

DIST	COUNTY	ROUTE	POST MILES TOTAL PROJECT	SHEET No	TOTAL SHEETS
08	SBd	138			

Chris Hoodley 12-27-12
 CERTIFIED ENGINEERING GEOLOGIST

PLANS APPROVAL DATE


Chris Hoodley
 No. 2309
 Exp. 11-23-13
 CERTIFIED ENGINEERING GEOLOGIST
 STATE OF CALIFORNIA

The State of California or its officers or agents shall not be responsible for the accuracy or completeness of electronic copies of this plan sheet.

This LOTB sheet was prepared in accordance with the Caltrans Soil & Rock Logging, Classification, & Presentation Manual (2010 Edition). See 2010 Standard Plans A10F and A10G for Soil Legend, and A10H for Rock Legend.


BENCH MARK

SET STD DISK IN CONC DN 3"
 STAMPED "P1-71-P1-21",
 29' RIGHT OF ?? PM 7.12
 NAD83 (VERTICAL)
 ZONE 5

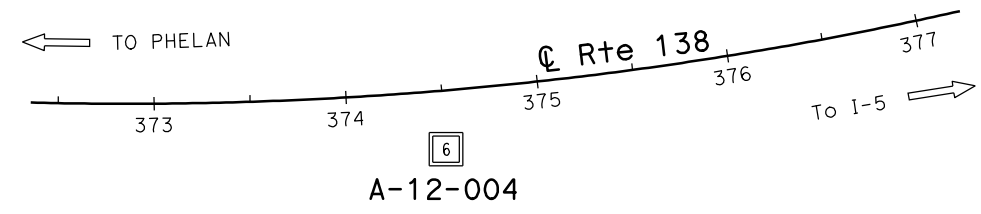

PLAN
 1" = 50'

Note: No ground water encountered during field investigation.

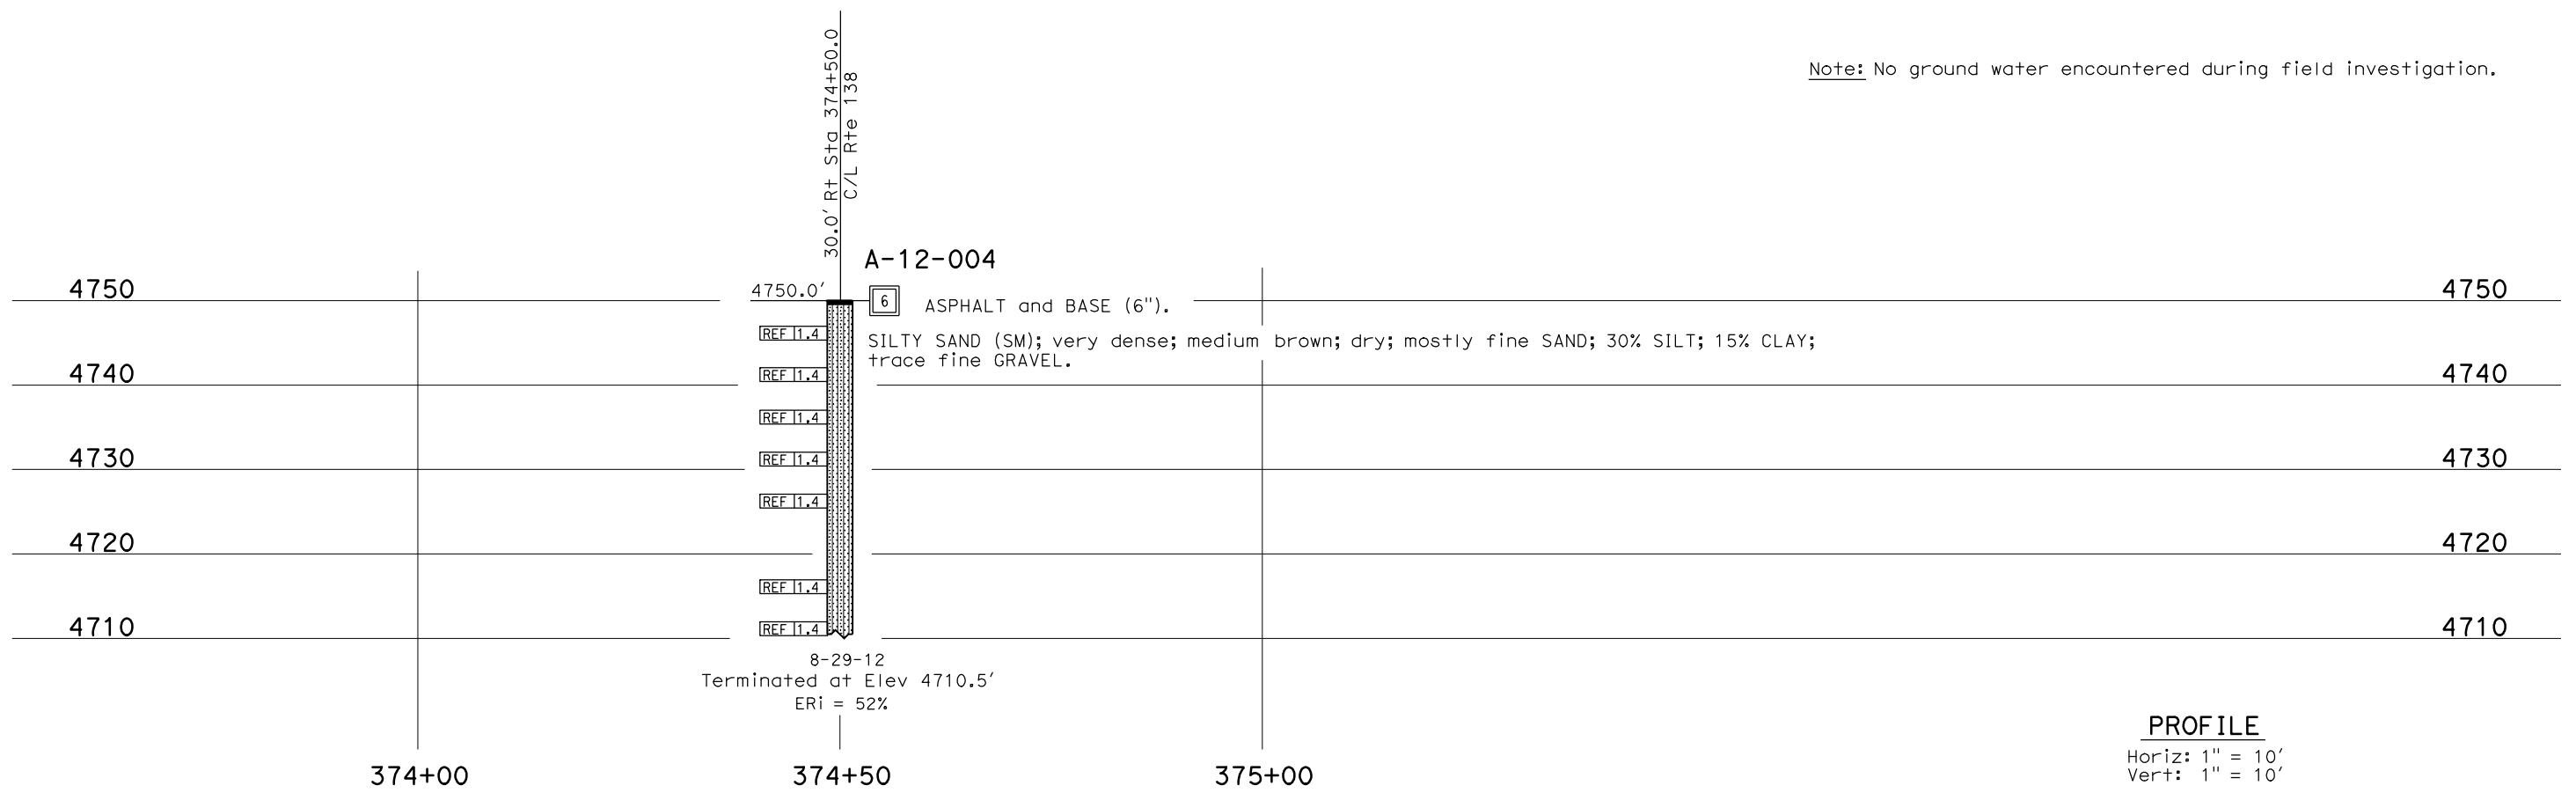

PROFILE
 Horiz: 1" = 10'
 Vert: 1" = 10'

ENGINEERING SERVICES		MATERIALS AND GEOTECHNICAL SERVICES		STATE OF CALIFORNIA		DIVISION OF ENGINEERING SERVICES		BRIDGE NO.		RETAINING WALL NO. 376	
FUNCTIONAL SUPERVISOR		DRAWN BY: W. Tang 10/12		FIELD INVESTIGATION BY:		STRUCTURE DESIGN		POST MILE		LOG OF TEST BORINGS	
NAME: S. Wei		CHECKED BY: M. Wilson		C. Hoodley		DESIGN BRANCH X		7.1			
065 CIVIL LOG OF TEST BORINGS SHEET		ORIGINAL SCALE IN INCHES FOR REDUCED PLANS		0 1 2 3		UNIT: 3643		PROJECT NUMBER & PHASE: 08000006091		CONTRACT NO.: 08-3401U1	
						DISREGARD PRINTS BEARING EARLIER REVISION DATES		REVISION DATES		SHEET OF	
								11-09-12 12-07-12		X X	

USERNAME => s128444 DATE PLOTTED => 28-DEC-2012 TIME PLOTTED => 13:41

DIST	COUNTY	ROUTE	POST MILES TOTAL PROJECT	SHEET No	TOTAL SHEETS
08	SBd	138			

Chris Hoodley 12-27-12
 CERTIFIED ENGINEERING GEOLOGIST

Chris Hoodley
 No. 2309
 Exp. 11-23-13
 CERTIFIED ENGINEERING GEOLOGIST
 STATE OF CALIFORNIA


PLANS APPROVAL DATE _____

The State of California or its officers or agents shall not be responsible for the accuracy or completeness of electronic copies of this plan sheet.

This LOTB sheet was prepared in accordance with the Caltrans Soil & Rock Logging, Classification, & Presentation Manual (2010 Edition). See 2010 Standard Plans A10F and A10G for Soil Legend, and A10H for Rock Legend.


BENCH MARK

FD 6X6" CONC R/W MONUMENT 100' RT
 STATION 674+48.18 EC, PM8.64.
 NAD83 (VERTICAL)
 ZONE 5

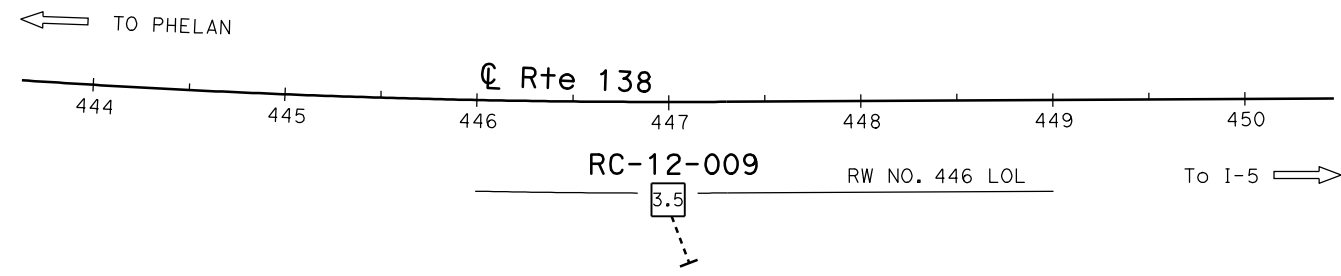

PLAN
 1" = 50'

Note: No ground water encountered during field investigation.

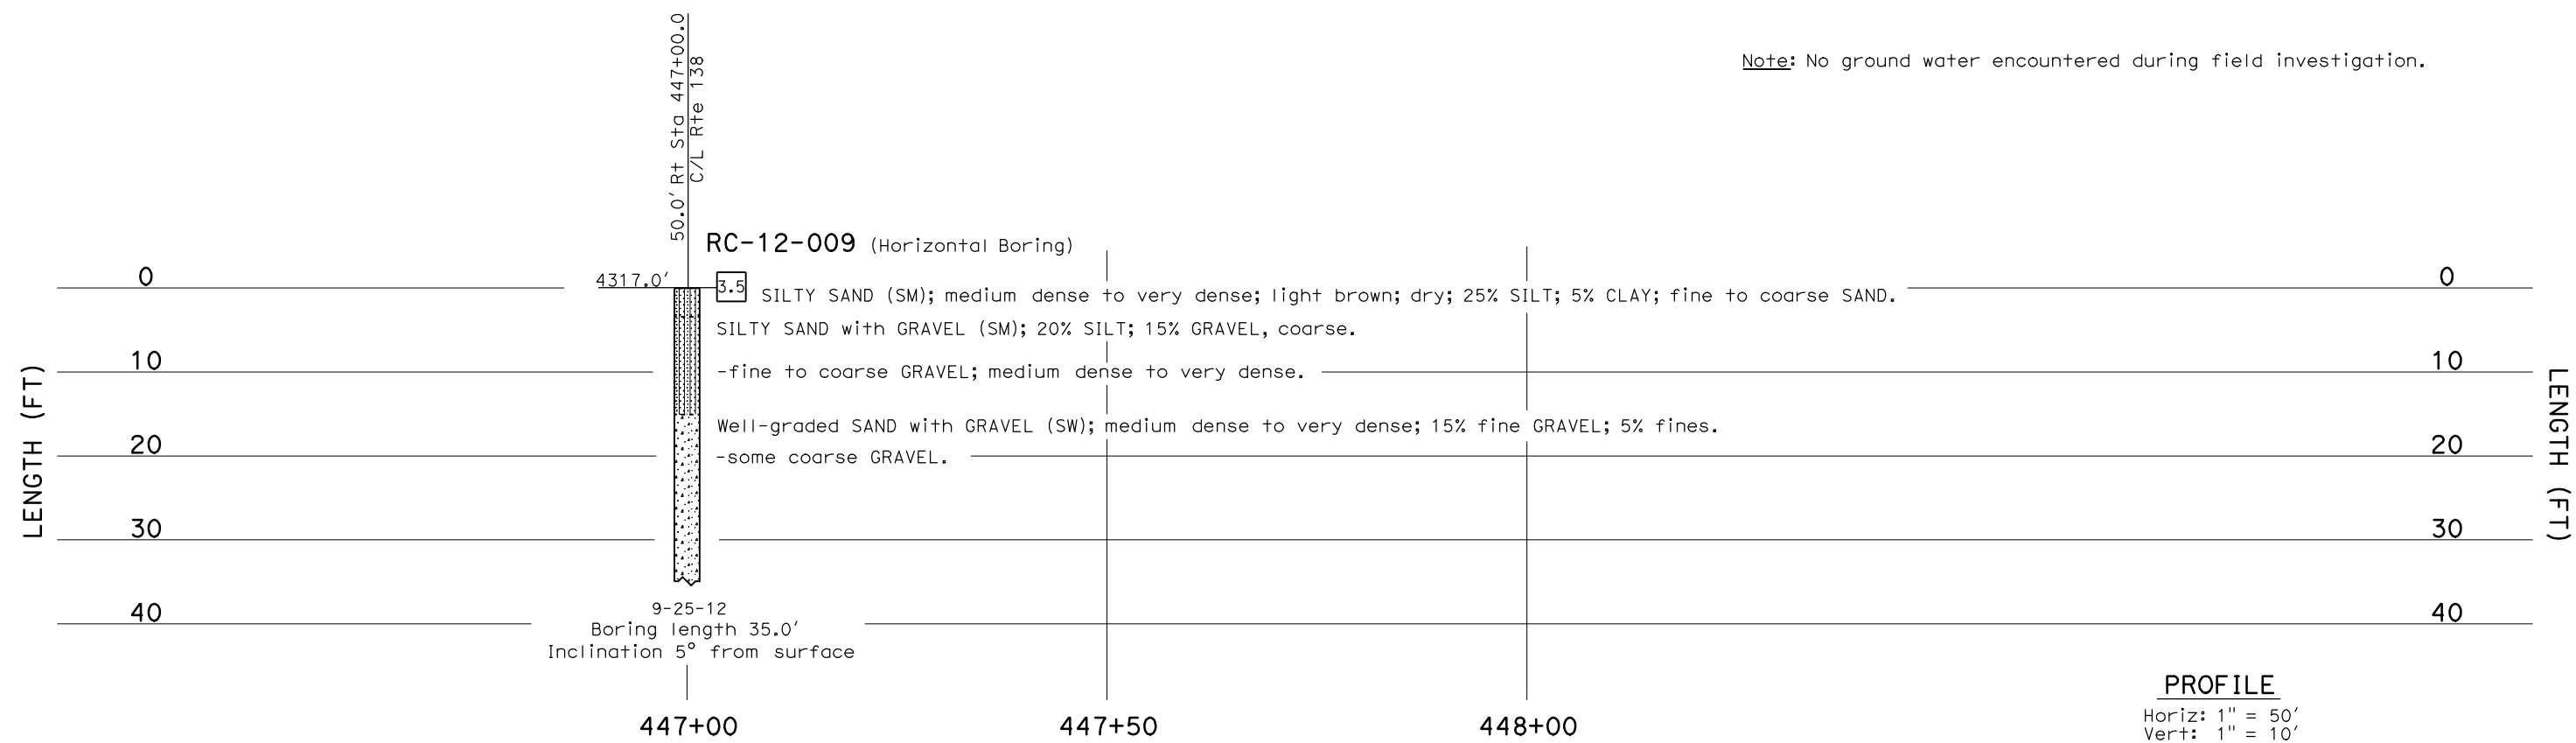



PROFILE

Horiz: 1" = 50'
 Vert: 1" = 10'

ENGINEERING SERVICES		MATERIALS AND GEOTECHNICAL SERVICES		STATE OF CALIFORNIA		DIVISION OF ENGINEERING SERVICES		BRIDGE NO.		RETAINING WALL NO. 446	
FUNCTIONAL SUPERVISOR		DRAWN BY: W. Tang 10/12		FIELD INVESTIGATION BY:		STRUCTURE DESIGN		RW446		LOG OF TEST BORINGS	
NAME: S. Wei		CHECKED BY: M. Wilson		C. Hoodley		DESIGN BRANCH X		POST MILE			
085 CIVIL LOG OF TEST BORINGS SHEET		ORIGINAL SCALE IN INCHES FOR REDUCED PLANS		UNIT: 3643		PROJECT NUMBER & PHASE: 08000006091		CONTRACT NO.: 08-3401U1		DISREGARD PRINTS BEARING EARLIER REVISION DATES	
				0 1 2 3		FILE => rw446.dgn		REVISION DATES		SHEET OF	
								10-15-12 11-14-12 12-07-12		X X	

USERNAME => s128444 DATE PLOTTED => 28-DEC-2012 TIME PLOTTED => 13:41


DIST	COUNTY	ROUTE	POST MILES TOTAL PROJECT	SHEET No	TOTAL SHEETS
08	SBd	138			

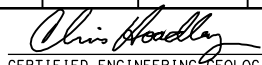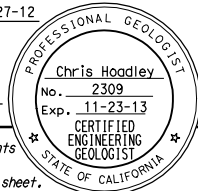
 CERTIFIED ENGINEERING GEOLOGIST 12-27-12


PLANS APPROVAL DATE _____

The State of California or its officers or agents shall not be responsible for the accuracy or completeness of electronic copies of this plan sheet.

This LOTB sheet was prepared in accordance with the Caltrans Soil & Rock Logging, Classification, & Presentation Manual (2010 Edition). See 2010 Standard Plans A10F and A10G for Soil Legend, and A10H for Rock Legend.

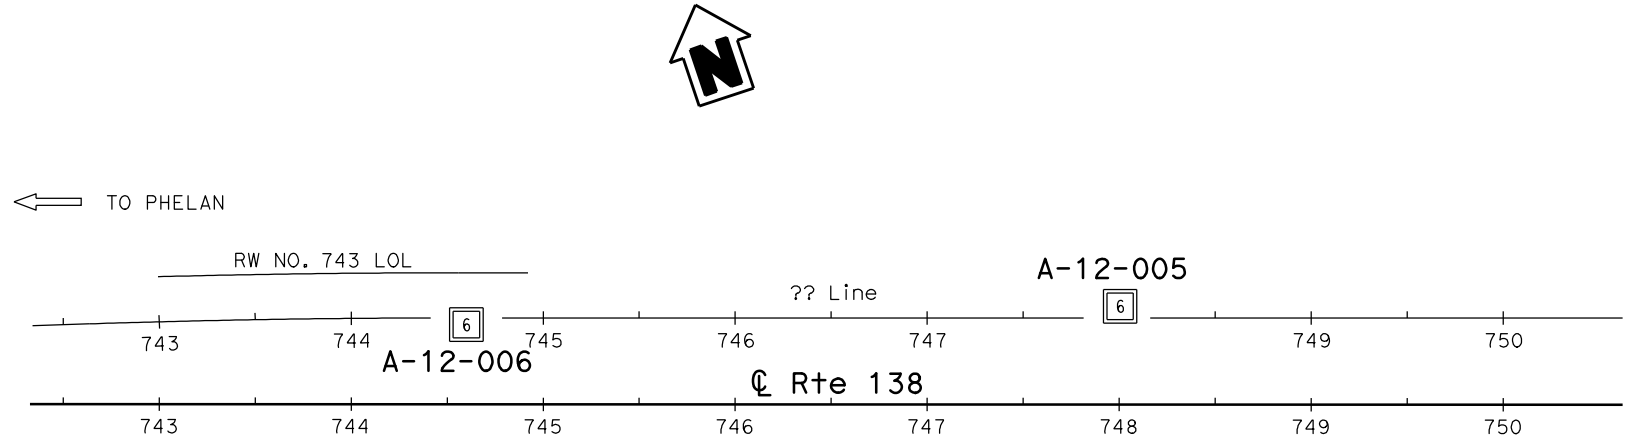


BENCH MARK

SET STD DISK STAMPED "SBd 138 GPS 9 1999" 100' +/- N'LY Y.S. Rte 138 ON TOP OF CUT S'WLY OF R/R OVERCROSS, 23' S'LY SPLIT R/R TRACKS, 10' W'LY CONC ENCASED CMP, PM14.1. NAD83 (VERTICAL) ZONE 5

PLAN
1" = 50'

Note: No ground water encountered during field investigation.

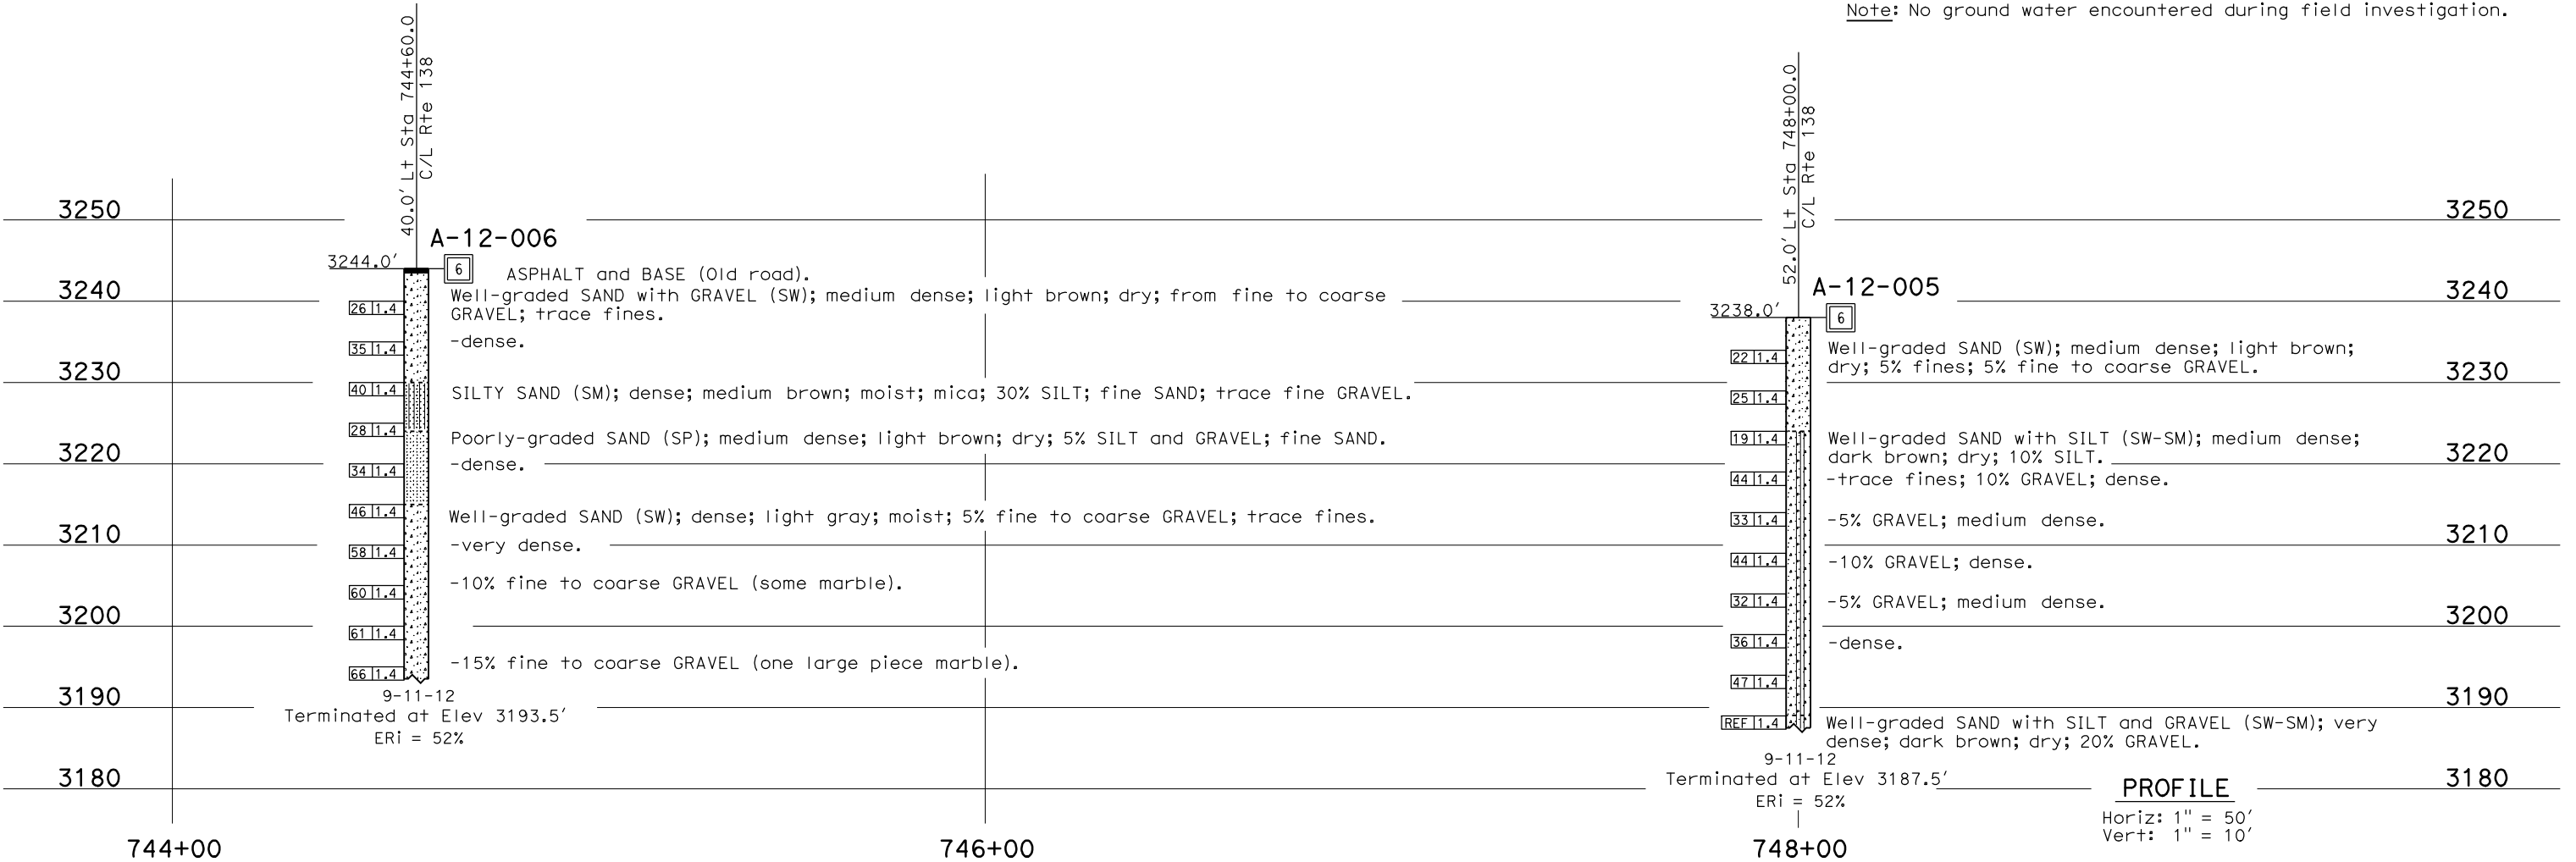


ENGINEERING SERVICES		MATERIALS AND GEOTECHNICAL SERVICES		STATE OF CALIFORNIA DEPARTMENT OF TRANSPORTATION		DIVISION OF ENGINEERING SERVICES STRUCTURE DESIGN DESIGN BRANCH X		RETAINING WALL NO. 743 LOG OF TEST BORINGS	
FUNCTIONAL SUPERVISOR NAME: S. Wei	DRAWN BY: W. Tang 10/12 CHECKED BY: M. Wilson	FIELD INVESTIGATION BY: C. Hoodley		BRIDGE NO. POST MILE 14.1/14.2		UNIT: 3643 PROJECT NUMBER & PHASE: 08000006091 CONTRACT NO.: 08-3401U1		DISREGARD PRINTS BEARING EARLIER REVISION DATES	
065 CIVIL LOG OF TEST BORINGS SHEET				ORIGINAL SCALE IN INCHES FOR REDUCED PLANS		REVISION DATES		SHEET OF	
				0 1 2 3		10-15-12 11-09-12 12-07-12 12-14-12		X X	

FILE => rw743.dgn


USERNAME => s128444 DATE PLOTTED => 28-DEC-2012 TIME PLOTTED => 13:41

Gish Overhead

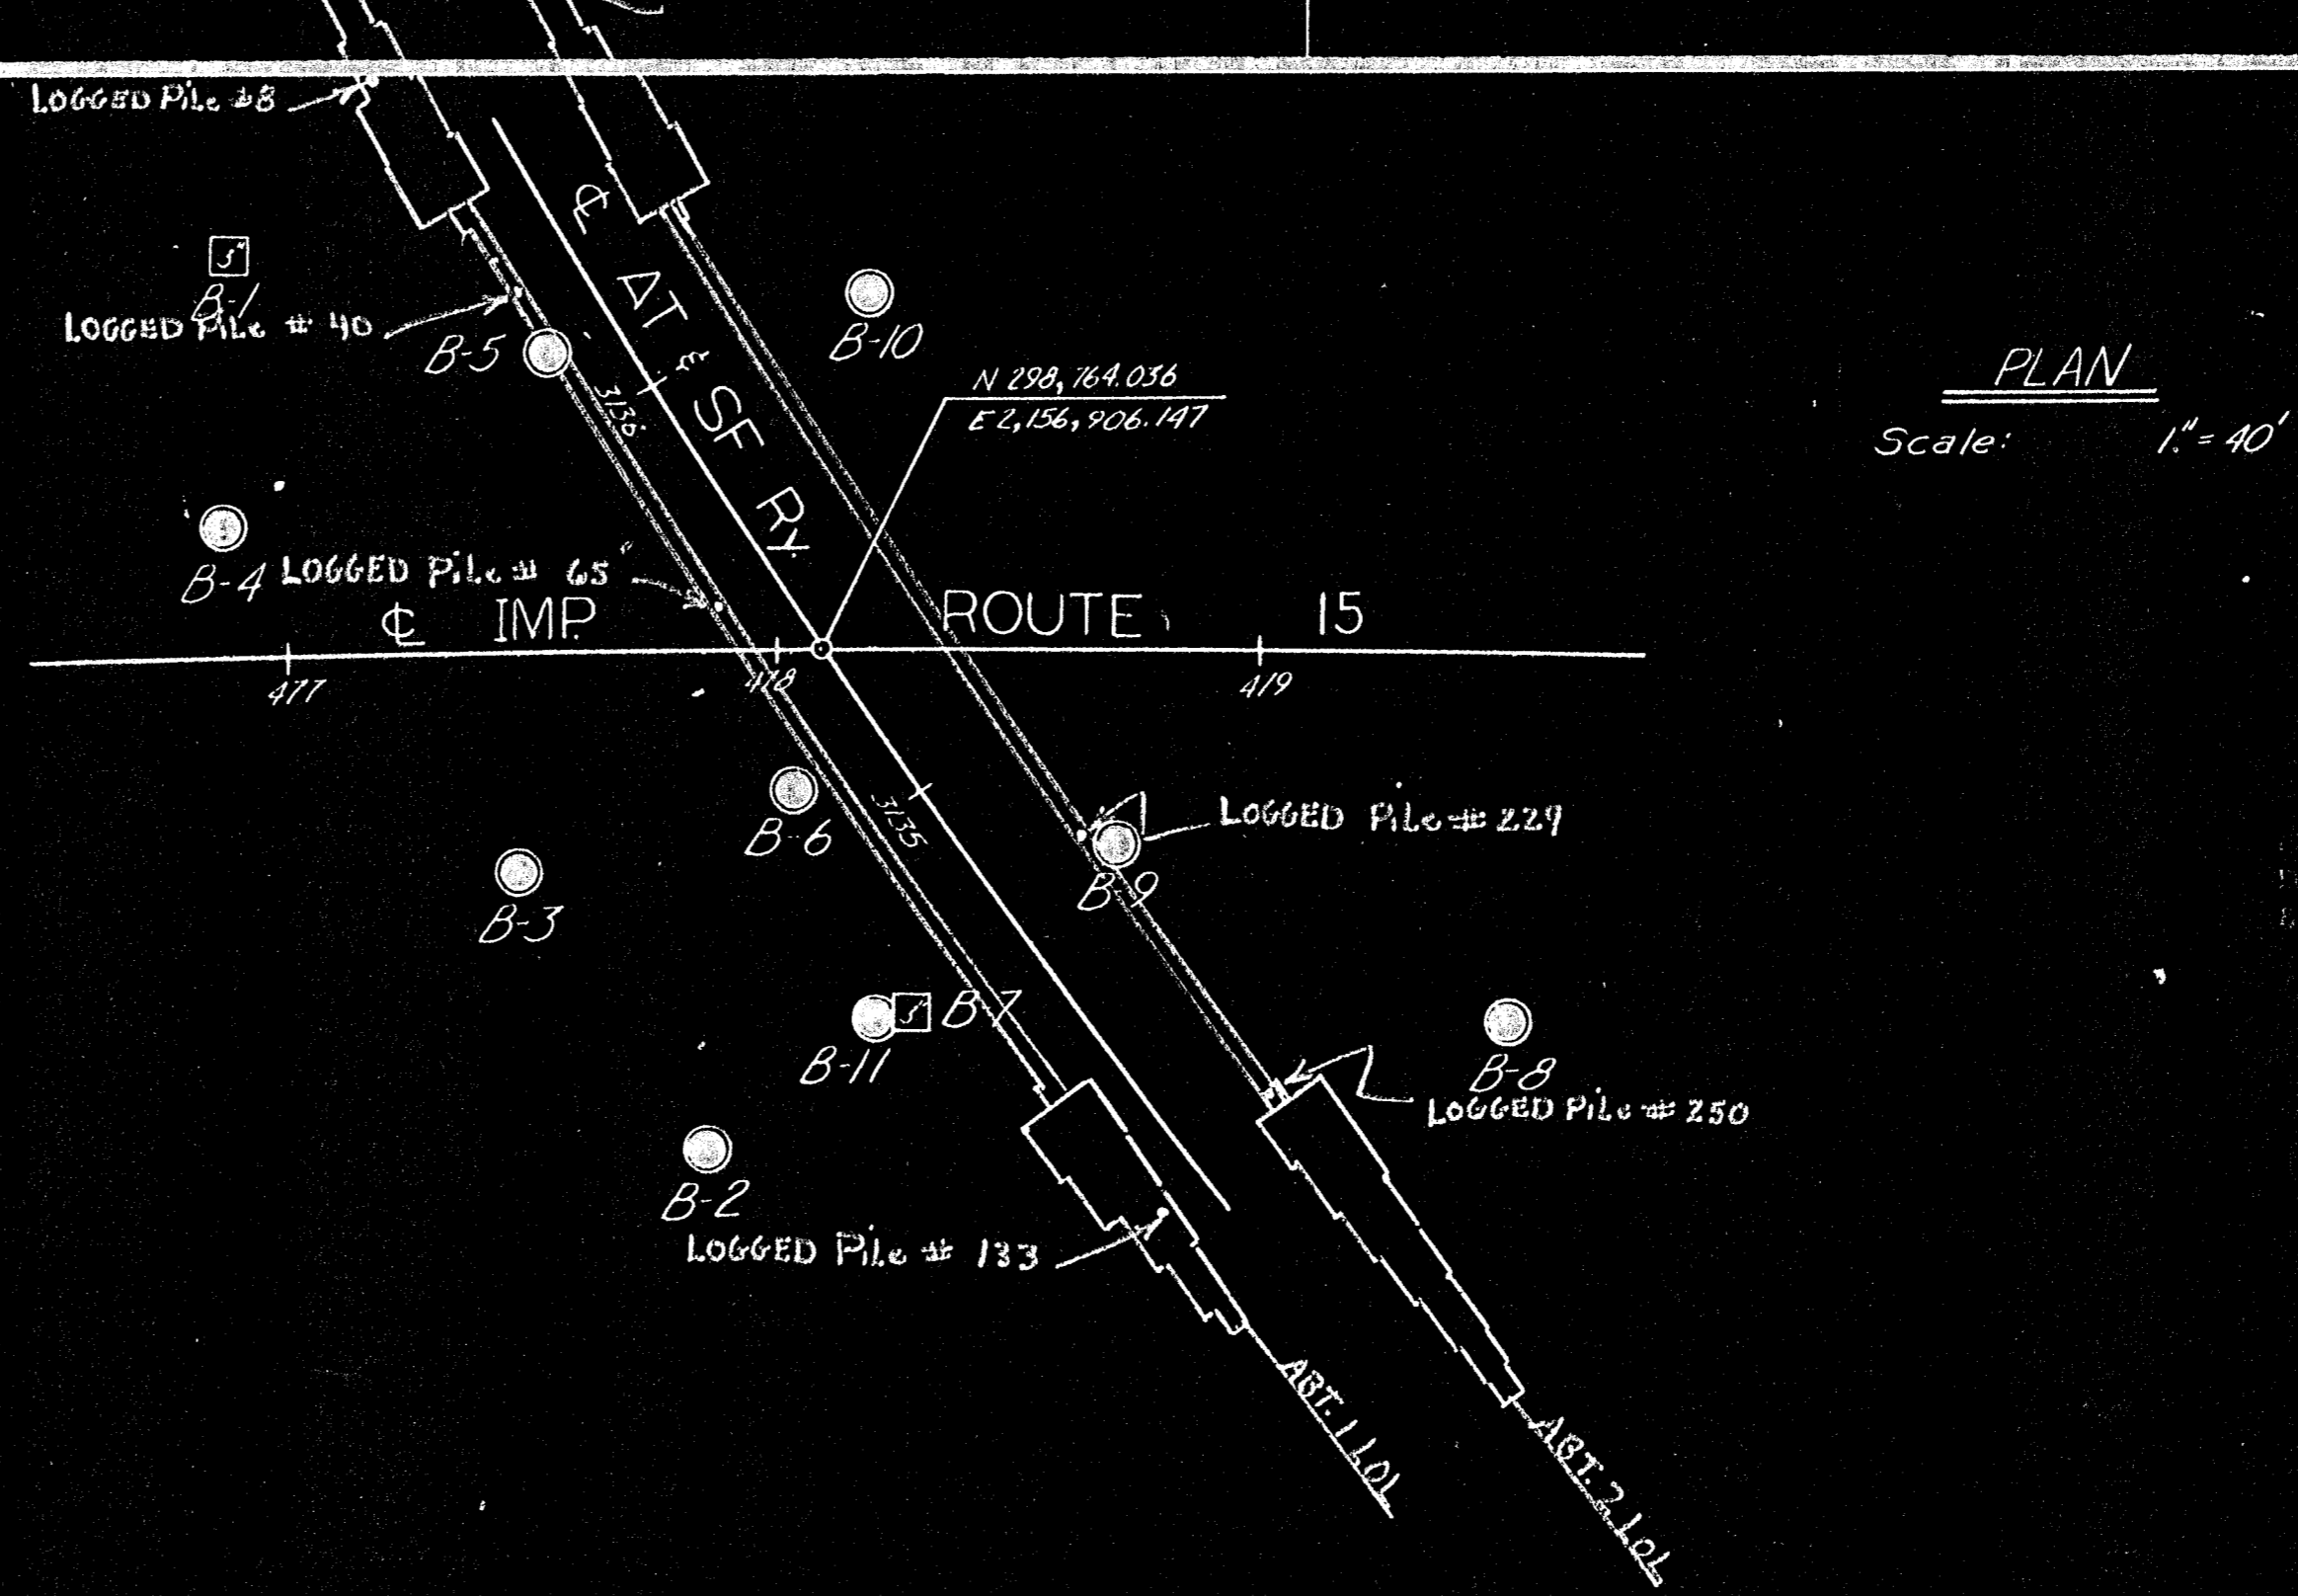

BENCH MARK
 B.M. K-2 USC & GS Elev. 3267.326
 Std. disk in top of NW end of NE conc. abut.
 of exist. Rte. 15 UR 364' Rt. Sta 481+69 ± POC
 & Imp.

Pile Footing:
 Design Pile load: 45T
 Pile Type: 10BP42
 Total Piles: 291 EA.
 Laid Ft. Piles, PLANS: 8,045'
 " " " As built: 8,986.5'
 Hammer: Vulcan 06 (6,500# RAM, 3 Ft. Stroke)
 Material Encountered conformed to that shown
 on this log of Test Borings. No footing
 Elevation Revisions Required. Ground water not encountered.

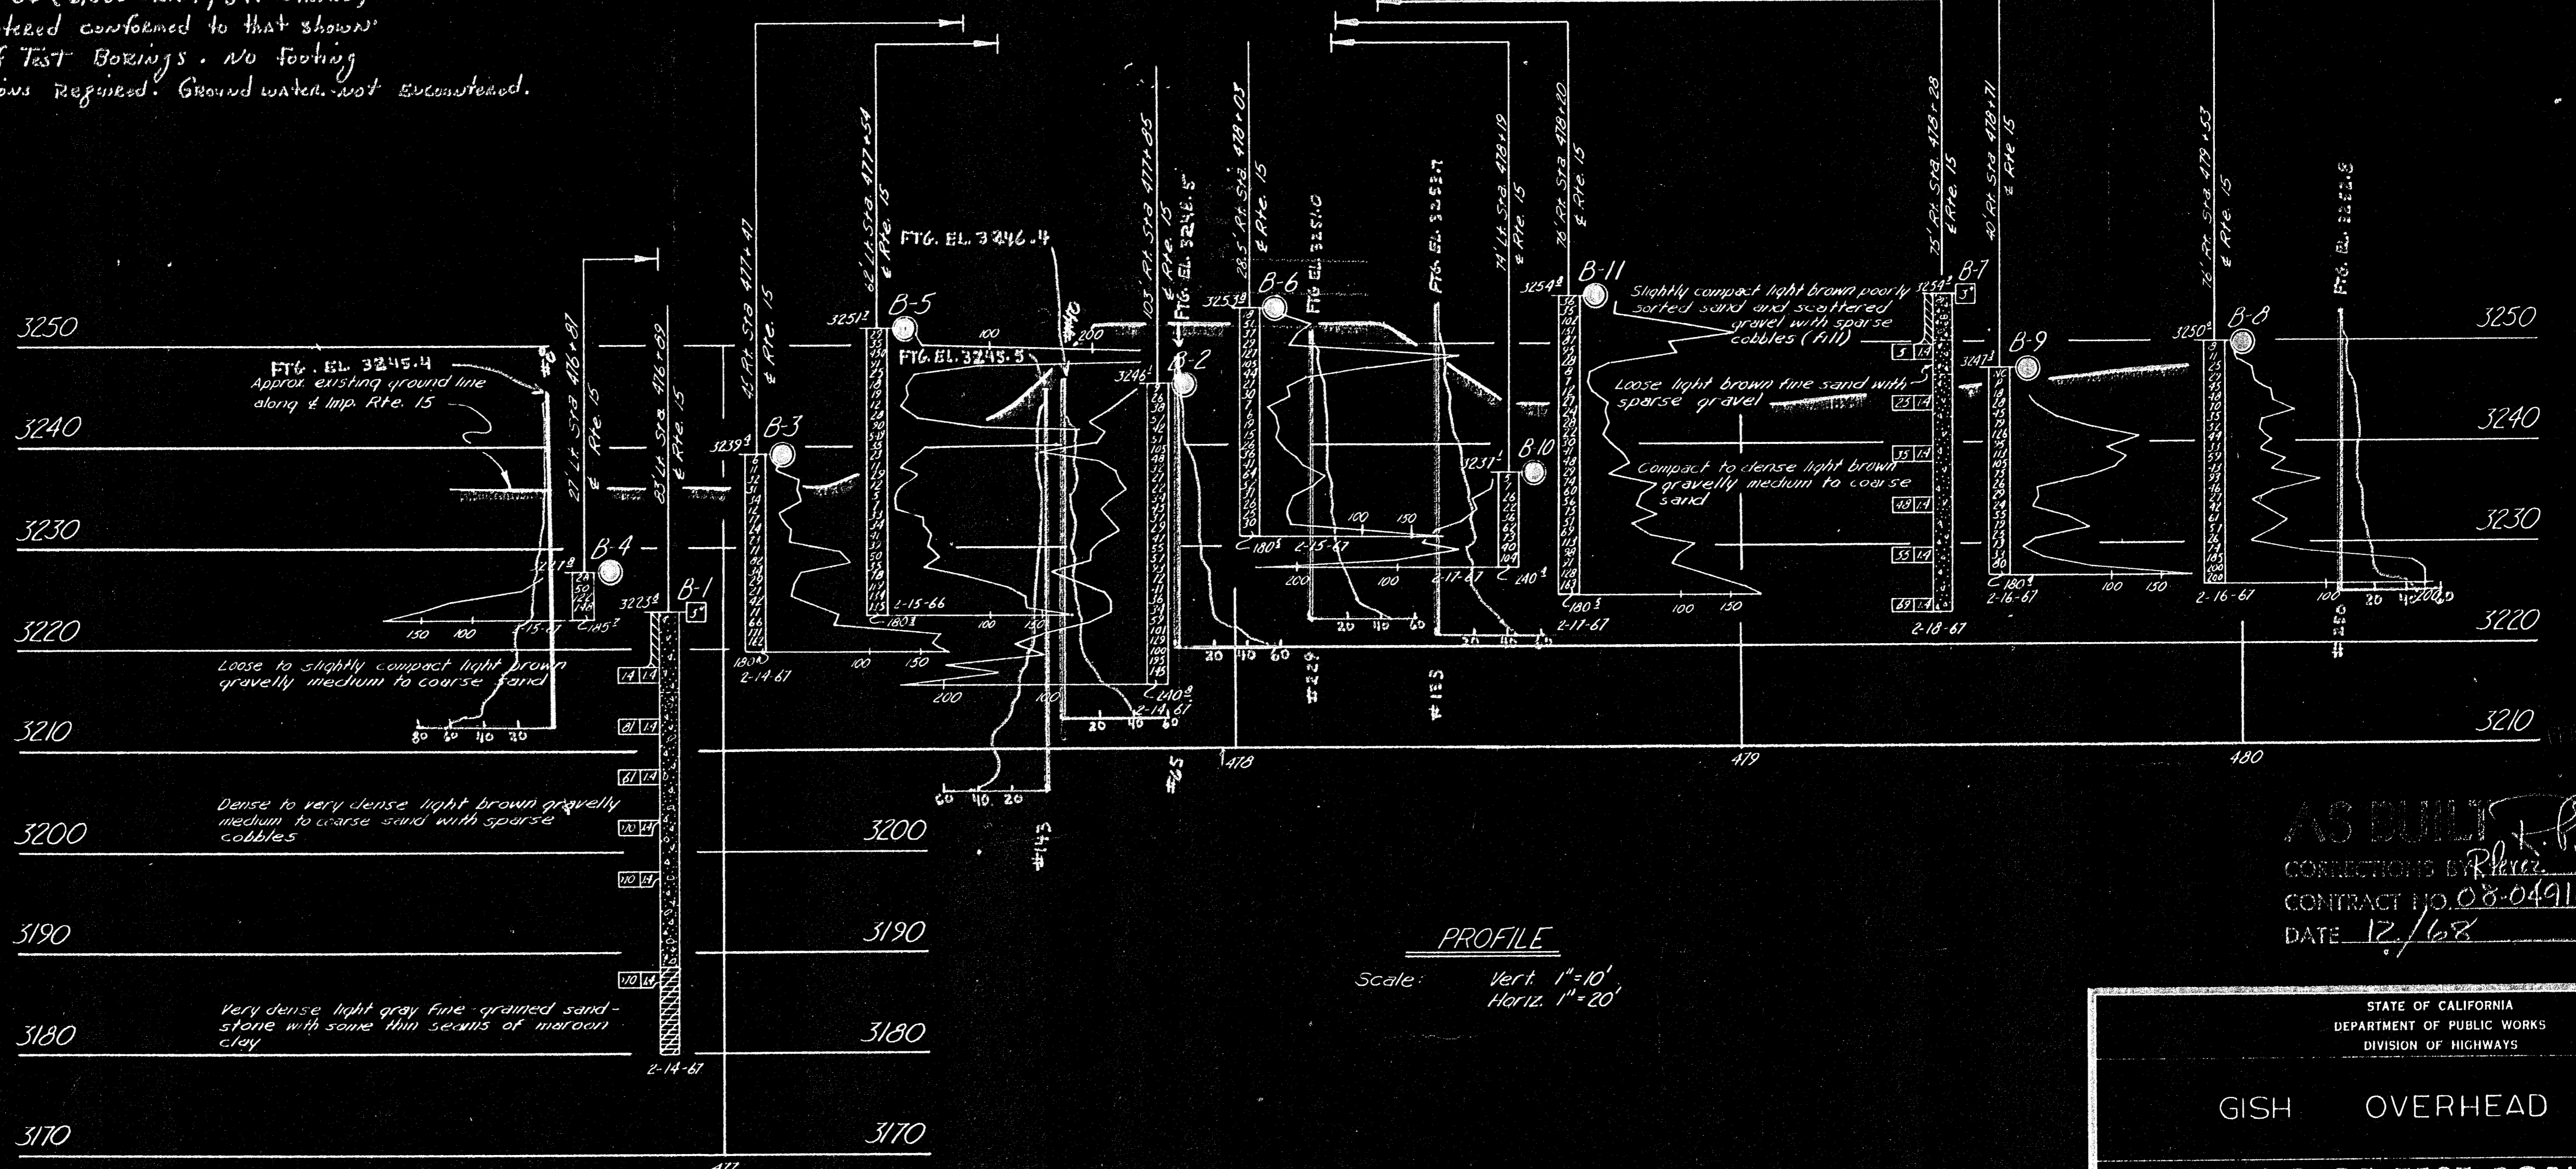

AS BUILT
 CORRECTIONS BY [Signature]
 CONTRACT NO. 08-04912.4
 DATE 12/68

LEGEND OF BORING OPERATIONS
 PENETRATION BORING
 ROTARY BORING
 SOIL TUBE

LEGEND OF EARTH MATERIALS
 SILTY CLAY OR CLAYEY SILT
 FEAT. MUD/CLAY
 ORGANIC MATTER
 FILL MATERIAL
 IGNEOUS ROCK
 SEDIMENTARY ROCK
 METAMORPHIC ROCK

CLASSIFICATION OF MATERIAL BASED ON STANDARD GRADE SIZE LIMITS
 NOTE: Classification of earth material as shown on this sheet is based upon field inspection and is not to be construed to imply mechanical analysis.

FIELD STUDY BY: D. CAMPBELL 2-16-67
 DRAWN BY: B. WOOD 5-2-67
 CHECKED BY: [Signature]
 APPROVED BY: [Signature]

BRIDGE DEPARTMENT
 ENGINEERING GEOLOGY SECTION

STATE OF CALIFORNIA
 DEPARTMENT OF PUBLIC WORKS
 DIVISION OF HIGHWAYS

GISH OVERHEAD

LOG OF TEST BORINGS


SCALE: As Noted BRIDGE 54-196 P11 22.1 DRAWING

PREL. DRAWING NO. PR-

Alray Overhead

CIDH Pile Footing:
 Pile type: 16" CIDH
 Total Piles: 101
 Lin. Ft., Plans: 2,585
 Lin. Ft., As built: 2,621
 MATERIAL EXCAVATED FROM CIDH piles conformed substantially to that shown on this LOG of Test Borings. No ground water encountered.

SPREAD FOOTING:
 Foundation material encountered AT spread footing (E.L.) locations conformed to that shown on this log of Test Borings. No footing elevation REVISIONS Required. Ground water NOT Encountered.

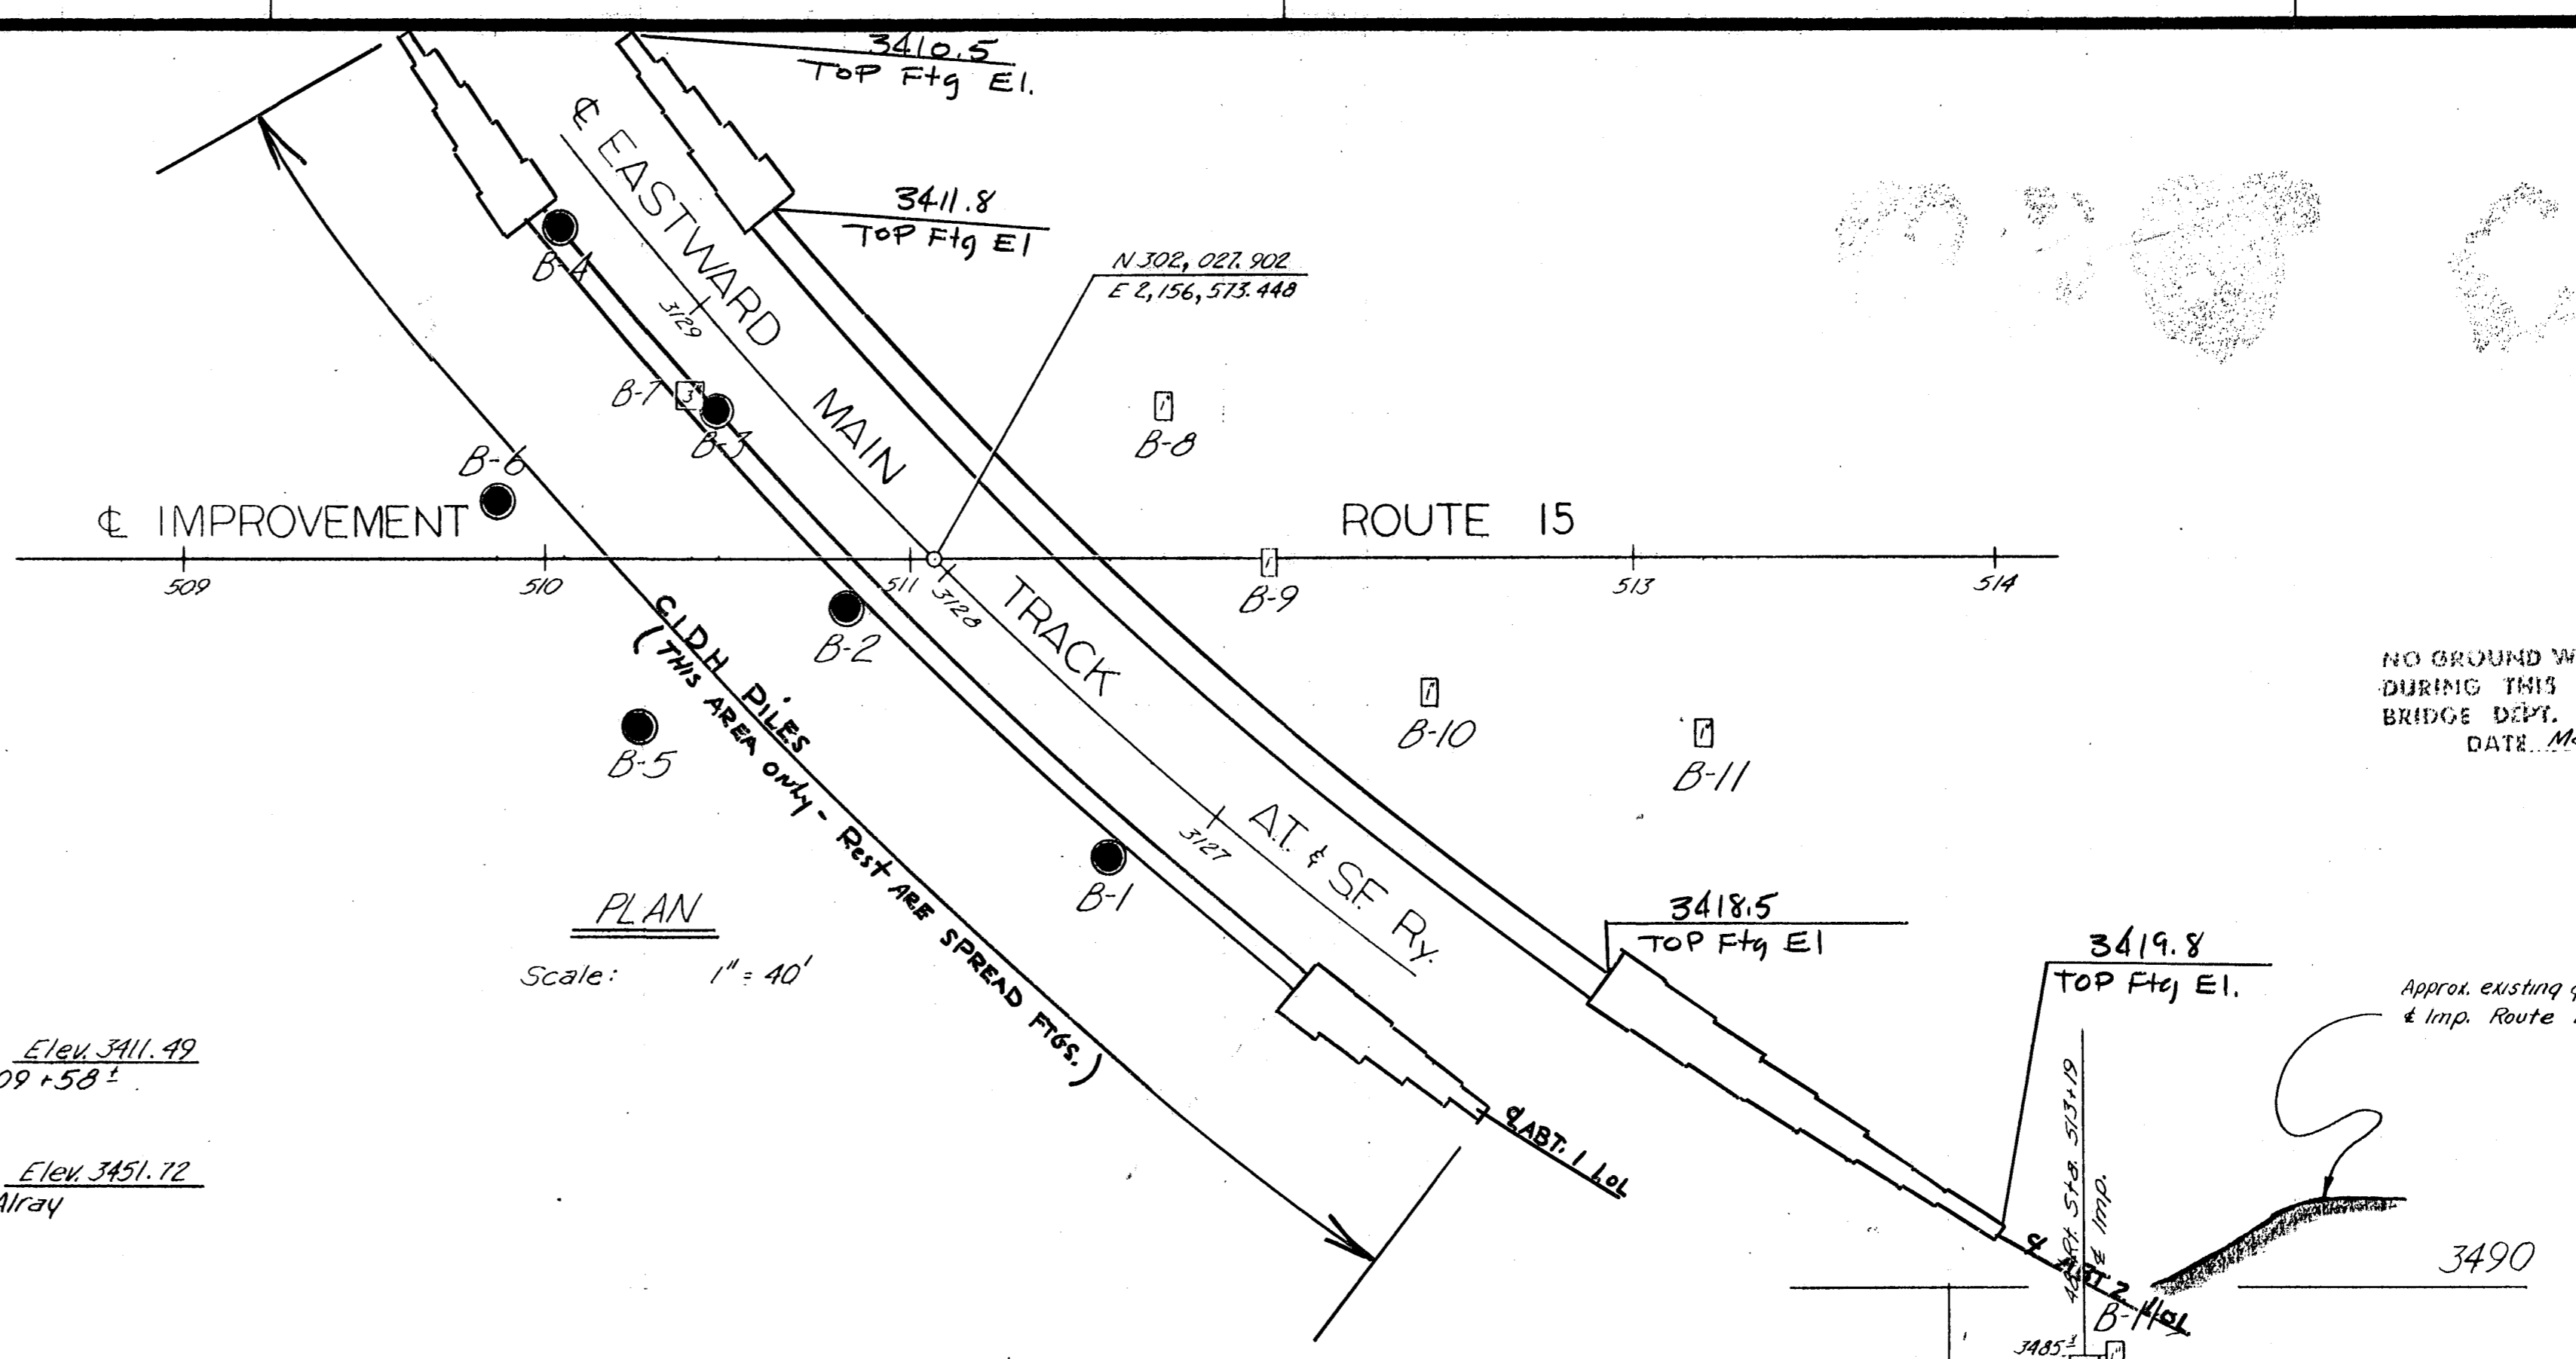


BENCH MARKS

BM B Alray 65 Elev. 3411.49
 Spd. nail in 2" x 2" hub buried 0.8' 156' ± Lt. 509+58 ±
 POT & Imp.




BM 52-A-50 Elev. 3451.72
 Spd. nail in lead in S'ly end of E'ly abut. of Alray Underpass. Bridge No. 54-23

NO GROUND WATER ENCOUNTERED DURING THIS INVESTIGATION BY BRIDGE DEPT. GEOLOGY SECTION DATE March, 1967

Approx. existing ground line along & Imp. Route 15

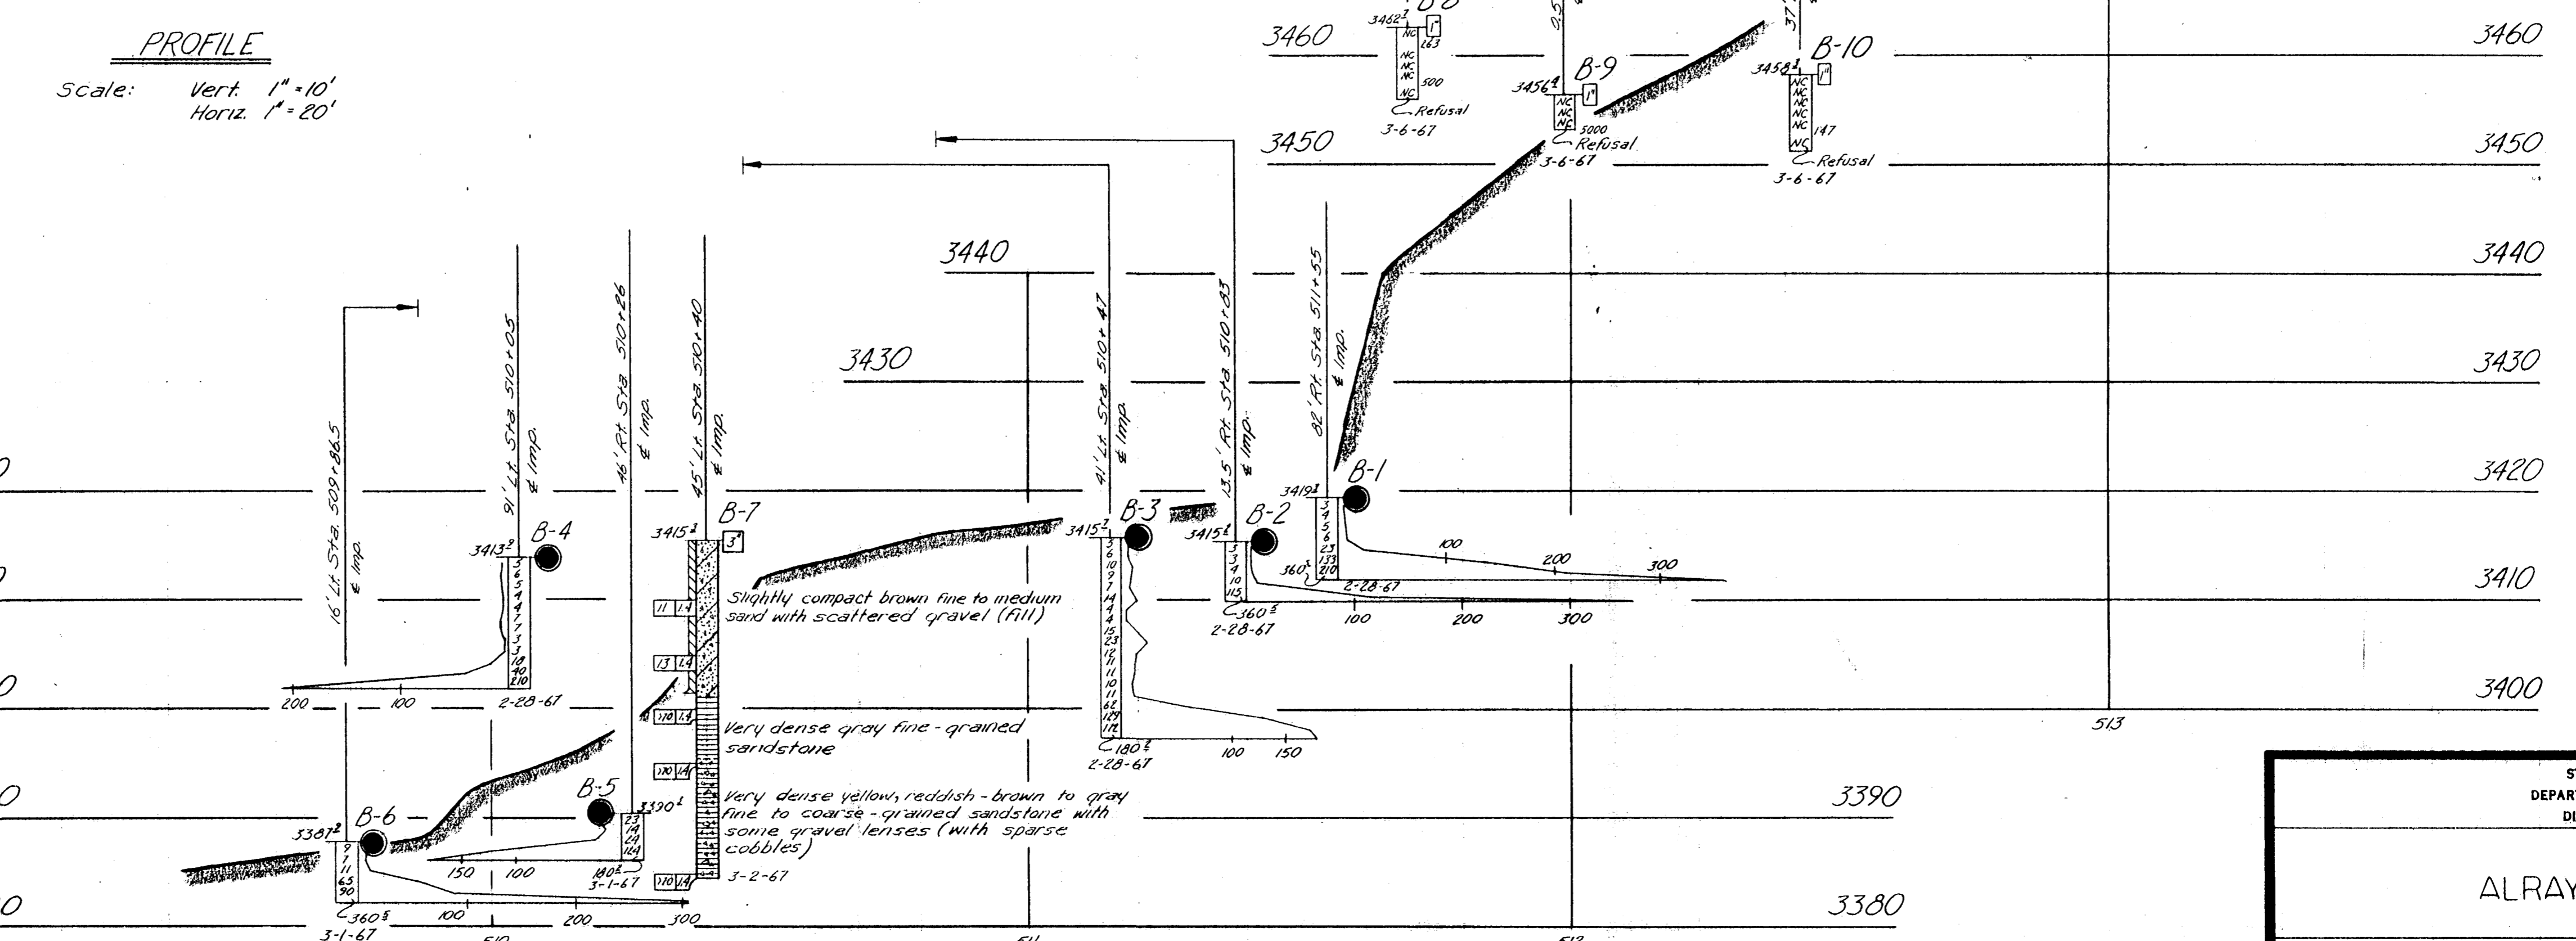

AS BUILT
 CORRECTIONS BY R. P. Somerville
 CONTRACT NO. 08-049124
 DATE 12/68

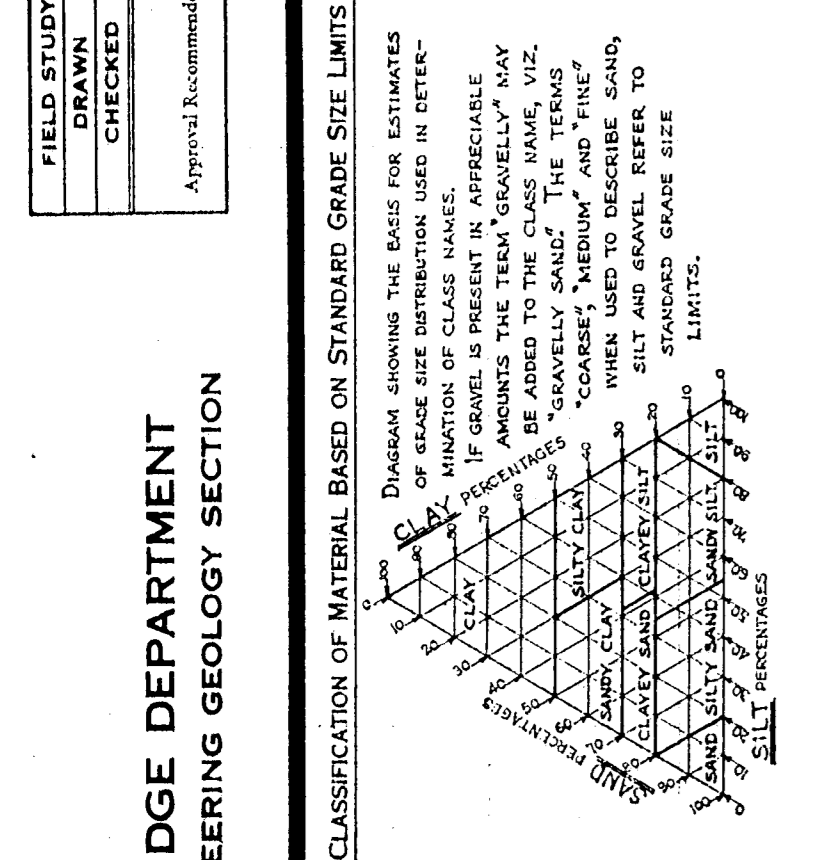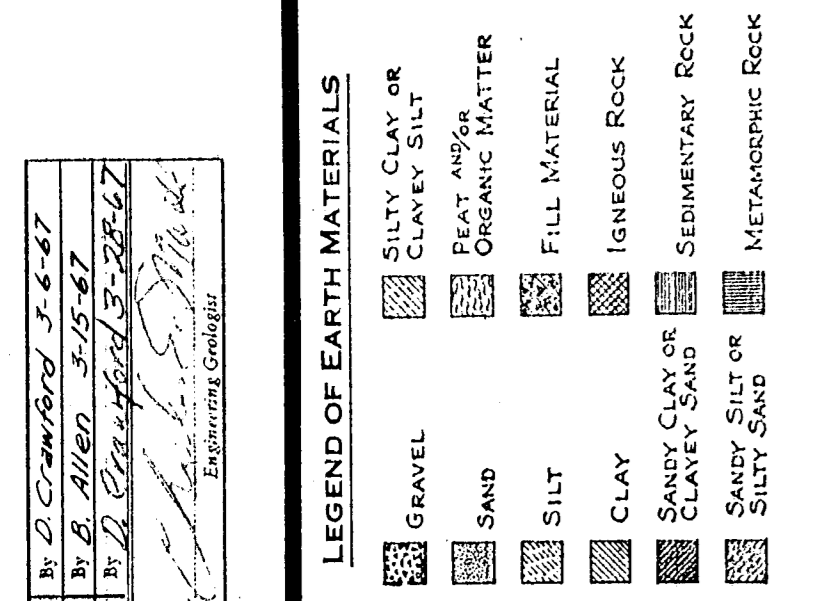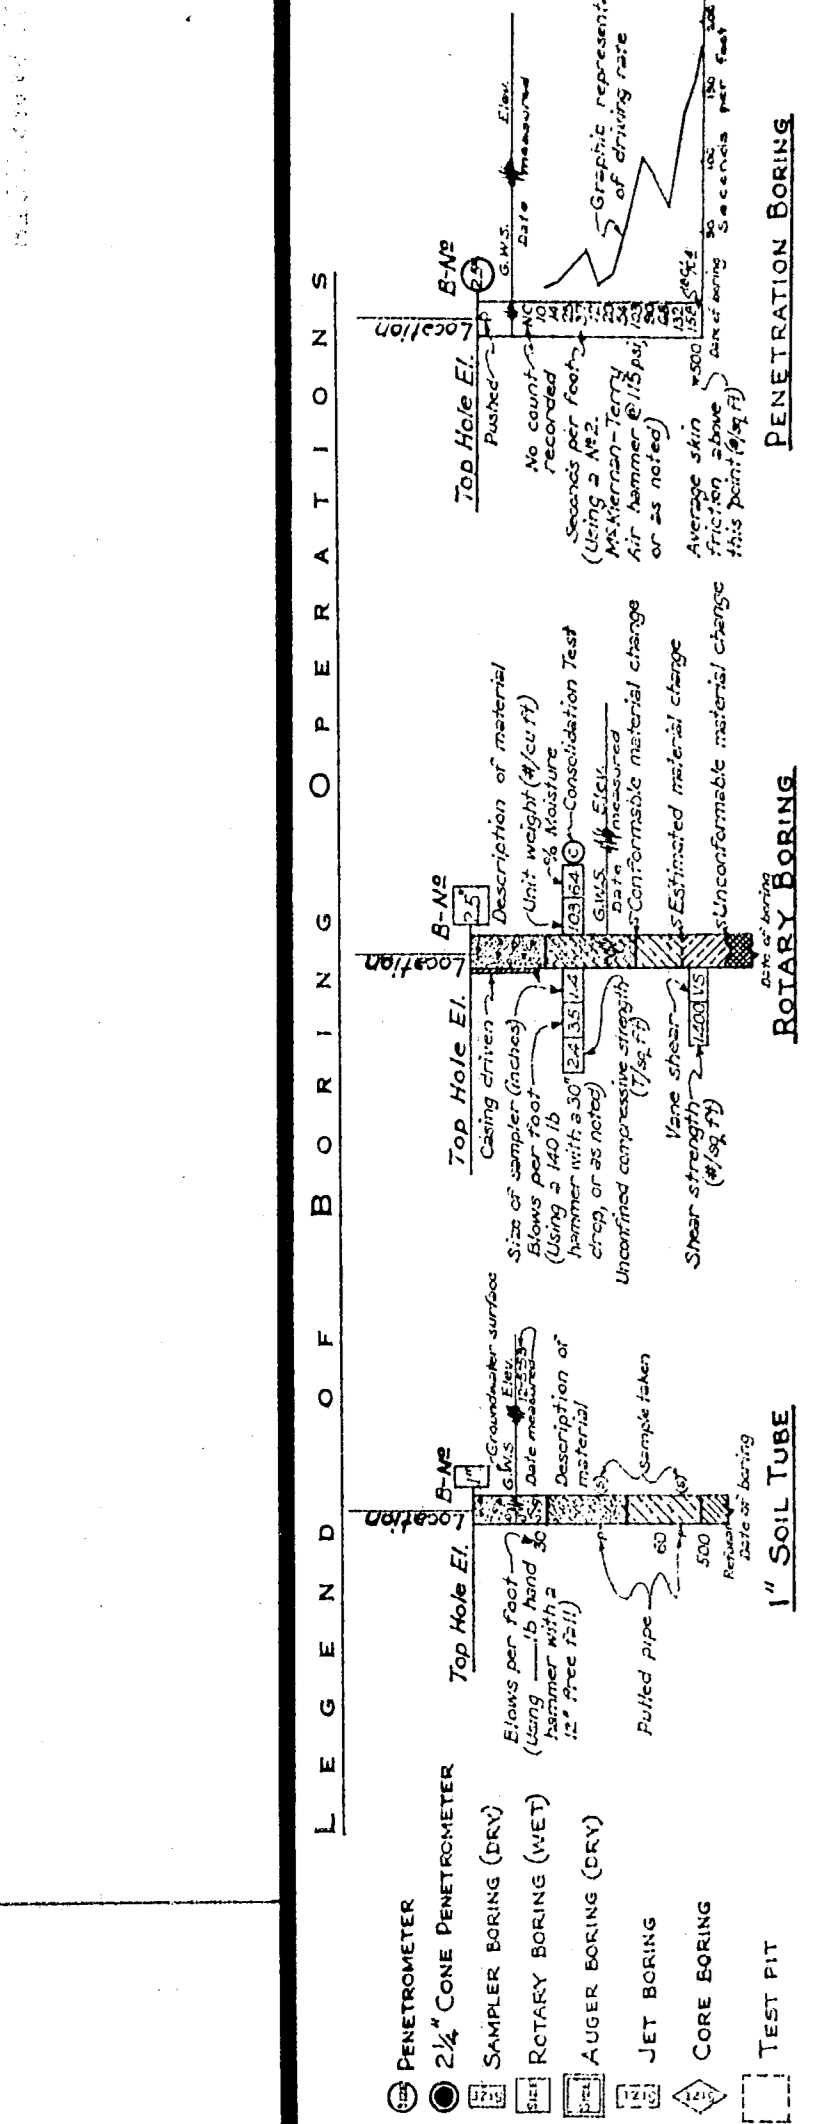

NOTE: Classification of earth material as shown on this sheet is based upon field inspection and is not to be construed to imply mechanical analysis.

BRIDGE DEPARTMENT
 ENGINEERING GEOLOGY SECTION

STATE OF CALIFORNIA
 DEPARTMENT OF PUBLIC WORKS
 DIVISION OF HIGHWAYS

ALRAY OVERHEAD
LOG OF TEST BORINGS

SCALE As Noted BRIDGE 54-797 P.M. 22.7 DRAWING

SHEET 105 OF 114

PREL. DRAWING NO. PR-12/3

105


North Alray Overhead

DATE APPROVED: March 18, 1968

Pile Footing:
 Design Pile Load: 45T
 Pile Type: 10BP42
 Total Piles: 116
 Liv. Pt. Piles, Plans: 1,955
 " " " , As Built: 1,875
 Hammer: Vulcan 06 (6,500# RAM, 3 Ft. Stroke)

SPREAD FOOTING:
 Foundation material encountered at spread footing locations conformed to that shown on this Log of Test Borings. No footing elevation revisions required. Ground water NOT encountered.

BENCH MARK
 B.M. # B-Alray-65 Elev. 3411.49
 Spd. nail in 2"x2" hub buried 0.8' 156'±
 Lt. 509+58 ± P.O.T. ± Imp.

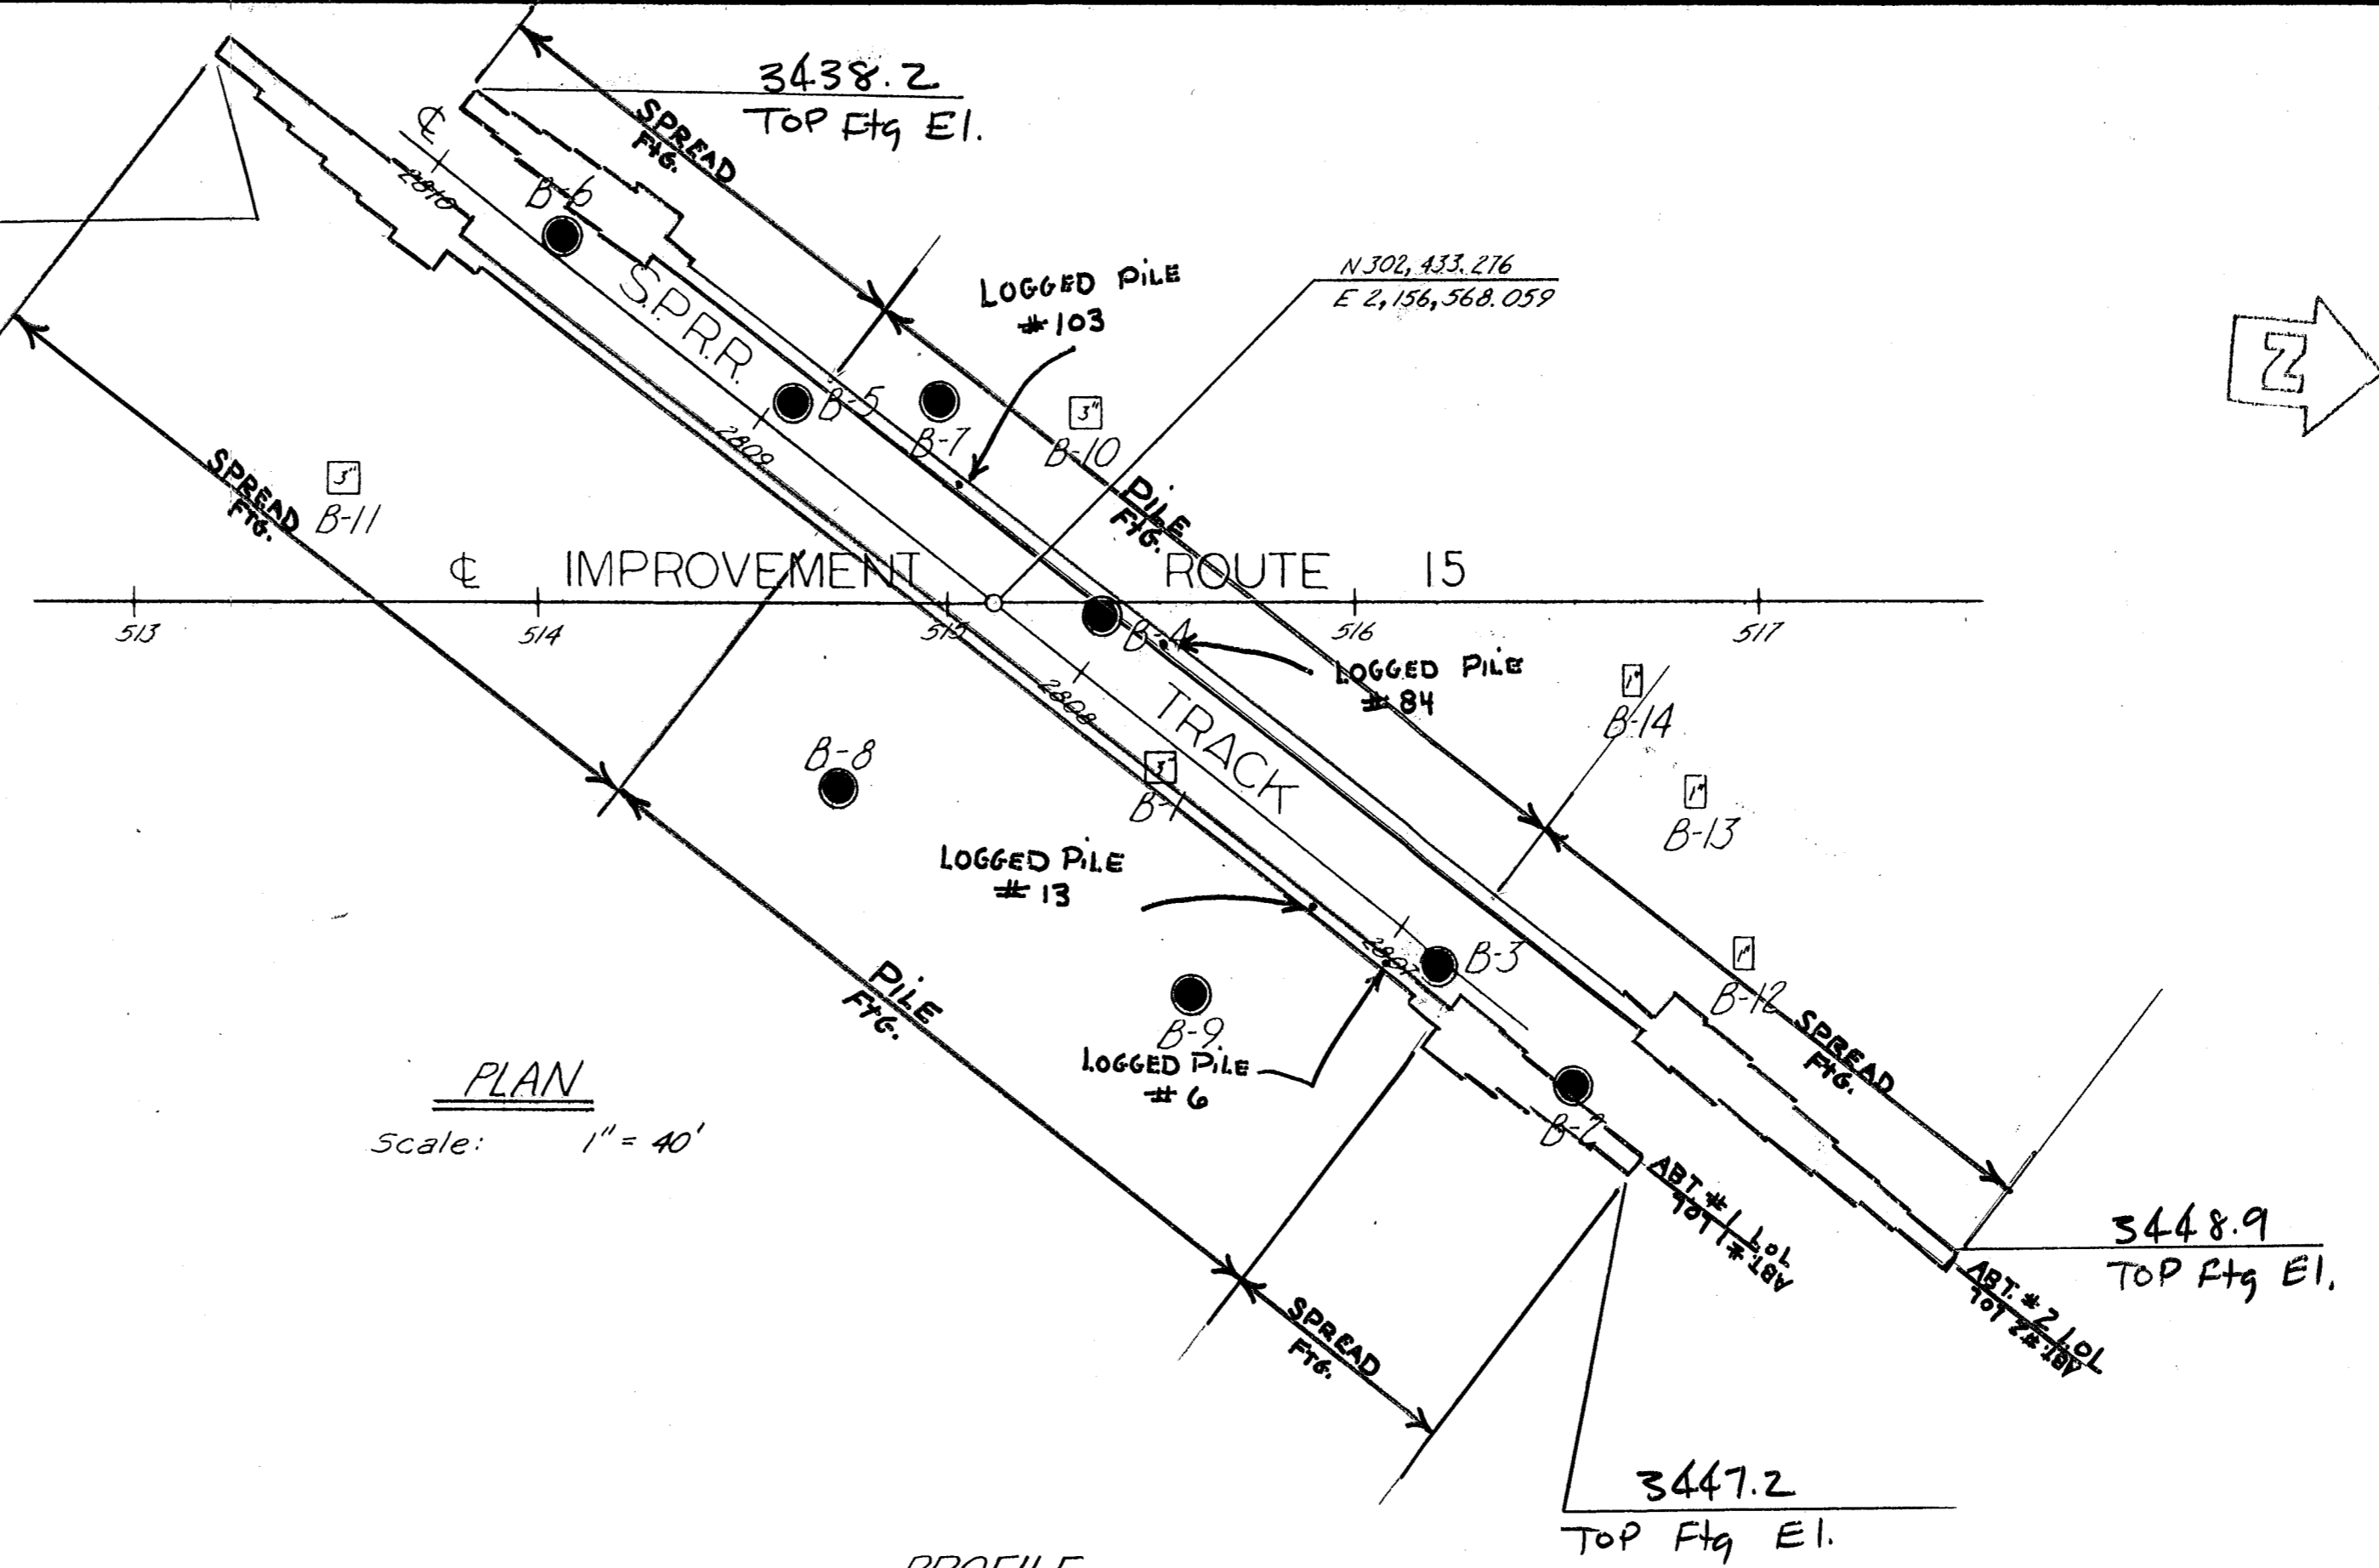


PLAN
 Scale: 1" = 40'

PROFILE
 Scale: Vert. 1" = 10'
 Horiz. 1" = 20'

NO GROUND WATER ENCOUNTERED DURING THIS INVESTIGATION BY BRIDGE DEPT. GEOLOGY SECTION DATE March, 1967


AS BUILT R. J. Somerville
 CORRECTIONS BY R. Perez
 CONTRACT NO. 08-049124
 DATE 12/68

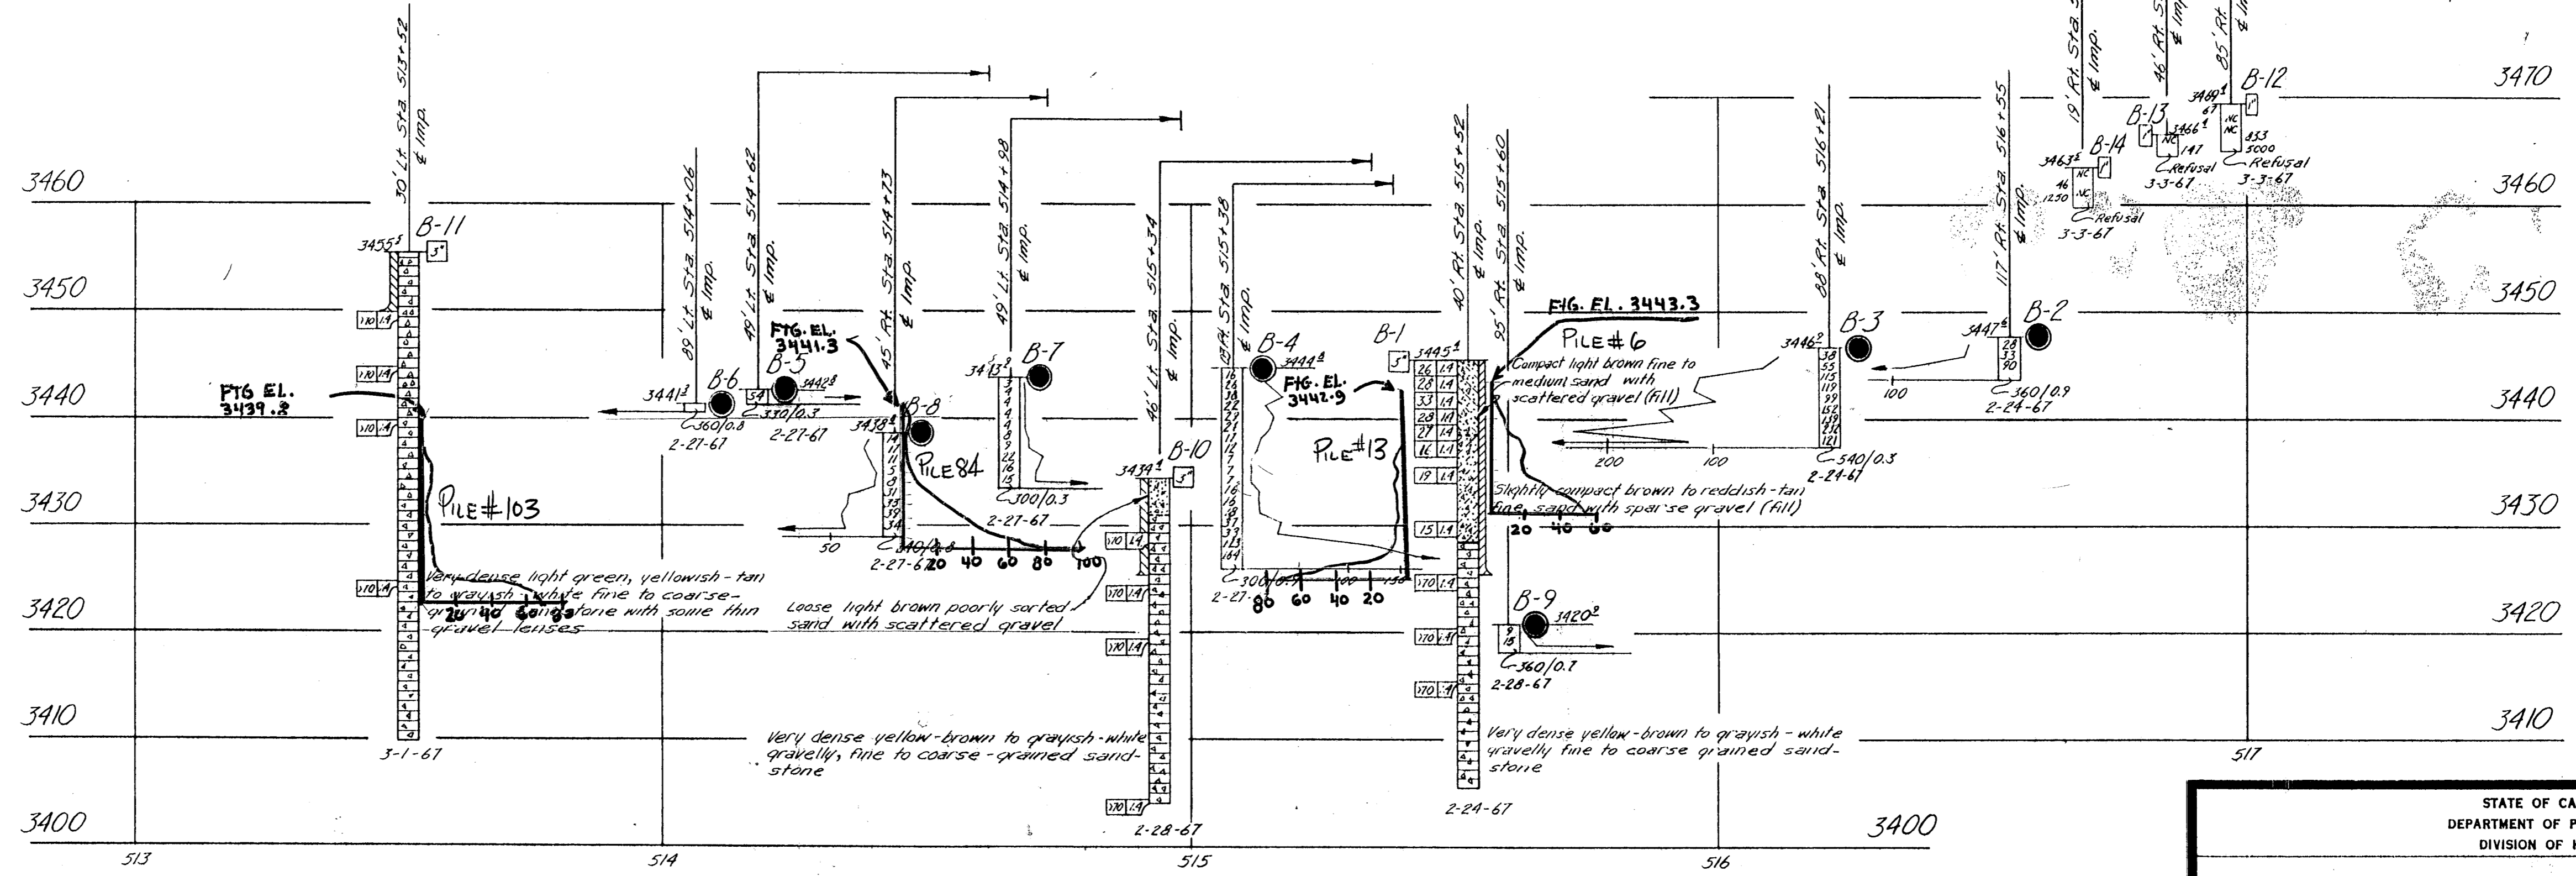

FIELD STUDY	By: J. Crawford 3-3-67
DRAWN	By: G. Alford 3-20-67
CHECKED	By: D. Campbell 3-20-67

LEGEND OF EARTH MATERIALS

GRAVEL	SILTY CLAY OR CLAY SILT
SAND	CLAY
SILT	ORGANIC MATTER
CLAY	FILL MATERIAL
SANDY CLAY OR CLAYEY SAND	IGNEOUS ROCK
SANDY SILT OR SILTY SAND	SEDIMENTARY ROCK
	METAMORPHIC ROCK

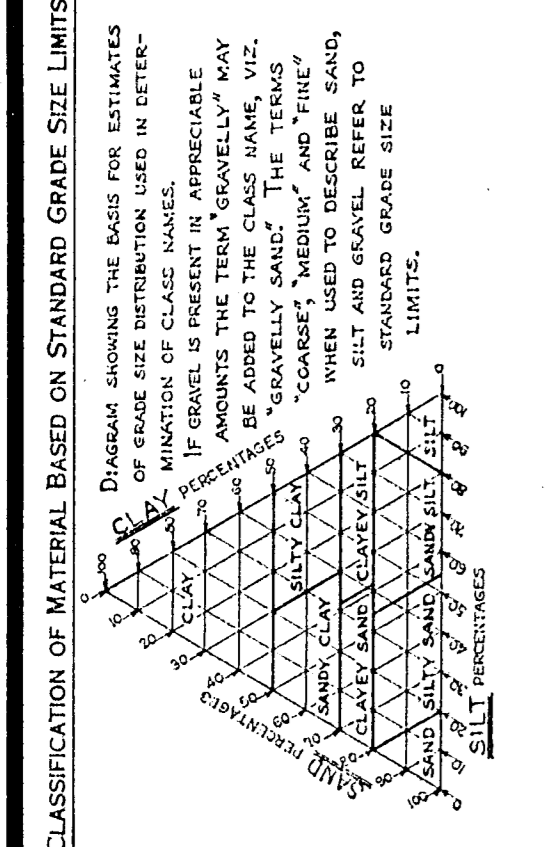

NOTE: Classification of earth material as shown on this sheet is based upon field inspection and is not to be construed to imply mechanical analysis.

STATE OF CALIFORNIA
 DEPARTMENT OF PUBLIC WORKS
 DIVISION OF HIGHWAYS

NORTH ALRAY OVERHEAD

LOG OF TEST BORINGS

SCALE: As Noted | BRIDGE: 5A-827- | P.M.: 22-7 | DRAWING: 34477-8

PREL. DRAWING NO. PR- []

CHK. 08201
 W.A. 049121



Disregard prints bearing earlier numbers

South Forest Road

No As-Builts nor any LOTBs for the South Forest Road Undercrossing (Santa Fe Rd) Caltrans Bridge No. 54-0940R can be located within the online Caltrans GEODog database <https://geodog.dot.ca.gov/>.

Oak Hill Road OC

BM # 7 A 57 Elev. 4077.76
 Spha. no. 1 in 10.30 SA cor. P.C. D.I. 40.5
 Rt. Ex. W P.3 Ba (B) Lt. 66 + 04

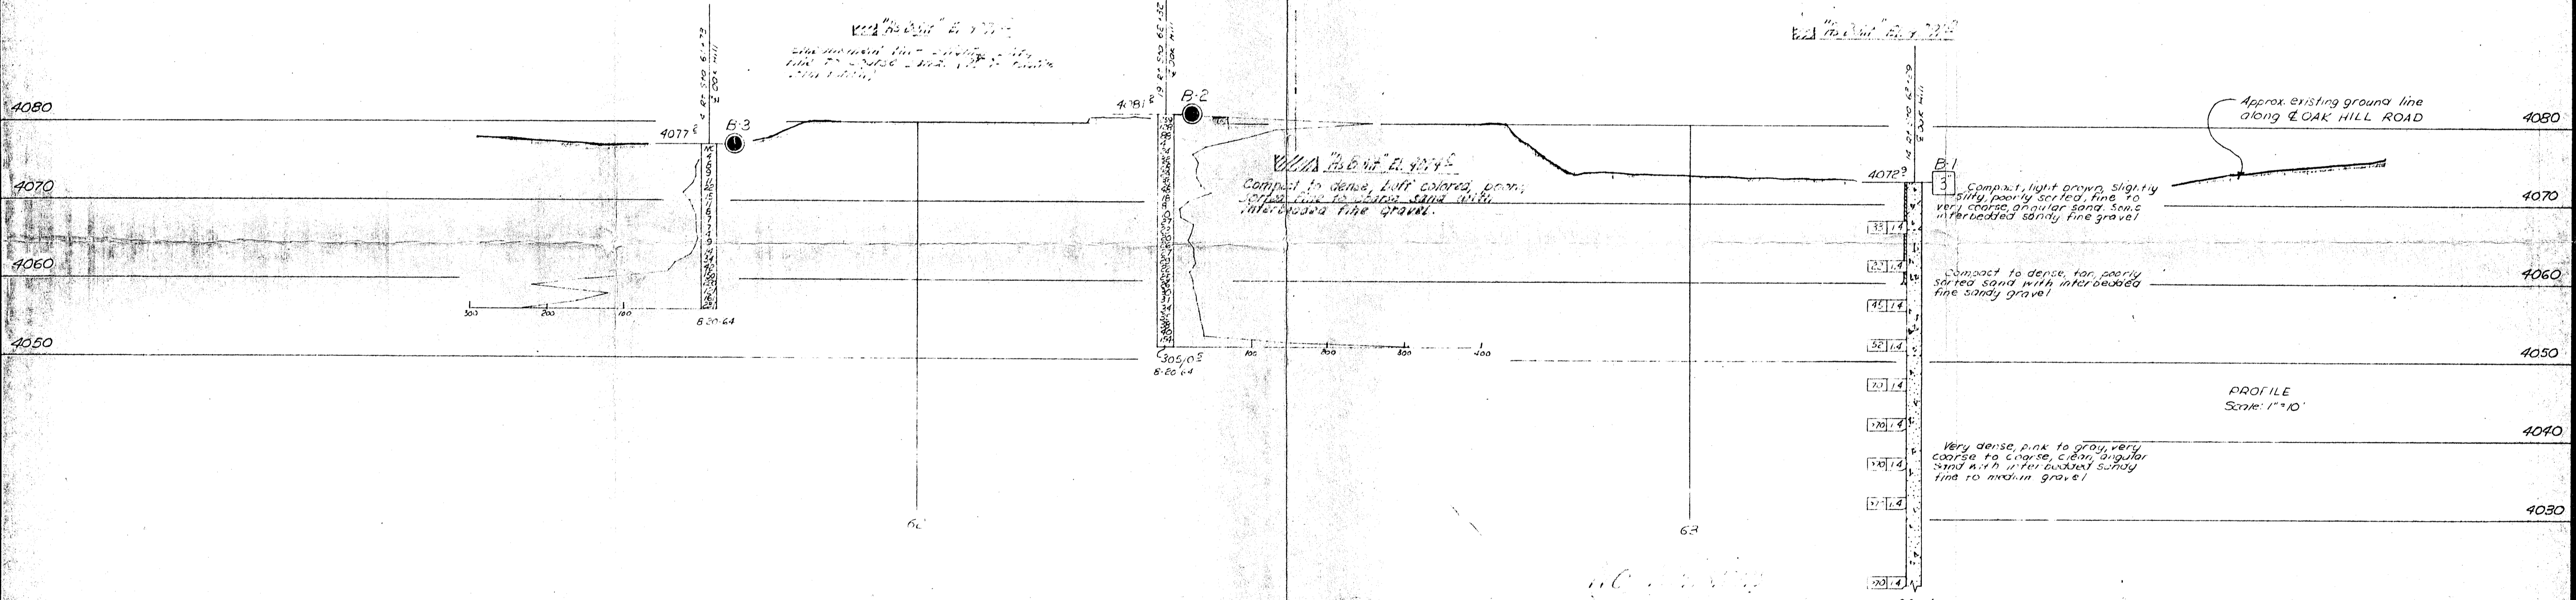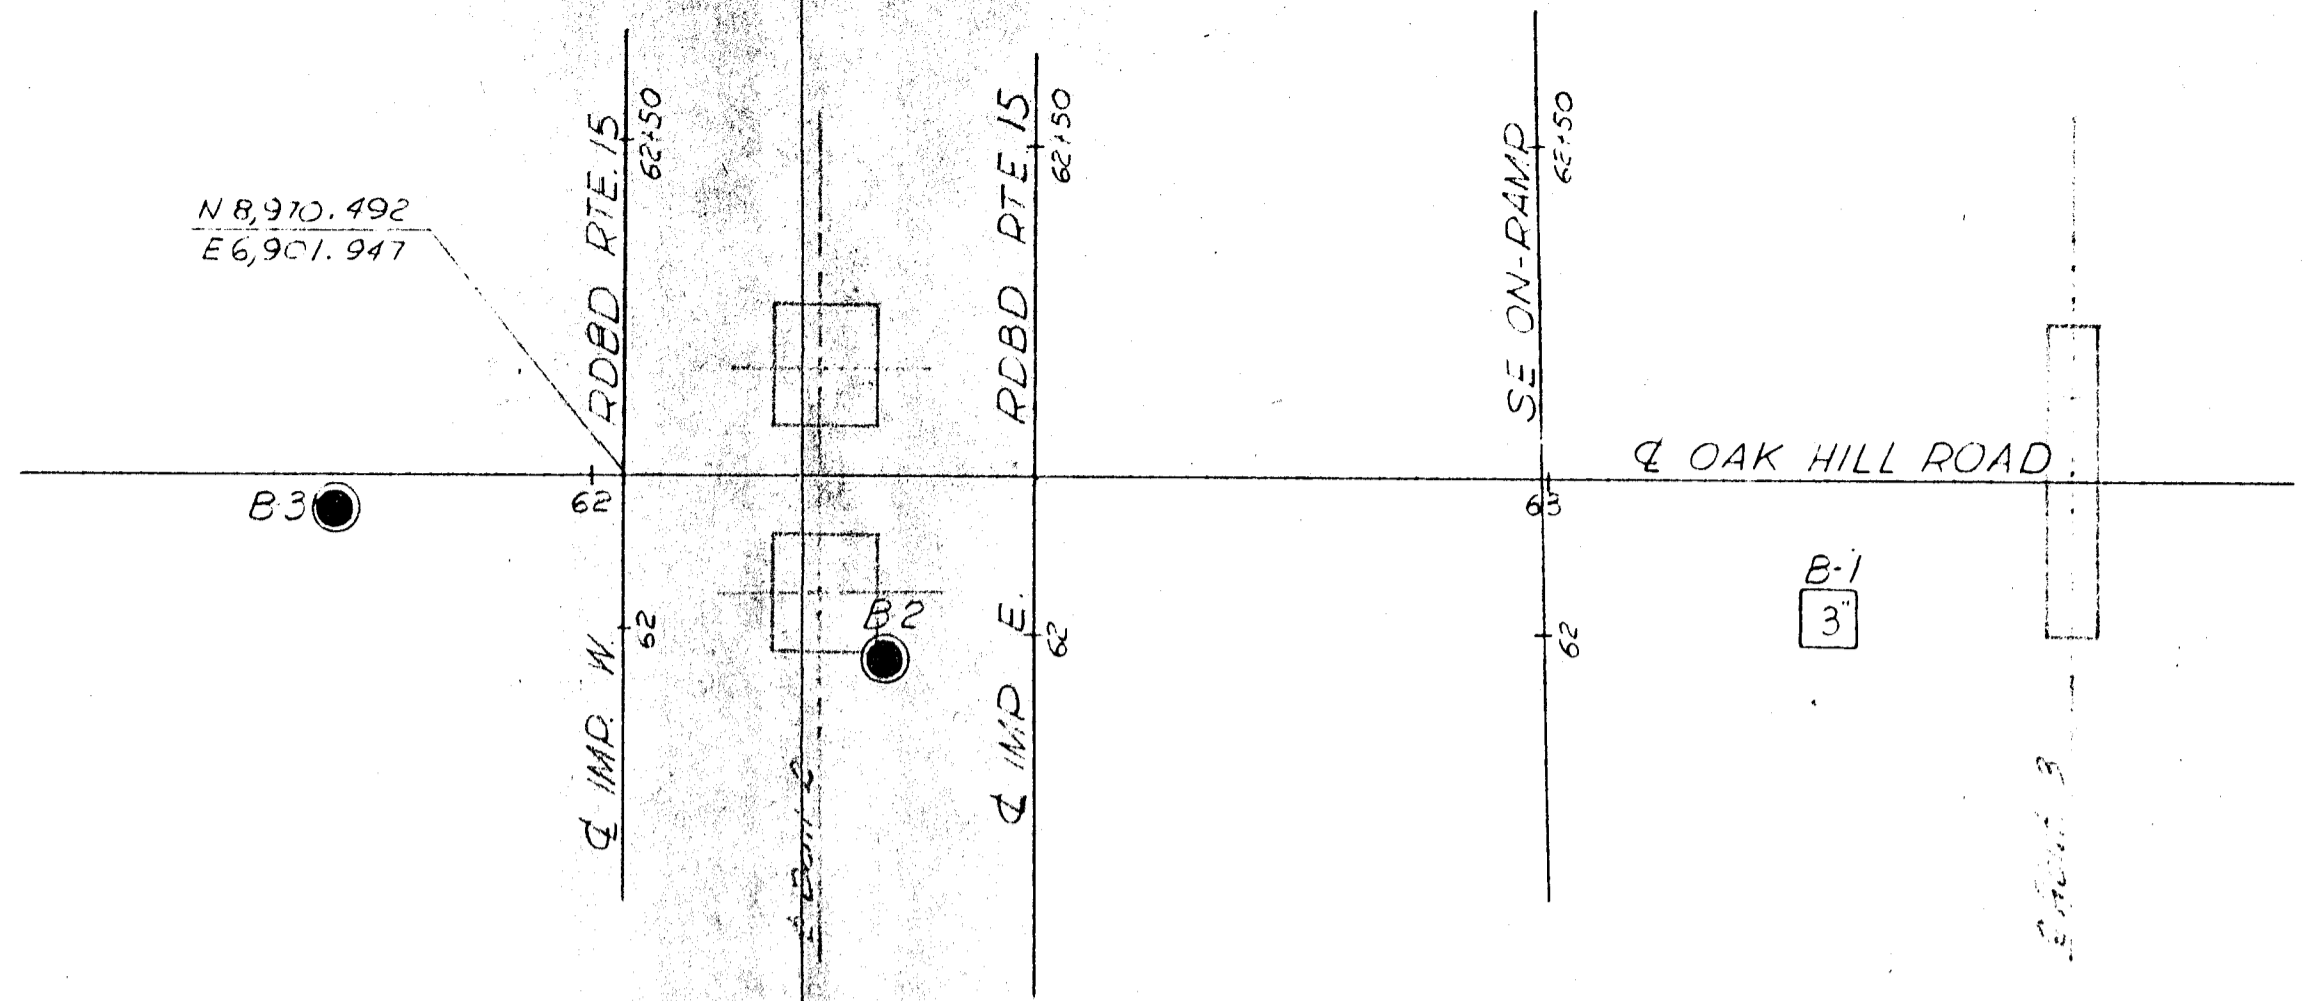


AS BUILT
 CORRECTIONS BY
 CONTRACT NO.
 DATE

NO GROUND WATER ENCOUNTERED
 DURING THIS INVESTIGATION BY
 BRIDGE DEPT. GEOLOGY SECTION
 DATE AUGUST 1964

SHEET	OF
12	12

FIELD STUDY BY C.G. B...
 CHECKED BY...
 DATE...

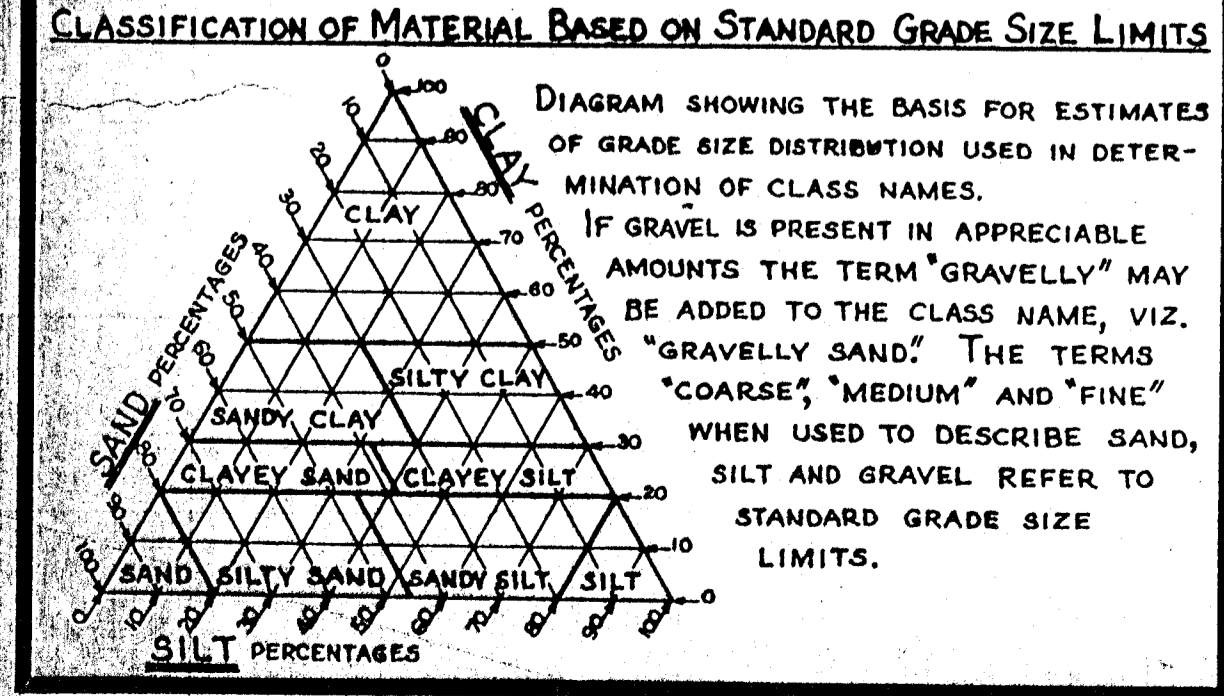

LEGEND OF EARTH MATERIALS

GRAVEL	SILTY CLAY OR CLAYEY SILT
SAND	PEAT AND/OR ORGANIC MATTER
SILT	FILL MATERIAL
CLAY	IGNEOUS ROCK
SANDY CLAY OR CLAYEY SAND	SEDIMENTARY ROCK
SANDY SILT OR SILTY SAND	METAMORPHIC ROCK

LEGEND OF BORING OPERATIONS

● PENETROMETER	○ 2 1/4" CONE PENETROMETER
□ SAMPLER BORING (DRY)	□ ROTARY BORING (WET)
□ AUGER BORING (DRY)	□ JET BORING
□ CORE BORING	□ TEST PIT

NOTE
 Classification of earth material as shown on this sheet is based upon field inspection and is not to be construed to imply mechanical analysis.

STATE OF CALIFORNIA
 DEPARTMENT OF PUBLIC WORKS
 DIVISION OF HIGHWAYS

OAK HILL ROAD OVERCROSSING

LOG OF TEST BORINGS

SCALE As Noted BRIDGE 54-740 FILE PM 286 DRAWING 54740-10

Charge: 08201 WA: 039641

Ranchero Road OC

No As-Builts nor any LOTBs for the Ranchero Road OC Caltrans Bridge No. 54-1285 can be located within the online Caltrans GEODog database <https://geodog.dot.ca.gov/>.

Logs of nearby borings performed for infiltration basins were found in the database.




LOGGED BY K. Barker	BEGIN DATE 2-27-19	COMPLETION DATE 2-27-19	BOREHOLE LOCATION (Lat/Long or North/East and Datum) 34° 23' 1.22" / -117° 24' 56.72" NAD83	HOLE ID A-19-001
DRILLING CONTRACTOR Caltrans		BOREHOLE LOCATION (Offset, Station, Line)		SURFACE ELEVATION -3880.0 ft NAVD88
DRILLING METHOD Hollow-Stem Auger		DRILL RIG CS 2000 (truck)		BOREHOLE DIAMETER 8 in
SAMPLER TYPE(S) AND SIZE(S) (ID) SPT (1.4")		SPT HAMMER TYPE Automatic		HAMMER EFFICIENCY, ERI 94%
BOREHOLE BACKFILL AND COMPLETION grout		GROUNDWATER READINGS	DURING DRILLING N/A	AFTER DRILLING (DATE)
				TOTAL DEPTH OF BORING 50.0 ft

ELEVATION (ft)	DEPTH (ft)	Material Graphics	DESCRIPTION	Sample Location	Sample Number	Blows per 6 in.	Blows per foot	Recovery (%)	RQD (%)	Moisture Content (%)	Dry Unit Weight (pcf)	Shear Strength (tsf)	Drilling Method	Casing Depth	Remarks
3878.00	0		Well-graded SAND with CLAY (SW-SC); dark brown; moist; few to little medium plasticity fines; few fine GRAVEL.												
3876.00	4		SILTY SAND (SM); medium dense; brown; dry; mostly fine and medium SAND; little fines.	S-1	13 6 9	15									
3874.00	6														
3872.00	8														
3870.00	10		Dense; few fine GRAVEL ; weak cementation.	S-2	5 12 14	26									
3868.00	12														
3866.00	14														
3864.00	16		CLAYEY SAND (SC); very dense; dark brown; dry; mostly fine and medium SAND; little fines; moderate cementation.	S-3	11 25 25	50									
3862.00	18														
3860.00	20			S-4	21 22 26	48									
3858.00	22														
3856.00	24														
	25														

(continued)

S BR - STANDARD RTE 15 INFILTRATION BASINS.GPJ CALTRANS LIBRARY (FEB 2017).GLB 3/1/19

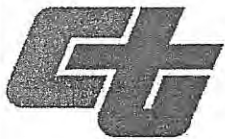

Department of Transportation
 Division of Engineering Services
 Geotechnical Services
 Office of Geotechnical Design - South

REPORT TITLE BORING RECORD				HOLE ID A-19-001	
DIST. 08	COUNTY SBD	ROUTE 15	POSTMILE 30.4	PROJECT ID 0815000244	
PROJECT OR BRIDGE NAME					
BRIDGE NUMBER		PREPARED BY		DATE	SHEET 1 of 2

ELEVATION (ft)	DEPTH (ft)	Material Graphics	DESCRIPTION	Sample Location	Sample Number	Blows per 6 in.	Blows per foot	Recovery (%)	RQD (%)	Moisture Content (%)	Dry Unit Weight (pcf)	Shear Strength (tsf)	Drilling Method	Casing Depth	Remarks	
3854.00	25		SILTY SAND (SM); very dense; brown; dry; mostly fine and medium SAND; little fines; moderate cementation.	S-5	13	38										
	26				17											
	27				21											
3852.00	28		Well-graded SAND with SILT (SW-SM); dense; brown; dry; mostly from fine to coarse SAND; weak cementation.	S-6	9	25										
	29				12											
	30				13											
3848.00	32		Very dense; uncemented.	S-7	12	43										
	33				20											
	34				23											
3846.00	34		Trace fine GRAVEL.	S-8	12	40										
	35				17											
	36				23											
3844.00	36			S-9	12	43										
	37				18											
	38				25											
3842.00	38															
3840.00	40															
3838.00	42															
3836.00	44															
3834.00	46															
3832.00	48															
3830.00	50		Bottom of borehole at 50.0 ft bgs													
	51															
3828.00	52		This Boring Record was developed in accordance with the Caltrans Soil & Rock Logging, Classification, and Presentation Manual (2010) except as noted on the Soil or Rock Legend or below.													
	53															
3826.00	54															
	55															

5 BR - STANDARD RTE-15 INFILTRATION BASINS.GPJ CALTRANS LIBRARY (FEB 2017).GLB 3/1/19



Department of Transportation
 Division of Engineering Services
 Geotechnical Services
 Office of Geotechnical Design - South

REPORT TITLE BORING RECORD				HOLE ID A-19-001	
DIST. 08	COUNTY SBD	ROUTE 15	POSTMILE 30.4	PROJECT ID 0815000244	
PROJECT OR BRIDGE NAME					
BRIDGE NUMBER		PREPARED BY		DATE	
				SHEET 2 of 2	

LOGGED BY K. Barker	BEGIN DATE 2-26-19	COMPLETION DATE 2-26-19	BOREHOLE LOCATION (Lat/Long or North/East and Datum) 34° 23' 3.93" / -117° 24' 53.21" NAD83	HOLE ID A-19-002
DRILLING CONTRACTOR Caltrans			BOREHOLE LOCATION (Offset, Station, Line)	SURFACE ELEVATION ~3871.0 ft NAVD88
DRILLING METHOD Hollow-Stem Auger			DRILL RIG CS 2000 (truck)	BOREHOLE DIAMETER 8 in
SAMPLER TYPE(S) AND SIZE(S) (ID) SPT (1.4")			SPT HAMMER TYPE Automatic	HAMMER EFFICIENCY, ERI 94%
BOREHOLE BACKFILL AND COMPLETION grout			GROUNDWATER READINGS N/A	AFTER DRILLING (DATE)
				TOTAL DEPTH OF BORING 50.0 ft

ELEVATION (ft)	DEPTH (ft)	Material Graphics	DESCRIPTION	Sample Location	Sample Number	Blows per 6 in.	Blows per foot	Recovery (%)	ROD (%)	Moisture Content (%)	Dry Unit Weight (pcf)	Shear Strength (tsf)	Drilling Method	Casing Depth	Remarks
3869.00	1		Well-graded SAND with CLAY and GRAVEL (SW-SC); medium dense; dark brown; moist; little to some fine and coarse GRAVEL.	S-1	3 4 5	9									
3867.00	2														
3865.00	3														
3863.00	4														
3861.00	5														
3859.00	6		CLAYEY SAND (SC); dense; dark brown; moist; mostly fine and mediu SAND; little fines.	S-2	10 12 16	28									
3857.00	7														
3855.00	8														
3853.00	9		Medium dense.	S3	26 6 9	15									
3851.00	10														
3849.00	11														
3847.00	12		Well-graded SAND (SW); medium dense; brown; dry; few fine GRAVEL.	S-4	7 10 12	22									
	13														
	14														
	15		Dense.												

(continued)



Department of Transportation
 Division of Engineering Services
 Geotechnical Services
 Office of Geotechnical Design - South

REPORT TITLE BORING RECORD				HOLE ID A-19-002
DIST. 08	COUNTY SBD	ROUTE 15	POSTMILE 30.4	PROJECT ID 0815000244
PROJECT OR BRIDGE NAME				
BRIDGE NUMBER	PREPARED BY	DATE	SHEET 1 of 2	

6 BR - STANDARD RTE 15 INFILTRATION BASINS.GPJ, CALTRANS LIBRARY (FEB 2017), G.L.B. 3/1/19

ELEVATION (ft)	DEPTH (ft)	Material Graphics	DESCRIPTION	Sample Location	Sample Number	Blows per 6 in.	Blows per foot	Recovery (%)	RCD (%)	Moisture Content (%)	Dry Unit Weight (pcf)	Shear Strength (tsf)	Drilling Method	Casing Depth	Remarks	
3845.00	25	[Material Graphics: Well-graded SAND (SW)]	Weak cementation. Well-graded SAND (SW) (continued). Very dense.	S-5	13 14 17	31										
3843.00	28															
3841.00	30					S-6	10 14 20	34								
3839.00	32															
3837.00	34															
3835.00	36					S-7	13 17 20	37								
3833.00	38															
3831.00	40					S-8	13 19 22	41								
3829.00	42															
3827.00	44															
3825.00	46			S-9	10 17 26	43										
3823.00	48															
3821.00	50		Bottom of borehole at 50.0 ft bgs													
3819.00	52		This Boring Record was developed in accordance with the Caltrans Soil & Rock Logging, Classification, and Presentation Manual (2010) except as noted on the Soil or Rock Legend or below.													
3817.00	54															
	55															

5 BR - STANDARD RTE 15 INFILTRATION BASINS.GPJ CALTRANS LIBRARY (FEB 2017).CLB 3/1/19



Department of Transportation
 Division of Engineering Services
 Geotechnical Services
 Office of Geotechnical Design - South

REPORT TITLE BORING RECORD				HOLE ID A-19-002	
DIST. 08	COUNTY SBD	ROUTE 15	POSTMILE 30.4	PROJECT ID 0815000244	
PROJECT OR BRIDGE NAME					
BRIDGE NUMBER		PREPARED BY		DATE	SHEET 2 of 2

LOGGED BY K. Barker	BEGIN DATE 2-26-19	COMPLETION DATE 2-26-19	BOREHOLE LOCATION (Lat/Long or North/East and Datum) 34° 22' 55.38" / -117° 24' 55.29" NAD83	HOLE ID A-19-003
DRILLING CONTRACTOR Caltrans			BOREHOLE LOCATION (Offset, Station, Line)	SURFACE ELEVATION -3883.0 ft NAVD88
DRILLING METHOD Hollow-Stem Auger			DRILL RIG CS 2000 (truck)	BOREHOLE DIAMETER 8 in
SAMPLER TYPE(S) AND SIZE(S) (ID) SPT (1.4")			SPT HAMMER TYPE Automatic	HAMMER EFFICIENCY, ERI 94%
BOREHOLE BACKFILL AND COMPLETION grout			GROUNDWATER READINGS DURING DRILLING N/A	AFTER DRILLING (DATE)
				TOTAL DEPTH OF BORING 51.5 ft

ELEVATION (ft)	DEPTH (ft)	Material Graphics	DESCRIPTION	Sample Location	Sample Number	Blows per 6 in.	Blows per foot	Recovery (%)	RCD (%)	Moisture Content (%)	Dry Unit Weight (pcf)	Shear Strength (tsf)	Drilling Method	Casing Depth	Remarks
0	0														
3881.00	1		CLAYEY SAND (SC); dark brown; moist; mostly from fine to coarse SAND; little fines; few fine GRAVEL.												
3879.00	2														
3877.00	3														
3875.00	4		SILTY SAND (SM); dense; brown; dry; mostly from fine to coarse SAND; little fines; few fine GRAVEL.												
3873.00	5														
3871.00	6			S-1	11	30									
3869.00	7				14										
3867.00	8				16										
3865.00	9														
3863.00	10		Very dense; trace fine GRAVEL; moderate cementation.	S-2	17	36									
3861.00	11				17										
3859.00	12				19										
3857.00	13														
3865.00	14			S3	11	32									
3863.00	15				15										
3861.00	16				17										
3859.00	17														
3857.00	18		Weak cementation.	S-4	15	43									
3855.00	19				19										
3853.00	20				24										
3851.00	21		Few fine and coarse GRAVEL.												
3849.00	22														
3847.00	23														
3845.00	24														
3843.00	25														

(continued)

5 BR - STANDARD RTE 15 INFILTRATION BASINS.GPJ CALTRANS LIBRARY (FEB 2017).GLB 3/1/19



Department of Transportation
 Division of Engineering Services
 Geotechnical Services
 Office of Geotechnical Design - South

REPORT TITLE BORING RECORD				HOLE ID A-19-003	
DIST. 08	COUNTY SBD	ROUTE 15	POSTMILE 30.4	PROJECT ID 0815000244	
PROJECT OR BRIDGE NAME					
BRIDGE NUMBER		PREPARED BY		DATE	SHEET 1 of 2

5 BR - STANDARD, RTE 15 INFILTRATION BASINS.GPJ CALTRANS LIBRARY (FEB 2017).GLB 3/1/19

ELEVATION (ft)	DEPTH (ft)	Material Graphics	DESCRIPTION	Sample Location	Blows per 6 in.	Blows per foot	Recovery (%)	RQD (%)	Moisture Content (%)	Dry Unit Weight (pcf)	Shear Strength (tsf)	Drilling Method	Remarks
				Sample Number									
3857.00	25		Dense, SILTY SAND (SM) (continued).	S-5	15	30							
	26		Poorly graded SAND with SILT (SP-SM); dense; brown; dry; mostly fine SAND; weak cementation.		13								
	27				17								
3855.00	28												
	29												
3853.00	30		Very dense; fine and medium SAND; trace fine GRAVEL; no cementation.	S-6	11	46							
	31				21								
	32				25								
3851.00	33												
	34												
3849.00	35												
	36			S-7	11	35							
	37				16								
3847.00	38				19								
	39												
3845.00	40												
	41			S-8	13	41							
	42				19								
	43				22								
3841.00	44												
	45												
3839.00	46		Few fine GRAVEL.	S-9	12	43							
	47				21								
	48				22								
3837.00	49												
	50												
3835.00	51		Well-graded SAND with SILT (SW-SM); very dense; brown; dry.	S-10	15	50							
	52				21								
	53				29								
3833.00	54		Bottom of borehole at 51.5 ft bgs										
	55												
3829.00			This Boring Record was developed in accordance with the Caltrans Soil & Rock Logging, Classification, and Presentation Manual (2010) except as noted on the Soil or Rock Legend or below.										



Department of Transportation
 Division of Engineering Services
 Geotechnical Services
 Office of Geotechnical Design - South

REPORT TITLE BORING RECORD				HOLE ID A-19-003	
DIST. 08	COUNTY SBD	ROUTE 15	POSTMILE 30.4	PROJECT ID 0815000244	
PROJECT OR BRIDGE NAME					
BRIDGE NUMBER		PREPARED BY		DATE	SHEET 2 of 2



West Hesperia Overhead

FED. ROAD DIV. NO.	STATE	PROJ. NO.	FISCAL YEAR	SHEET NO.	TOTAL SHEETS
7	CAL.				

DATE	DRAWN BY	ROUTE	SECTION	SHEET NO.	TOTAL SHEETS
VIII	SBD	31	C		

BENCH MARK 20-B-57
 Solid nail in Lead of SE'y cor.
 01 36' at 104' 100' C₂'
 EI 3801.87

PLAN
 Scale: 1" = 50'

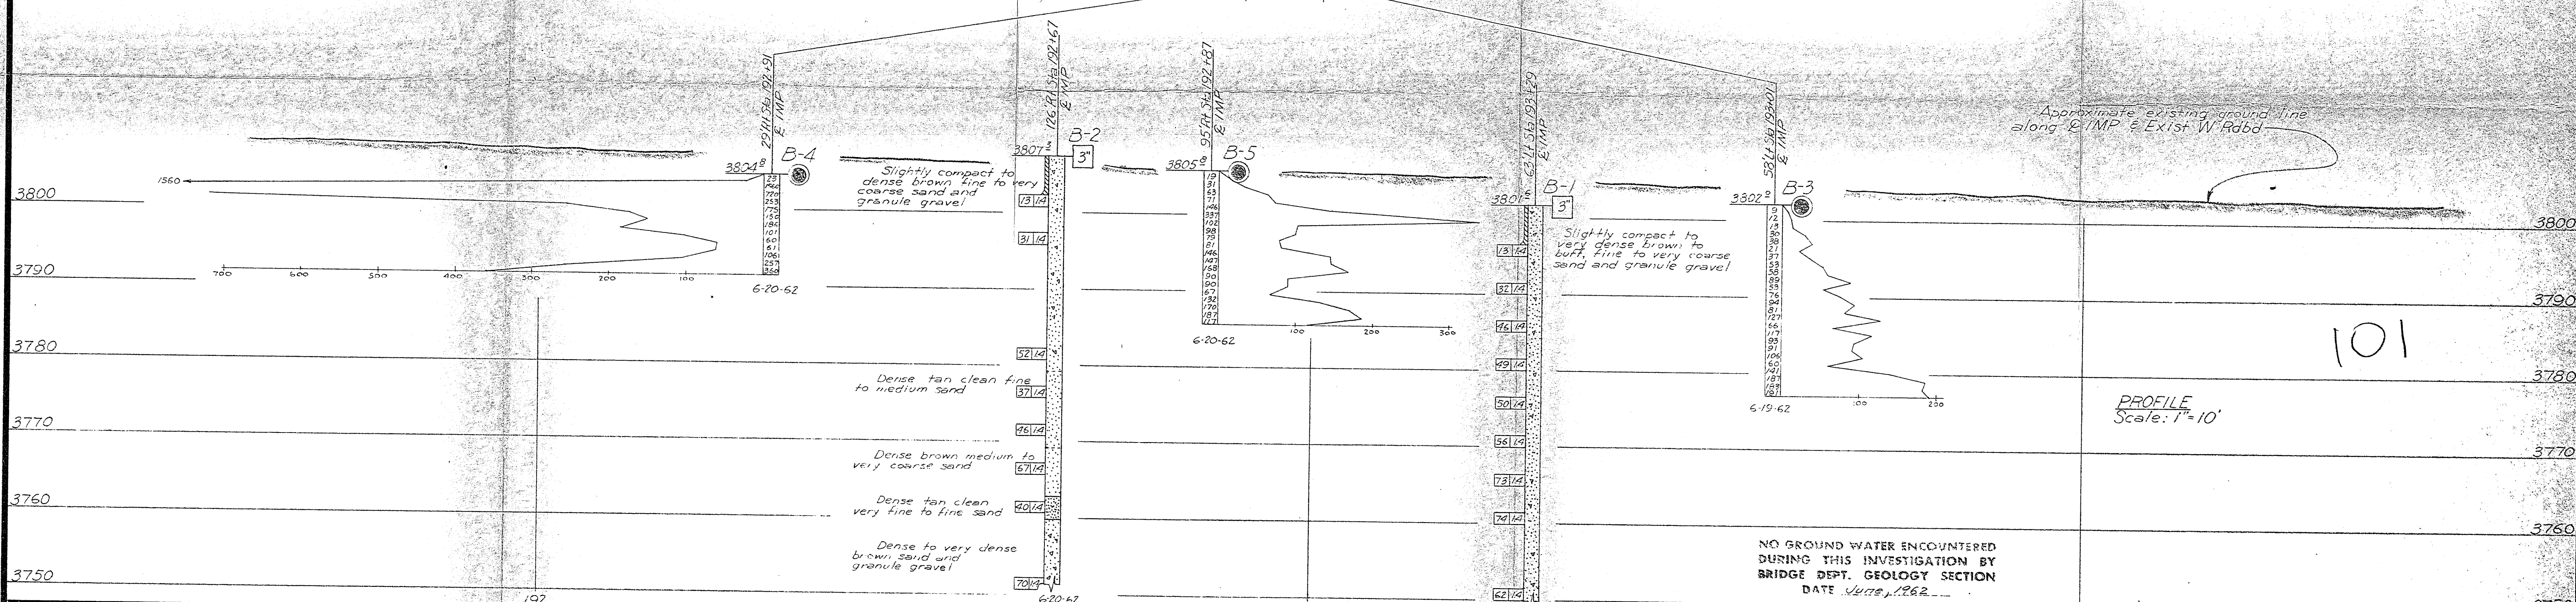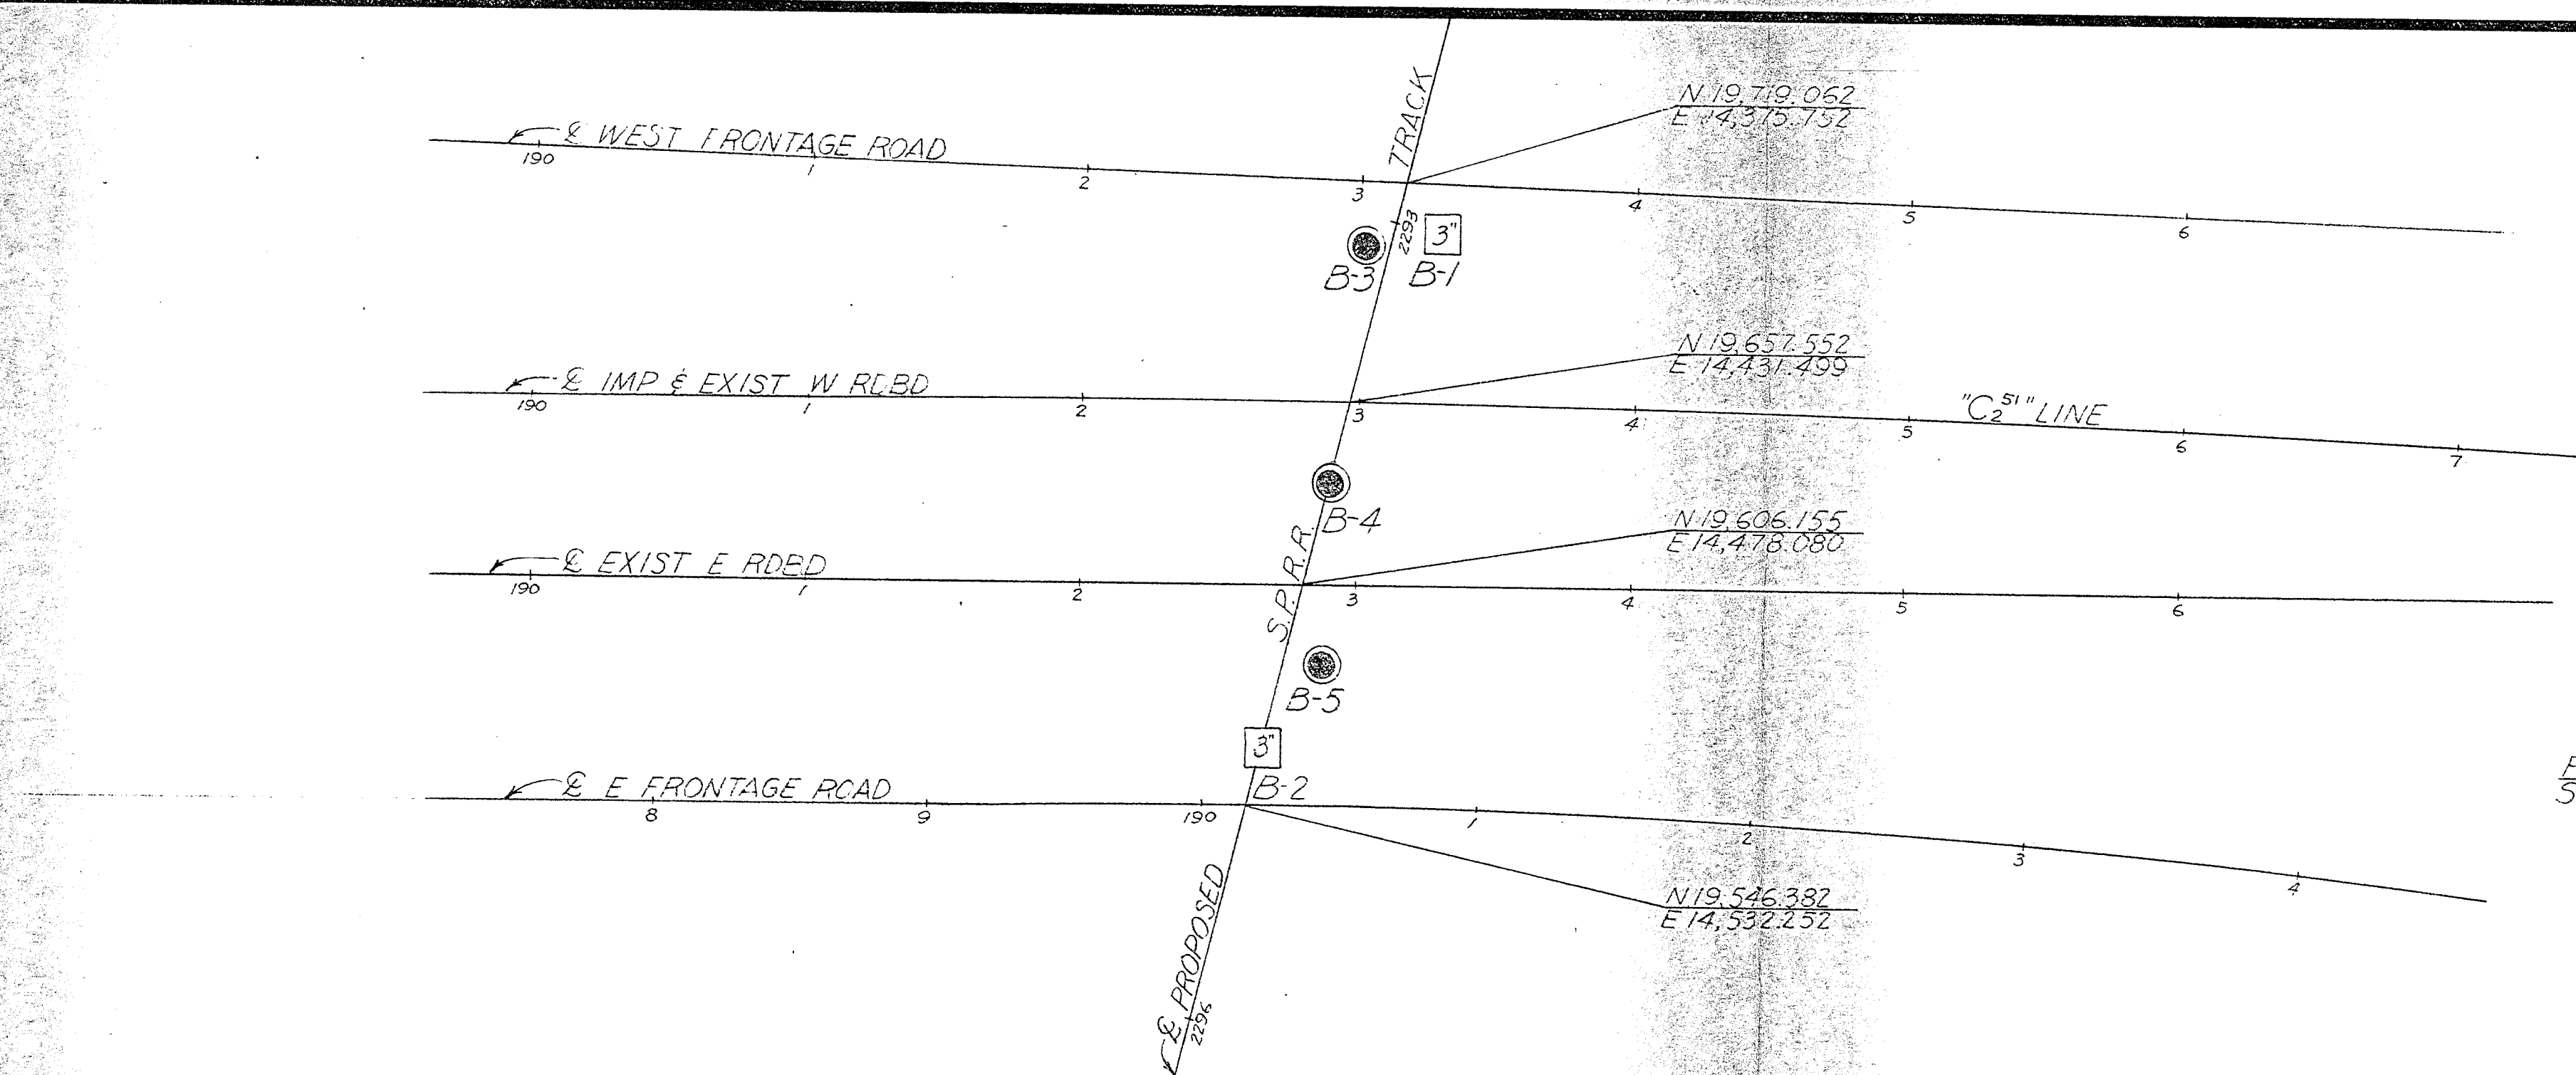


PROFILE
 Scale: 1" = 10'

NO GROUND WATER ENCOUNTERED
 DURING THIS INVESTIGATION BY
 BRIDGE DEPT. GEOLOGY SECTION
 DATE MURS, 1962

FIELD STUDY
 by Espen 6-20-62
 DRAWN
 by Eskine 7-10-62
 CHECKED
 by Espen 7-11-62
 Approval Recommended by
 [Signature]
 Engineer in Charge
 Alvin H. Kistner, Engineer

CLASSIFICATION OF MATERIAL BASED ON STANDARD GRADE SIZE LIMITS

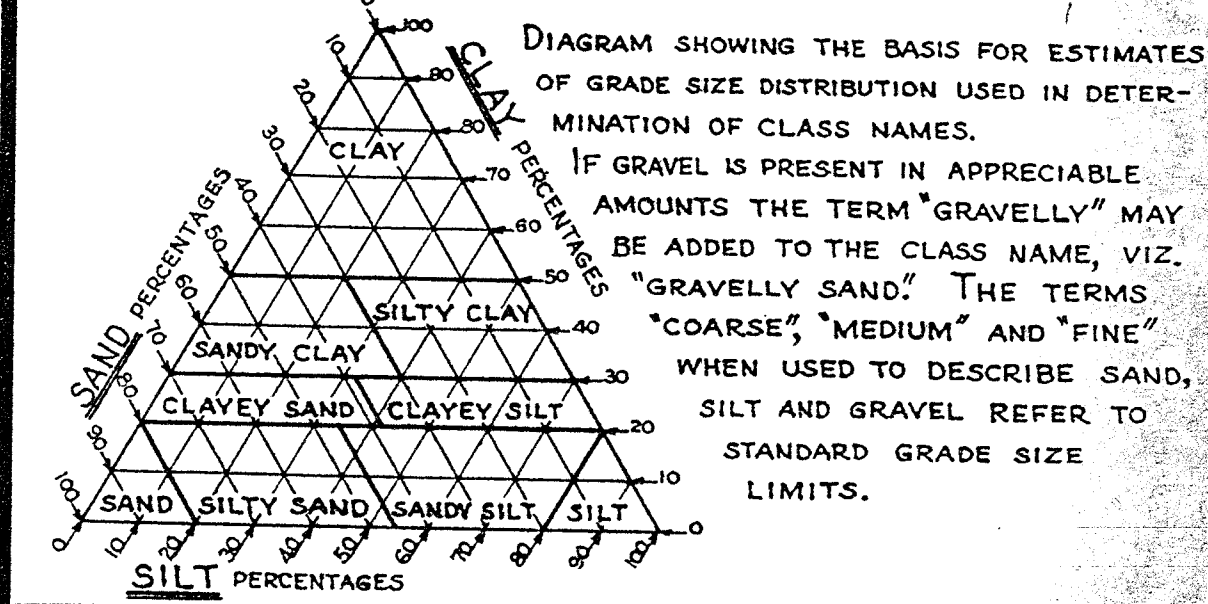

LEGEND OF EARTH MATERIALS

- GRAVEL
- SAND
- SILT
- CLAY
- SANDY CLAY OR CLAYEY SAND
- SANDY SILT OR SILTY SAND
- SILTY CLAY OR CLAYEY SILT
- PEAT AND/OR ORGANIC MATTER
- FILL MATERIAL
- IGNEOUS ROCK
- SEDIMENTARY ROCK
- METAMORPHIC ROCK

LEGEND OF BORING OPERATIONS

PENETROMETER
 2 1/4" CONE PENETROMETER
 SAMPLER BORING (DRY)
 ROTARY BORING (WET)
 AUGER BORING (DRY)
 JET BORING
 CORE BORING
 TEST PIT

1" SOIL TUBE
 Top Hole El. Location B-N2
 Blows per Foot (Using 140 lb hand hammer with a 12" Free Fall)
 Date Measured
 Description of material
 Sample taken
 Refusal
 Date of boring

ROTARY BORING
 Top Hole El. Location B-N2
 Casing driven
 G.W.S. Elev.
 Description of material
 Unit weight (#/cu ft)
 % Moisture
 Consolidation Test
 G.W.S. Elev.
 Date Measured
 Conformable material change
 Unconformable material change
 Vane shear
 Shear strength (#/sq ft)
 Friction above this point (#/sq ft)

PENETRATION BORING
 Top Hole El. Location B-N2
 Pushed
 G.W.S. Elev.
 Date Measured
 No count recorded
 Seconds per Foot (Using a NR2, McKiernan-Terry Air hammer @ 115 psi, or as noted)
 Average skin Friction above this point (#/sq ft)

NOTE

Classification of earth material as shown on this sheet is based upon field inspection and is not to be construed to imply mechanical analysis.

STATE OF CALIFORNIA
 DEPARTMENT OF PUBLIC WORKS
 DIVISION OF HIGHWAYS

WEST HESPERIA OVERHEAD
 LOG OF TEST BORINGS


Scale As Noted BRIDGE 54-664 FILE DRAWING

BRIDGE DEPARTMENT

N15-N395 Connector OC

DATE	BY	CHKD	APP'D
JAN 13 1984			


BM # 24-B-57
 Spd. nail in 2x8 Rwd. A111 buried
 7' 39" At Sta 231+00
 Elev. 3731.64

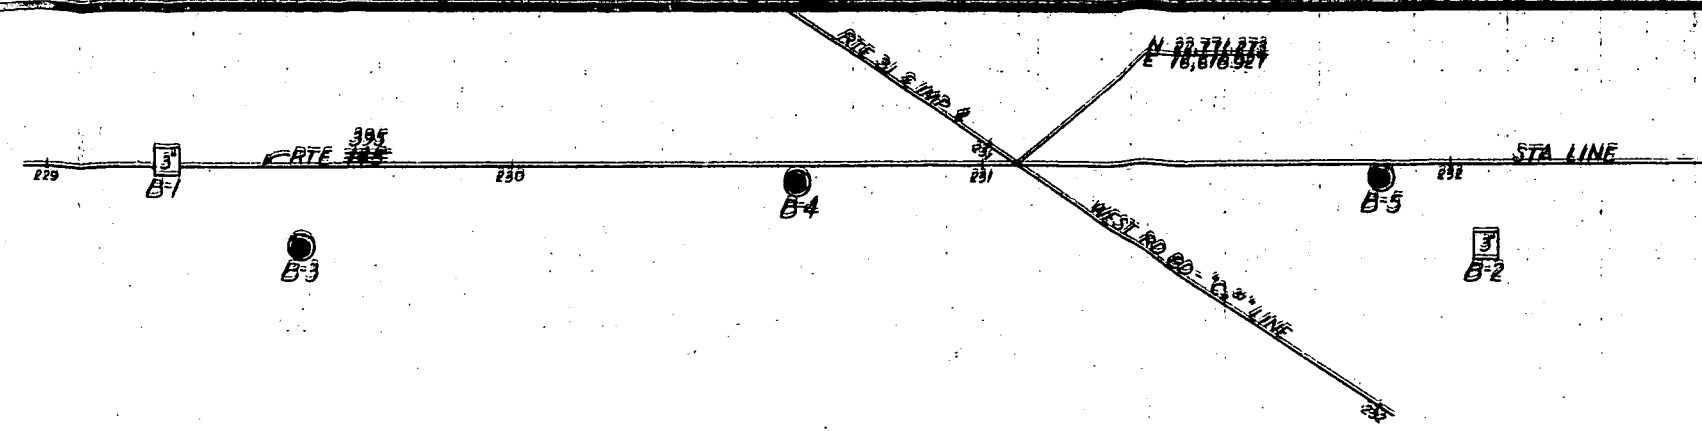

REDUCED PLAN
 USE SCALE BELOW


BRIDGE DEPARTMENT

Approximate existing ground line along Rte 145

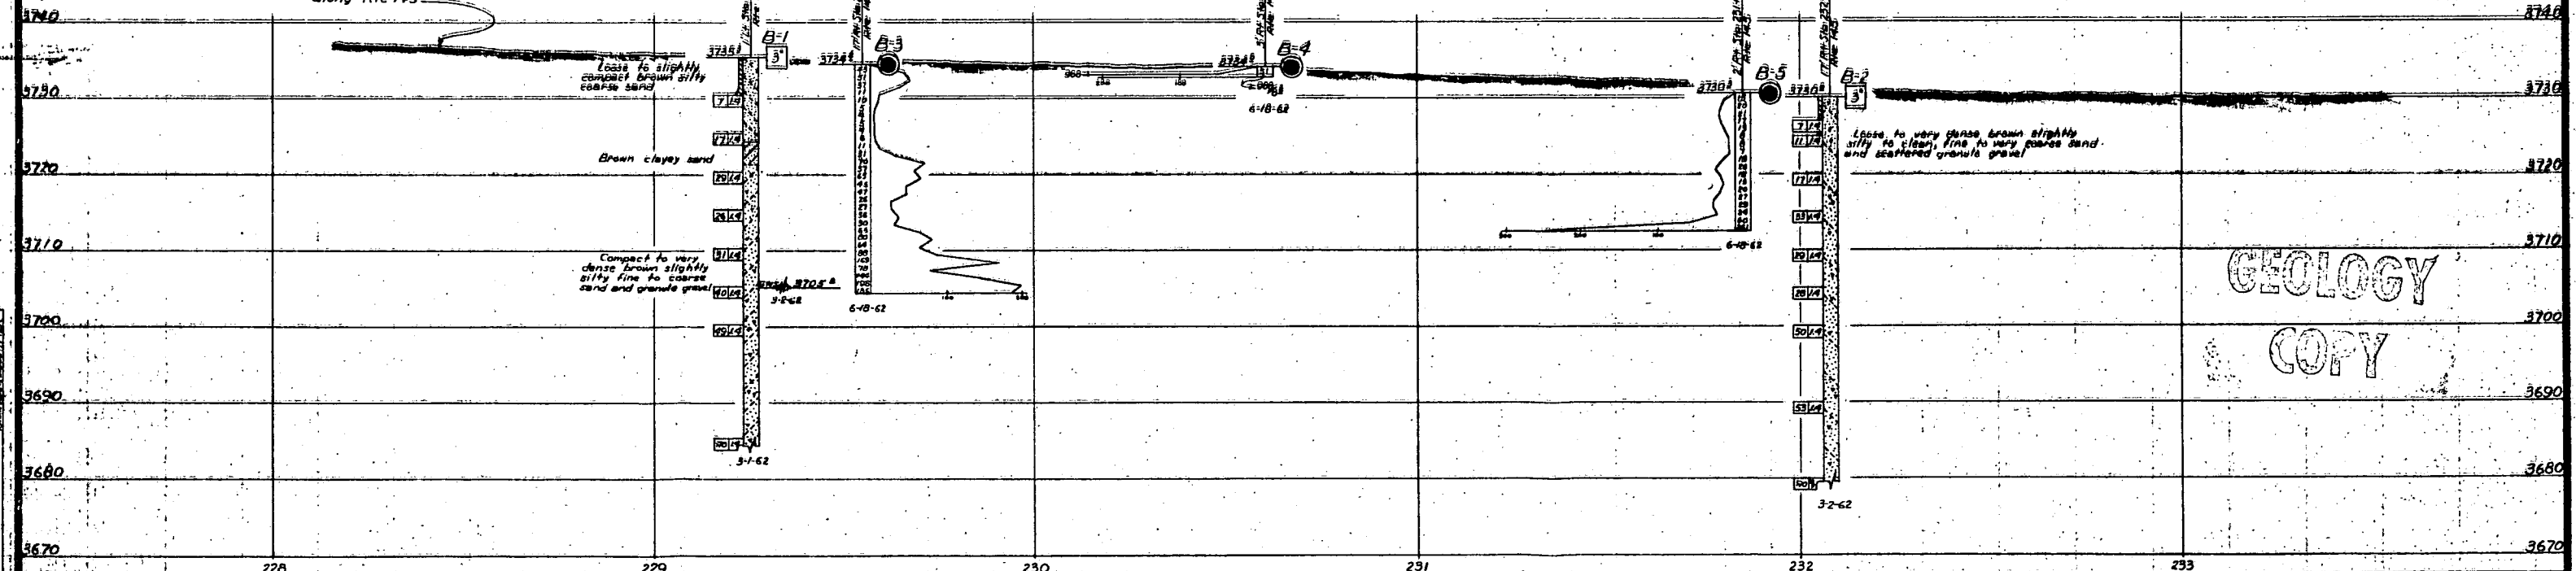

GEOLOGY
COPY

CLASSIFICATION OF MATERIAL BASED ON STANDARD GRADE SIZE LIMITS

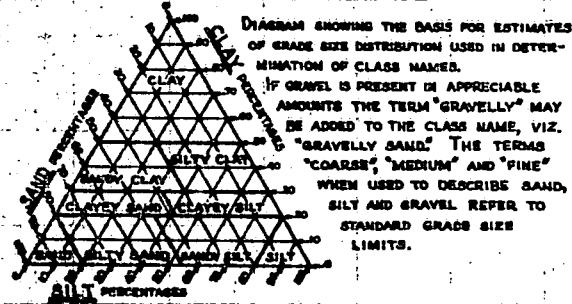

LEGEND OF EARTH MATERIALS

- GRAVEL
- SAND
- SILT
- CLAY
- SANDY CLAY OR CLAYEY SAND
- SANDY SILT OR SILTY SAND
- SILTY CLAY OR CLAYEY SILT
- PEAT AND/OR ORGANIC MATTER
- FILL MATERIAL
- IGNEOUS ROCK
- SEDIMENTARY ROCK
- METAMORPHIC ROCK

LEGEND OF BORING OPERATIONS

- PENETROMETER
- 2 1/2" CONE PENETROMETER
- SAMPLER BORING (DRY)
- ROTARY BORING (WET)
- AUGER BORING (DRY)
- JET BORING
- CORE BORING
- TEST PIT

NOTE

Classification of earth material as shown on this sheet is based upon field inspection and is not to be construed to imply mechanical analysis.

STATE OF CALIFORNIA DEPARTMENT OF PUBLIC WORKS DIVISION OF HIGHWAYS	
BHEET	OF
12	12

395/15
 RTE 145 SEPARATION
LOG OF TEST BORINGS

SCALE Horiz. 1"=20'
 Vert. 1"=10'

BRIDGE 54-665 FILE DRAWING SALS-10

Joshua Street (Palm Avenue) OC


(New VIII-58d-15)

FED. ROAD DIV. NO.	STATE	PROJ. NO.	FISCAL YEAR	SHEET NO.	TOTAL SHEETS
7	CAL.				

VIII SBD	COUNTY	ROUTE	SECTION	SHEET NO.	TOTAL SHEETS
VIII SBD	31	C	82	82	

ENGINEER: *[Signature]*
 DATE APPROVED: January 13, 1964

BENCH MARK #26-B-57
 Spyd. nail in 2"x2" Fwd. Hub buried 1'
 39' Rt Sta 251+00 "C₂" Line
 EL. 3680.75

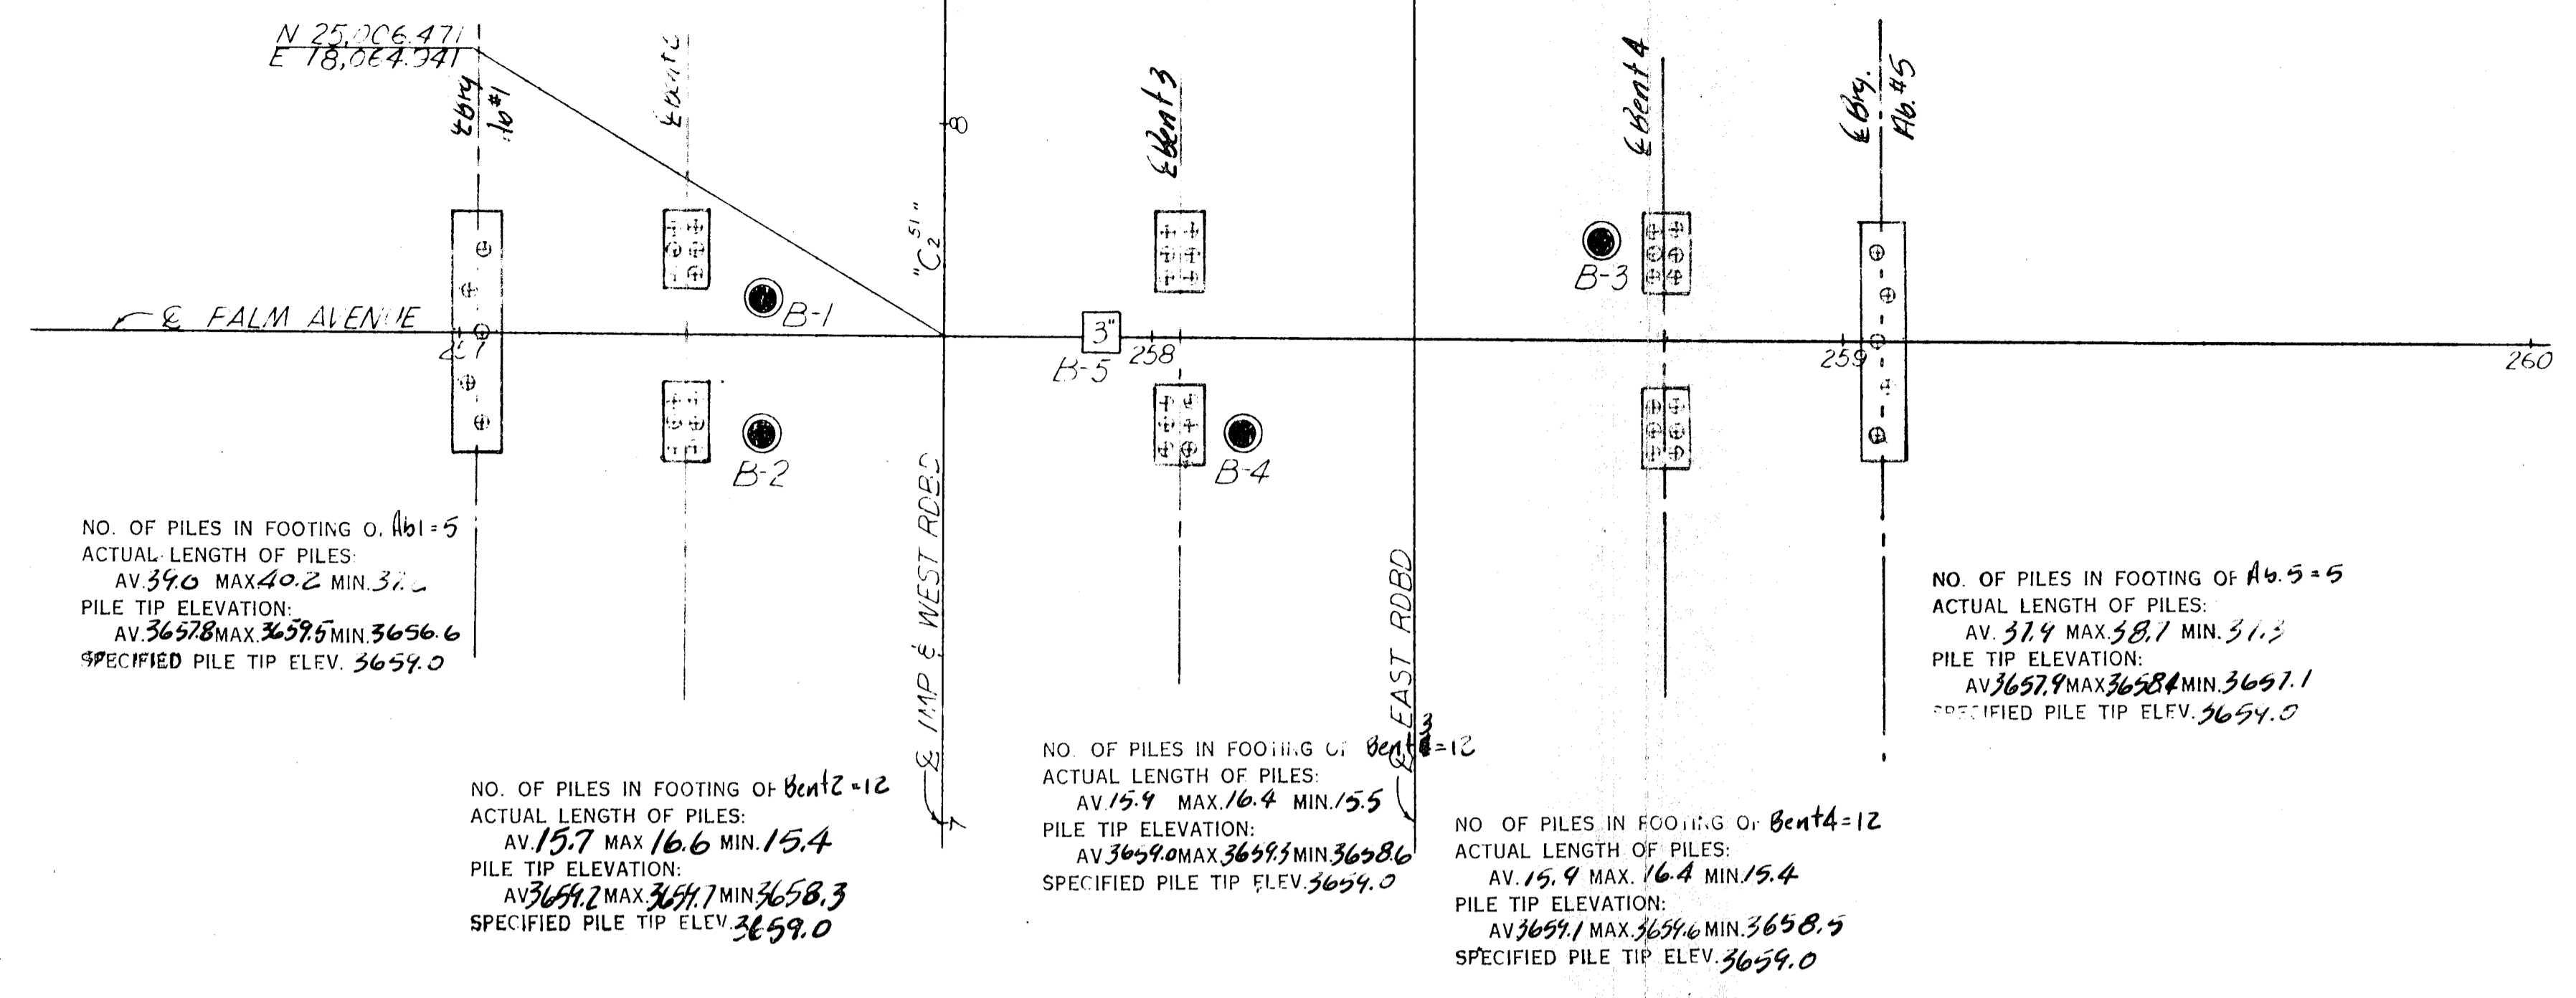

NO. OF PILES IN FOOTING OF Bent 1-5
 ACTUAL LENGTH OF PILES:
 AV. 39.0 MAX. 40.2 MIN. 37.2
 PILE TIP ELEVATION:
 AV. 3657.8 MAX. 3659.5 MIN. 3656.6
 SPECIFIED PILE TIP ELEV. 3659.0

NO. OF PILES IN FOOTING OF Bent 3-5
 ACTUAL LENGTH OF PILES:
 AV. 31.9 MAX. 33.1 MIN. 31.3
 PILE TIP ELEVATION:
 AV. 3657.9 MAX. 3658.4 MIN. 3657.1
 SPECIFIED PILE TIP ELEV. 3659.0

NO. OF PILES IN FOOTING OF Bent 2-12
 ACTUAL LENGTH OF PILES:
 AV. 15.7 MAX. 16.6 MIN. 15.4
 PILE TIP ELEVATION:
 AV. 3654.2 MAX. 3657.7 MIN. 3658.3
 SPECIFIED PILE TIP ELEV. 3659.0


NO. OF PILES IN FOOTING OF Bent 4-12
 ACTUAL LENGTH OF PILES:
 AV. 15.9 MAX. 16.4 MIN. 15.5
 PILE TIP ELEVATION:
 AV. 3659.0 MAX. 3659.5 MIN. 3658.6
 SPECIFIED PILE TIP ELEV. 3659.0

NO. OF PILES IN FOOTING OF Bent 4-12
 ACTUAL LENGTH OF PILES:
 AV. 15.9 MAX. 16.4 MIN. 15.4
 PILE TIP ELEVATION:
 AV. 3659.1 MAX. 3659.6 MIN. 3658.5
 SPECIFIED PILE TIP ELEV. 3659.0

~~PILE DATA
 TYPE OF PILE
 HAMMER DATA
 PILE DIAMETER: TIP BUTT
 PILE DESIGN LOAD =
 FOR THE STRUCTURE:
 NUMBER OF PILES
 EST. LENGTH OF PILING~~


PILE DATA
 TYPE OF PILE C10H
 HAMMER DATA P4C Ayer R9
 PILE DIAMETER: TIP 16" BUTT 16"
 PILE DESIGN LOAD = 45 T
 FOR THE STRUCTURE:
 NUMBER OF PILES = 46
 EST. LENGTH OF PILING = 950 lf.
 ACTUAL = 954.2 lf.

AS BUILT
 CORRECTIONS BY PPS
 CONTRACT NO. 0803962A (64-BV13C29-T)
 DATE 8/24/64

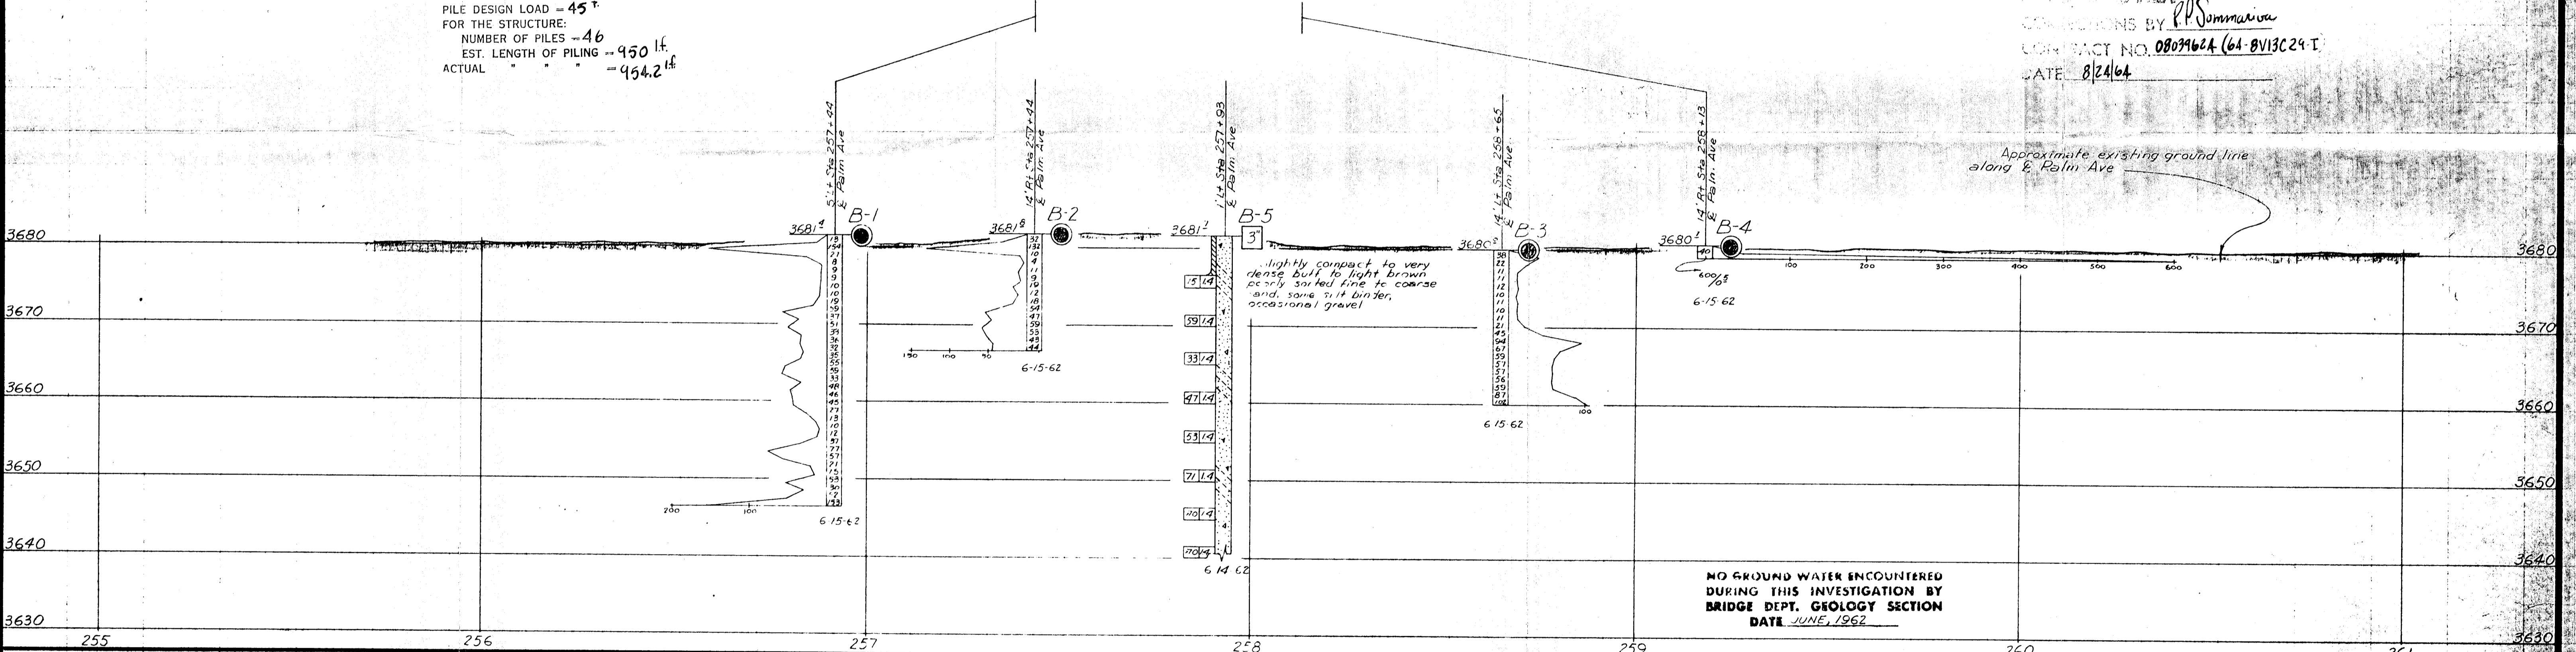


NO GROUND WATER ENCOUNTERED
 DURING THIS INVESTIGATION BY
 BRIDGE DEPT. GEOLOGY SECTION
 DATE JUNE, 1962

FIELD STUDY
 DRAWN
 CHECKED
 Approved Recommended by: *[Signature]*
 Charles E. Pope

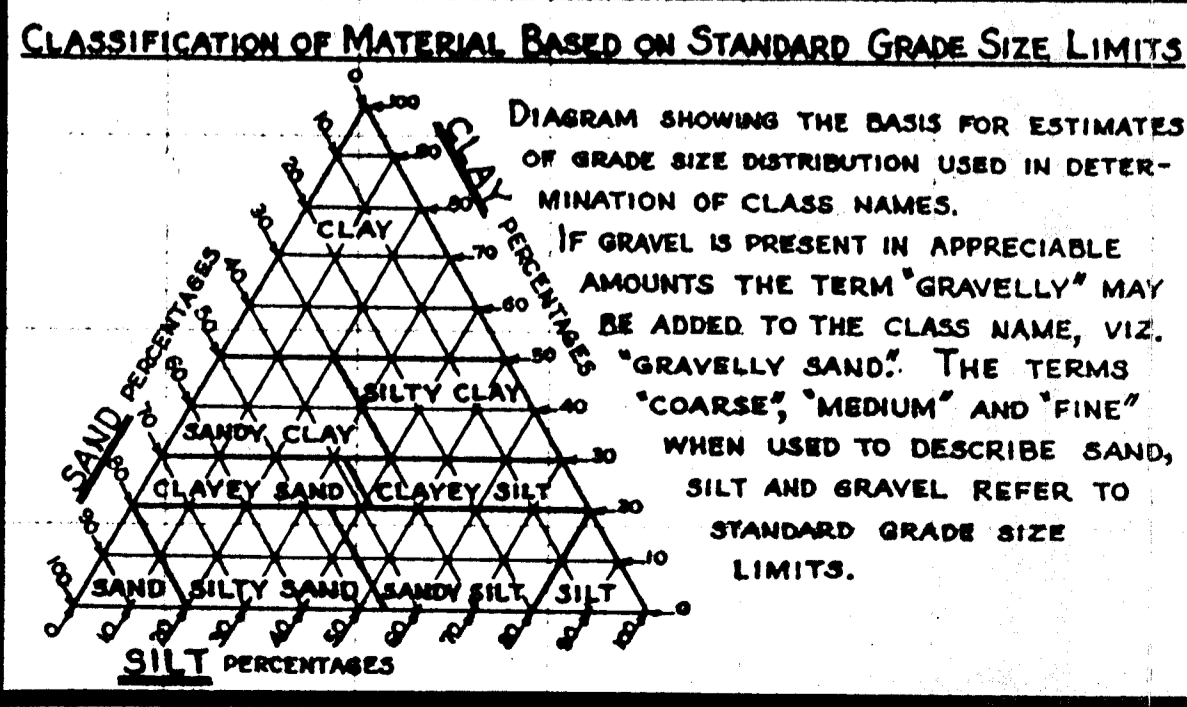

LEGEND OF EARTH MATERIALS

GRAVEL	SILTY CLAY OR CLAYEY SILT
SAND	PEAT AND/OR ORGANIC MATTER
SILT	FILL MATERIAL
CLAY	IGNEOUS ROCK
SANDY CLAY OR CLAYEY SAND	SEDIMENTARY ROCK
SANDY SILT OR SILTY SAND	METAMORPHIC ROCK

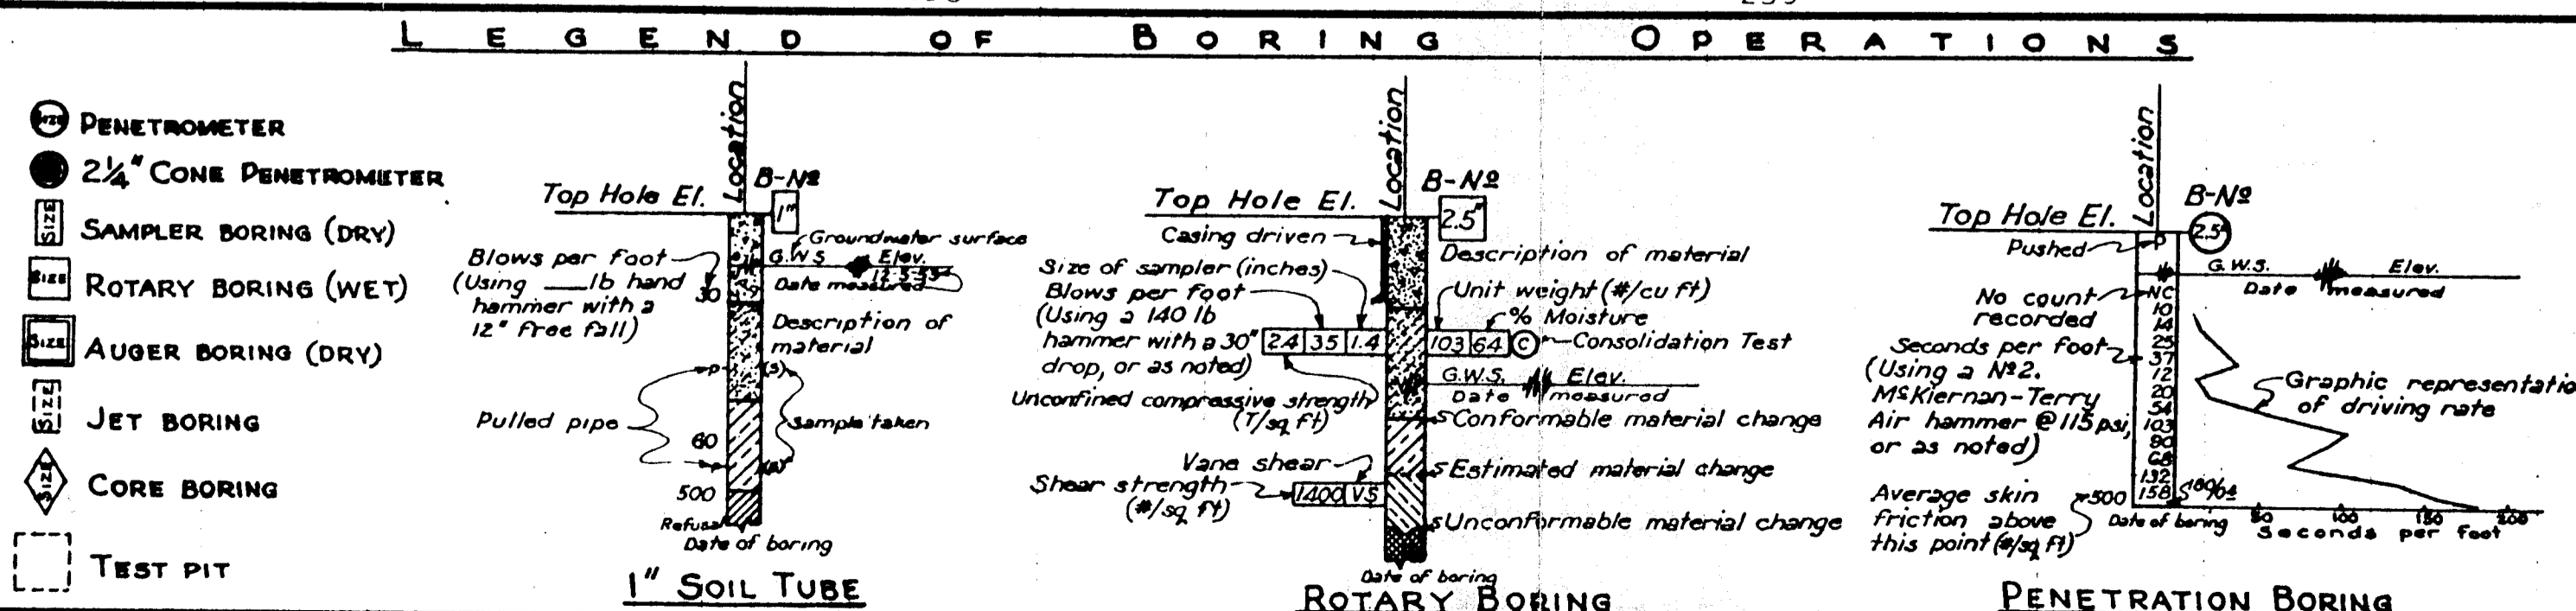

NOTE
 Classification of earth material as shown on this sheet is based upon field inspection and is not to be construed to imply mechanical analysis.

STATE OF CALIFORNIA
 DEPARTMENT OF PUBLIC WORKS
 DIVISION OF HIGHWAYS

SHEET 9 OF 9

PALM AVENUE OVERCROSSING

LOG OF TEST BORINGS

Scale: Horiz. 1"=20', Vert. 1"=10'
 BRIDGE 54-666 FILE DRAWING 54666-9

PRINTED ON CLEARPRINT 1303 H


BRIDGE DEPARTMENT

82

Main Street

The State of California or its officers or agents shall not be responsible for the accuracy or completeness of electronic copies of this plan sheet.

October 5, 1964

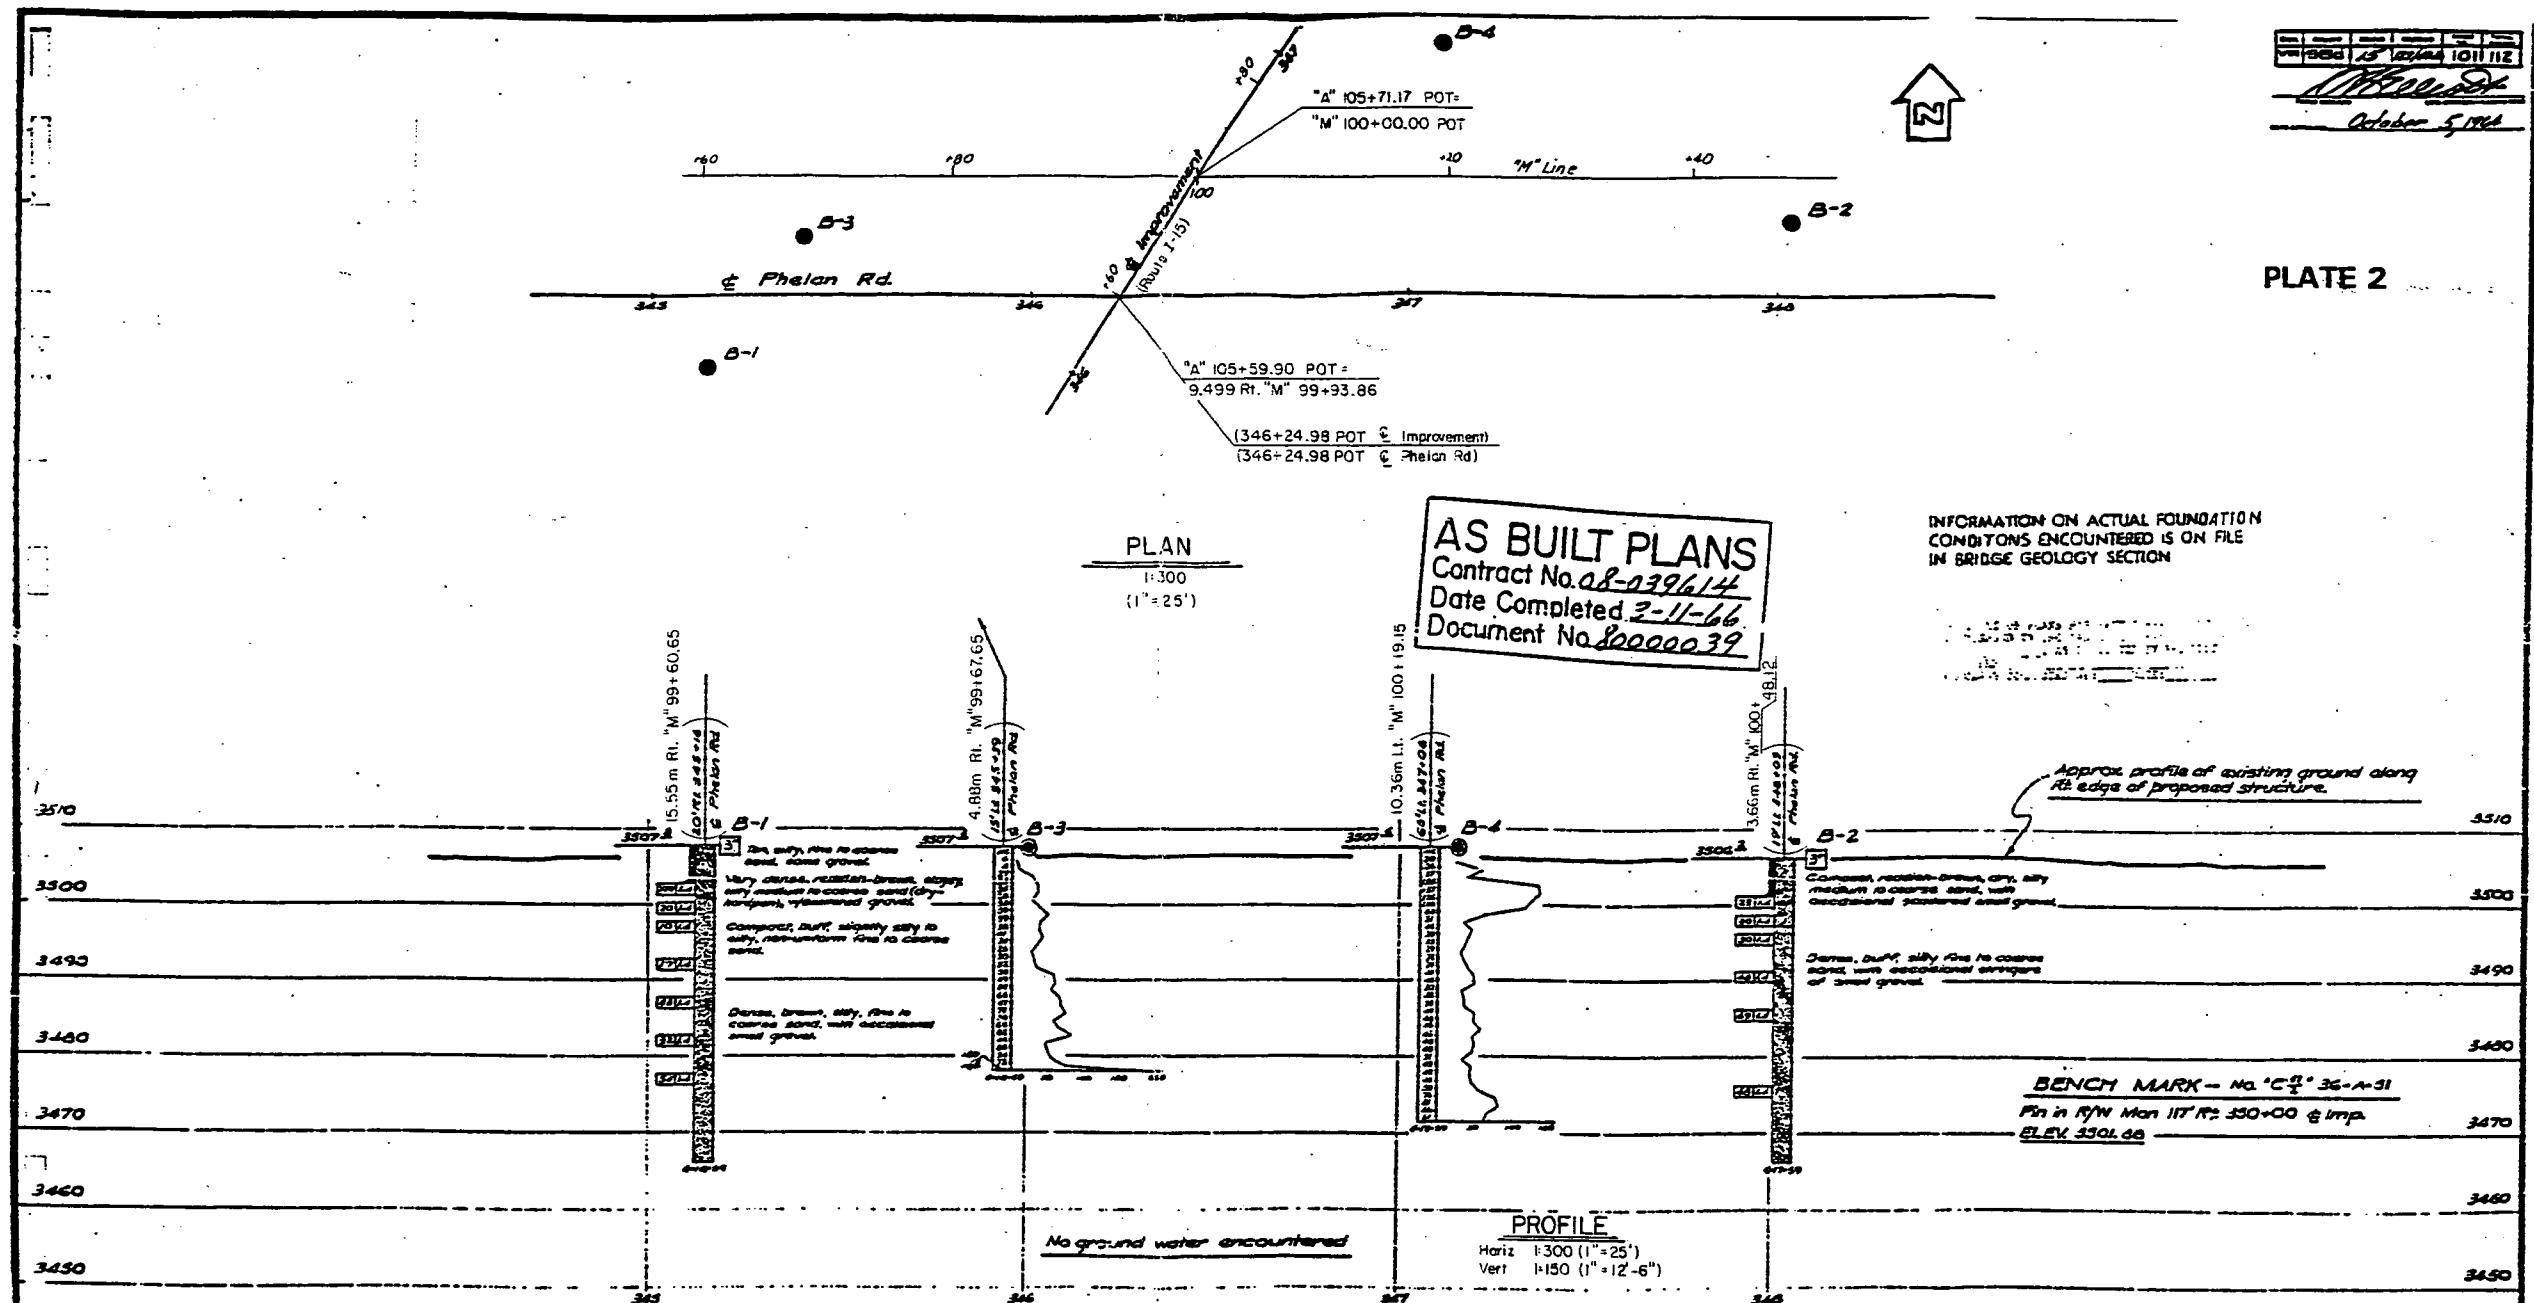

CLASSIFICATION OF MATERIAL BASED ON STANDARD GRADE SIZE LIMITS 	LEGEND OF EARTH MATERIALS <ul style="list-style-type: none"> GRAVEL SAND SILT CLAY SANDY CLAY OR CLAYEY SAND SANDY SILT OR SILTY SAND SILTY CLAY OR CLAYEY SILT PEAT AND/OR ORGANIC MATTER FILL MATERIAL IGNEOUS ROCK SEDIMENTARY ROCK METAMORPHIC ROCK 	LEGEND OF BORING OPERATIONS <ul style="list-style-type: none"> PLAN OF ANY BORING PENETROMETER 2 1/2" CORE PENETROMETER SAMPLER BORING (DRY) ROTARY BORING (WET) AUGER BORING (DRY) JET BORING CORE BORING TEST PIT 	NOTES The contractor's attention is directed to Section 2, Article 16 of the Standard Specifications and to the Special Provisions accompanying this set of plans. Classification of earth material as shown on this sheet is based upon field inspection and is not to be construed to imply mechanical analysis.

DESIGN OVERSIGHT	NOTE: ADDITIONAL AS-BUILT FOUNDATION DATA MAY BE AVAILABLE AT THE DIVISION OF NEW TECHNOLOGY, MATERIALS AND RESEARCH 5900 FOLSOM BOULEVARD, SACRAMENTO, CALIFORNIA 95819	DESIGN BY M. Maechler	CHECKED E. Tsal	PREPARED FOR THE STATE OF CALIFORNIA DEPARTMENT OF TRANSPORTATION	PROJECT ENGINEER M. Maechler	BRIDGE NO. 54624	MAIN STREET OVERCROSSING AS-BUILT LOG OF TEST BORINGS
SIGNOFF DATE	DETAILS BY C. Houghton	CHECKED E. Tsal	CU 08325		POST MILE 5472		
	QUANTITIES BY E. Wong	CHECKED Y. Ton	EA 37020K		DISREGARD PRINTS BEARING EARLIER REVISION DATES		
ORIGINAL SCALE IN INCHES FOR REDUCED PLANS				REVISION DATES (PRELIMINARY STAGE ONLY)		SHEET 18 OF 18	



DIST.	COUNTY	ROUTE	KILOMETER POSTS TOTAL PROJECT	SHEET NO.	TOTAL SHEETS
08	SBd			17	18


REGISTERED ENGINEERING GEOLOGIST
 JEFFREY L. JOHNSON
 No. 1889
 STATE OF CALIFORNIA

PLANS APPROVAL DATE


0.5m remove of embankment

25/6


0.58

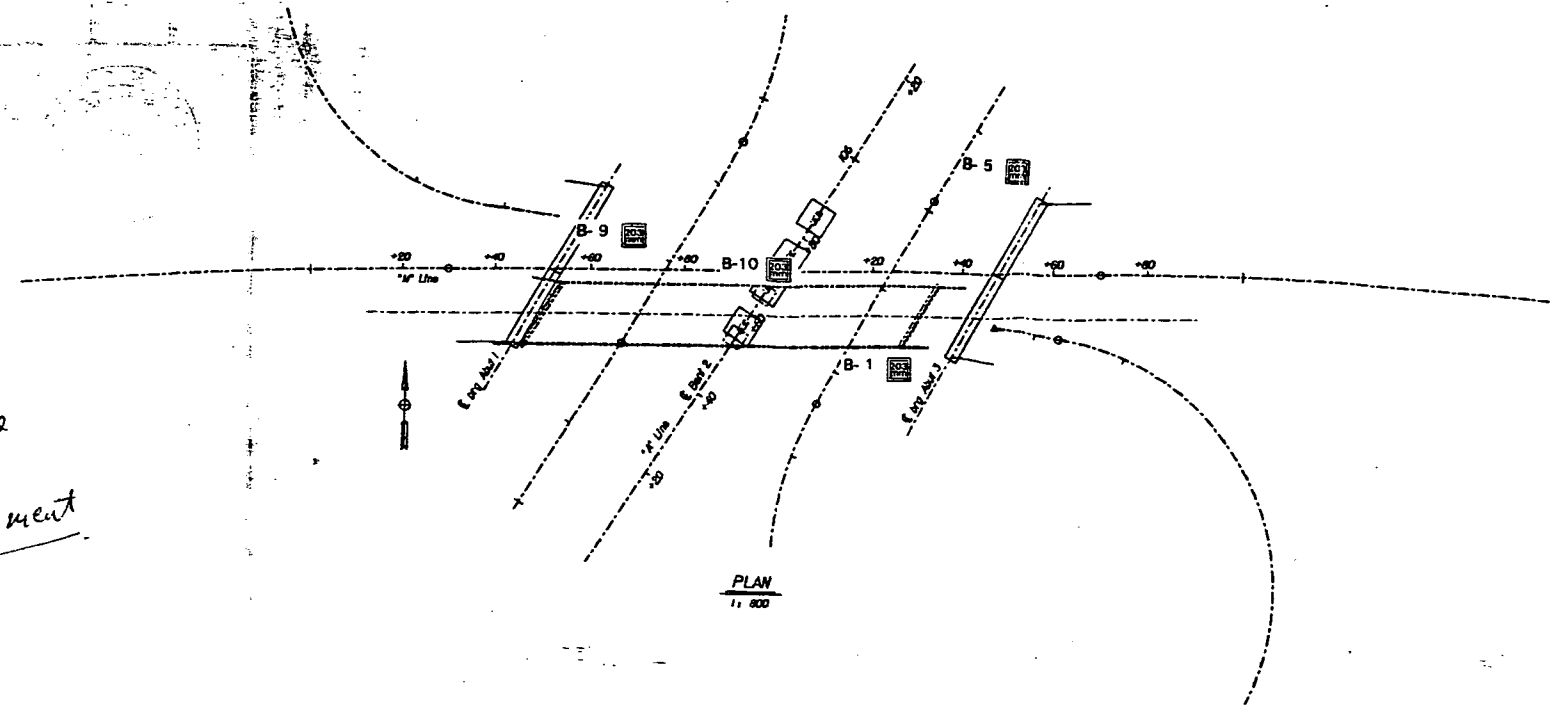

LEGEND OF BORING OPERATIONS

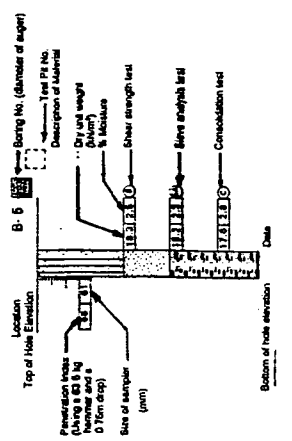

NOTES:
 - BLOWS ARE CONVERTED TO STANDARD PENETRATION TEST DATA.
 - BORING ELEVATIONS ARE BASED ON TOPOGRAPHY FROM CONCEPTUAL GEOMETRIC DRAWING, MAIN STREET/ RTE 15 INTERCHANGE (12/14/85).

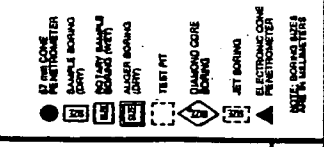


CONSISTENCY CLASSIFICATION FOR SOIL

According to the Standard Penetration Test

Penetration Index (Blows / 30 cm)	Consistency
0-4	Very Loose
5-9	Loose
10-19	Slightly compact
20-29	Compact
30-39	Dense
40-49	Very Dense
50-59	Very Hard
60-69	Hard
70-79	Very Hard

NOTE: Classification of earth material as shown on this sheet is based upon field inspection and is not to be construed to imply mechanical analysis.

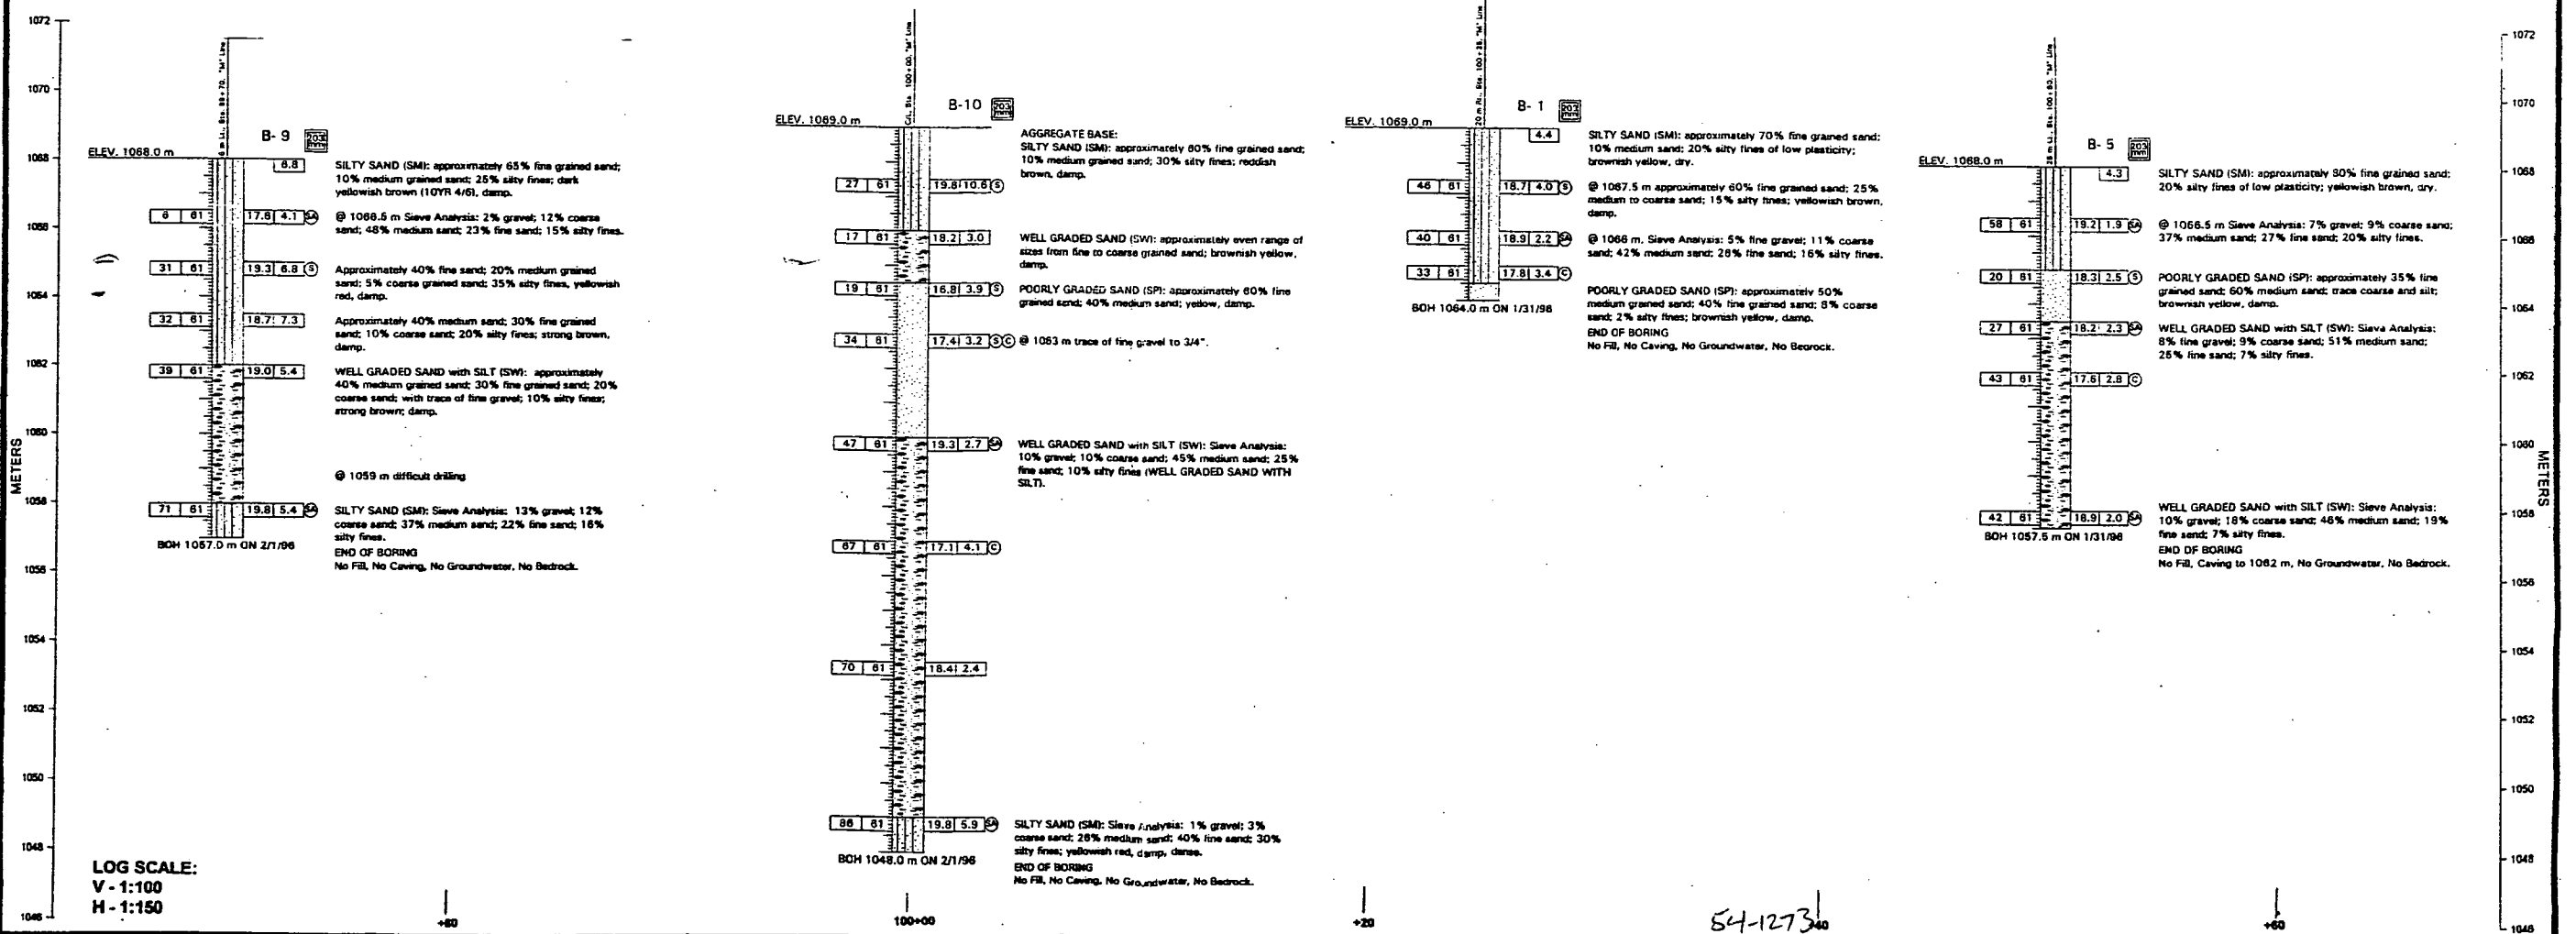

LOG SCALE:
 V - 1:100
 H - 1:150

ENGINEERING SERVICE CENTER	STRUCTURE FOUNDATIONS	FIELD INVESTIGATION BY: J. JOHNSON LOR Geotechnical Group, Inc. 6121 Quail Valley Court Riverside, California 92507	State of CALIFORNIA DEPARTMENT OF TRANSPORTATION	DIVISION OF STRUCTURES STRUCTURE DESIGN	BRIDGE NO. 54-624 KILOMETER POST 15-53.9/55.9	MAIN STREET OVERCROSSING LOG OF TEST BORINGS
DRAWN BY JJJ	CHECKED BY JPL					REVISION DATES (PRELIMINARY STAGE ONLY) 4/96 11/96 4/97 6/97

ORIGINAL V-SCALE IN MILLIMETERS FOR REDUCED PLANS

CL: 08325
EA: 37020K


54-127340

California Aqueduct

ROAD DISTRICT	STATE	FED. PROJECT NO.	PROJECT NO.	TOTAL SHEETS
7	CALIF.			

DIST.	COUNTY	ROUTE	SECTION	PROJECT NO.	TOTAL SHEETS
09	S. Bd.	15	3423		

DATE APPROVED: _____

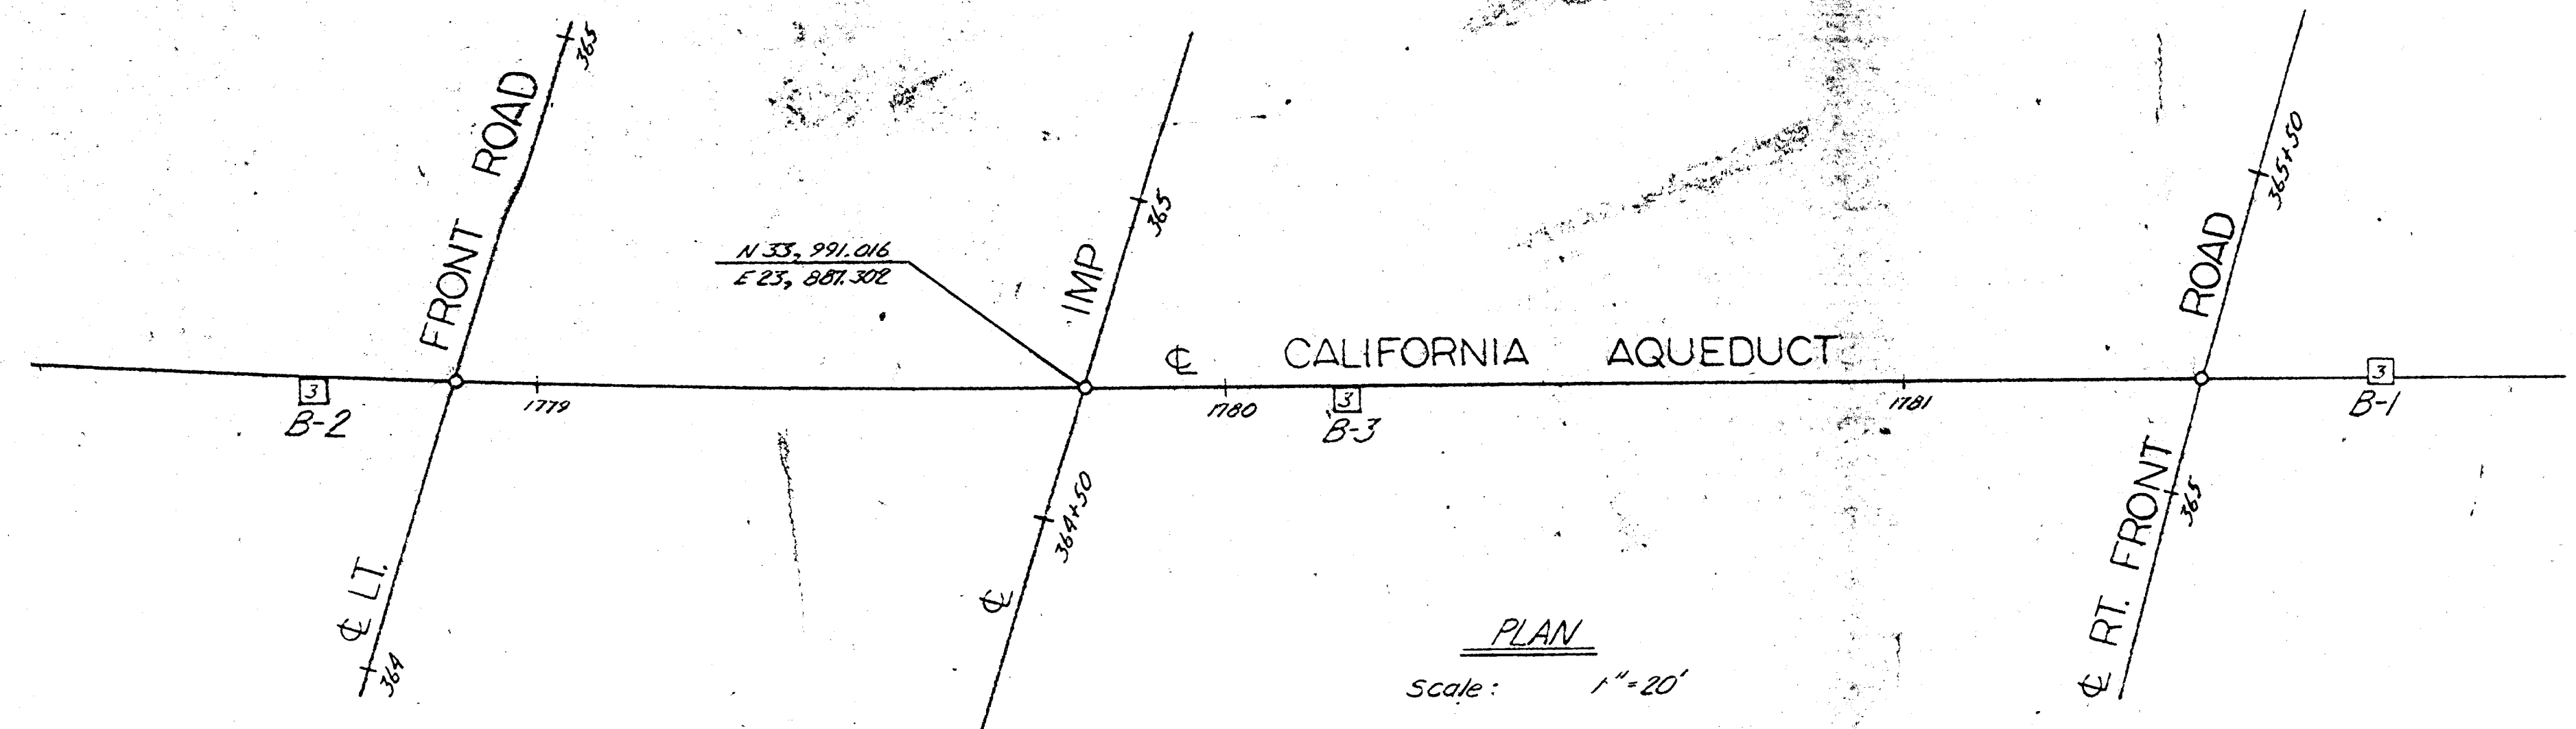


NO GROUND WATER ENCOUNTERED
DURING THIS INVESTIGATION BY
BRIDGE DEPT. GEOLOGY SECTION
DATE 11/22/57

BENCH MARK

B.M. # 37-A-57
Sp. hd. nail in lead top S.E. cor. D.I. ST. RT.
& Imp. 362.159

EL. 3475.96

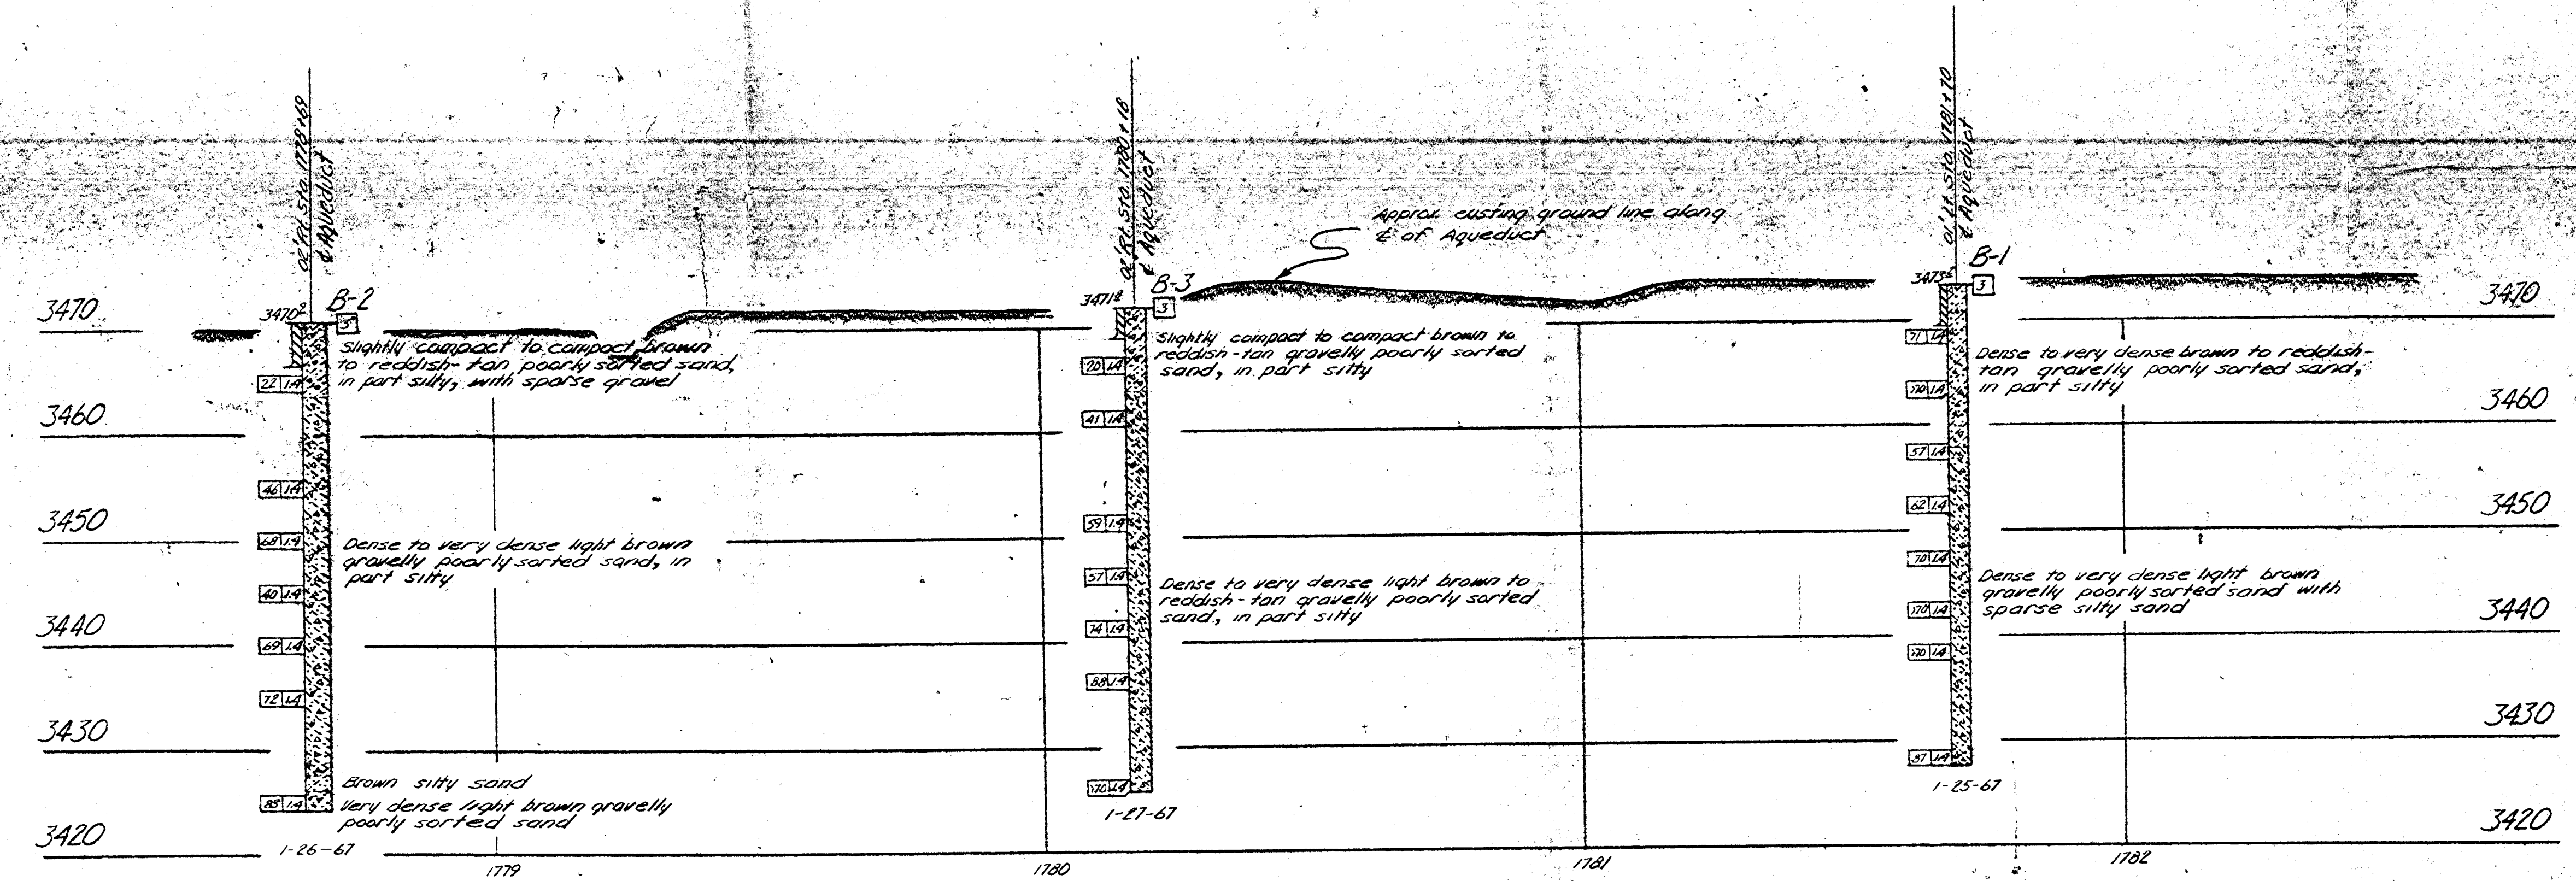

FIELD STUDY	By: D. CARWOOD	1-25-57
DRAWN	By: S. ALLEN	1-30-57
CHECKED	By: S. BEAVER	1-31-57

Approval: _____

LEGEND OF EARTH MATERIALS

	SILTY CLAY OR CLAYEY CLAY
	ORGANIC MATTER
	FILL MATERIAL
	IGNEOUS ROCK
	SEDIMENTARY ROCK
	METAMORPHIC ROCK
	GRAVEL
	SAND
	SILT
	CLAY
	SILTY SAND OR SANDY SILT

CLASSIFICATION OF MATERIAL BASED ON STANDARD GRADE SIZE LIMITS

DIRECTIONS SHOWING THE RANGE FOR ESTIMATES OF GRADE SIZE CLASSIFICATION ARE GIVEN IN DEGREES. IF GRAVEL IS PRESENT IN APPRECIABLE AMOUNTS THE TERM "GRAVELLY" MAY BE ADDED TO THIS CLASSIFICATION. "COARSE", "MEDIUM", AND "FINE" WHEN USED TO DESCRIBE SAND, SILT AND GRAVEL REFER TO GRADE SIZE LIMITS.

GRAVEL (%)	SAND (%)	SILT (%)	CLAY (%)
0	0	0	0
0	0	0	100
0	100	0	0
100	0	0	0
0	0	100	0
0	0	0	100

NOTE: Classification of earth material as shown on this sheet is based upon field inspection and is not to be construed to imply mechanical analysis.

STATE OF CALIFORNIA
DEPARTMENT OF PUBLIC WORKS
DIVISION OF HIGHWAYS

CALIFORNIA AQUEDUCT

LOG OF TEST BORINGS

SCALE: As Noted | BRIDGE: 5A-828 | FILE: | DRAWING: |



PREL. DRAWING NO. PR- |

CHG. W.A. 08201 10/7/01

Disregard prints bearing earlier numbers


Bear Valley Road OC

BENCH MARK "C 5/1" 55-A-51
 Brass Pin in R/W Mon. 118' Rt.
 540+00 & Imp.
 ELEV. 3157.34

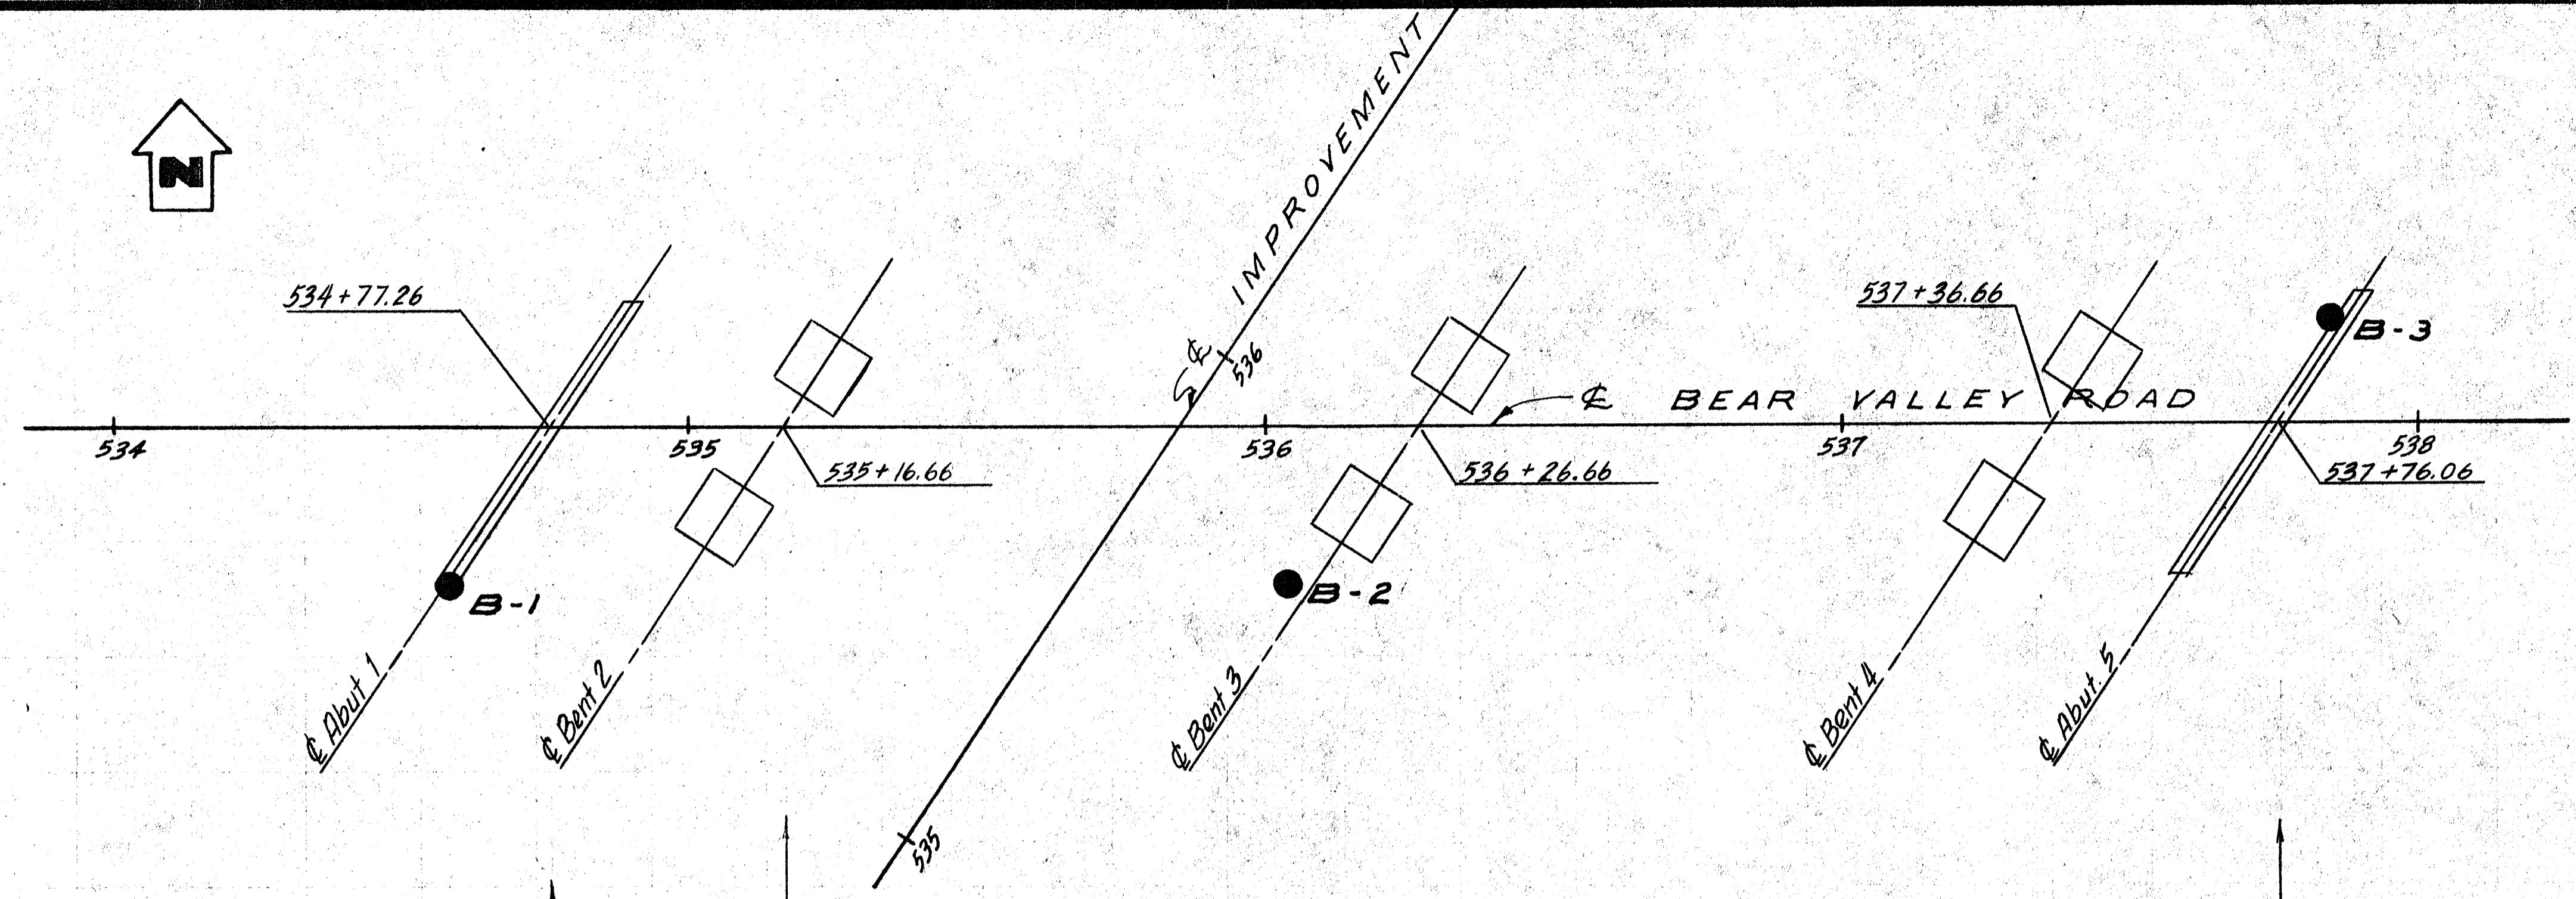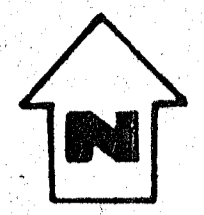


BRIDGE DEPARTMENT

Approx. profile of exist ground along Rt. edge of proposed structure.

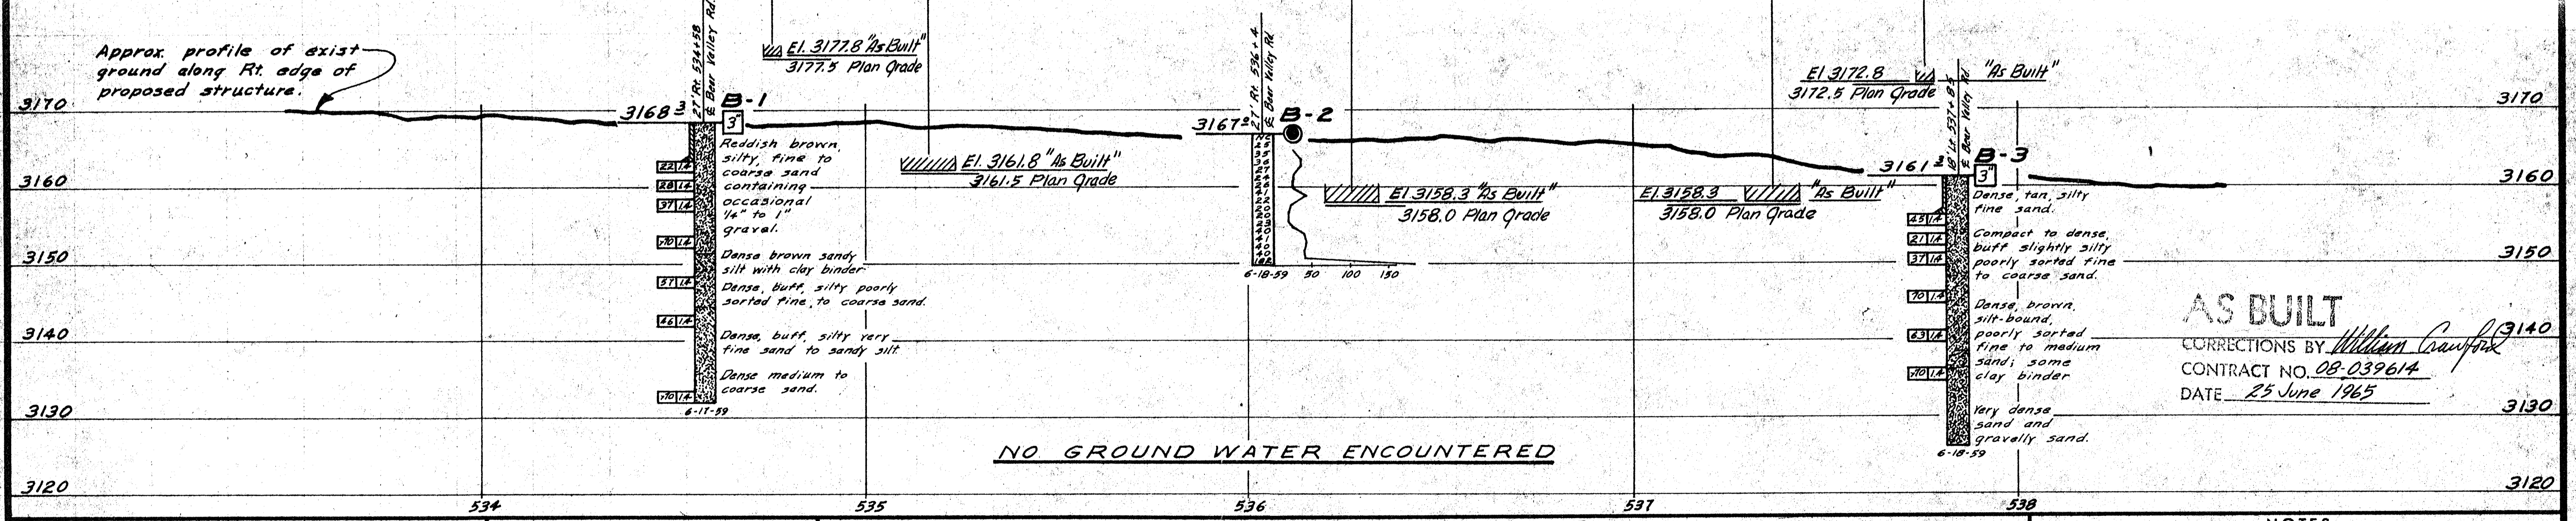


AS BUILT
 CORRECTIONS BY *William Crawford*
 CONTRACT NO. *08-039614*
 DATE *25 June 1965*

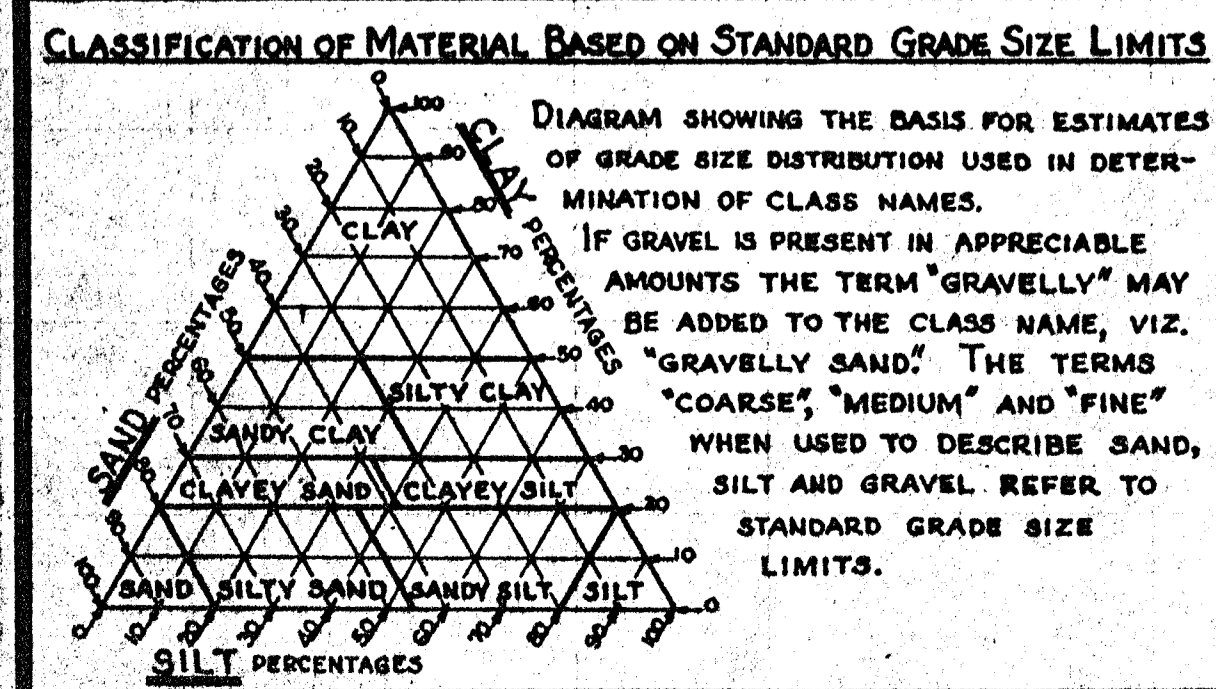

LEGEND OF EARTH MATERIALS

GRAVEL	SILTY CLAY OR CLAYEY SILT
SAND	PEAT AND/OR ORGANIC MATTER
SILT	FILL MATERIAL
CLAY	IGNEOUS ROCK
SANDY CLAY OR CLAYEY SAND	SEDIMENTARY ROCK
SANDY SILT OR SILTY SAND	METAMORPHIC ROCK

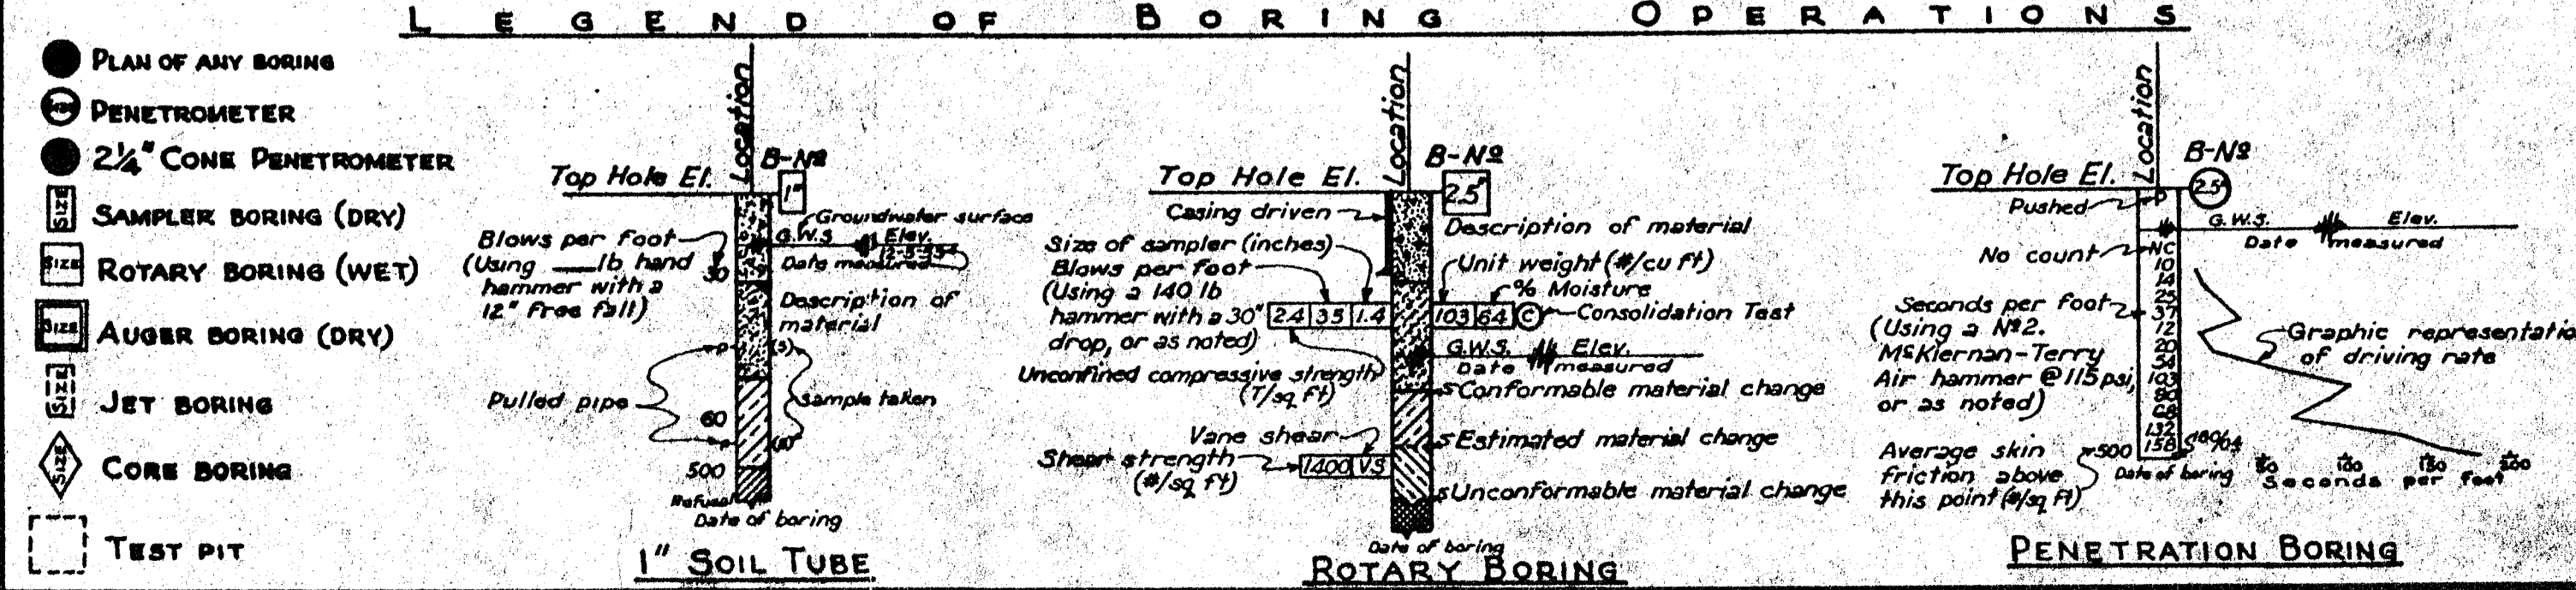

NOTES

The contractor's attention is directed to Section 2, Article (c) of the Standard Specifications and to the Special Provisions accompanying this set of plans. Classification of earth material as shown on this sheet is based upon field inspection and is not to be construed to imply mechanical analysis.

STATE OF CALIFORNIA
 DEPARTMENT OF PUBLIC WORKS
 DIVISION OF HIGHWAYS


SHEET *112* OF *112*

BEAR VALLEY CUTOFF O.C.

LOG OF TEST BORINGS

Horiz. 1"=20'
 SCALE Vert. 1"=10'

BRIDGE *54-625* FILE DRAWING *54625-12*

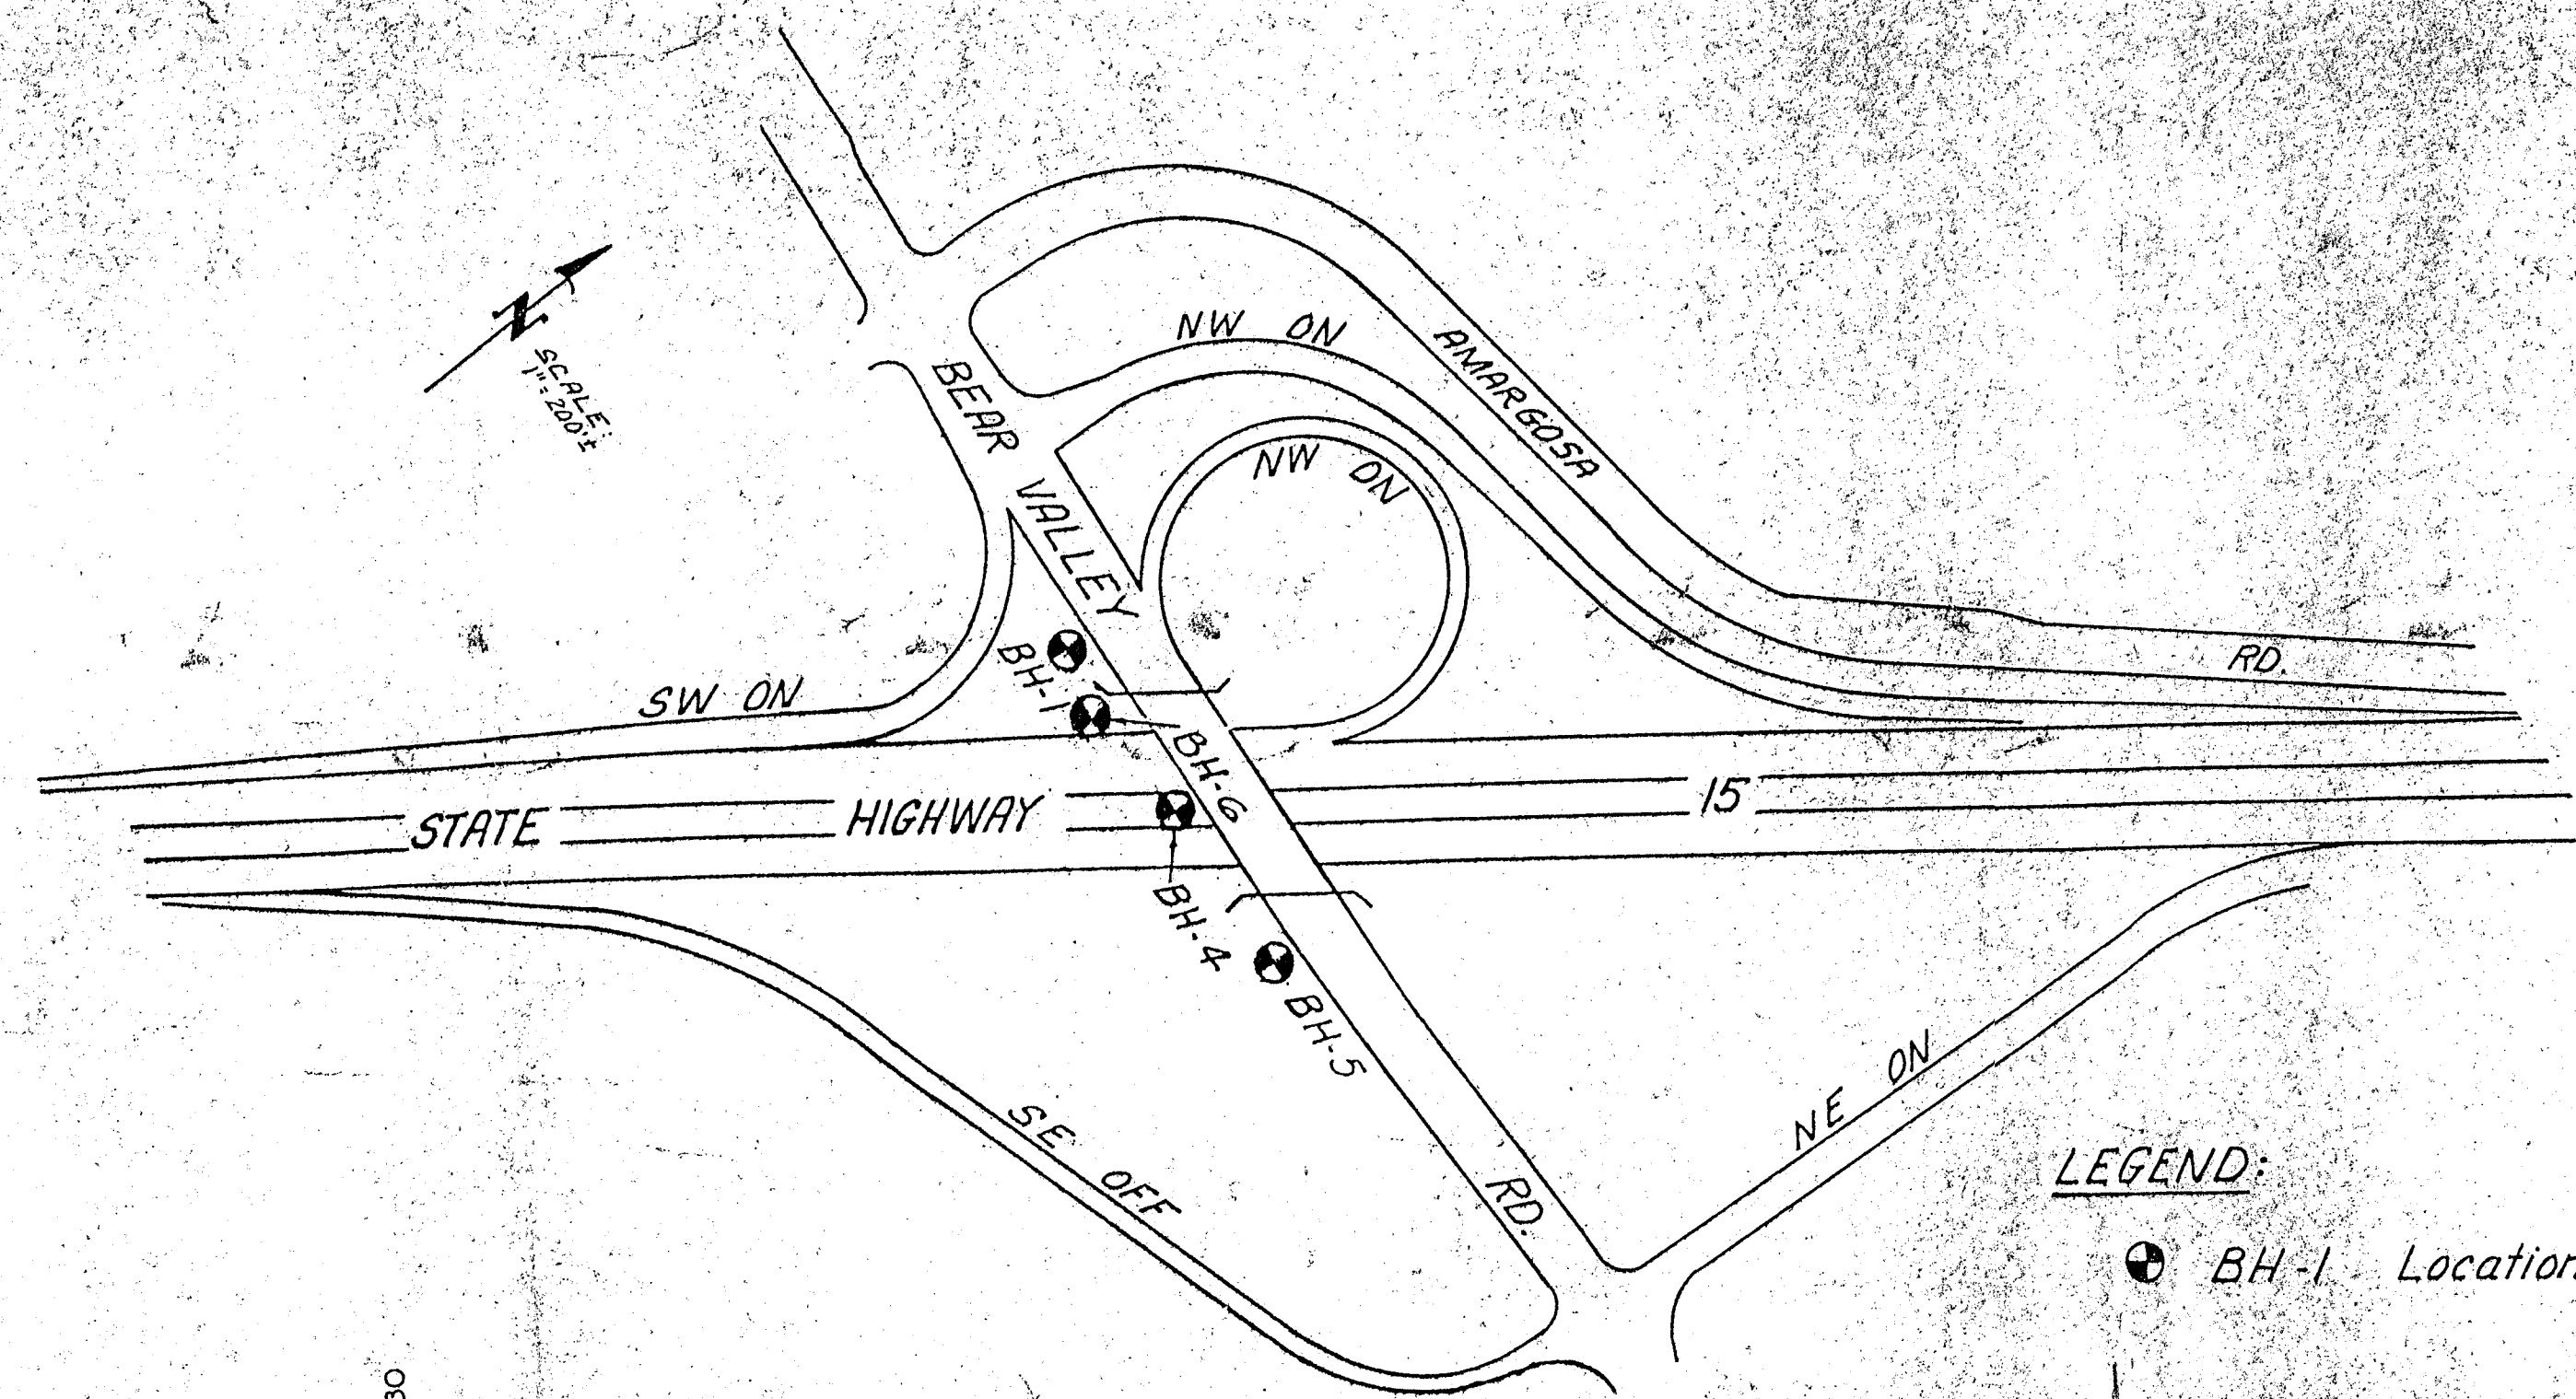

LEGEND:
 ● BH-1 Location of Test Boring (Typ)

LEGEND OF BORING OPERATIONS

LEGEND OF EARTH MATERIALS


CONSISTENCY CLASSIFICATION FOR SOILS

LEGEND OF PENETRATION TESTS

LEGEND OF SAMPLE BORING (MET)

LEGEND OF PENETRATION TESTS

LEGEND OF SAMPLE BORING (MET)

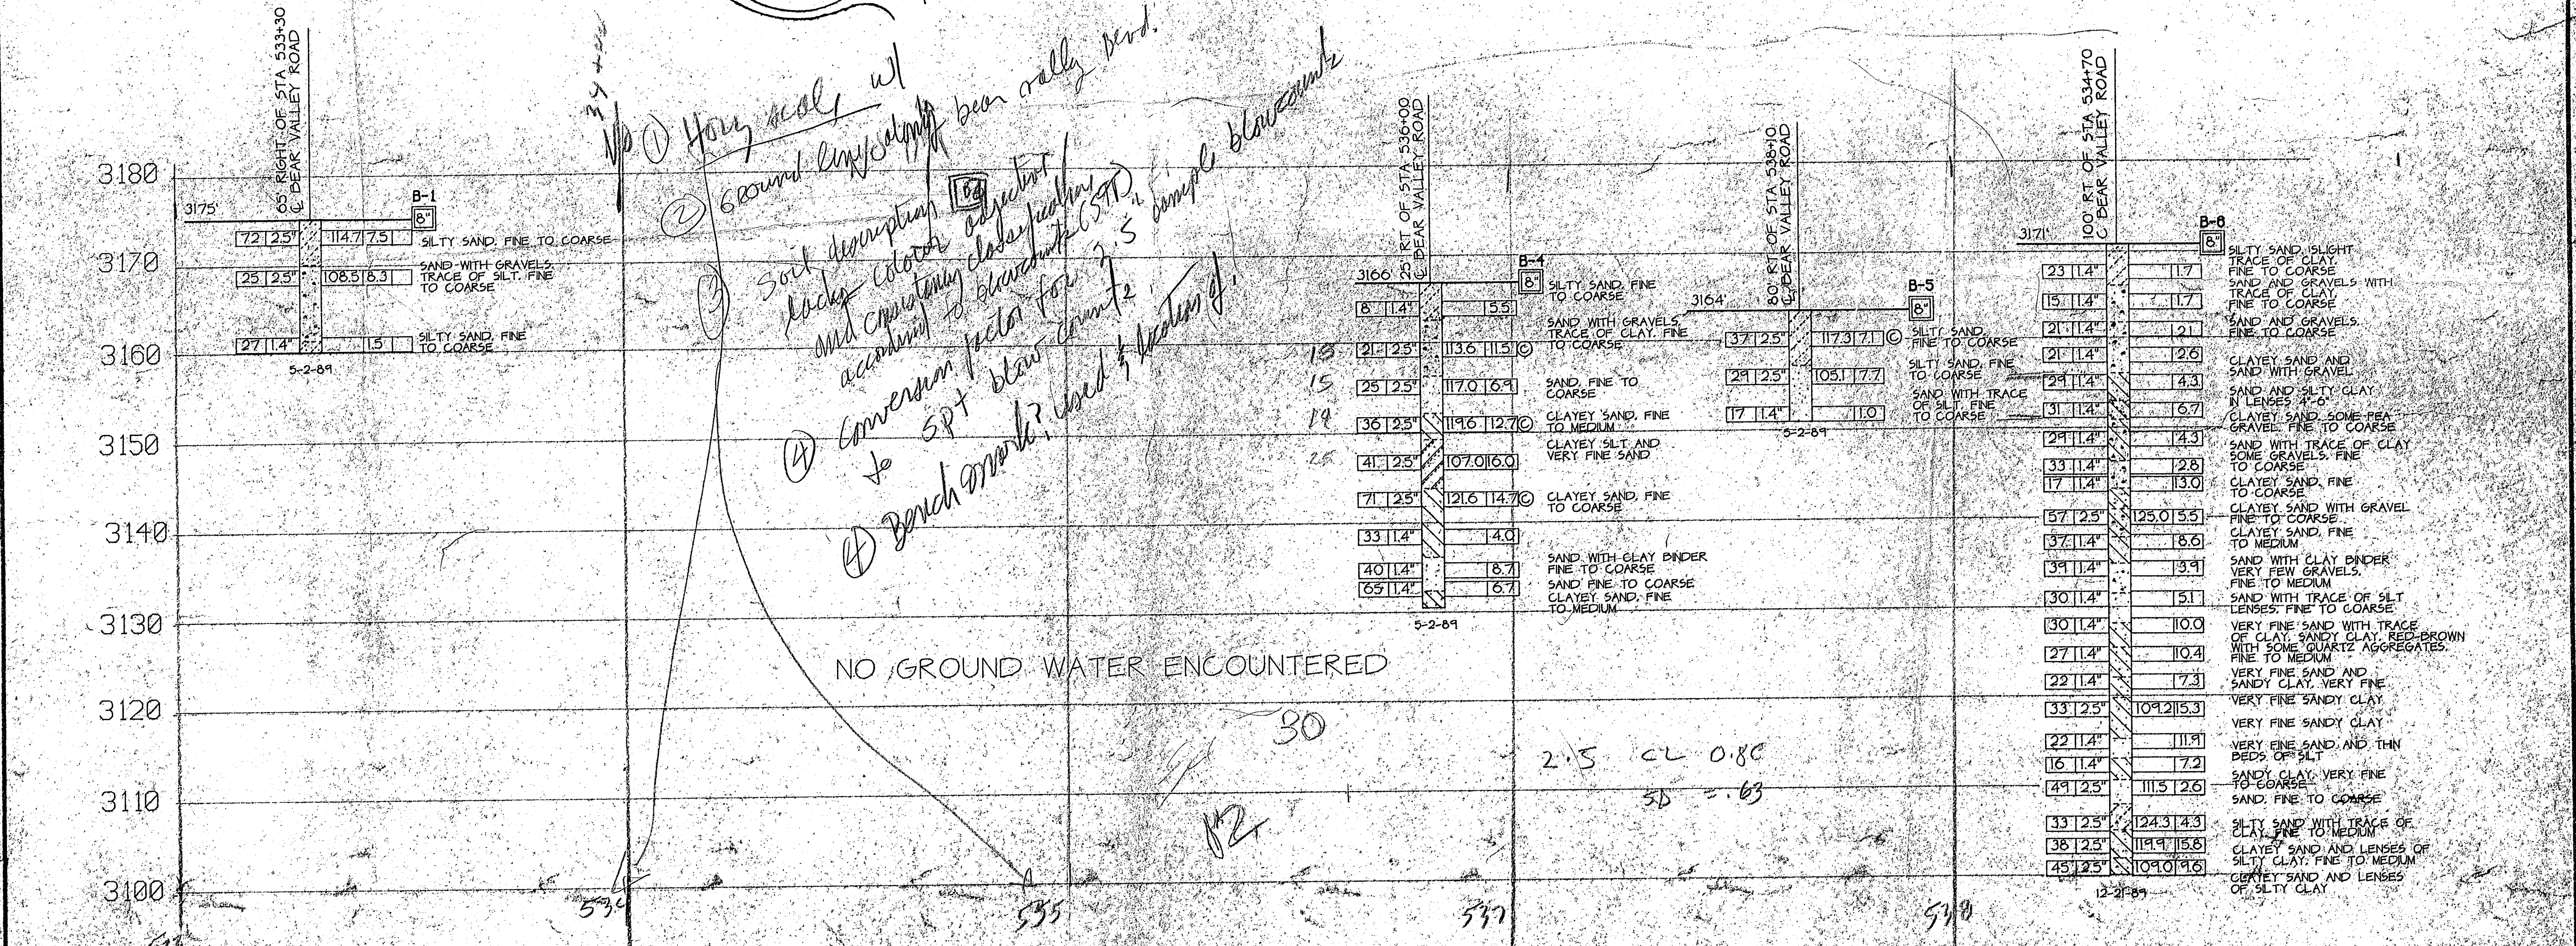

DESIGN OVERSIGHT	DRAWN BY: N. BEDLION	FIELD INVESTIGATOR: R.F. CARDUCCI	DATE: 5-2 & 12-21-87	BRIDGE NO.: 64-625	POST-MILE: 37.6	PROJECT ENGINEER: Victor Lee	REVISION DATES (PRELIMINARY-STAGE ONLY)	SHEET 15 OF 15
DATE: 5-2-87	CHECKED BY: R.F. CARDUCCI	DATE: 5-2-87		BRIDGE NO.: 64-625	POST-MILE: 37.6	PROJECT ENGINEER: Victor Lee		

ORIGINAL SCALE IN INCHES FOR REDUCED PLANS

CU 08103 EA 346000

DISREGARD PRINTS BEARING EARLIER REVISION DATES

La Mesa Nisqualli Road OC

BENCHMARKS

MONUMENTS	COORDINATES		ELEVATIONS	DESCRIPTION
	NORTHING	EASTING		
AE Pt. No.1005	609471.897	2061071.613	935.301	Found 1" IP of the centerline Intersection of Niaguaiti Road and Mariposa Road, Station 159+80.161 centerline 1-15, 33.916 meters right.
AE Pt. No.1076	609571.976	2061087.730	933.858	Set 600 Spk 1 m westerly of the northbound edge of pavement 1-15, Station 160+76.653 centerline 1-15, 2.838 meters right.

DIST	COUNTY	ROUTE	KILOMETER POST TOTAL PROJECT	SHEET No	TOTAL SHEETS
8	SBd	15	61.5 / 63.4		

REGISTERED CIVIL ENGINEER DATE

PLANS APPROVAL DATE



The State of California or its officers or agents shall not be responsible for the accuracy or completeness of electronic copies of this plan area!

CITY OF VICTORVILLE
14343 CIVIC DRIVE
VICTORVILLE, CA 92393

EARTH MECHANICS, INC
17660 NEWHOPE STREET, SUITE E
FOUNTAIN VALLEY, CA 92708

NOTES

52mm samples were taken using a California split-barrel sampler with an inside diameter (I.D) of 62mm and an outside diameter (O.D) of 83mm.
A rope and cathode hammer system consisting of a hammer weight of 63.5kN falling a distance of 762mm was used to advance the drive sampler(s)
This LOTB sheet (Boring Record) was prepared in accordance with the Caltrans Soil and Rock Classification Logging, Classification and Presentation Manual (June 2007)

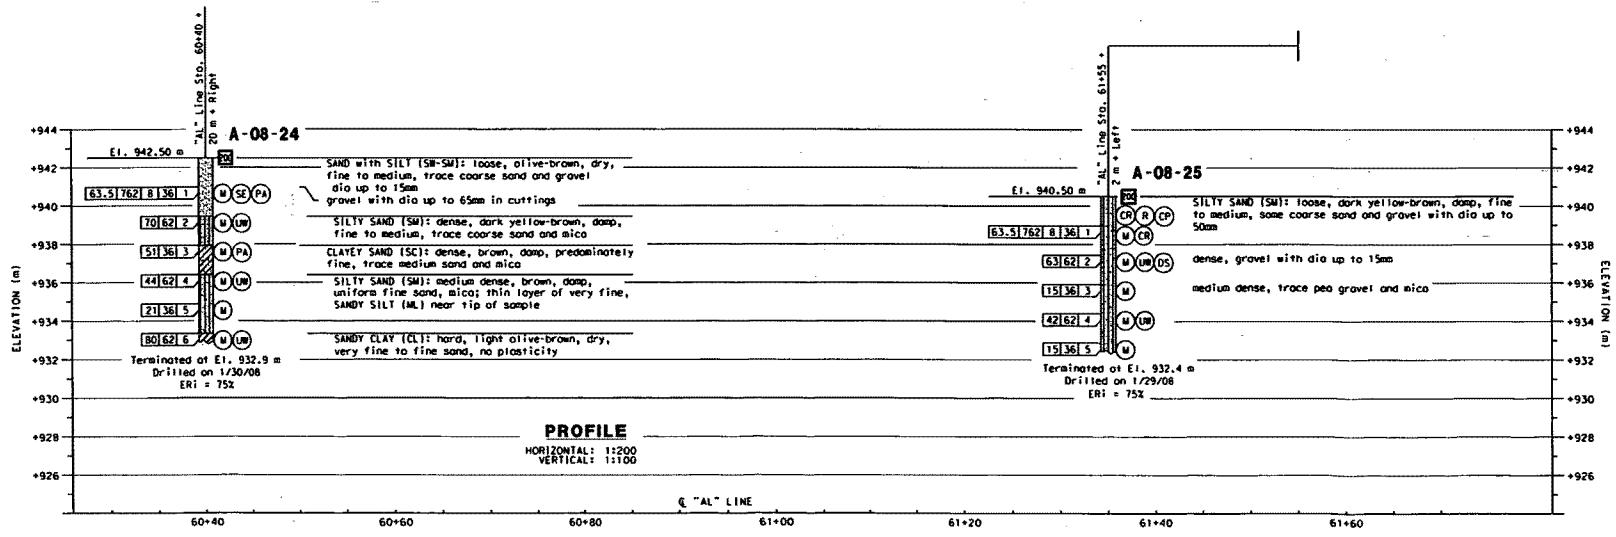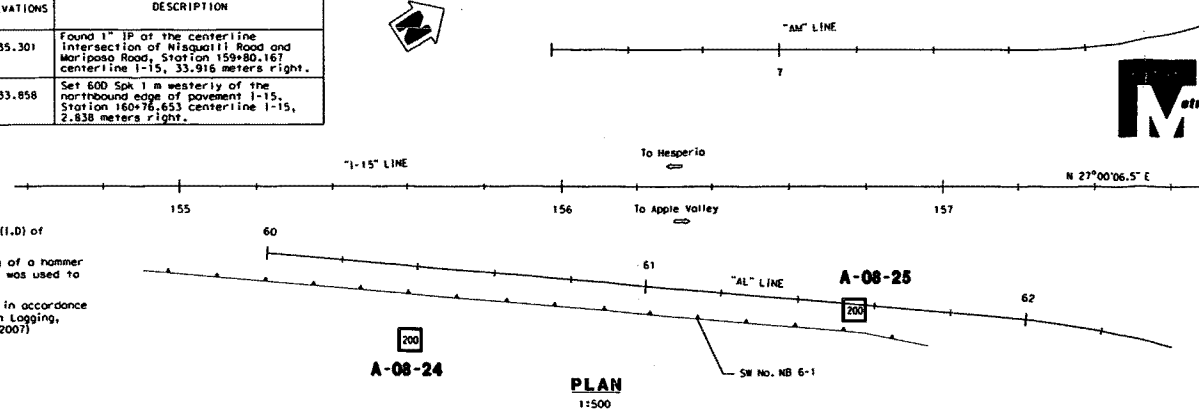

ENGINEERING SERVICES		GEOTECHNICAL SERVICES		PREPARED FOR THE STATE OF CALIFORNIA DEPARTMENT OF TRANSPORTATION		BRIDGE NO. XX-XXXX		SOUND WALL NO. NB 6-1	
FUNCTIONAL SUPERVISOR NAME: K. Arulraj	DRAWN BY: E. Brown	FIELD INVESTIGATION BY: R. Jie	PROJECT ENGINEER	E. Brown		SHEET NO. XX		LOG OF TEST BORINGS	
CHECKED BY: R. Dunganon		ORIGINAL SCALE IN MILLIMETERS FOR REDUCED PLANS		CU E.A. 04D4501		REVISION DATES (PRELIMINARY STAGE ONLY)		SHEET OF XX XX	

BENCHMARKS

MONUMENTS	COORDINATES		ELEVATIONS	DESCRIPTION
	NORTHING	EASTING		
AE Pt. No. 1005	609471.897	2061071.613	935.301	Found 1" IP of the centerline intersection of Miguaiti Road and Mariposa Road, Station 159+80.167 centerline I-15, 33.916 meters right.
AE Pt. No. 1076	609571.976	2061087.730	933.858	Set 600 Spk 1 m westerly of the northbound edge of pavement I-15, Station 160+76.653 centerline I-15, 2.838 meters right.

NOTES

62mm samples were taken using a California split-barrel sampler with an inside diameter (I.D.) of 62mm and an outside diameter (O.D.) of 83mm. A rope and cathead hammer system consisting of a hammer weight of 63.5kN falling a distance of 762mm was used to advance the drive sampler(s).

This LOTB sheet (Boring Record) was prepared in accordance with the Caltrans Soil and Rock Classification Logging, Classification and Presentation Manual (June 2007)



DIST	COUNTY	ROUTE	MILEAGE PER POST	TOTAL PROJECT	SHEET No	TOTAL SHEETS
8	Sbd	15	61.5 / 63.4			


REGISTERED CIVIL ENGINEER DATE

PLANS APPROVAL DATE


The State of California or its officers or agents shall not be responsible for the accuracy or completeness of electronic copies of this plan sheet.

CITY OF VICTORVILLE
14343 CIVIC DRIVE
VICTORVILLE, CA 92393

EARTH MECHANICS, INC
17660 NEWHOPE STREET, SUITE E
FOUNTAIN VALLEY, CA 92708

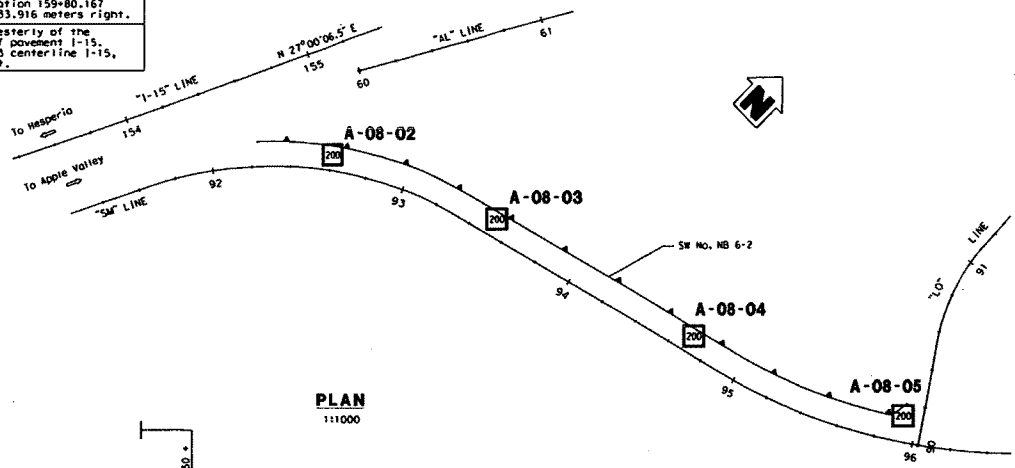

PLAN
1:11000

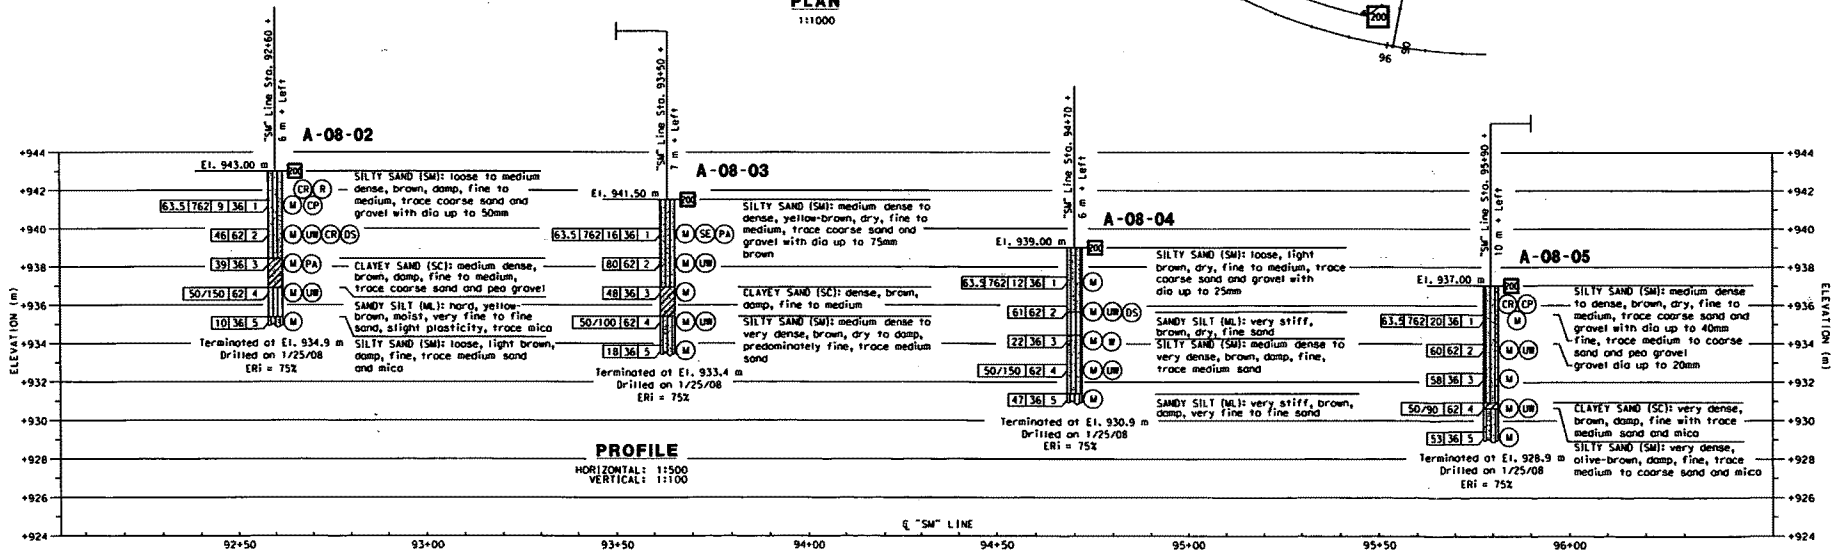

PROFILE
HORIZONTAL: 1:1500
VERTICAL: 1:100

ENGINEERING SERVICES		GEOTECHNICAL SERVICES		PREPARED FOR THE STATE OF CALIFORNIA DEPARTMENT OF TRANSPORTATION		BRIDGE NO. XX-XXXX		SOUND WALL NO. NB 6-2	
FUNCTIONAL SUPERVISOR NAME: E. Arundel	Drawn by: E. Brown	FIELD INVESTIGATION BY: R. Jie	PROJECT ENGINEER	E. Brown		XX-XXXX		LOG OF TEST BORINGS	
Checked by: R. Ghanoujan				CU EA 0404501		DISSEMINATION DATES		SHEET OF XX XX	


MONUMENTS	COORDINATES		ELEVATIONS	DESCRIPTION
	NORTHING	EASTING		
AE Pt. No.1005	609471.897	2061071.613	935.301	Found 1" IP of the centerline intersection of Misquahili Road and Noriposo Road, Station 159+00.167 centerline 1-15, 33.916 meters right.
AE Pt. No.1076	609571.976	2061087.730	933.858	Set 600 Spk 1 m westerly of the northbound edge of pavement 1-15, Station 160+76.653 centerline 1-15, 2.838 meters right.

NOTES

62mm samples were taken using a California split-barrel sampler with an inside diameter (I.D.) of 62mm and an outside diameter (O.D.) of 83mm.

A rope and cathead hammer system consisting of a hammer weight of 63.5kN falling a distance of 762mm was used to advance the drive sampler(s).

This LOGB sheet (Boring Record) was prepared in accordance with the Caltrans Soil and Rock Classification Logging, Classification and Presentation Manual (June 2007)

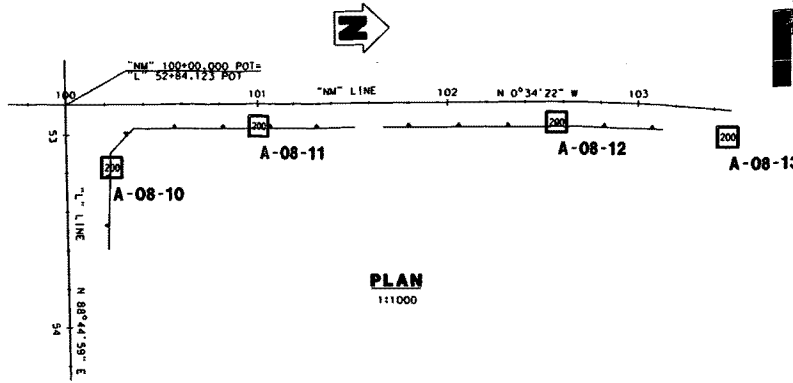

DIST	COUNTY	ROUTE	KILOMETER POST TOTAL PROJECT	SHEET NO.	TOTAL SHEETS
8	SBd	15	61.5 / 63.4		


REGISTERED CIVIL ENGINEER DATE

PLANS APPROVAL DATE


The State of California or its officers or agents shall not be responsible for the accuracy or completeness of electronic copies of this plan sheet.

CITY OF VICTORVILLE
14343 CIVIC DRIVE
VICTORVILLE, CA 92393

EARTH MECHANICS, INC
17660 NEWHOPE STREET, SUITE E
FOUNTAIN VALLEY, CA 92708

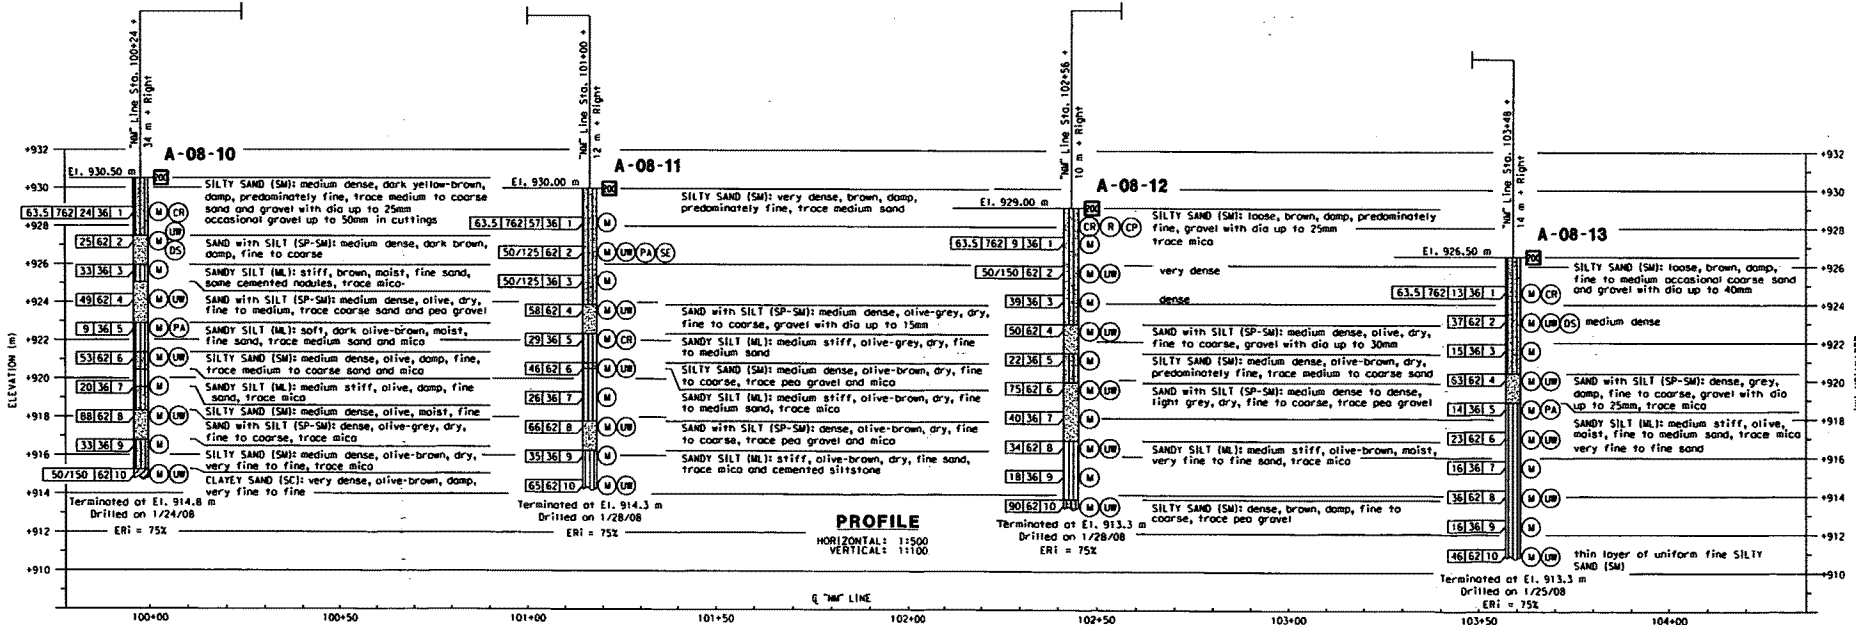

ENGINEERING SERVICES		GEOTECHNICAL SERVICES		PREPARED FOR THE STATE OF CALIFORNIA DEPARTMENT OF TRANSPORTATION		BRIDGE NO. XX-XXXX		RETAINING WALL NO. NB 6-3 (A/B)			
FUNCTIONAL SUPERVISOR	NAME: K. Arulmoji	DRAWN BY: E. Brown	CHECKED BY: R. Gunarajan	FIELD INVESTIGATION BY: R. Jie	E. Brown	PROJECT ENGINEER	DATE: XX-XXXX	LOG OF TEST BORINGS			
ORIGINAL SCALE IN MILLIMETERS FOR REDUCED PLANS		FILE # 0404501		REVISION DATES (PRELIMINARY STATE ONLY)		SHEET OF XX XX					

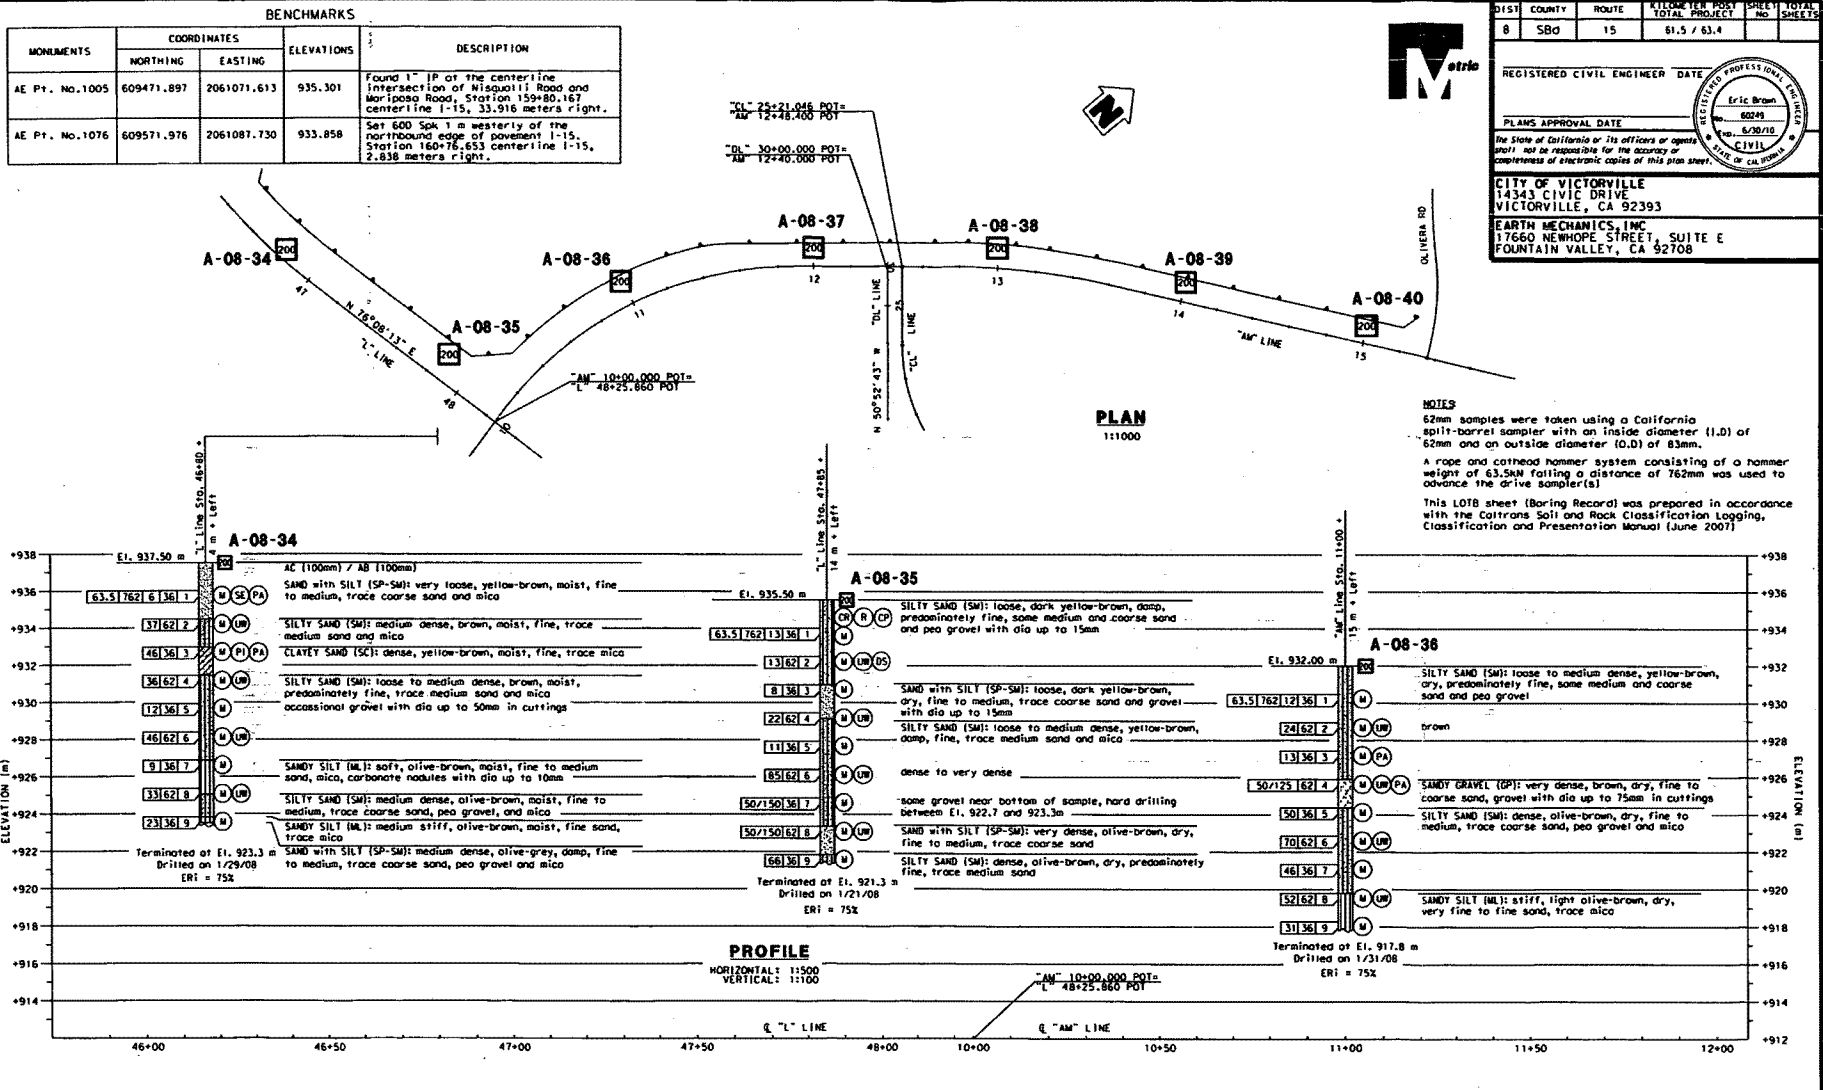

BENCHMARKS				
MONUMENTS	COORDINATES		ELEVATIONS	DESCRIPTION
	NORTHING	EASTING		
AE Pt. No.1005	609471.897	2061071.613	935.301	Found 1" IP of the centerline intersection of Misadullif Road and Moriposo Road, Station 159+80.167 centerline I-15, 33.916 meters right.
AE Pt. No.1076	609571.976	2061087.730	933.858	Set 600 Spk 1 m westerly of the northbound edge of pavement I-15, Station 160+76.653 centerline I-15, 2.836 meters right.

DIST	COUNTY	ROUTE	KILOMETER POST TOTAL PROJECT	SHEET TOTAL SHEETS
8	SBo	15	61.5 / 63.4	

Metric

REGISTERED CIVIL ENGINEER DATE

Eric Brown
No. 6029
Exp. 6/30/16
CIVIL
STATE OF CALIFORNIA

PLANS APPROVAL DATE

The State of California or its officers or agents shall not be responsible for the accuracy or completeness of electronic copies of this plan sheet.

CITY OF VICTORVILLE
14343 CIVIC DRIVE
VICTORVILLE, CA 92393

EARTH MECHANICS, INC.
17660 NEWHOPE STREET, SUITE E
FOUNTAIN VALLEY, CA 92708

NOTES

62mm samples were taken using a California split-barrel sampler with an inside diameter (I.D.) of 62mm and an outside diameter (O.D.) of 83mm.

A rope and cathead hammer system consisting of a hammer weight of 63.5kg falling a distance of 762mm was used to advance the drive sampler(s).

This LOTB sheet (Boring Record) was prepared in accordance with the Caltrans Soil and Rock Classification Logging, Classification and Presentation Manual (June 2007)

ENGINEERING SERVICES		GEOTECHNICAL SERVICES		PREPARED FOR THE STATE OF CALIFORNIA DEPARTMENT OF TRANSPORTATION		RETAINING WALL NO. NB 6-5 LOG OF TEST BORINGS (1 OF 2)	
FUNCTIONAL SUPERVISOR NAME: R. Arjuntol	DRAWN BY: E. Brown	CHECKED BY: R. Gunarajan	FIELD INVESTIGATION BY: R. Jie	E. Brown PROJECT ENGINEER	ISSUE NO.: XX-XXXX EVALUATED POST: XX.XX	DISPREP. PRINTS BEHIND EARTH MECHANICS, INC.	
ORIGINAL SCALE IN MILLIMETERS FOR REDUCED PLANS				CU E.A. 0404501	FILE # 30002	REVISION DATES PRELIMINARY STAGE (DATE)	
DATE PLOTTED: 03/14/16						SHEET OF XX XX	

MONUMENTS	COORDINATES		ELEVATIONS	DESCRIPTION
	NORTHING	EASTING		
AE Pt. No.1005	609471.897	2061071.613	935.301	Found 1" IP of the centerline intersection of Nisqually Road and Mariposa Road, Station 159+80.167 centerline I-15, 33.916 meters right.
AE Pt. No.1076	609571.976	2061087.730	933.858	Set 60D Spk 1 m westerly of the northbound edge of pavement I-15, Station 160+76.653 centerline I-15, 2.838 meters right.



DIST	COUNTY	ROUTE	KILOMETER POST TOTAL PROJECT	SHEET No	TOTAL SHEETS
8	SBd	15	61.5 / 63.4		


REGISTERED CIVIL ENGINEER DATE _____
 Eric Brown 6049
 5/30/10
 CIVIL
 STATE OF CALIFORNIA

PLANS APPROVAL DATE _____

The State of California or its officers or agents shall not be responsible for the accuracy or completeness of electronic copies of this plan sheet.

CITY OF VICTORVILLE
 14343 CIVIC DRIVE
 VICTORVILLE, CA 92393

EARTH MECHANICS, INC
 17660 NEWHOPE STREET, SUITE E
 FOUNTAIN VALLEY, CA 92708

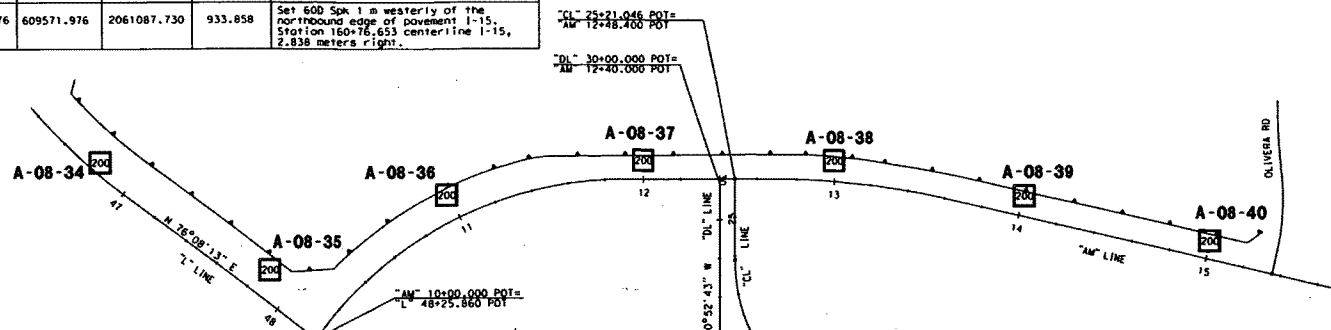


NOTES:

62mm samples were taken using a California split-barrel sampler with an inside diameter (I.D) of 62mm and an outside diameter (O.D) of 83mm.

A rope and cathead hammer system consisting of a hammer weight of 63.5kN falling a distance of 762mm was used to advance the drive sampler(s).

This LOTB sheet (Boring Record) was prepared in accordance with the California Soil and Rock Classification Logging, Classification and Presentation Manual (June 2007)


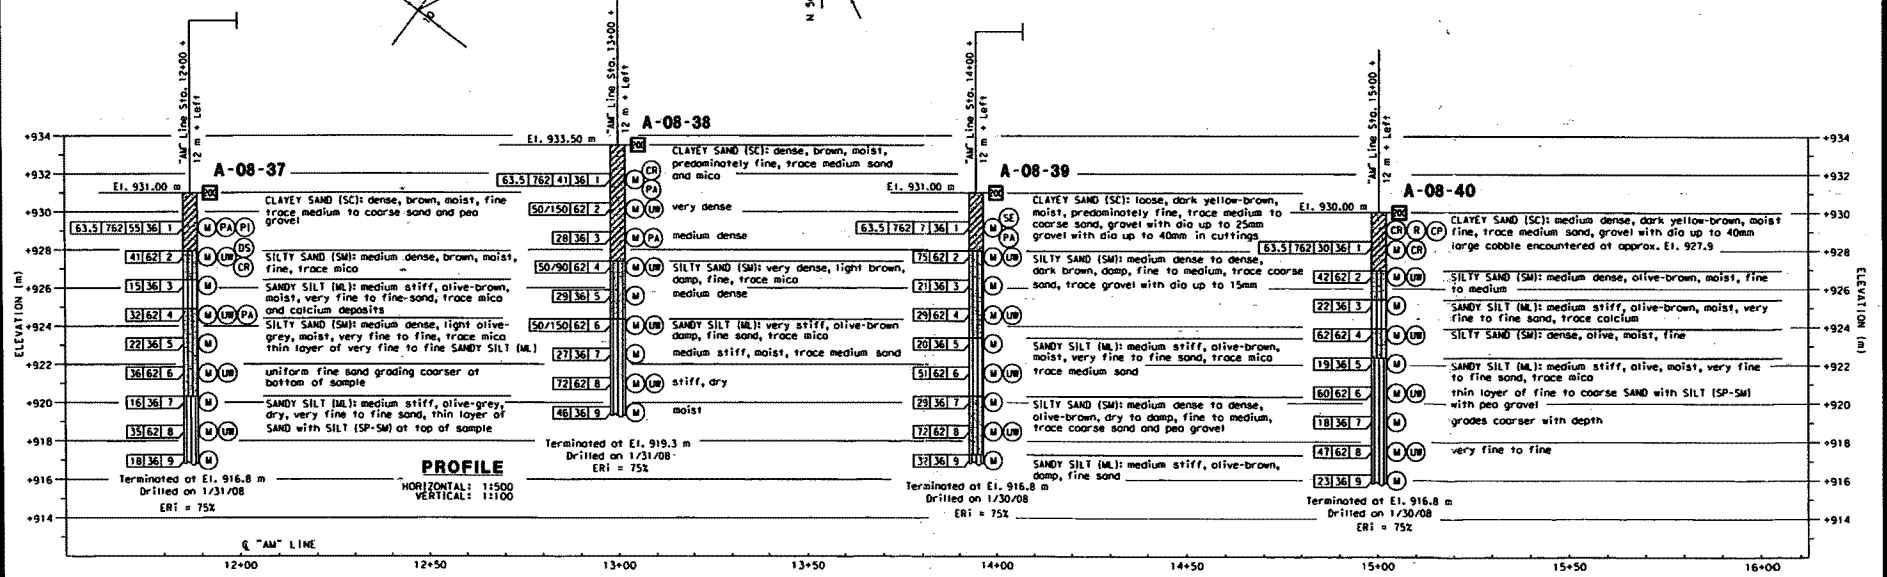


ENGINEERING SERVICES		GEOTECHNICAL SERVICES		PREPARED FOR THE STATE OF CALIFORNIA DEPARTMENT OF TRANSPORTATION		BRIDGE NO. XX-XXXX PROJECT ENGINEER E. Brown		RETAINING WALL NO. NB 6-5	
FUNCTIONAL SUPERVISOR NAME: K. Arulmani		DRAWN BY: E. Brown		FIELD INVESTIGATION BY: R. Jie		PROJECT ENGINEER		LOG OF TEST BORINGS (2 OF 2)	
CHECKED BY: R. Gunjanon						XX.XX		SHEET XX OF XX	
ORIGINAL SCALE IN MILLIMETERS FOR REDUCED PLANS				FILE # 3 REQUEST		REVISION DATES (DATE, REVISION, STAGE, SHEET)			

MONUMENTS	COORDINATES		ELEVATIONS	DESCRIPTION
	NORTHING	EASTING		
AE Pt. No.1005	609471.897	2061071.613	935.301	Found 1" IP at the centerline intersection of Nisqualli Road and Mariposa Road, Station 159+80.167 centerline 1-15, 33.916 meters right.
AE Pt. No.1076	609571.976	2061087.730	933.858	Set 600 Spk 1 m westerly of the northbound edge of pavement 1-15, Station 160+76.653 centerline 1-15, 2.838 meters right.

NOTES



62mm samples were taken using a California split-barrel sampler with an inside diameter (I.D.) of 62mm and an outside diameter (O.D.) of 83mm. A rope and cathead hammer system consisting of a hammer weight of 83.5kg falling a distance of 762mm was used to advance the drive sampler(s). This LOG sheet (Boring Record) was prepared in accordance with the Caltrans Soil and Rock Classification Logging, Classification and Presentation Manual (June 2007).

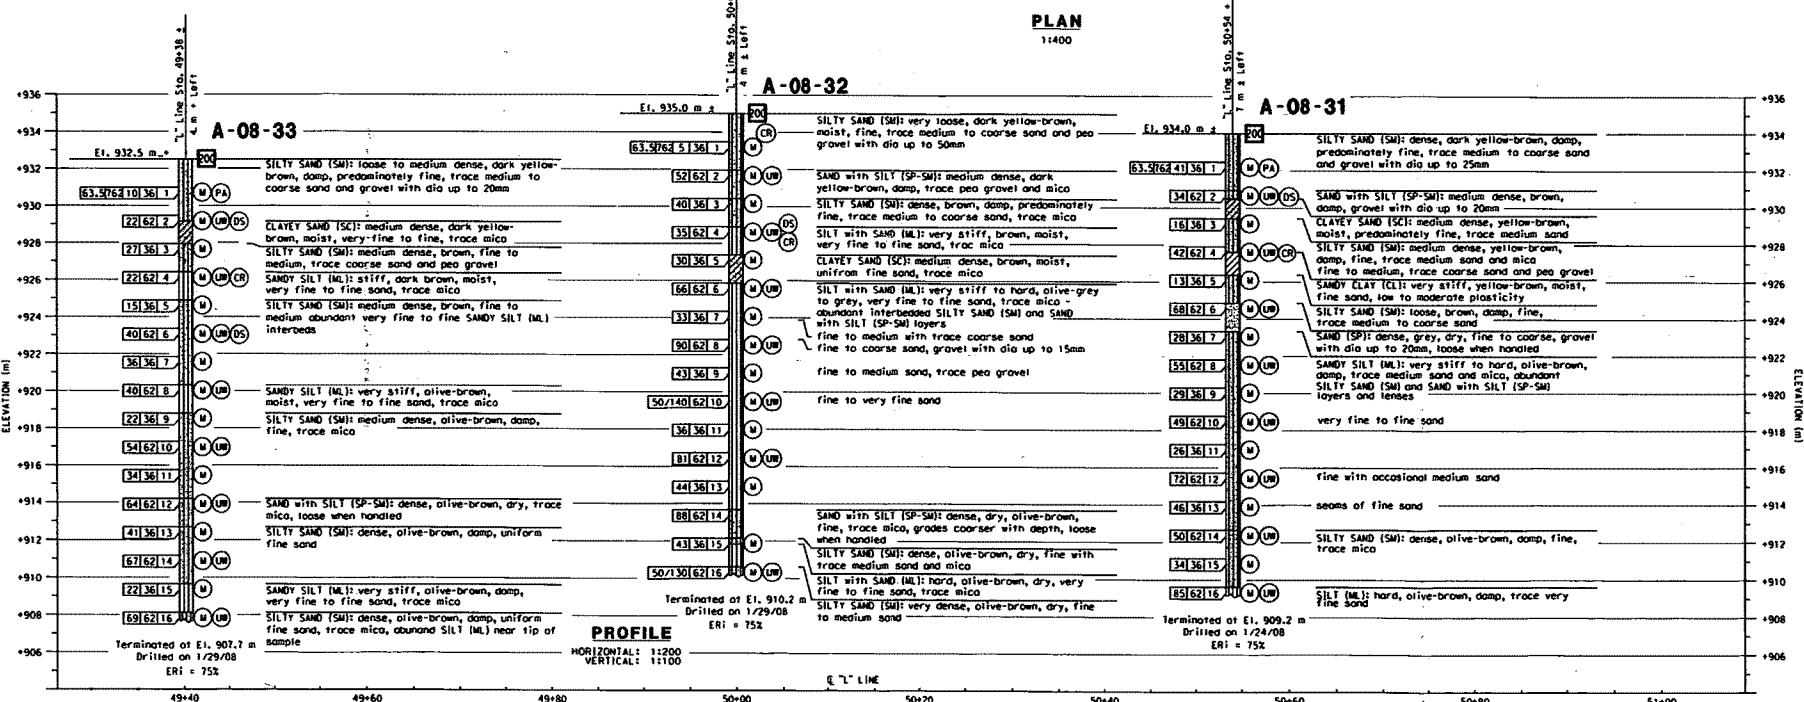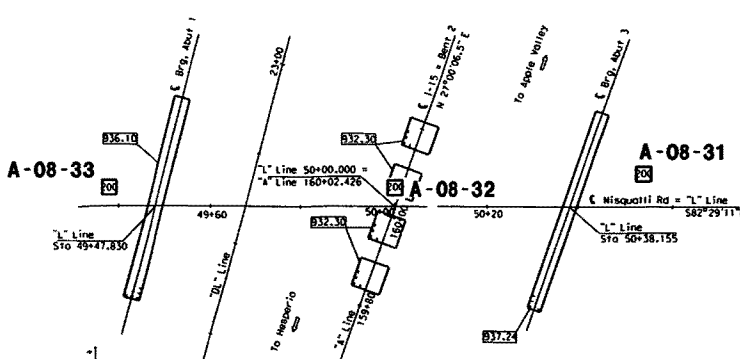

X DESIGN OVERSIGHT X SIGN OFF DATE	GEOTECHNICAL SERVICES DRAWN BY: E. Brown CHECKED BY: R. GUNORANJON		FIELD INVESTIGATION BY: R. Jie		PREPARED FOR THE STATE OF CALIFORNIA DEPARTMENT OF TRANSPORTATION PROJECT ENGINEER: E. Brown		BRIDGE NO. 54-1284 ALLOWED POST 62.41		LA MESA ROAD - NISQUALLI ROAD OVERCROSSING LOG OF TEST BORINGS NO. 3	
	ORIGINAL SCALE IN MILLIMETERS FOR REDUCED PLANS		HORIZONTAL: 1:1200 VERTICAL: 1:100		CU 08224 EA 044501		SHEET 24 OF 24		SHEET 24 OF 24	

SR 18/I 15 Separation

PROJECT NO.	7	STATE	CAL.	FED. AID	FOUR	52	TOTAL	52
DATE	VII 58	BY	31	CHKD	C	9	DATE	5-14-58

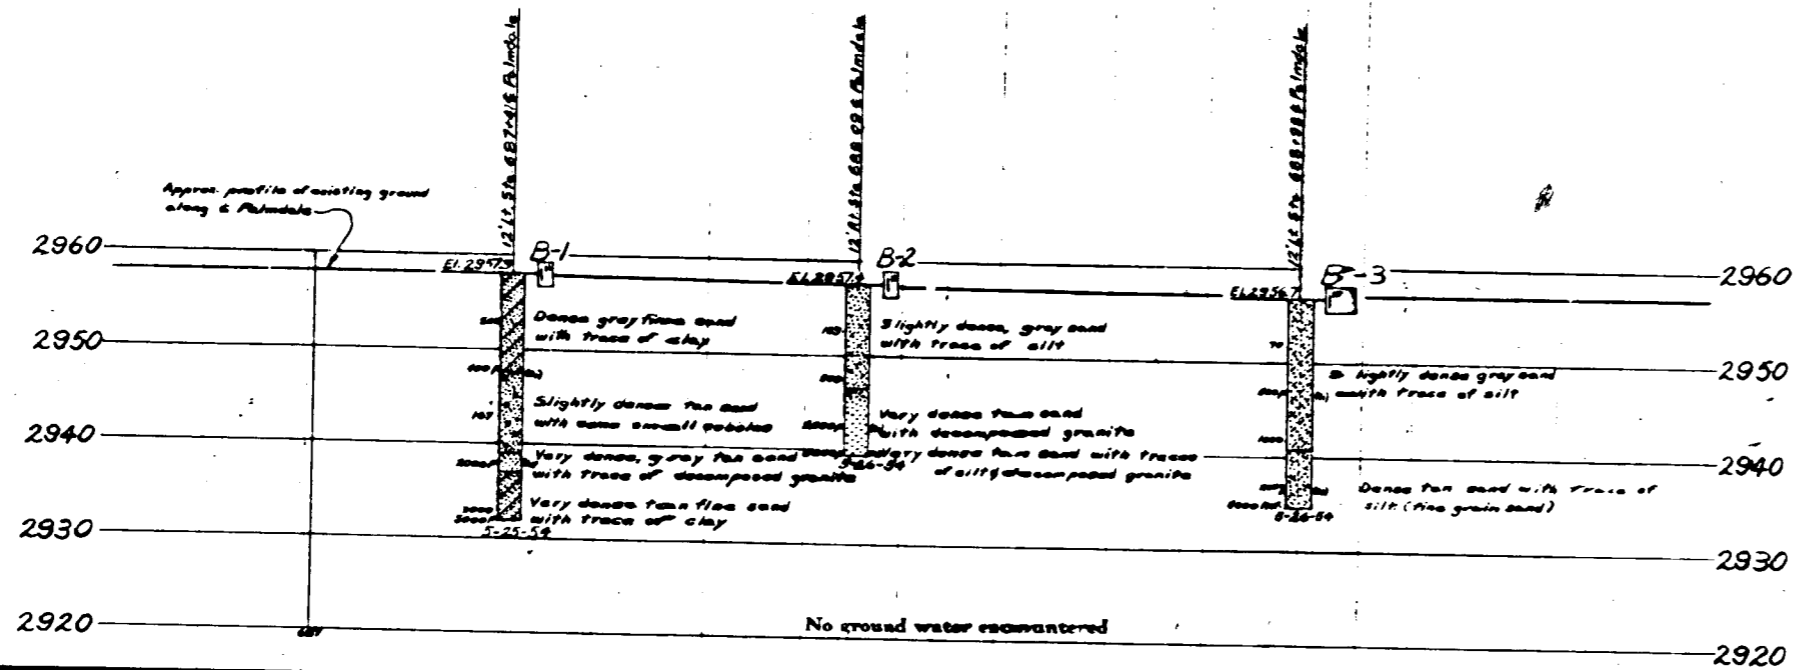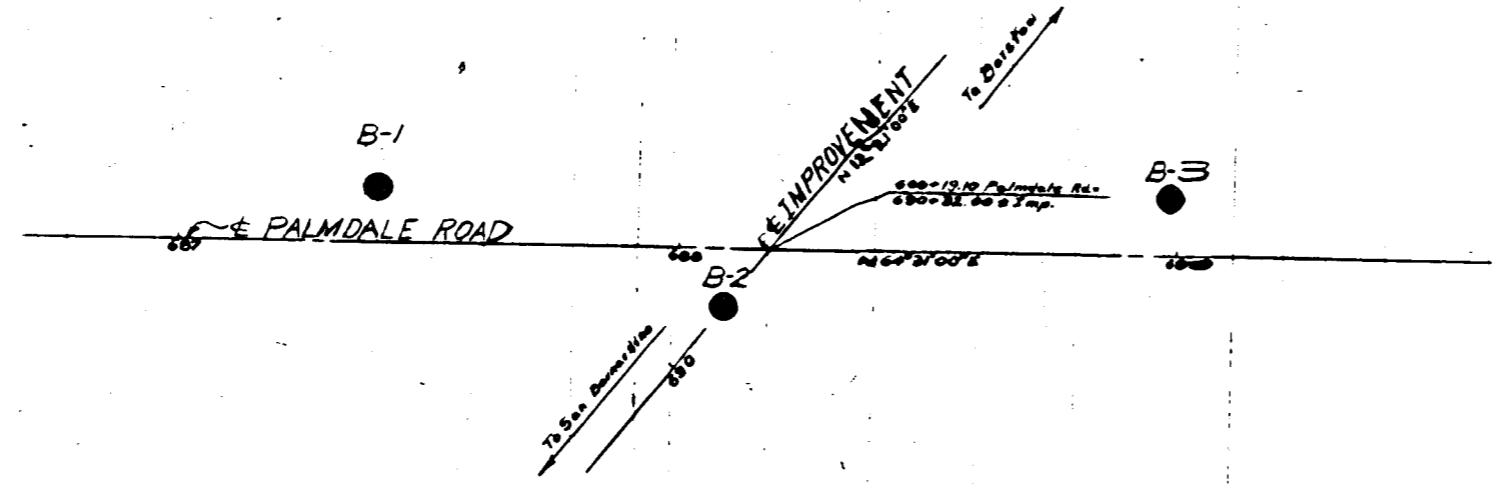


Test Boring By Bridge Dept.

B.M. "C" 70-A-53
 2x2 Rod Head Sp. Hd. Nail buried 1" 166' 17" "C" 70-A-53
 El. 2940.00

B.M. "C" 70-B-53
 2x2 Rod Head Sp. Hd. Nail buried 1" 167' 17" "C" 70-B-53
 El. 2958.92
 Related - Hub 125' right of Sta. 697+32 E. Hg. 176'


AS BUILT
 CORRECTIONS BY *J. M. Winter*
 DATE 12-27-55

FIELD STUDY	BY	J. M. Winter
DRAWN	BY	J. M. Winter
CHECKED	BY	J. M. Winter

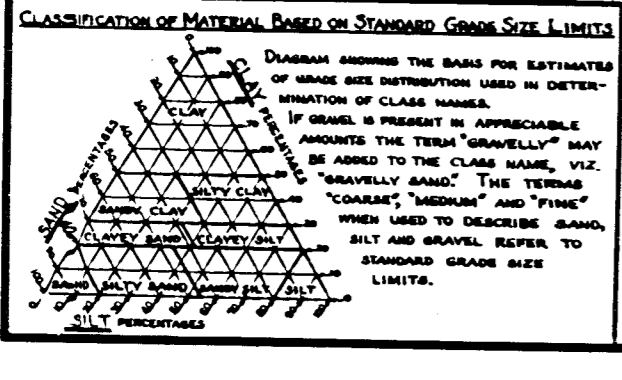

LEGEND OF EARTH MATERIALS

GRAVEL	SILTY CLAY OR CLAYEY SILT
SAND	PEAT AND/OR ORGANIC MATTER
SILT	FILL MATERIAL
CLAY	IGNEOUS ROCK
SANDY CLAY OR CLAYEY SAND	SEDIMENTARY ROCK
SANDY SILT OR SILTY SAND	METAMORPHIC ROCK

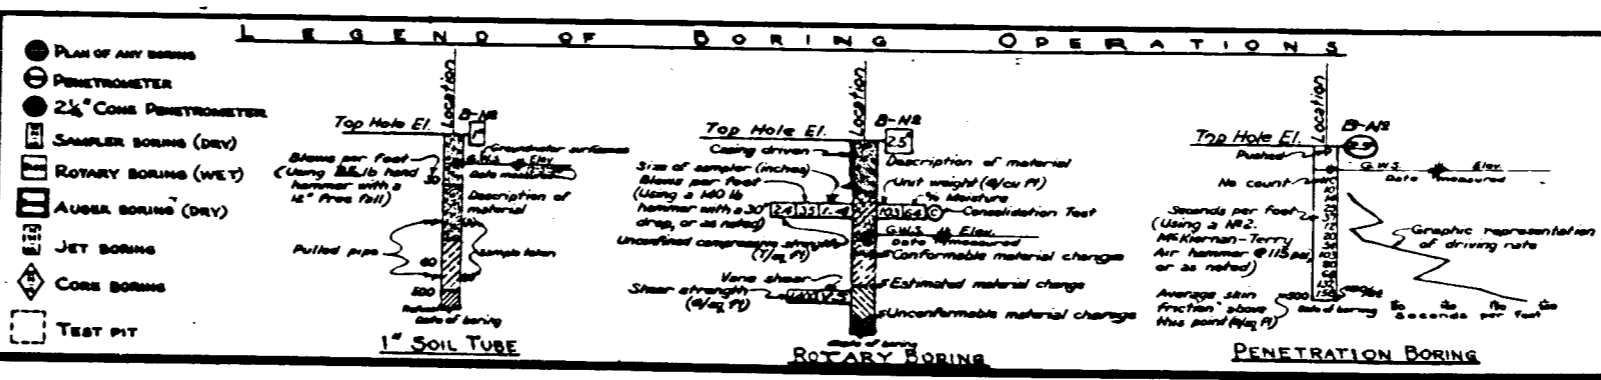

NOTES

The contractor's attention is directed to Section 2, Article (c) of the Standard Specifications and to the Special Provisions accompanying this set of plans. Classification of earth material as shown on this sheet is based upon field inspection and is not to be construed to imply mechanical analysis.

STATE OF CALIFORNIA
 DEPARTMENT OF PUBLIC WORKS
 DIVISION OF HIGHWAYS

PALMDALE ROAD O.C.

LOG OF TEST BORINGS

Scale: Vert. 1"=10', Horiz. 1"=20'



BRIDGE 54-470 FILE E-54 DRAWING C-3406-9

BRIDGE DEPARTMENT

DEPT.	COUNTY	ROUTE	POST MILES - TOTAL PROJECT
08	SBD	18, 15	98.968 - 101.407

Robert W. Reynolds #165
 CERTIFIED ENGINEERING GEOLOGIST
 DATE APPROVED July 8, 1974

BENCH MARK
 B.M. #69-A-70 Elev. 2956.73
 T Bar and cap 90' Lt. 687+50 & Rte. 15.

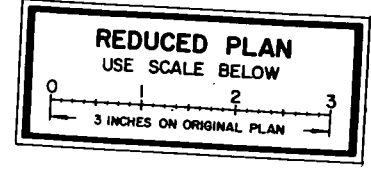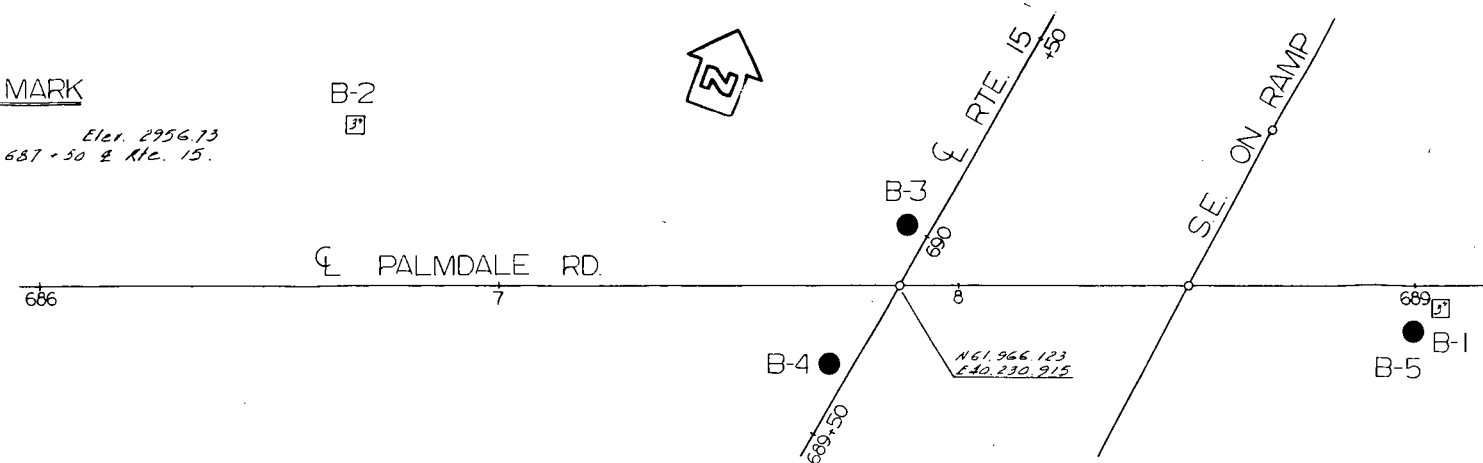

INFORMED WITH THE RESULTS OF BORING TESTS CONDUCTED BY ENGINEER GEOL. GEOLOGY SECTION, D.T. August 1973

PROFILE
 Scale: Vert. 1" = 10'
 Horiz. 1" = 20'

LEGEND OF BORING OPERATIONS

LEGEND OF EARTH MATERIALS

LEGEND OF BORING OPERATIONS

LEGEND OF EARTH MATERIALS

LEGEND OF BORING OPERATIONS

LEGEND OF EARTH MATERIALS


CONSISTENCY CLASSIFICATION FOR SOILS

According to the Standard Proctor Test (ASTM Designation D 1556-67)

Penetration (Blows/Ft)	Cohesive	
	Granular	Cohesive
0-5	Very loose	Very soft
5-10	Loose	Soft
10-20	Slightly compact	Stiff
20-35	Compact	Very stiff
35-70	Dense	Hard
> 70	Very dense	Very hard

UNIFIED SOIL CLASSIFICATION SYSTEM

CL	CLAY	High Plasticity
ML	CLAY	Low Plasticity
OL	CLAY	Very Low Plasticity
CH	CLAY	High Plasticity
MH	CLAY	Low Plasticity
OH	CLAY	Very Low Plasticity
GM	GRAVELLY SAND	
SM	SANDY SILT	
GC	CLAYEY SAND	
SC	SANDY CLAY	
GM	GRAVELLY SAND	
SM	SANDY SILT	
GC	CLAYEY SAND	
SC	SANDY CLAY	

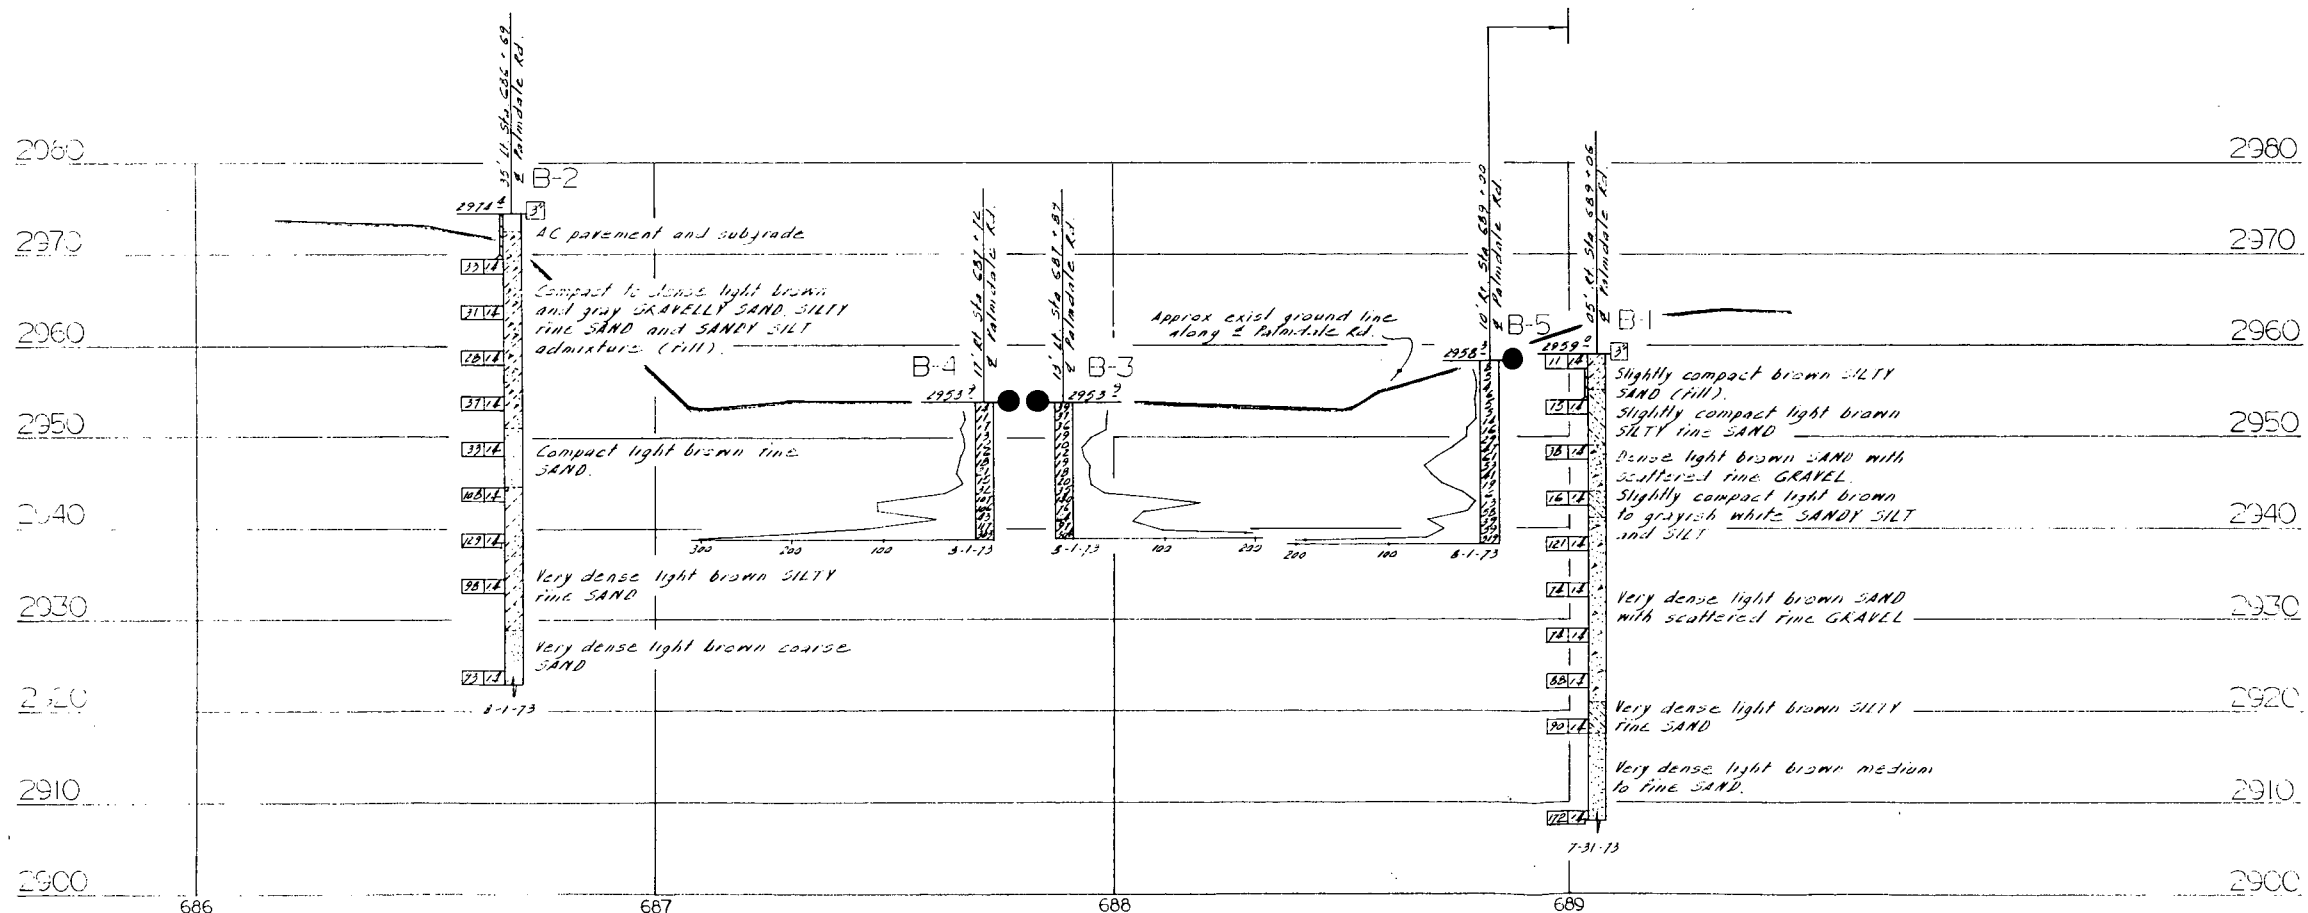

GEOLOGY

ENGINEERING GEOLOGY SECTION

FIELD STUDY	By O. Mikes 8-3-73	Approval Recommended By	Charles E. Frank
DRAWN	By J. Law 8-8-73	ENGINEERING GEOLOGIST	
CHECKED	By M. Collins 9-5-73	CERTIFIED ENGINEERING GEOLOGIST NUMBER	40

State of CALIFORNIA	BRIDGE DEPARTMENT
DEPARTMENT OF TRANSPORTATION	DESIGN SECTION
	2
	BRIDGE NO. 54-470
	POST MILE 96.57
	PROJECT ENGINEER <i>Ellen Dawson</i>

PALMDALE ROAD SEPARATION (RTE 18/15)
LOG OF TEST BORINGS

BRIDGE NO. 54-470	POST MILE 96.57
PROJECT ENGINEER <i>Ellen Dawson</i>	

DIST.	COUNTY	ROUTE	POST MILES-TOTAL PROJECT	Sheet No.	Total Sheets
08	SBD	18			

CERTIFIED ENGINEERING GEOLOGIST
DATE APPROVED _____ NUMBER _____

PLAN
Scale 1" = 20'

PROFILE
Scale Vert 1" = 10'
Horiz 1" = 20'

LEGEND OF BORING OPERATIONS

ROTARY BORINGS:
 - 1/2" CONE PENETROMETER
 - SAMPLER BORING (DRY)
 - RETRIEVAL BORING (WET)
 - JET BORING
 - CORE BORING

PENETRATION BORING:
 - TEST PIT

SOIL TUBE:
 - 2 1/2" SOIL TUBE

Other symbols:
 - Boring log
 - Boring log with soil description
 - Boring log with soil description and test results
 - Boring log with soil description and test results and groundwater level


LEGEND OF EARTH MATERIALS

GRAVEL: (Symbol)
SAND: (Symbol)
SILT: (Symbol)
CLAY: (Symbol)
SANDY CLAY: (Symbol)
CLAYEY SAND: (Symbol)
SILTY SAND: (Symbol)


CONSISTENCY CLASSIFICATION FOR SOILS
 According to the Standard Penetration Test
 ASTM Designation D 1586-67

Penetration Index (Blows/FT)	Consistency	
	Granular	Cohesive
C-5	Very loose	Very soft
5-10	Loose	Soft
10-20	Slightly compact	Stiff
20-30	Medium dense	Hard
30-50	Dense	Very hard
> 50	Very dense	

NOTE: Classification of earth material as shown on this sheet is based upon field inspection and is not to be construed to imply mechanical analysis.

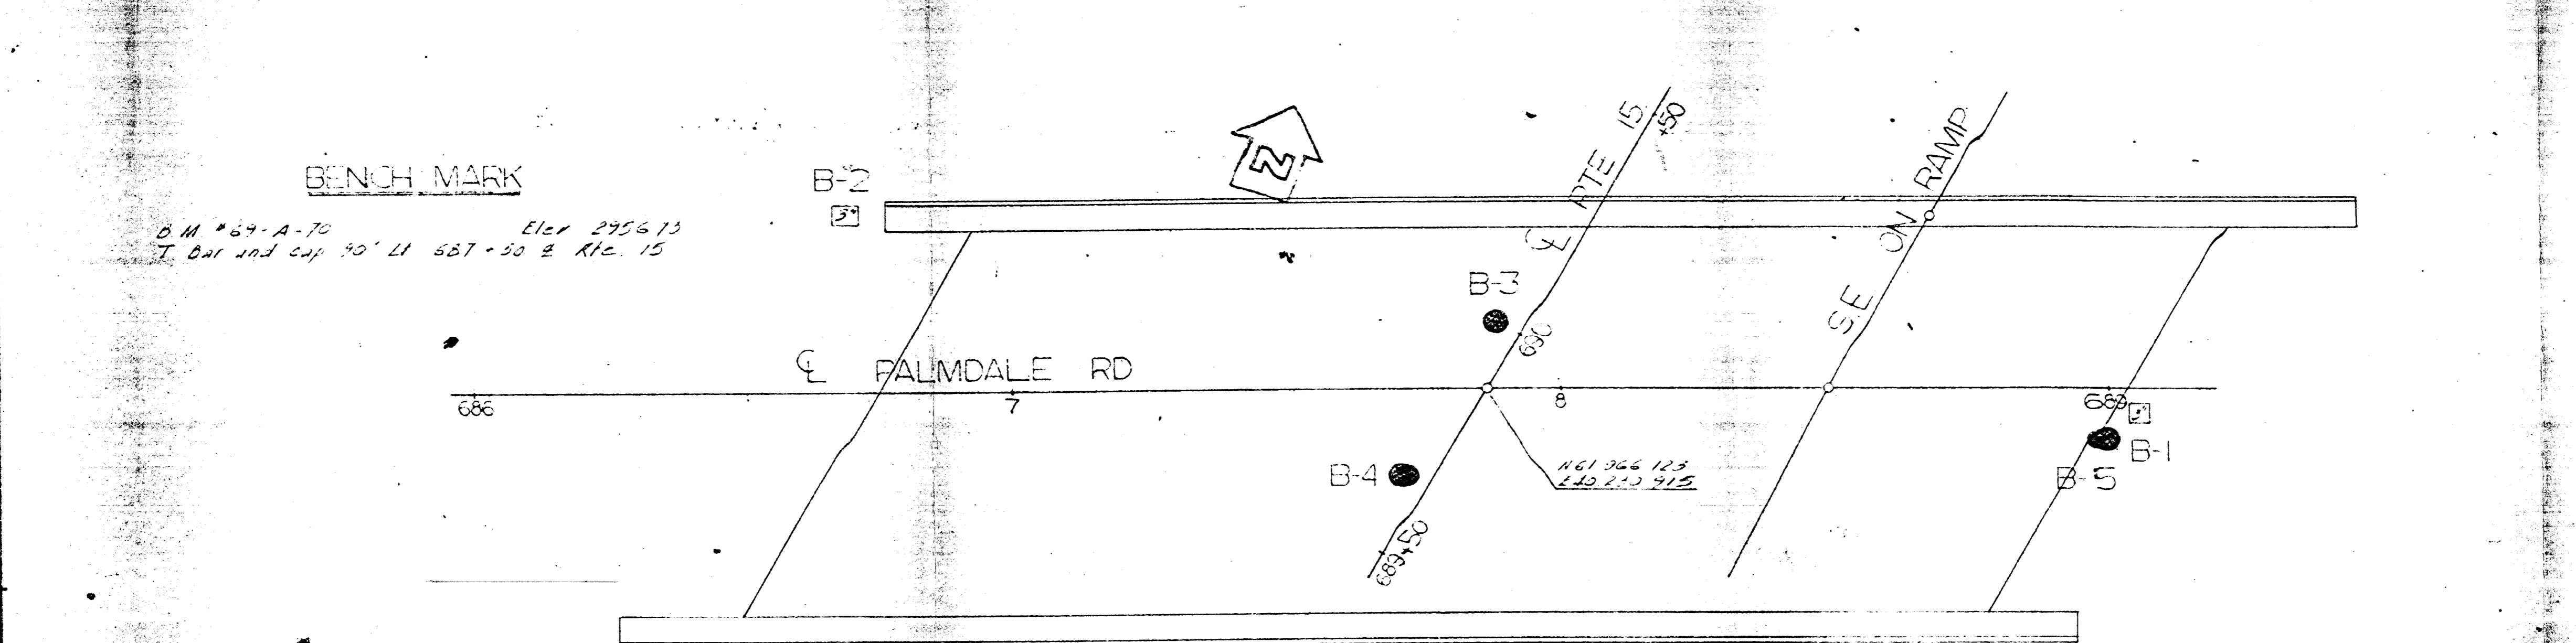

NO GROUND WATER ENCOUNTERED DURING THIS INVESTIGATION BY BRIDGE DEPT. GEOLOGY SECTION
DATE August 1973

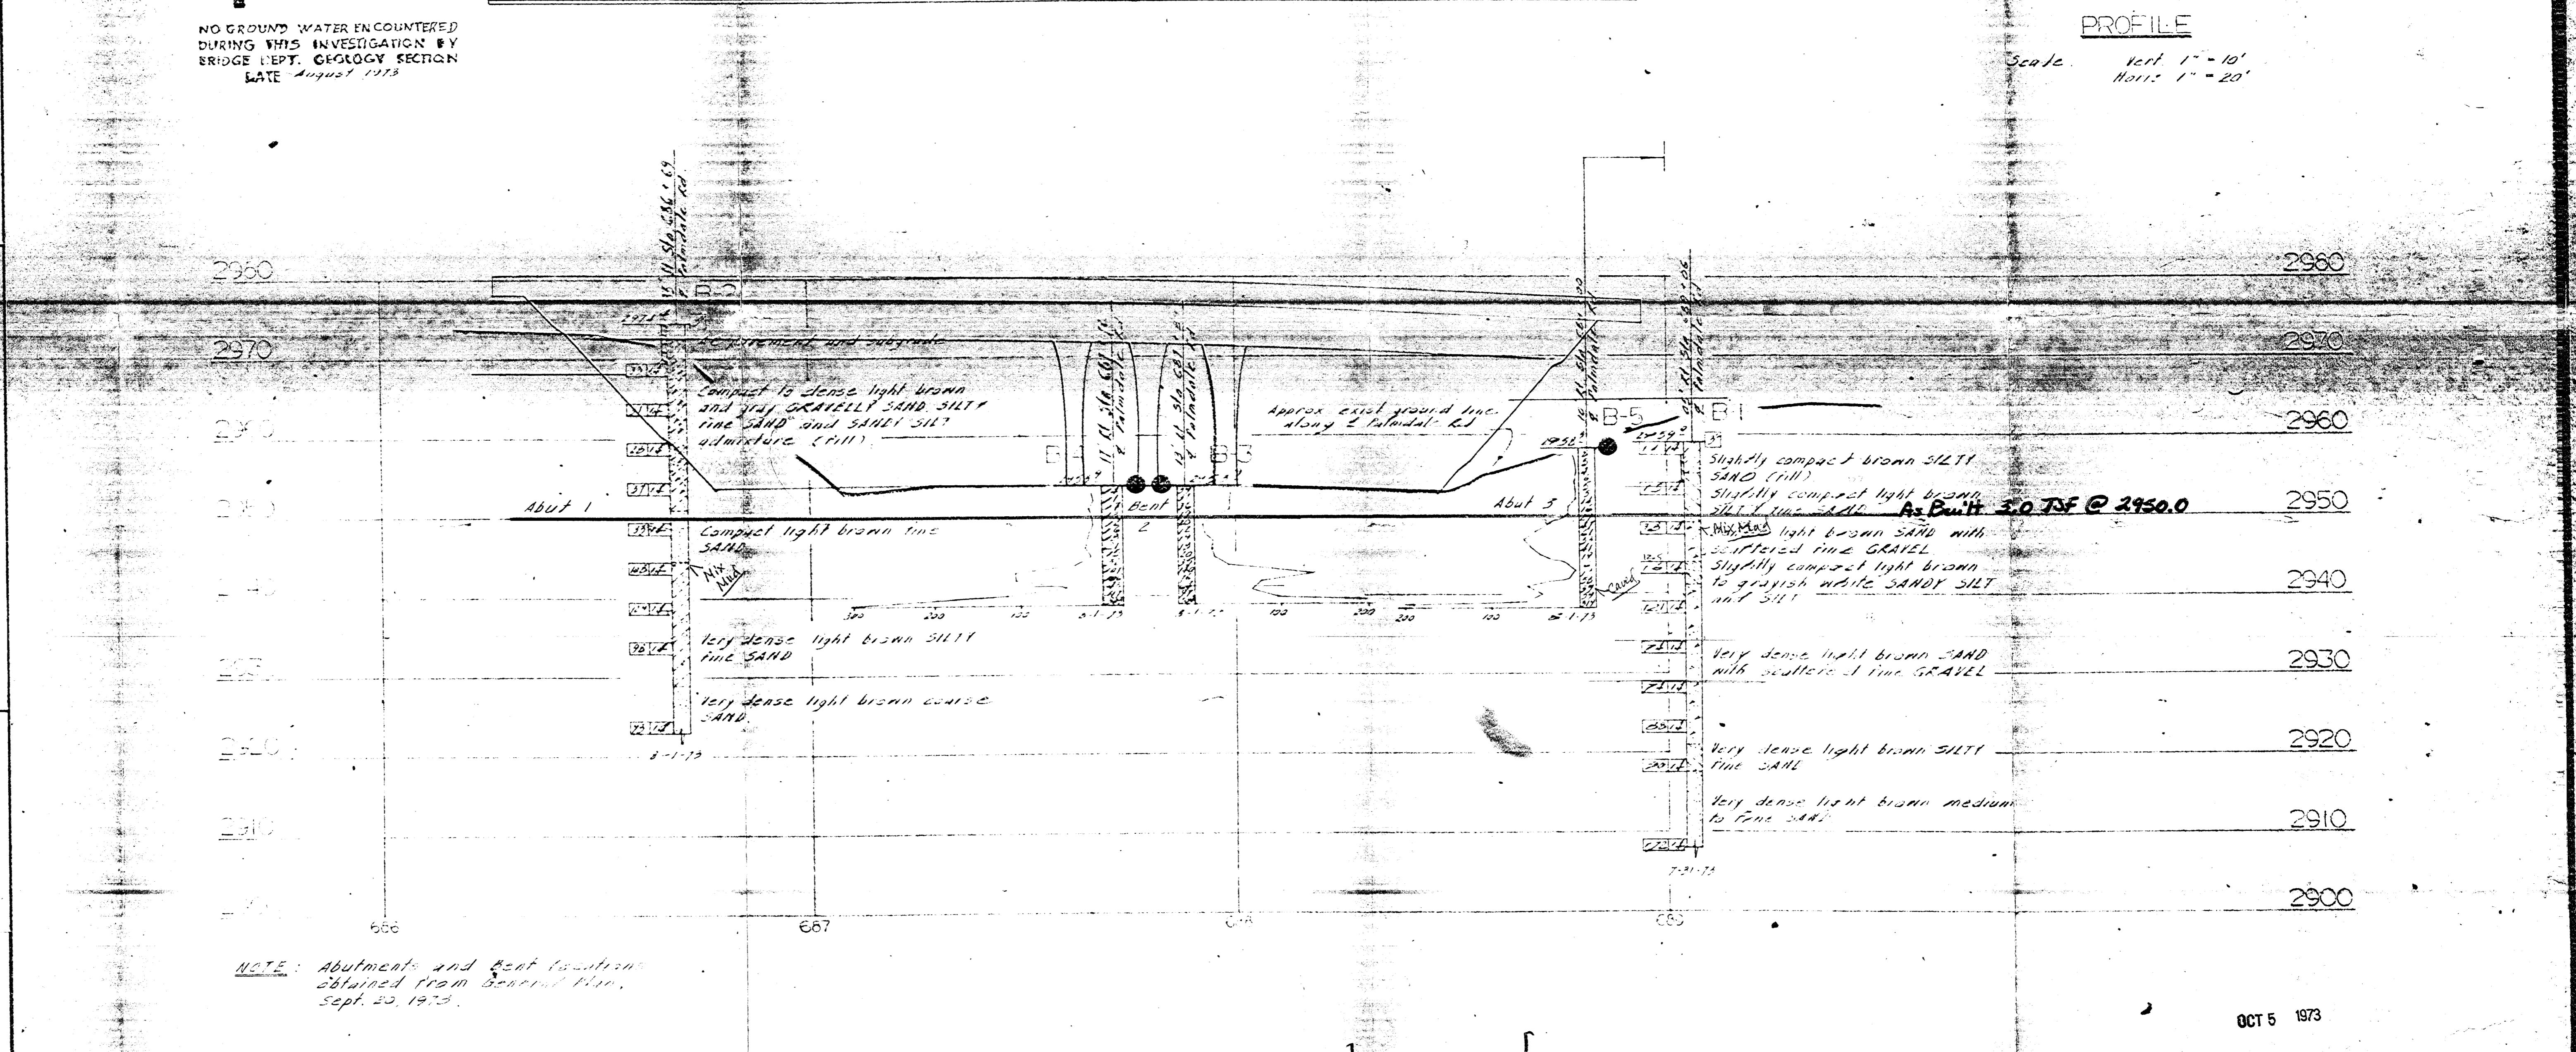

NOTE: Abutment and Bent locations obtained from General Plan, Sept. 22, 1973.

OCT 5 1973

ENGINEERING GEOLOGY SECTION FIELD STUDY By Mike 5-3-73 DRAWN By Luv 5-3-73 CHECKED By		Approval Recommended By ENGINEER GEOLOGIST STATE OF CALIFORNIA GEOLOGIST NUMBER	State of CALIFORNIA DEPARTMENT OF TRANSPORTATION	BRIDGE DEPARTMENT DESIGN SECTION PROJECT ENGINEER	BRIDGE NO. 54-470 POST MILE 96.57	PALMDALE ROAD SEPARATION (18/15)(REPLACE) LOG OF TEST BORINGS
---	--	---	--	---	--	---

ORIGINAL SCALE IN INCHES FOR REDUCED PLANS

CU 0610Z
WO 131811

Disregard prices bearing earlier revision dates

REVISION DATES (PRELIMINARY STAGE ONLY)

Roy Rogers Drive OC


DIST	COUNTY	ROUTE	POST MILES TOTAL PROJECT	SHEET NO.	TOTAL SHEETS
8	SBd	15	40.7 - 41.8	2	5

Steven P. Alford
 GEOTECHNICAL PROFESSIONAL
 12-7-90
 PLANS APPROVAL DATE

REG. CIVIL ENGINEER
 STEVEN P. ALFORD
 No. 34276
 Exp. 9/30/91
 STATE OF CALIFORNIA

LEIGHTON AND ASSOCIATES, INC.

- GEOTECHNICAL LEGEND**
- T-7 [Symbol] Approximate location of exploratory trench.
 - B-8 [Symbol] Approximate location of exploratory boring.
 - 2936 [Symbol] Contour line with elevation in feet above mean sea level.
 - 35 [Symbol] Center line of street with station number indicated.
 - + [Symbol] Center line for intersection.
 - G.W. [Symbol] Groundwater: No groundwater was encountered.
 - [Symbol] Approximate location of deleterious material.

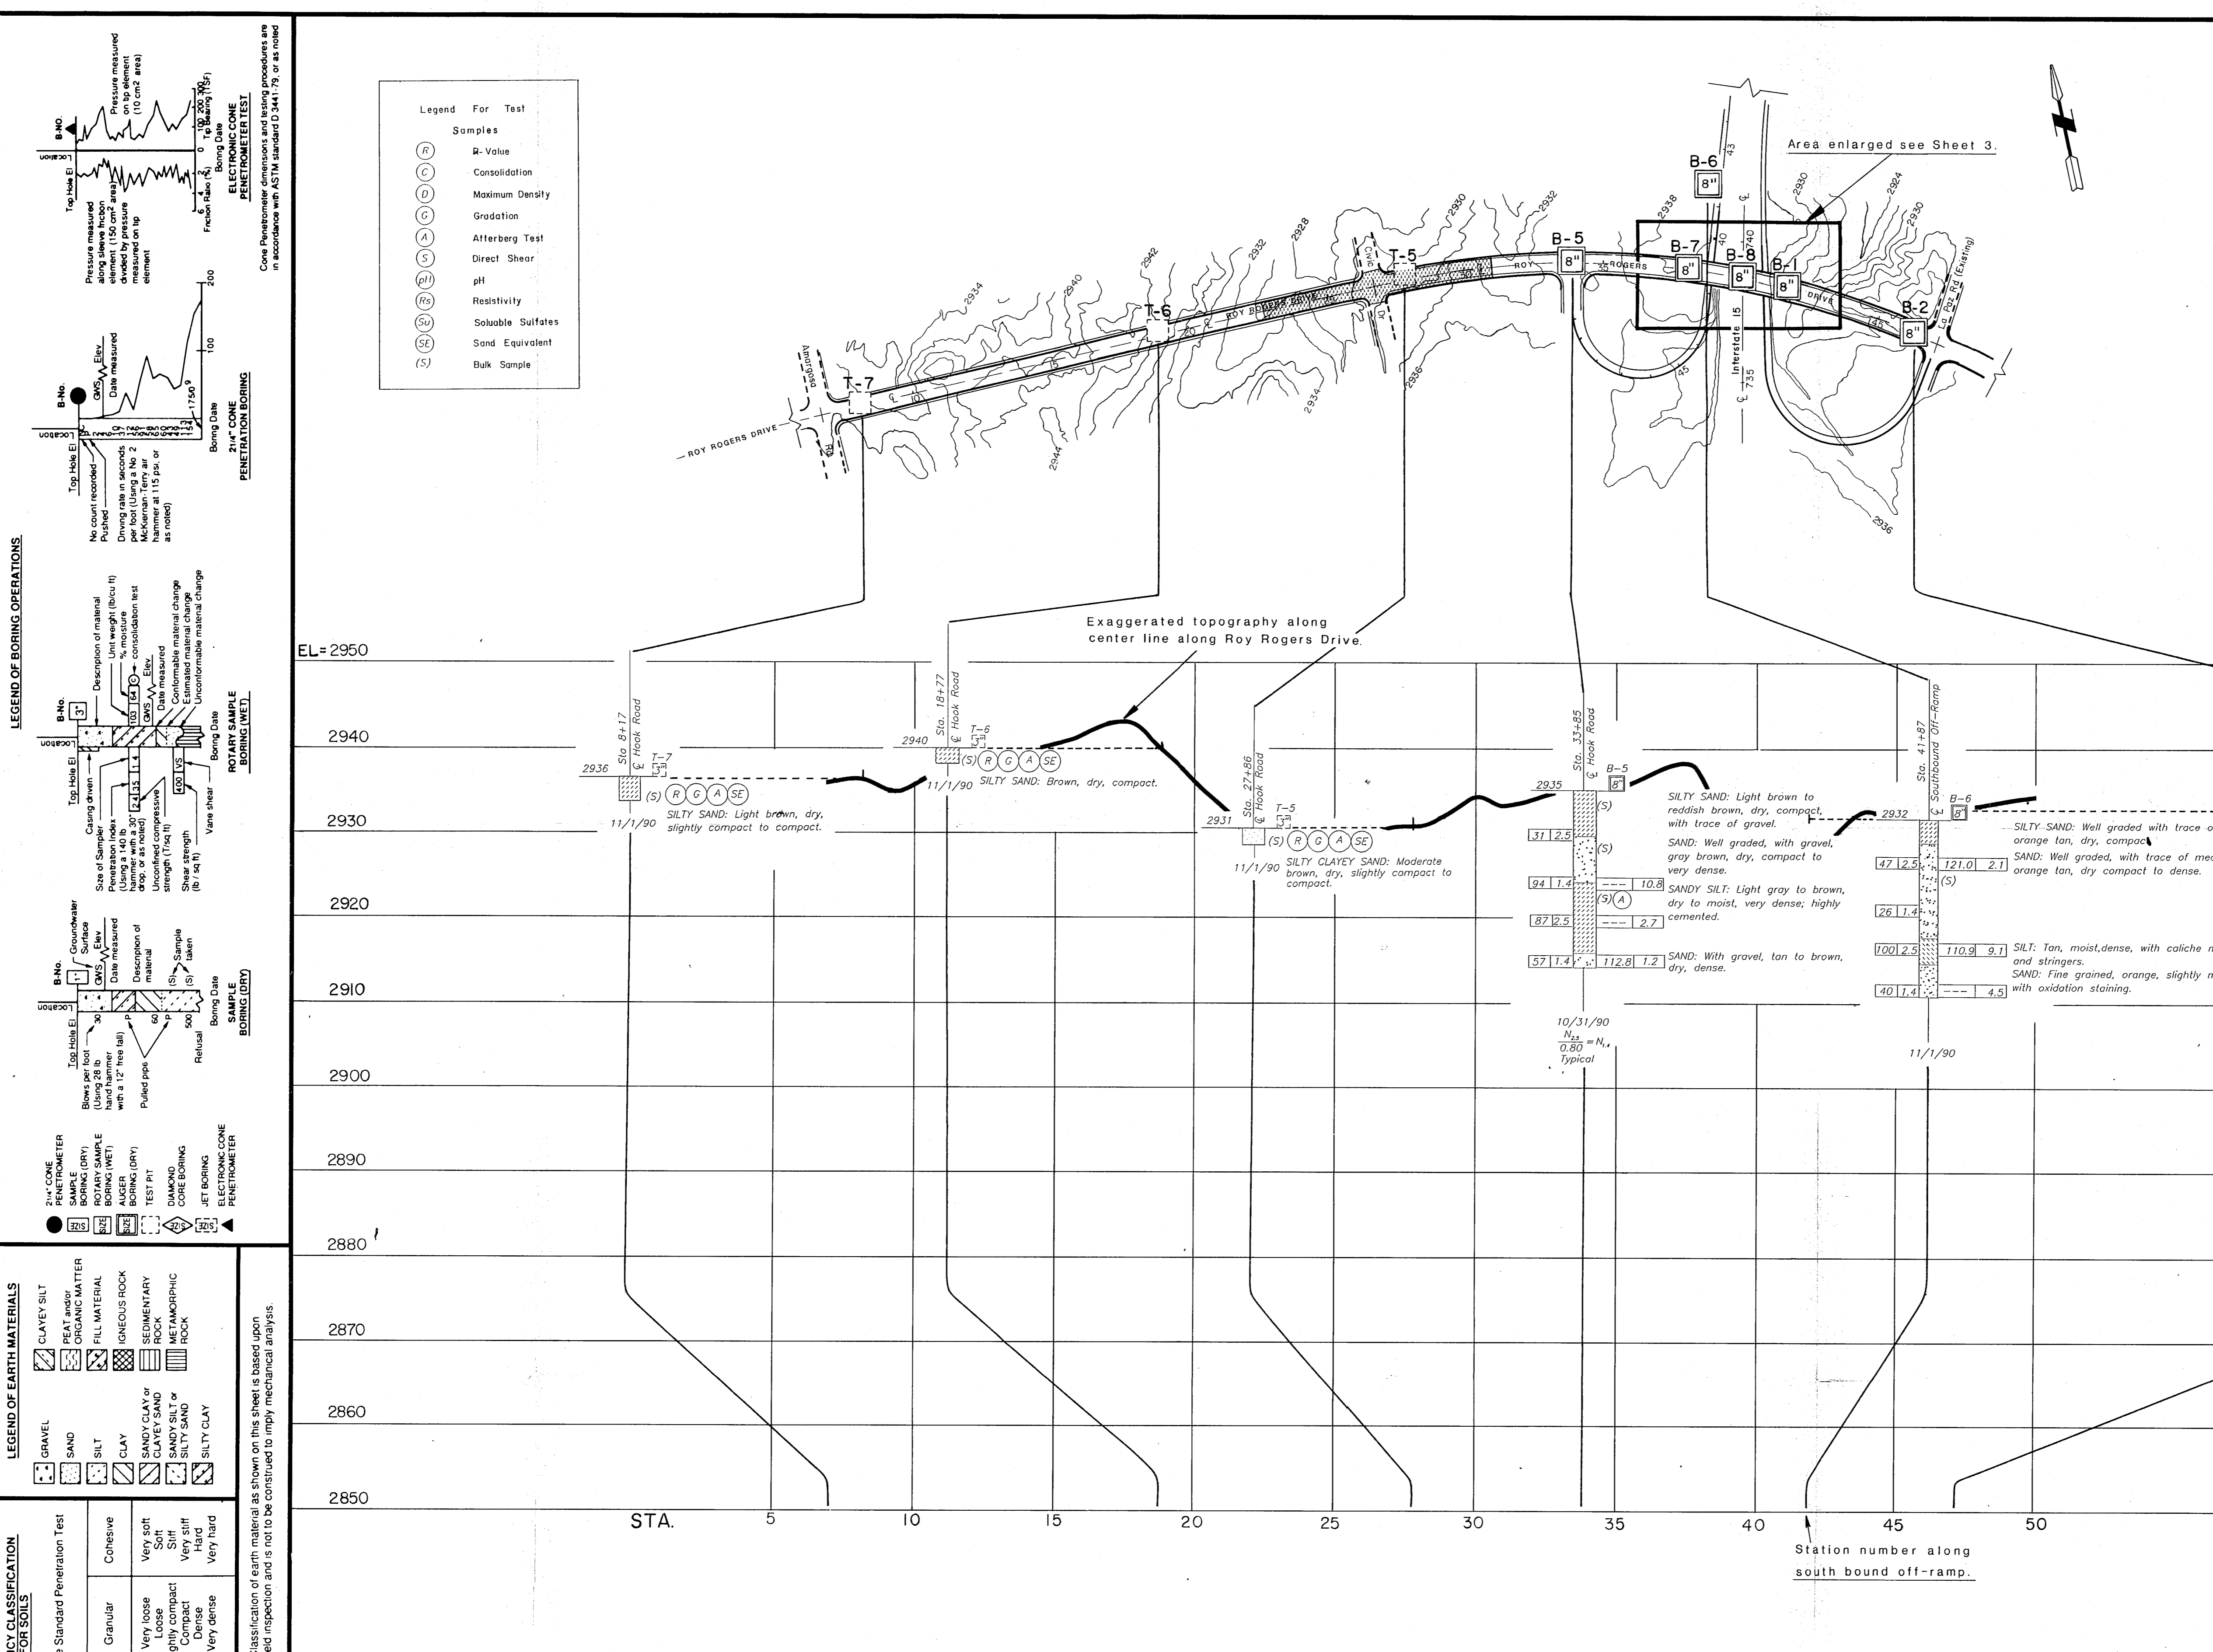

LEGEND OF BORING OPERATIONS

2 1/4" CONE PENETRATION BORING
 No. count recorded
 Penetration rate in seconds
 Date measured
 (Using a No. 2
 Mikkelsen-Terry air
 at noted)

ROTARY SAMPLE BORING (WET)
 B.No.
 Top Hole Elevation
 Casing size
 Description of material
 Unit weight (lb/cu ft)
 Date measured
 (Using a No. 2
 Mikkelsen-Terry air
 at noted)
 Penetration index
 Shear strength (lb/1 sq ft)
 Vane shear
 Date measured
 (Using a No. 2
 Mikkelsen-Terry air
 at noted)
 Description of material
 Unit weight (lb/cu ft)
 Date measured
 (Using a No. 2
 Mikkelsen-Terry air
 at noted)
 Penetration index
 Shear strength (lb/1 sq ft)
 Vane shear
 Date measured
 (Using a No. 2
 Mikkelsen-Terry air
 at noted)

ROTARY SAMPLE BORING (DRY)
 B.No.
 Top Hole Elevation
 Casing size
 Description of material
 Unit weight (lb/cu ft)
 Date measured
 (Using a No. 2
 Mikkelsen-Terry air
 at noted)
 Penetration index
 Shear strength (lb/1 sq ft)
 Vane shear
 Date measured
 (Using a No. 2
 Mikkelsen-Terry air
 at noted)

2 1/4" CONE PENETRATION BORING
 No. count recorded
 Penetration rate in seconds
 Date measured
 (Using a No. 2
 Mikkelsen-Terry air
 at noted)

LEGEND OF EARTH MATERIALS

GRAVEL	CLAYEY SILT
SAND	PEAT and/or ORGANIC MATERIAL
SILT	FILL MATERIAL
CLAY	IGNEOUS ROCK
SANDY CLAY or CLAYEY SAND	SEDIMENTARY ROCK
CLAYEY SAND or SILTY SAND	METAMORPHIC ROCK
SILTY CLAY	

CONSISTENCY CLASSIFICATION FOR SOILS

According to the Standard Penetration Test

Penetration Index (Blows / Ft)	Cohesive	
	Very soft	Very hard
0-4	Very loose	Very dense
5-9	Loose	
10-14	Slightly compact	
15-19	Medium dense	
20-34	Dense	
35-59	Very dense	
>70		

NOTE: Classification of earth material as shown on this sheet is based upon field inspection and is not to be considered to imply mechanical analysis.

DESIGN OVERSIGHT	DRAWN BY MILES D. KENNEY 12/7/90	FIELD INVESTIGATOR GREG UECKER/FRED WINKLER	LEIGHTON & ASSOCIATES, INC. P.N. 12900307-03	BRIDGE NO. 54-1118	ROY ROGERS DRIVE OVERCROSSING LOG OF TEST BORINGS
SIGN OFF DATE	CHECKED BY STEVEN P. ALFORD 12/7/90	DATE 10/31/90 & 11/1/90	PROJECT ENGINEER	POST MILE 40.52	

ORIGINAL SCALE IN INCHES FOR REDUCED PLANS: 0 1 2 3

CU 08103 EA 251901

DISREGARD PRINTS BEARING EARLIER REVISION DATES

REVISION DATES (PRELIMINARY STAGE ONLY)		SHEET	OF
		2	5

DIST	COUNTY	ROUTE	POST MILES TOTAL PROJECT	SHEET NO.	TOTAL SHEETS
8	SBd	15	40.7 - 41.8	3	5

GEOTECHNICAL PROFESSIONAL
 12-7-90
 PLANS APPROVAL DATE

REGISTERED CIVIL ENGINEER
 STEVEN P. ALFORD
 No. 34276
 Exp. 9/30/91
 STATE OF CALIFORNIA

LEIGHTON AND ASSOCIATES, INC.

GEOTECHNICAL LEGEND

- B-8
Approximate location of exploratory boring.
- 2936
Contour line with elevation in feet above mean sea level.
- Low point for wash.
- 39
Center line of street with station number indicated.
- G.W.
Groundwater: No groundwater was encountered.
- Approximate location of deleterious material.

LEGEND OF BORING OPERATIONS

2 1/4" CONE PENETROMETER TEST

Pressure measured along sleeve friction divided by 150 cone area divided by 150 cone area measured on tip element

2 1/4" CONE PENETRATION BORING

No. count recorded
Driving rate in seconds per foot (Using a No. 2 hammer at 15 ft/s or as noted)

ROTARY SAMPLE BORING (DRY)

Size of Sample
Using a 1 1/2" diameter sampler with a 30" length
Unconfined compression strength (1/4" dia.)
Shear strength (1/4" dia.)
View shear

2 1/4" CONE PENETROMETER SAMPLE BORING (DRY)

Groundwater
Date measured
Description of material

LEGEND OF EARTH MATERIALS


- GRAVEL
- SAND
- SILT
- CLAY
- SANDY CLAY
- CLAYEY SAND
- SANDY SILT
- SILT CLAY
- CLAYEY SILT
- PEAT
- ORGANIC MATTER
- FILL MATERIAL
- IGNEOUS ROCK
- SEDIMENTARY ROCK
- METAMORPHIC ROCK

CONSISTENCY CLASSIFICATION FOR SOILS

According to the Standard Penetration Test


Penetration Index (Blows / Ft)	Cohesive
0-4	Very loose
5-9	Loose
10-19	Slightly compact
20-34	Compact
35-69	Dense
>70	Very dense

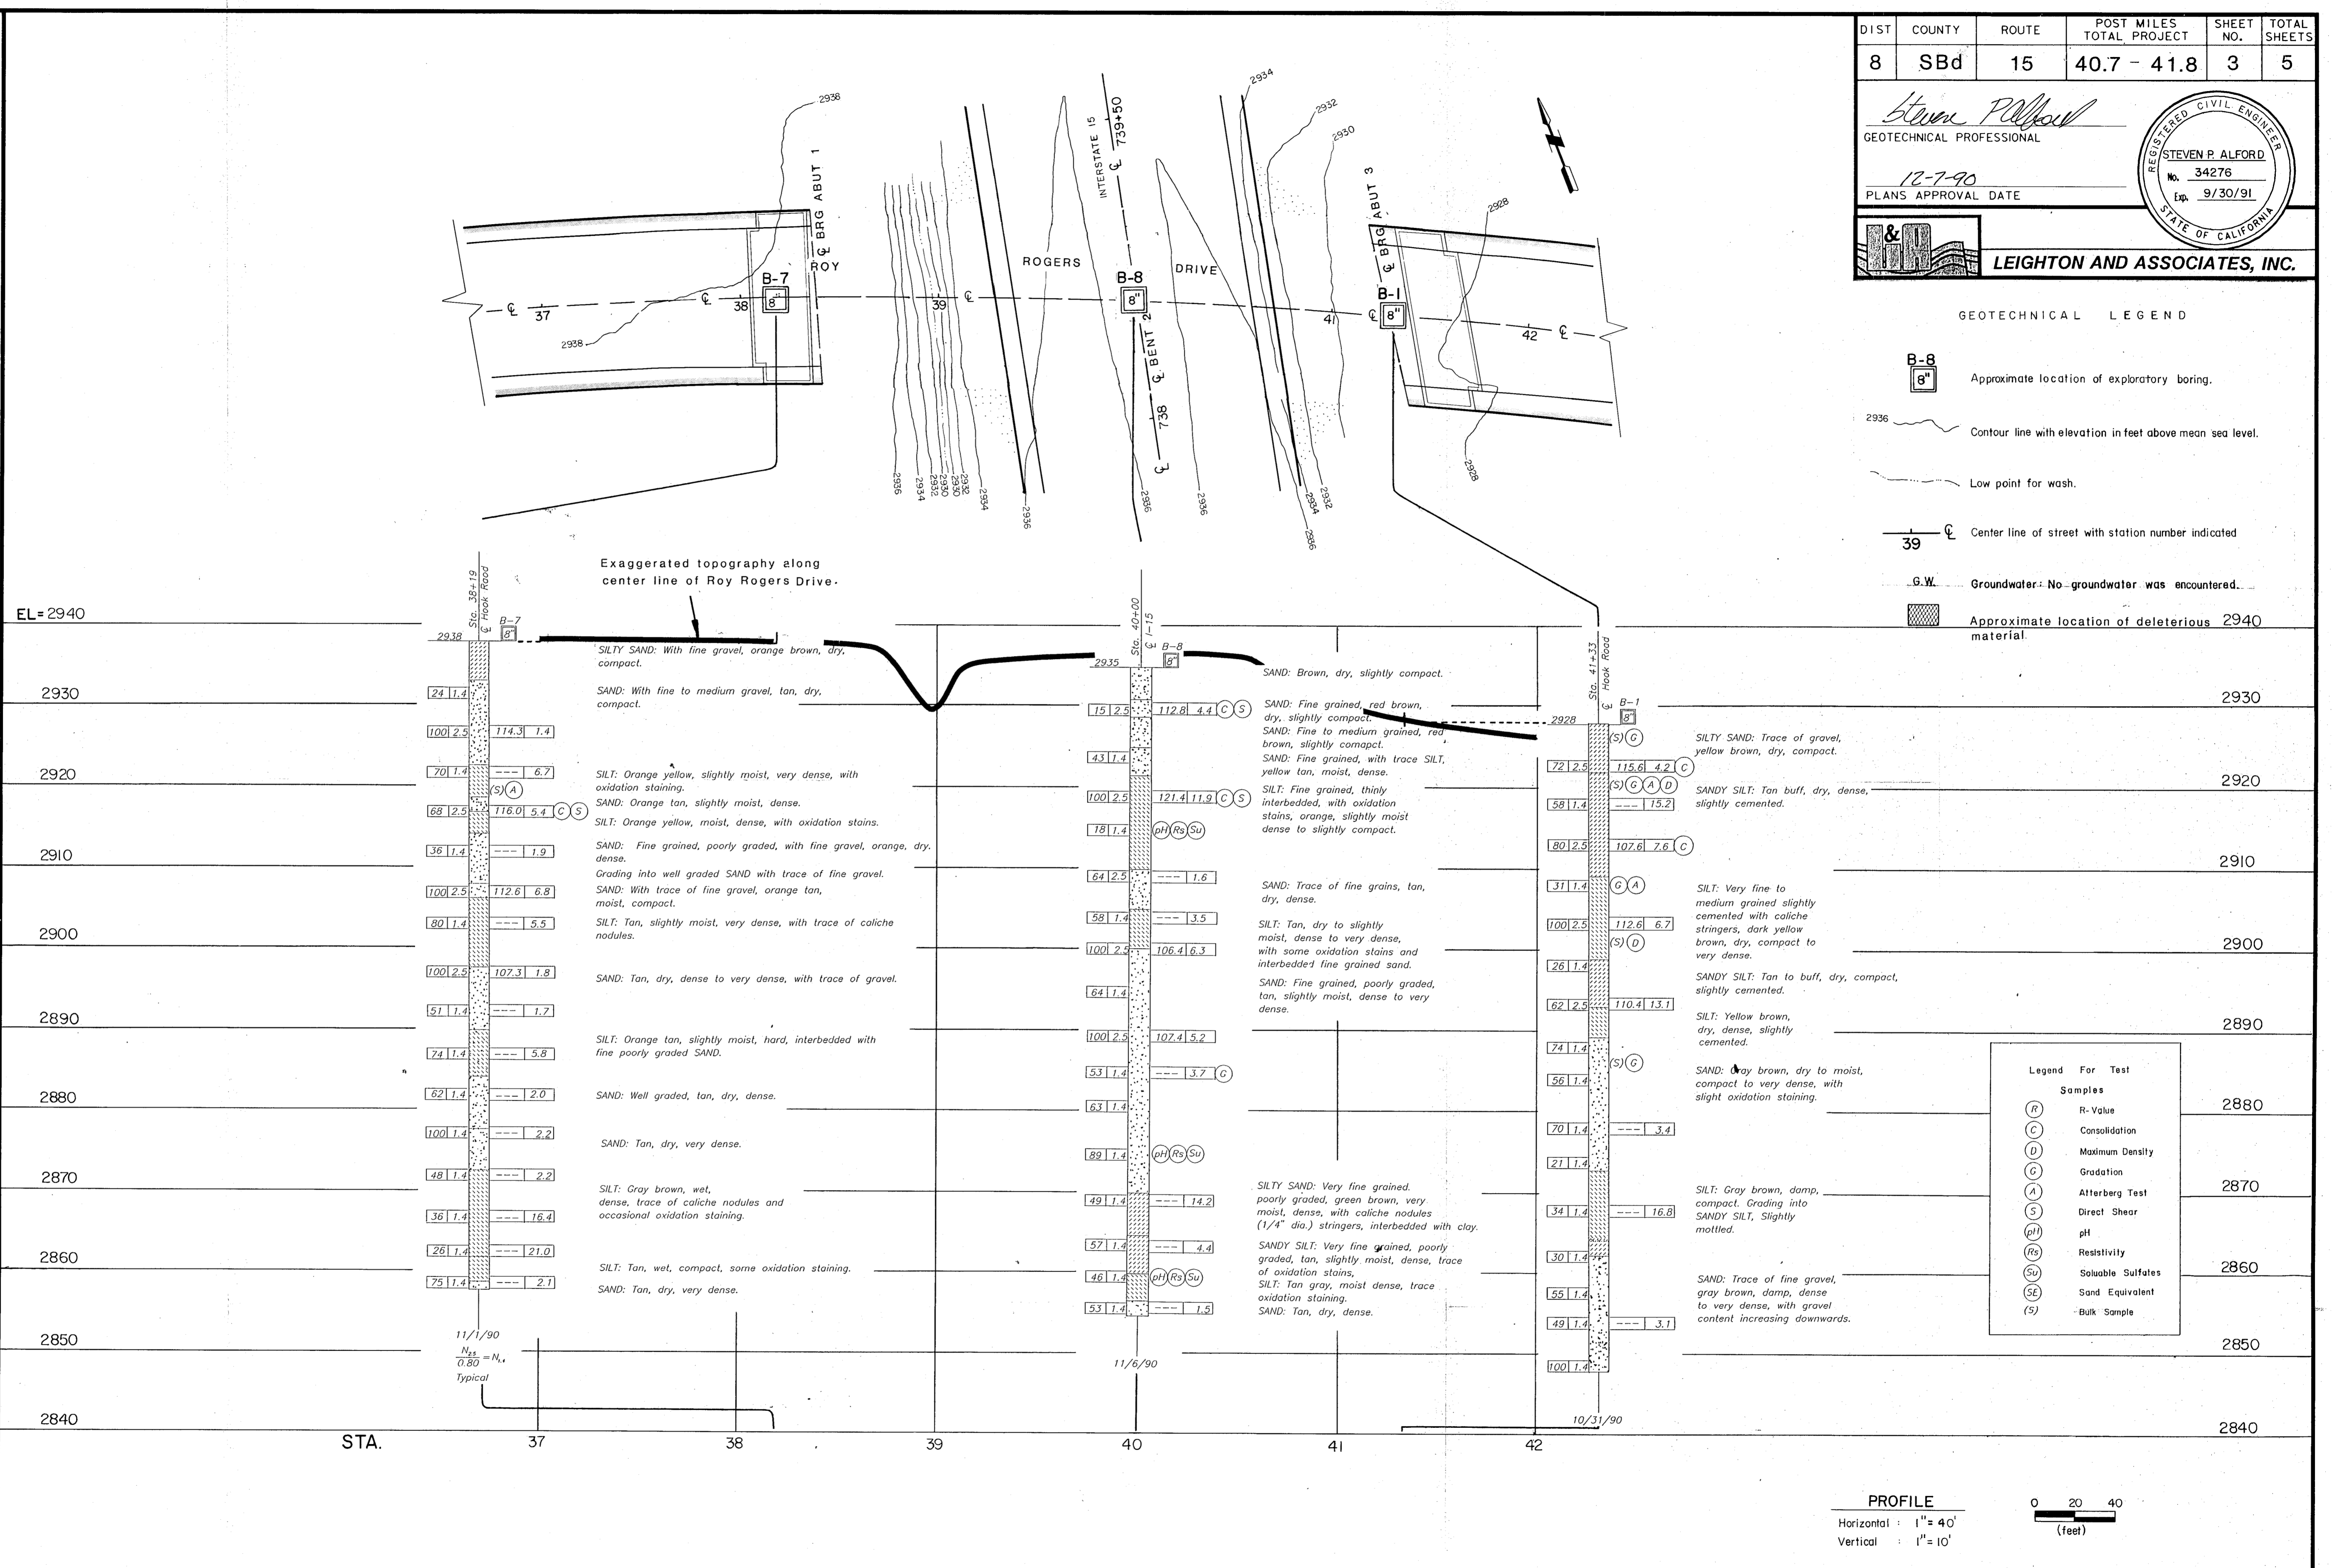






NOTE: Classification of earth material as shown on this sheet is based upon field inspection and is not to be construed to imply mechanical analysis





DESIGN OVERSIGHT	DRAWN BY MILES D. KENNEY 12/7/90	GREG UECKER/FRED WINKLER FIELD INVESTIGATOR	LEIGHTON & ASSOCIATES, INC. P.N. 12900307-03	BRIDGE NO. 54-1118	ROY ROGERS DRIVE OVERCROSSING
SIGN OFF DATE	CHECKED BY STEVEN P. ALFORD 12/7/90	DATE 10/31/90 & 11/1/90	PREPARED FOR THE STATE OF CALIFORNIA DEPARTMENT OF TRANSPORTATION	POST MILE 40.52	LOG OF TEST BORINGS
ORIGINAL SCALE IN INCHES FOR REDUCED PLANS				CU 08103 EA 251901	DISREGARD PRINTS BEARING EARLIER REVISION DATES
REVISION DATES (PRELIMINARY STAGE ONLY)					SHEET OF 3 5

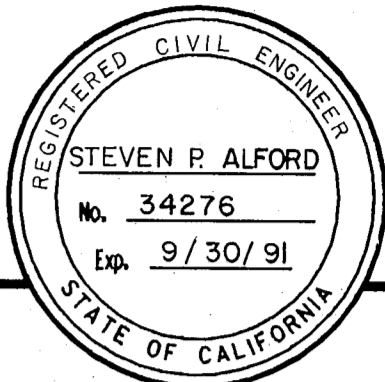DIST	COUNTY	ROUTE	POST MILES TOTAL PROJECT	SHEET NO.	TOTAL SHEETS
8	SBd	15	40.7 - 41.8	4	5

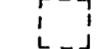Steven P. Alford
 GEOTECHNICAL PROFESSIONAL
 12-7-90
 PLANS APPROVAL DATE

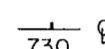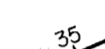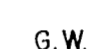LEIGHTON AND ASSOCIATES, INC.

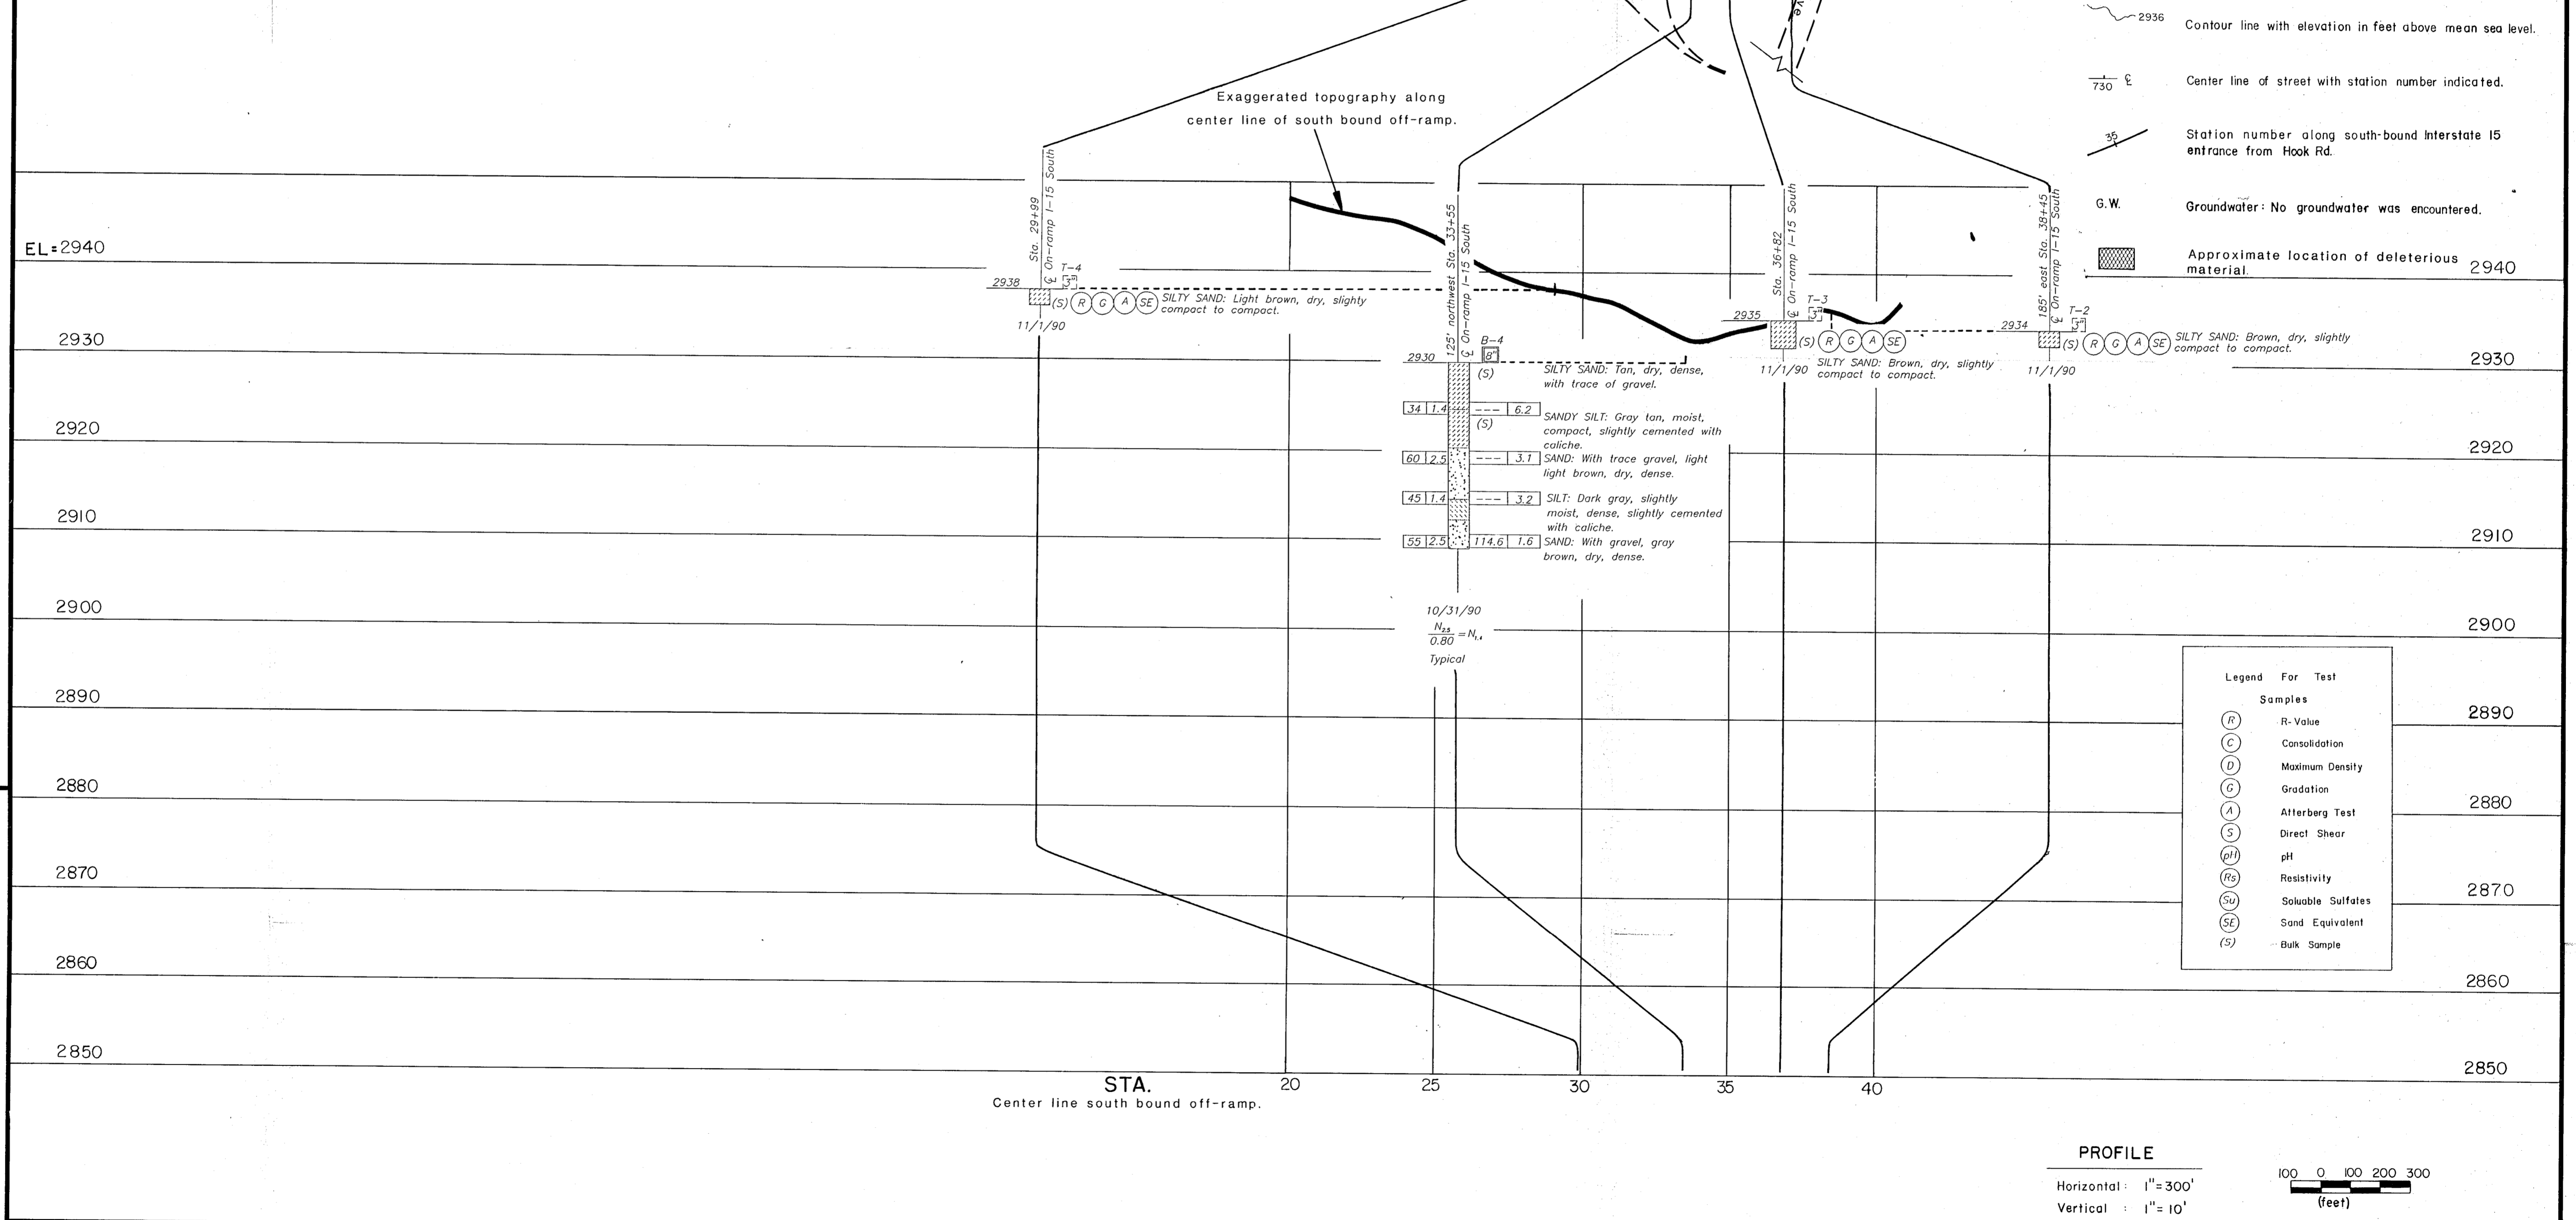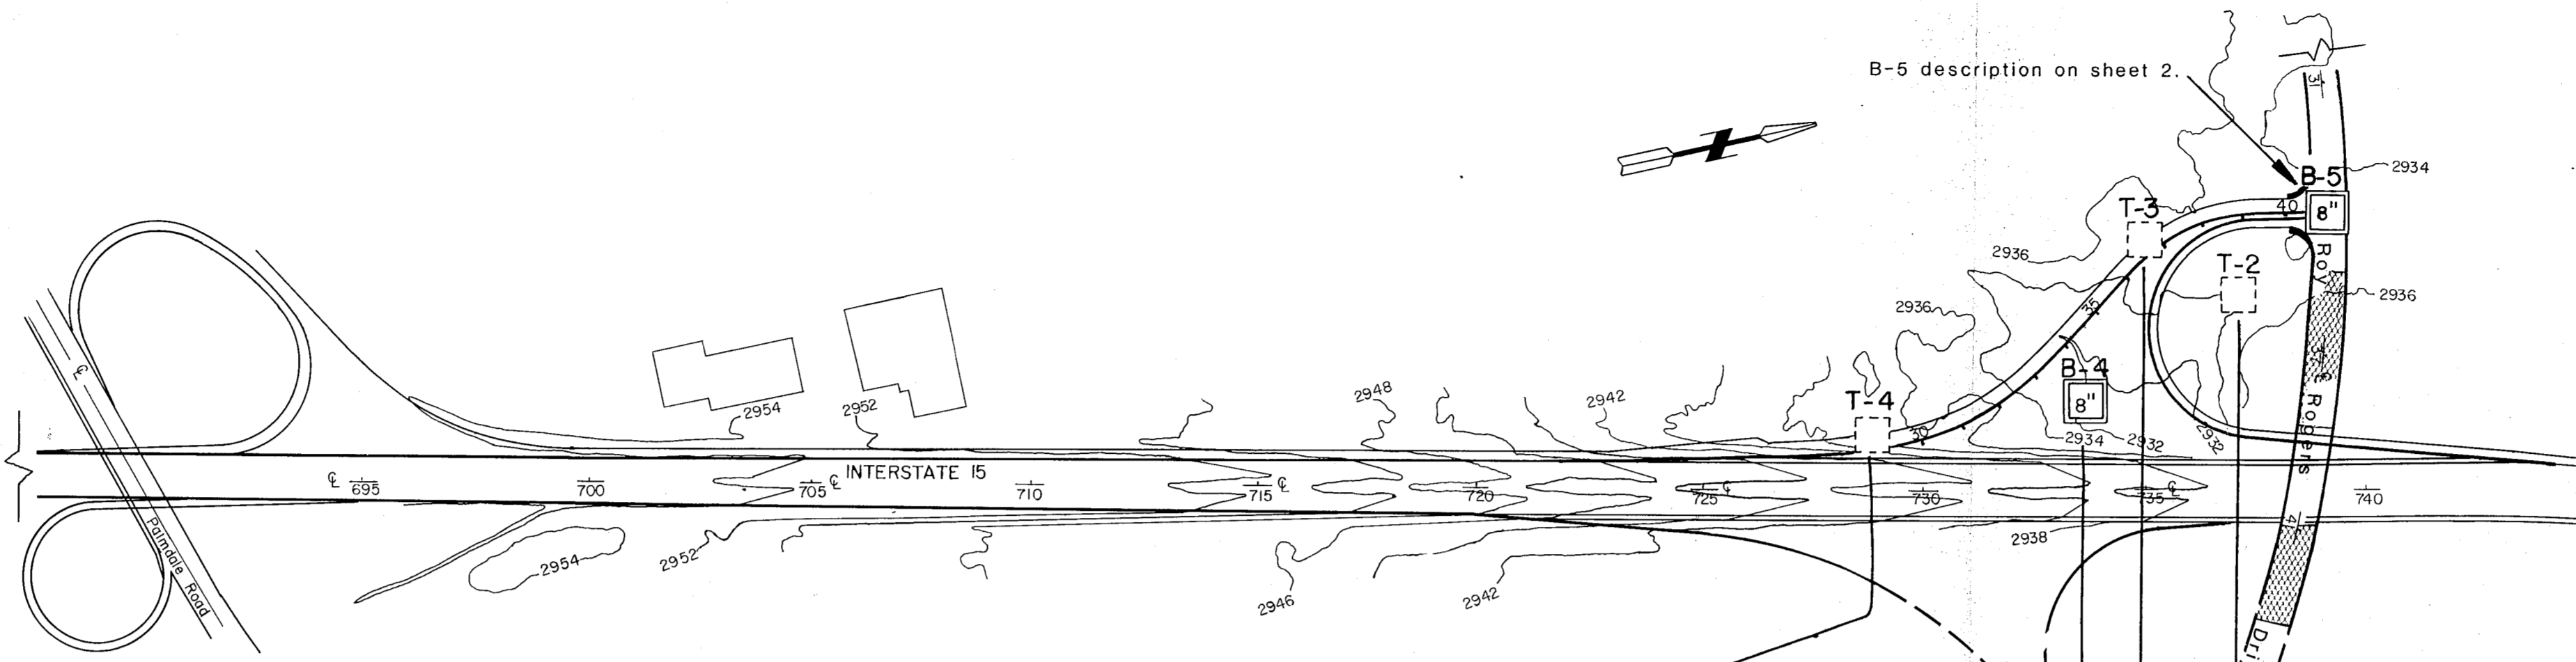- GEOTECHNICAL LEGEND**
-  Approximate location of exploratory trench.
 -  Approximate location of exploratory boring.
 -  Contour line with elevation in feet above mean sea level.
 -  Center line of street with station number indicated.
 -  Station number along south-bound Interstate 15 entrance from Hook Rd.
 -  Groundwater: No groundwater was encountered.
 -  Approximate location of deleterious material.



LEGEND OF BORING OPERATIONS

2 1/4" CONE PENETROMETER
 SAMPLE (GV), AUGER BORING (AV), AUGER BORING (AV), TEST PT, DIAMOND CORE BORING, ELECTRONIC CONE PENETROMETER

2 1/4" CONE PENETROMETER TEST
 Cone Penetrometer dimensions and testing procedures are in accordance with ASTM standard D 3441-79, or as noted.

ROTARY SAMPLE BORING (WET)

Description of material (Unit weight (lb/cu ft), % moisture, consolidation test (if noted), etc.)
 Unconfined compressive strength (100 ft)
 Confined material change (if noted)
 Estimated material change
 Unconfined material change

BORING (DRY)

Blows per foot (Using 28 lb hand hammer with 1.2" free fall)
 Pulled pipe
 Radial
 Sample taken

LEGEND OF EARTH MATERIALS

- GRAVEL
- SAND
- SILT
- CLAY
- SANDY CLAY or CLAYEY SAND
- SANDY SILT or SILTY SAND
- SILTY CLAY
- CLAYEY SILT
- REAL MESSY ORGANIC MATTER
- FILL MATERIAL
- GENUINE ROCK
- SEGMENTARY ROCK
- METAMORPHIC ROCK

CONSISTENCY CLASSIFICATION FOR SOILS

According to the Standard Penetration Test


Penetration Index (Blows Ft)	Consistency
0-4	Very loose
5-9	Loose
10-19	Slightly compact
20-29	Compact
30-39	Very compact
>40	Very hard

NOTE: Classification of earth material as shown on this sheet is based upon field inspection and is not to be construed to imply mechanical analysis.

- Legend For Test Samples**
- (R) R-Value
 - (C) Consolidation
 - (D) Maximum Density
 - (G) Gradation
 - (A) Atterberg Test
 - (S) Direct Shear
 - (pH) pH
 - (R_s) Resistivity
 - (Su) Soluble Sulfates
 - (SE) Sand Equivalent
 - (S) Bulk Sample

PROFILE


Horizontal: 1" = 300'
 Vertical: 1" = 10'

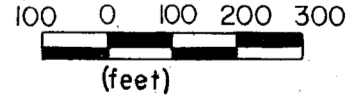

DESIGN OVERSIGHT	DRAWN BY MILES D. KENNEY 12/7/90	FIELD INVESTIGATOR GREG UECKER/FRED WINKLER	LEIGHTON & ASSOCIATES, INC.	BRIDGE NO. 54-1118	ROY ROGERS DRIVE OVERCROSSING	
SIGN OFF DATE	CHECKED BY STEVEN P. ALFORD 12/7/90	DATE 10/31/90 & 11/1/90	P.N. 12900307-03	POST MILE 40.52	LOG OF TEST BORINGS	
ORIGINAL SCALE IN INCHES FOR REDUCED PLANS				CU 08103 EA 251901	DISREGARD PRINTS BEARING EARLIER REVISION DATES	
				REVISION DATES (PRELIMINARY STAGE ONLY)		SHEET OF 4 5

DIST	COUNTY	ROUTE	POST MILES TOTAL PROJECT	SHEET NO.	TOTAL SHEETS
8	SBd	15	40.7 - 41.8	5	5

Steve P. Alford
 GEOTECHNICAL PROFESSIONAL
 12-7-90
 PLANS APPROVAL DATE

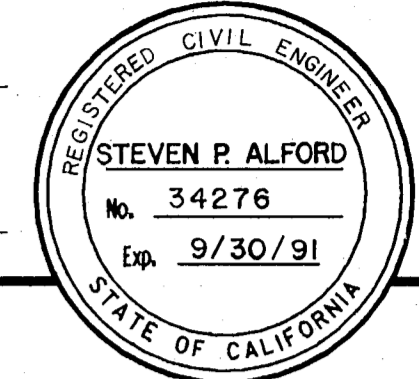

LEIGHTON AND ASSOCIATES, INC.

GEOTECHNICAL LEGEND

- T-9 [Symbol] Approximate location of exploratory trench.
- B-3 [Symbol] Approximate location of exploratory boring.
- 2930 [Symbol] Contour line with elevation in feet above mean sea level.
- 730 [Symbol] Center line of street with station number indicated.
- 30 [Symbol] Station number along north bound Interstate 15 exit for Hook Rd.
- G.W. [Symbol] Groundwater: No groundwater was encountered.
- [Symbol] Approximate location of deleterious material.

LEGEND OF BORING OPERATIONS

2 1/4" CONE PENETRATION BORING

ROTARY SAMPLE BORING (WET)

SAMPLE BORING (DRY)



LEGEND OF EARTH MATERIALS

CONSISTENCY CLASSIFICATION FOR SOILS

According to the Standard Penetration Test

Penetration (Blows / Ft)	Cohesive
0-5	Very soft
5-10	Soft
10-19	Slightly compact
20-34	Compact
35-59	Dense
>70	Very dense

NOTE: Classification of earth material as shown on this sheet is based upon field inspection and is not to be construed to imply mechanical analysis.

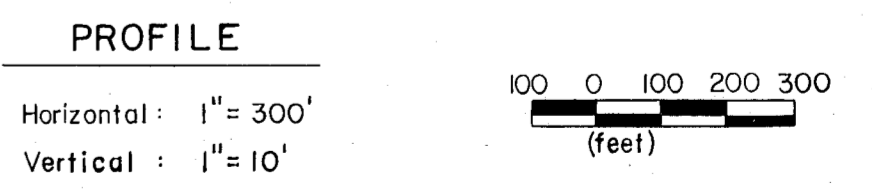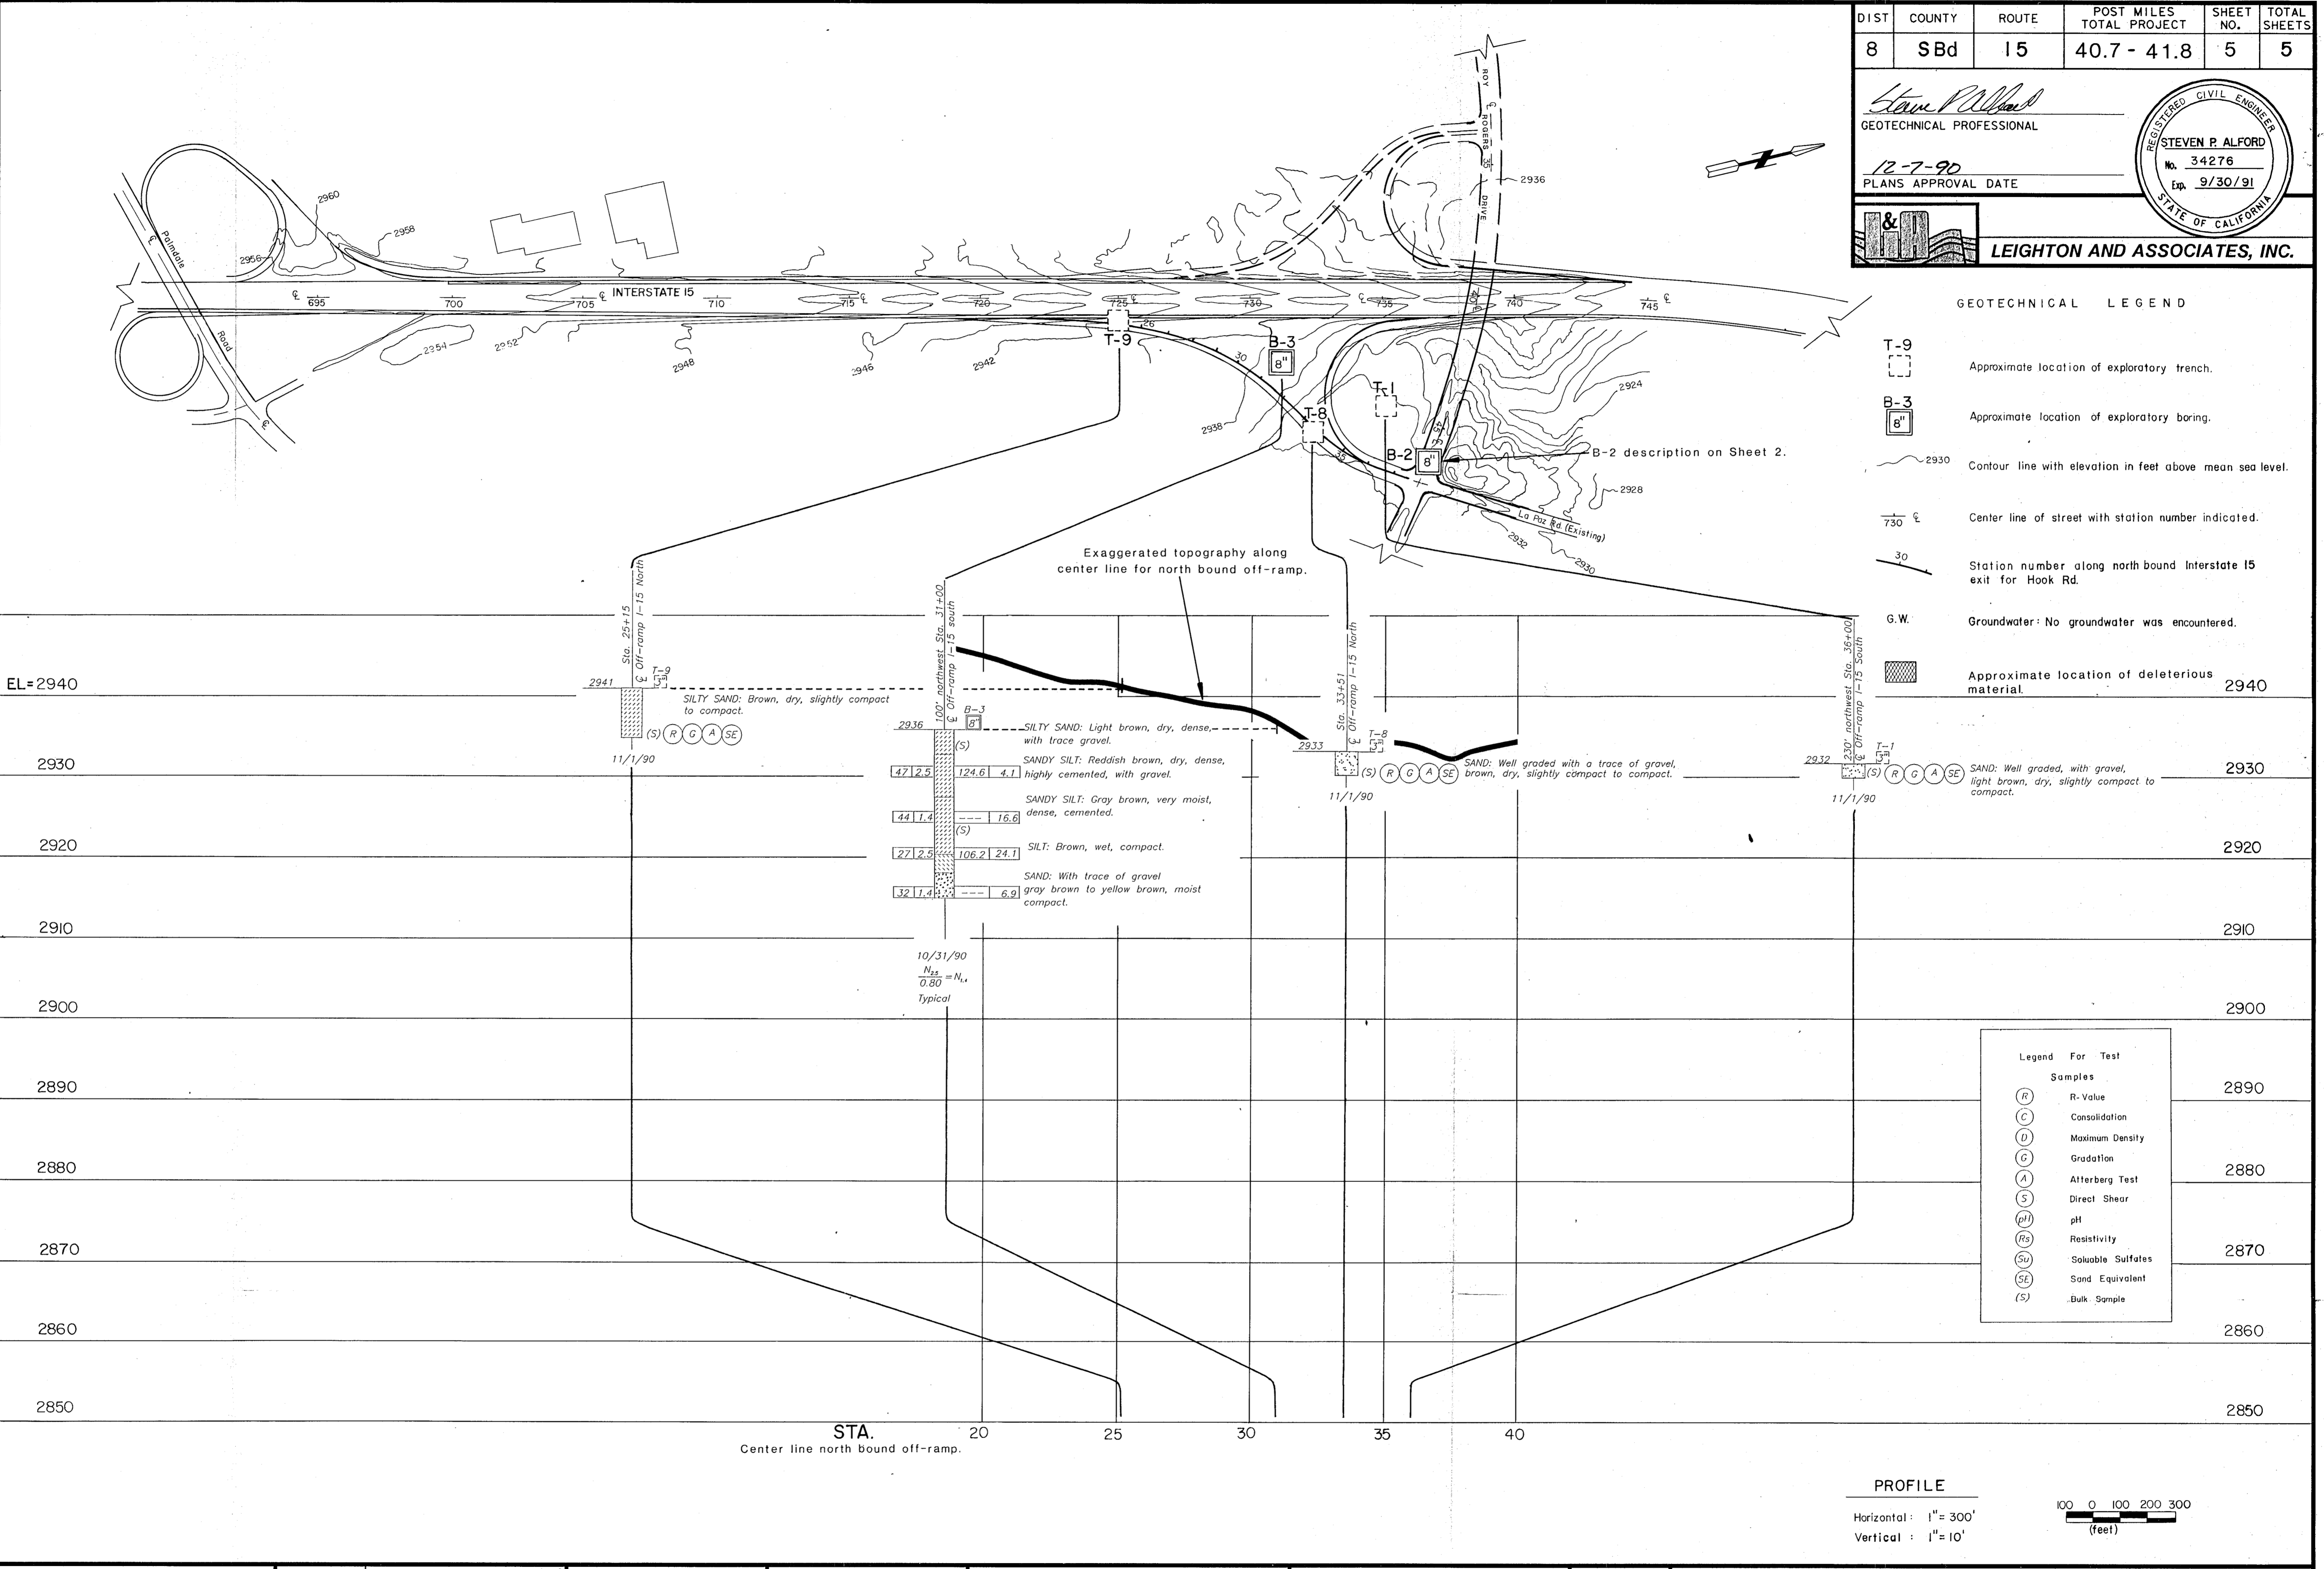



DESIGN OVERSIGHT	DRAWN BY MILES D. KENNEY 12/7/90	FIELD INVESTIGATOR GREG UECKER/FRED WINKLER	LEIGHTON & ASSOCIATES, INC.	BRIDGE NO. 54-1118	ROY ROGERS DRIVE OVERCROSSING LOG OF TEST BORINGS
SIGN OFF DATE	CHECKED BY STEVEN P. ALFORD 12/7/90	DATE 10/31/90 & 11/1/90	P.N. 12900307-03	POST MILE 40.52	
ORIGINAL SCALE IN INCHES FOR REDUCED PLANS				CU 08103 EA 251901	DISREGARD PRINTS BEARING EARLIER REVISION DATES
REVISION DATES (PRELIMINARY STAGE ONLY)					SHEET 5 OF 5

DIST	COUNTY	ROUTE	POST MILES TOTAL PROJECT	SHEET NO.	TOTAL SHEETS
8	SBd	15	40.7 41.8	1	6

Steven P. Alford
 GEOTECHNICAL PROFESSIONAL
 5/5/92
 PLANS APPROVAL DATE
 LEIGHTON AND ASSOCIATES, INC.
 REGISTERED CIVIL ENGINEER
 STEVEN P. ALFORD
 No. 34276
 Exp. 9/30/95
 STATE OF CALIFORNIA

CONSISTENCY CLASSIFICATION FOR SOILS	
According to the Standard Penetration Test	
Penetration (Blows / Ft)	Cohesive
0-4	Very soft
5-10	Soft
10-19	Slightly compact
20-34	Compact
35-69	Very dense
70	Very hard
Granular	
Very loose	
Loose	
Slightly compact	
Compact	
Dense	
Very dense	

LEGEND OF EARTH MATERIALS	
GRAVEL	CLAYEY SILT
SAND	PEAT and/or ORGANIC MATTER
SILT	FILL MATERIAL
CLAY	IGNEOUS ROCK
SANDY CLAY or CLAYEY SAND	SEDIMENTARY ROCK
SILTY SAND	AMPHIBOLIC ROCK
SILTY CLAY	CRYSTALLINE ROCK

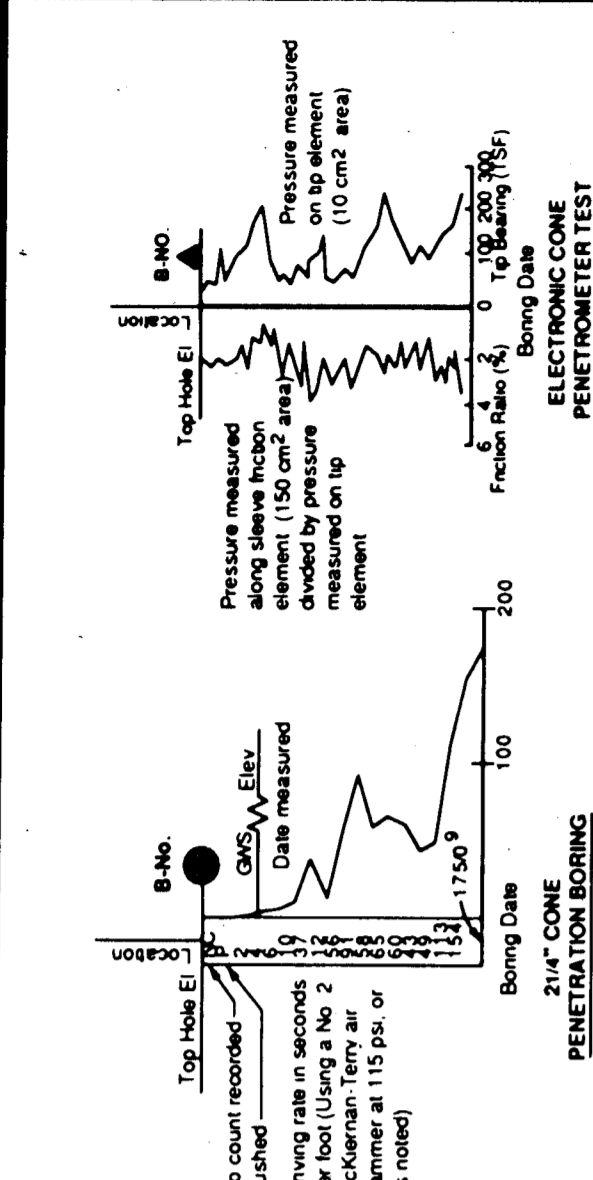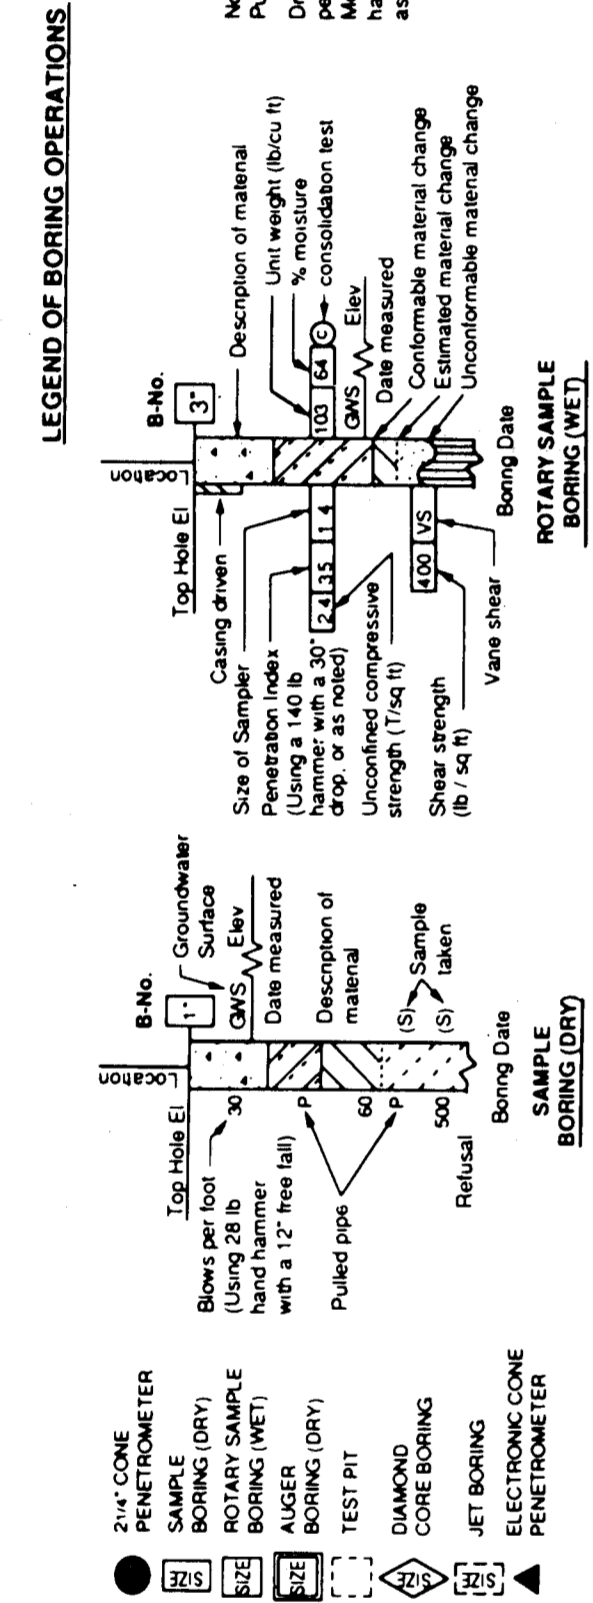

NOTE: Classification of earth material as shown on this sheet is based upon field inspection and is not to be construed to imply mechanical analysis.



BENCH LEVEL SUMMARY:
 DATUM: SEA LEVEL DATUM OF 1929 & SUPPLEMENTAL ADJUSTMENT OF 1980

BENCH MARK	ELEVATION	DESCRIPTION
72-A-89	2951.23	Std "CAL DOT" brass disk in 2" IP stamped "38-12-A-89" diam 0.2 in AC encl., 65.3" r/c/L IHD 714-CO NAD 1929 adj 1980
75-A-89	2934.51	Chis "..." on NW bolt PCC sign structure "22-Jove Dr. Next Right" 87.5" r/c/L IHP 743-00. 301" stamped "BM 75-A-89" NAD 1929 adj 1980

HORIZONTAL CONTROL:
 Standard Disk stamped
 "C/L IHD C1-53 714-CO 72 POT"
 N = 64342.82 m E = 40751.27

Standard Disk stamped
 "C/L IHD C1-53 741-51.19 30"
 N = 61955.12 m E = 40250.92

DESIGN OVERSIGHT	DRAWN BY MILES D. KENNEY 12/7/90	GREG UECKER/FRED WINKLER FIELD INVESTIGATOR	LEIGHTON & ASSOCIATES, INC. P.N. 12900307-03	PREPARED FOR THE STATE OF CALIFORNIA DEPARTMENT OF TRANSPORTATION	PROJECT ENGINEER
SIGN OFF DATE	CHECKED BY STEVEN P. ALFORD 12/7/90	DATE 10/31/90 & 11/1/90			

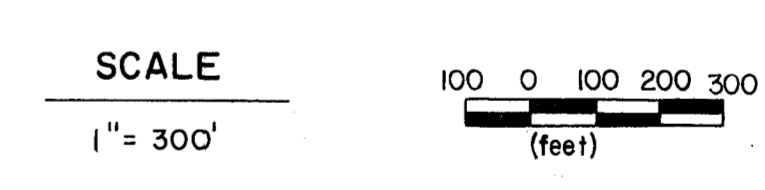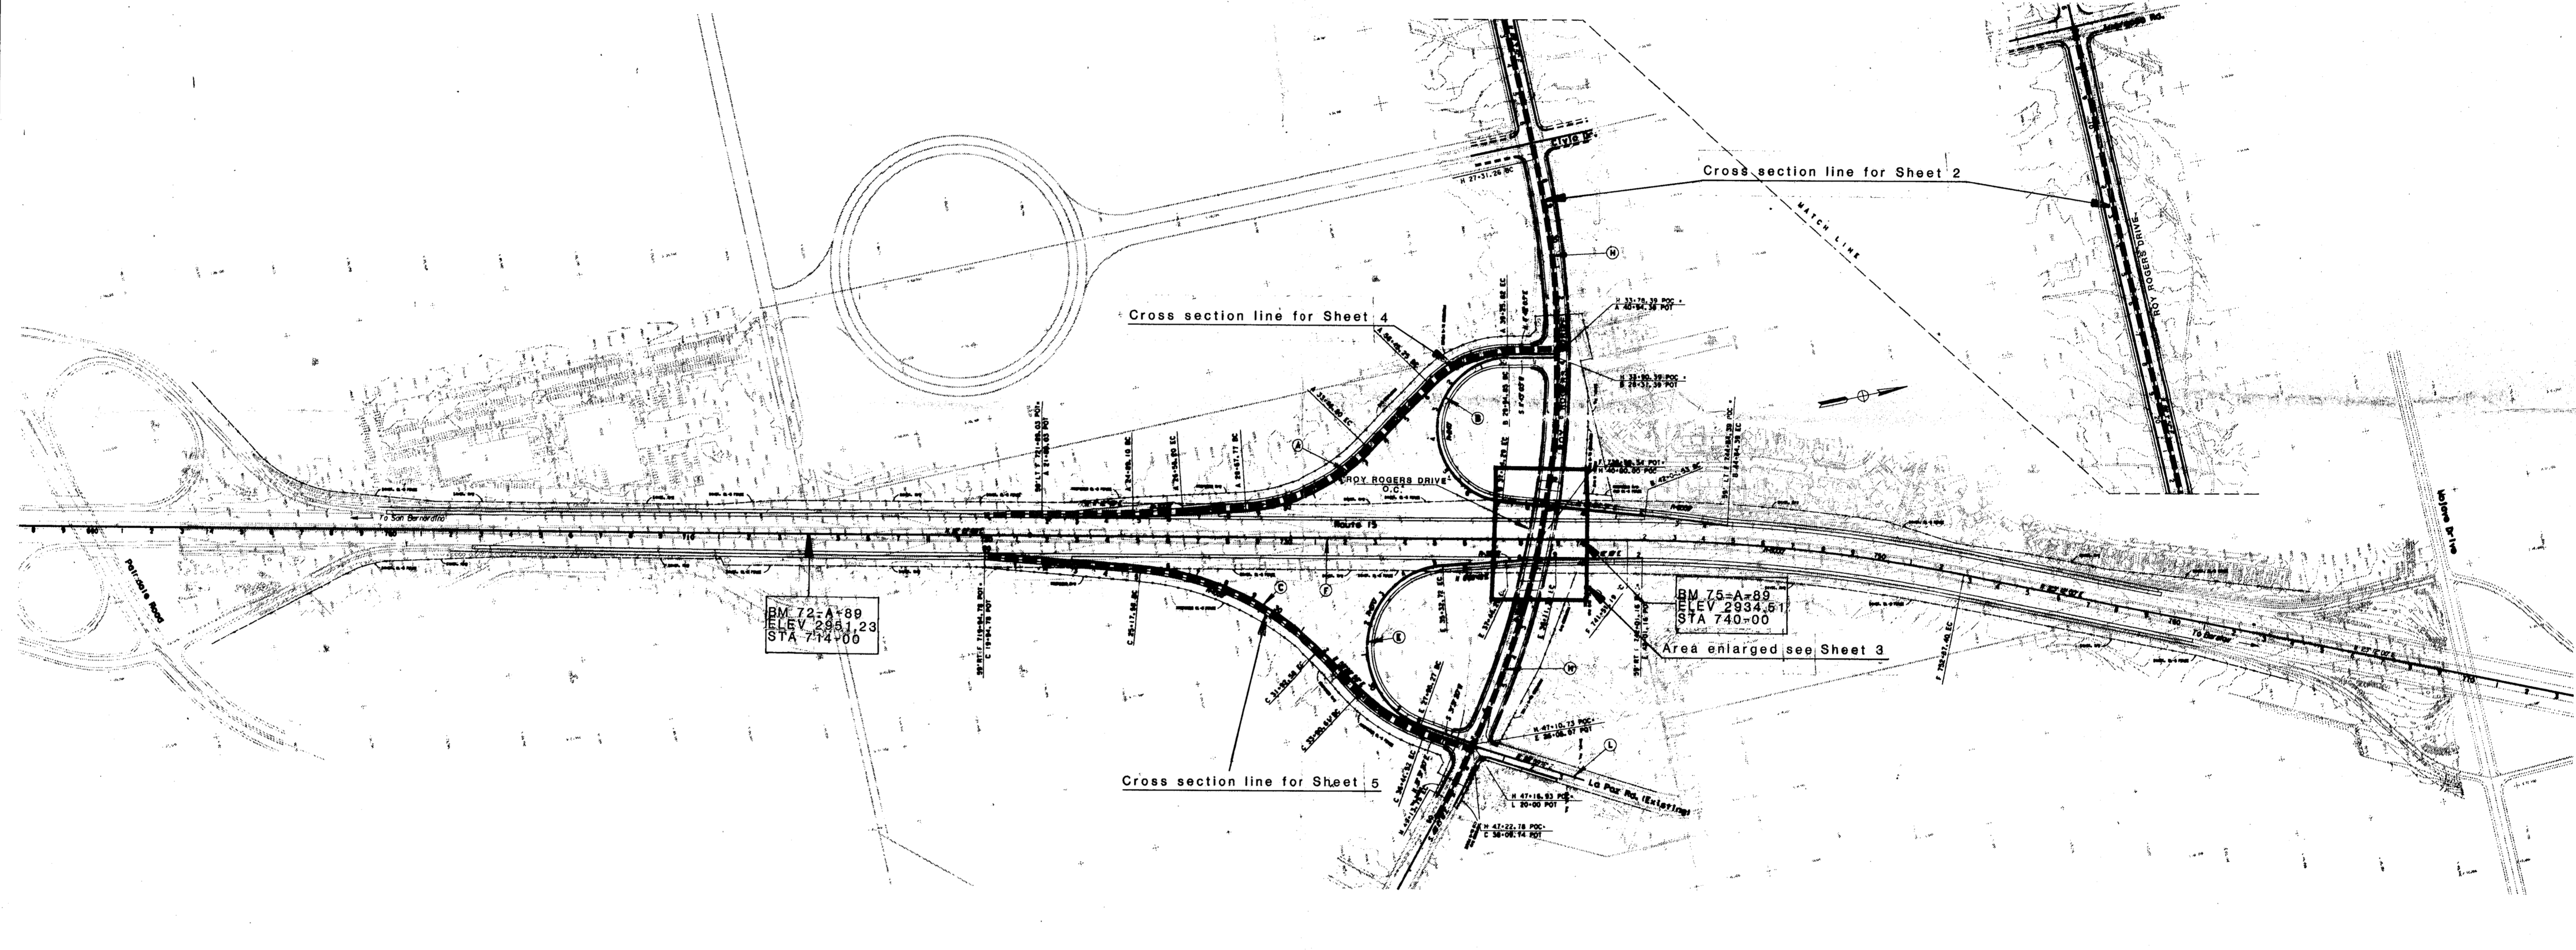


BRIDGE NO. 54-1118	ROY ROGERS DRIVE OVERCROSSING
POST MILE 40.52	LOG OF TEST BORINGS
CU 08108 EA 251904	REVISION DATES (PRELIMINARY STAGE ONLY)
	SHEET 1 OF 6

ORIGINAL SCALE IN INCHES FOR REDUCED PLANS: 0 1 2 3

DIST	COUNTY	ROUTE	POST MILES TOTAL PROJECT	SHEET NO.	TOTAL SHEETS
8	SBd	15	40.7 - 41.8	1	6

Stephen M. Poole
 GEOLOGICAL PROFESSIONAL
 5/6/92
 PLANS APPROVAL DATE

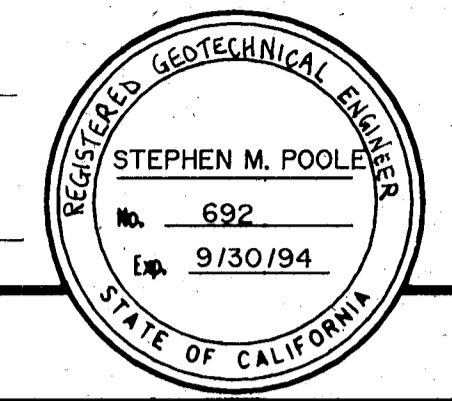

LEIGHTON AND ASSOCIATES, INC.

LEGEND OF BORING OPERATIONS

2 1/4" CONE PENETRATION BORING
 No record recorded. Pumping. Driving rate in seconds per foot (Using a No. 2 Mcrometer 115 psi or as noted).
 Top Hole El. Boring Date

ROTARY SAMPLE BORING (WET)
 Description of material. Unit weight (lb/cu ft). Consolidation test. Date measured. Estimated material change. Unrecoverable material change.
 Size of Sampler. Penetration hammer with 2.50' diameter. Unconfined compression strength (T/cu ft). Shear strength (lb/1/4 ft).
 Top Hole El. Casing drawn. Boring Date

SAMPLE BORING (DRY)
 Bore per foot. (Using 2 1/2" or with a 1 1/2" free fall). Pulled pipe. Retriever.
 Top Hole El. Date measured. Boring Date

CONE BORING
 CONE BORING. ELECTRONIC CONE PENETROMETER.

LEGEND OF EARTH MATERIALS


GRAVEL, SAND, SILT, CLAY, SANDY CLAY or SANDY SILT, SANDY SILT or SILTY SAND, SILTY SAND, SILTY CLAY, CLAYEY SILT, PEAT and/or ORGANIC MATTER, FILL MATERIAL, IGNEOUS ROCK, SEDIMENTARY ROCK, METAMORPHIC ROCK, AGGREGATE BASE.

CONSISTENCY CLASSIFICATION FOR SOILS

According to the Standard Penetration Test

Penetration (Blows/Ft)	Cohesive	
	Granular	
0-4	Very soft	Very soft
5-9	Loose	Soft
10-19	Slightly compact	Stiff
20-34	Compact	Very stiff
35-59	Dense	Hard
>70	Very dense	Very hard

NOTE: Classification of earth material as shown on this sheet is based upon field inspection and is not to be construed to imply mechanical analysis.


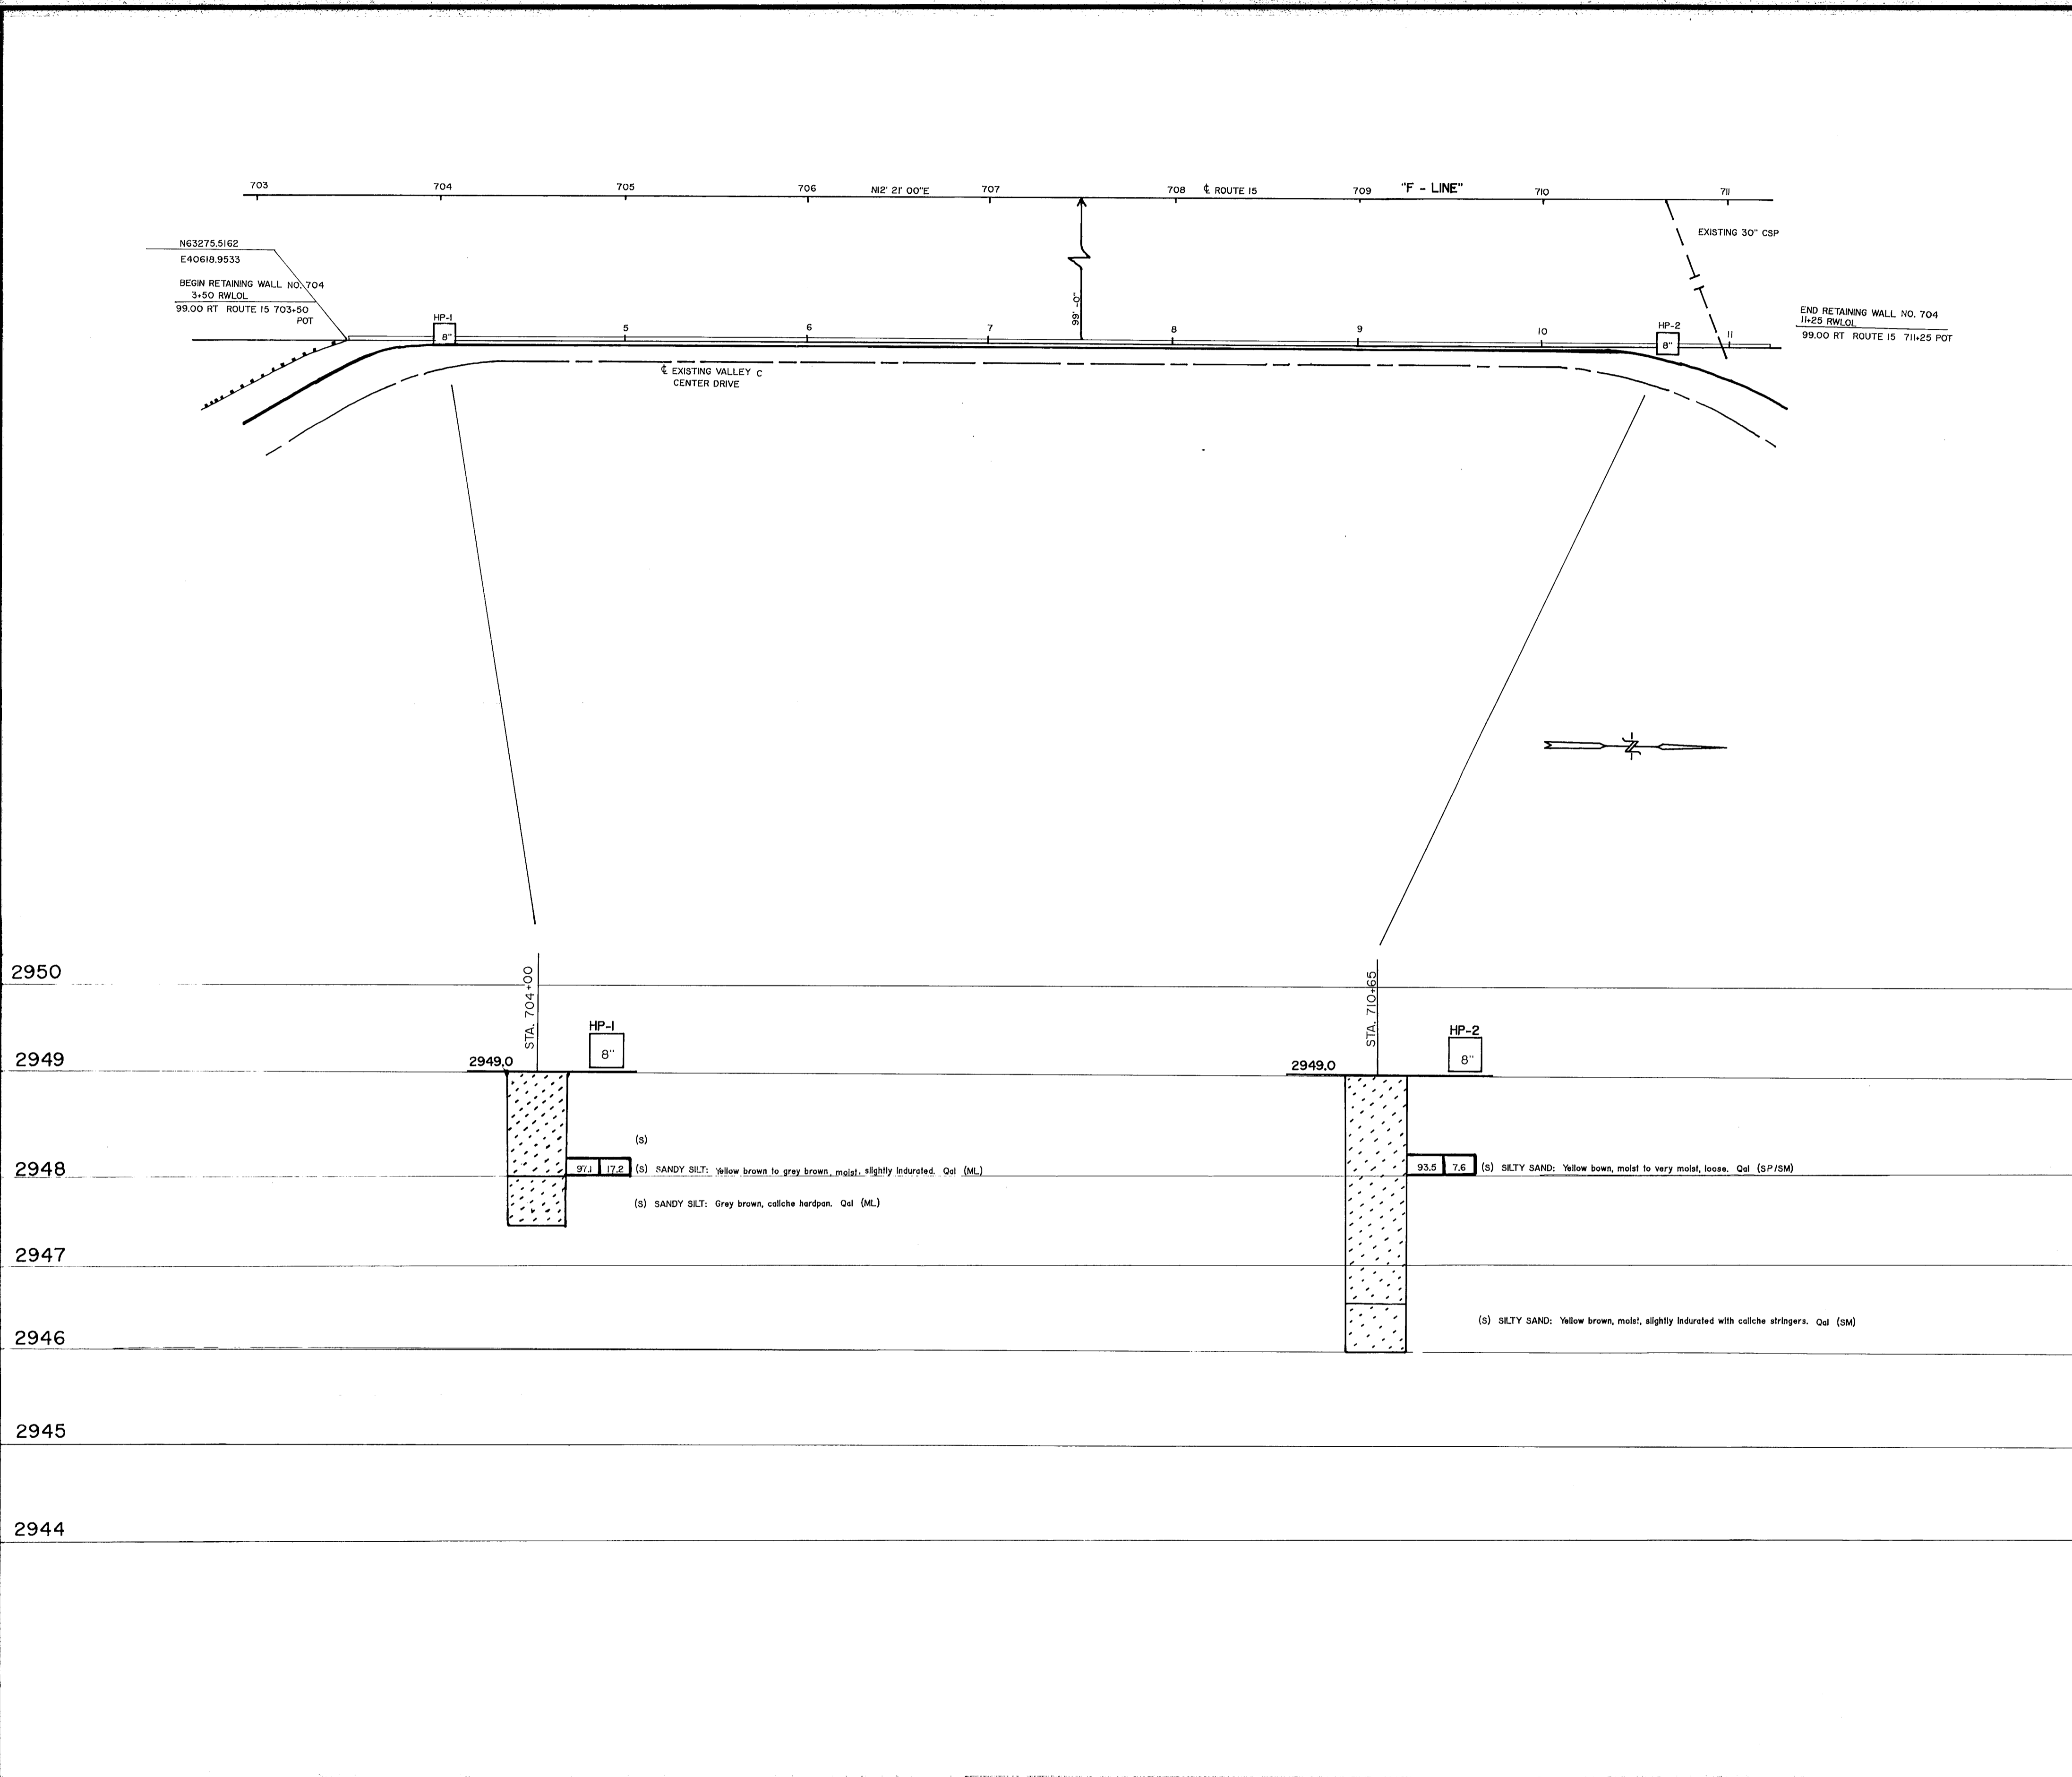


DESIGN OVERSIGHT	DRAWN BY WENDY WEESSIES 02/13/92	GREG UECKER/FRED WINKLER FIELD INVESTIGATOR	LEIGHTON & ASSOCIATES, INC. 12900307-04	PREPARED FOR THE STATE OF CALIFORNIA DEPARTMENT OF TRANSPORTATION	PROJECT ENGINEER	BRIDGE NO. 54-1118	RETAINING WALL NO. 704
SIGN OFF DATE	CHECKED BY SMP 02/14/92	DATE 11/15/91				POST MILE	LOG OF TEST BORINGS
						DISREGARD PRINTS BEARING EARLIER REVISION DATES	REVISION DATES (PRELIMINARY STAGE ONLY) SHEET OF






CU EA 251904	DISREGARD PRINTS BEARING EARLIER REVISION DATES	REVISION DATES (PRELIMINARY STAGE ONLY)	SHEET OF
-----------------	---	---	----------

DIST	COUNTY	ROUTE	POST MILES TOTAL PROJECT	SHEET NO.	TOTAL SHEETS
8	SBd	15	40.7 - 41.8	6	6

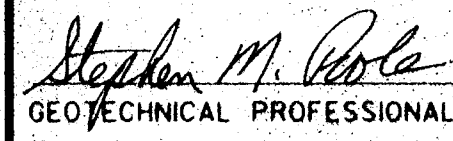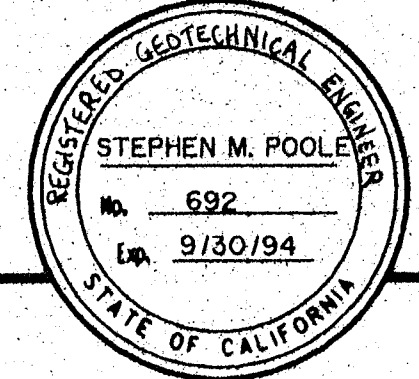
 GEO. TECH. PROFESSIONAL
 5/5/92
 PLANS APPROVAL DATE


LEIGHTON AND ASSOCIATES, INC.

GEOTECHNICAL LEGEND

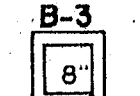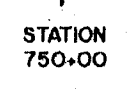-  Approximate location of exploratory boring
-  Center line of street with station number indicated
-  Denotes 2.5" California Sampler Equivalent SPT blow counts could be estimated by multiplying by 0.445

PROFILE

Horizontal $I' = 10'$
 Vertical $I' = 5'$

DATUM:
SEA LEVEL DATUM OF 1929%
SUPPLEMENTAL ADJUSTMENT OF 1980

BENCHMARK	ELEVATION	DESCRIPTION
72-A-89	2951.23	Std "CAL DOT" brass disk in 2" IP stamped "BM.72-A-89" down 0.2 in AC shldr. 65.3' rt C/L Imp 714+00 NAD 1929 adj 1980
75-A-89	2934.51	Chis "+" on NW bolt PCC sign structure "Mojave Dr. Next Right" 87.5' rt C/L Imp 740+00. Bolt stamped "BM.75-A-89" NAD 1929 adj 1980

HORIZONTAL CONTROL:
Standard Disk Stamped
C/L Imp C1-53 714+20.72 POT
N= 64342.62 E= 40751.27

Standard Disk Stamped
C/L Imp C1-59 741+51.19 30'
N= 61966.12 E= 40230.92

LEGEND OF BORING OPERATIONS


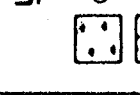



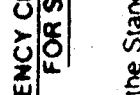

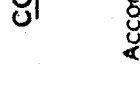

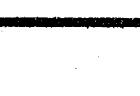
2 1/4" CONE PENETRATION BORING
 No. of blows recorded
 Date measured
 Driving rate in seconds per foot (Using a No. 2 Jacksonian Term or equivalent term as noted)
 Penetration (ft)
 Boring Date


ROTARY BORING (WET)
 Description of material
 Penetration (ft)
 Date measured
 Unconfined compressive strength (lb/ft²)
 Shear strength (lb/ft²)
 Boring Date

SAMPLE BORING (DRY)
 Blow per foot (Using 28 lb hammer with a 1 1/2" pipe)
 Date measured
 Description of material
 Sample No.
 Boring Date

ELECTRONIC CONE PENETROMETER
 Top Node Elevation
 Boring Date





LEGEND OF EARTH MATERIALS

	GRAVEL
	SAND
	SILT
	CLAY
	ORGANIC MATERIAL
	FILL MATERIAL
	IGNEOUS ROCK
	SEDIMENTARY ROCK
	METAMORPHIC ROCK
	AGGREGATE BASE

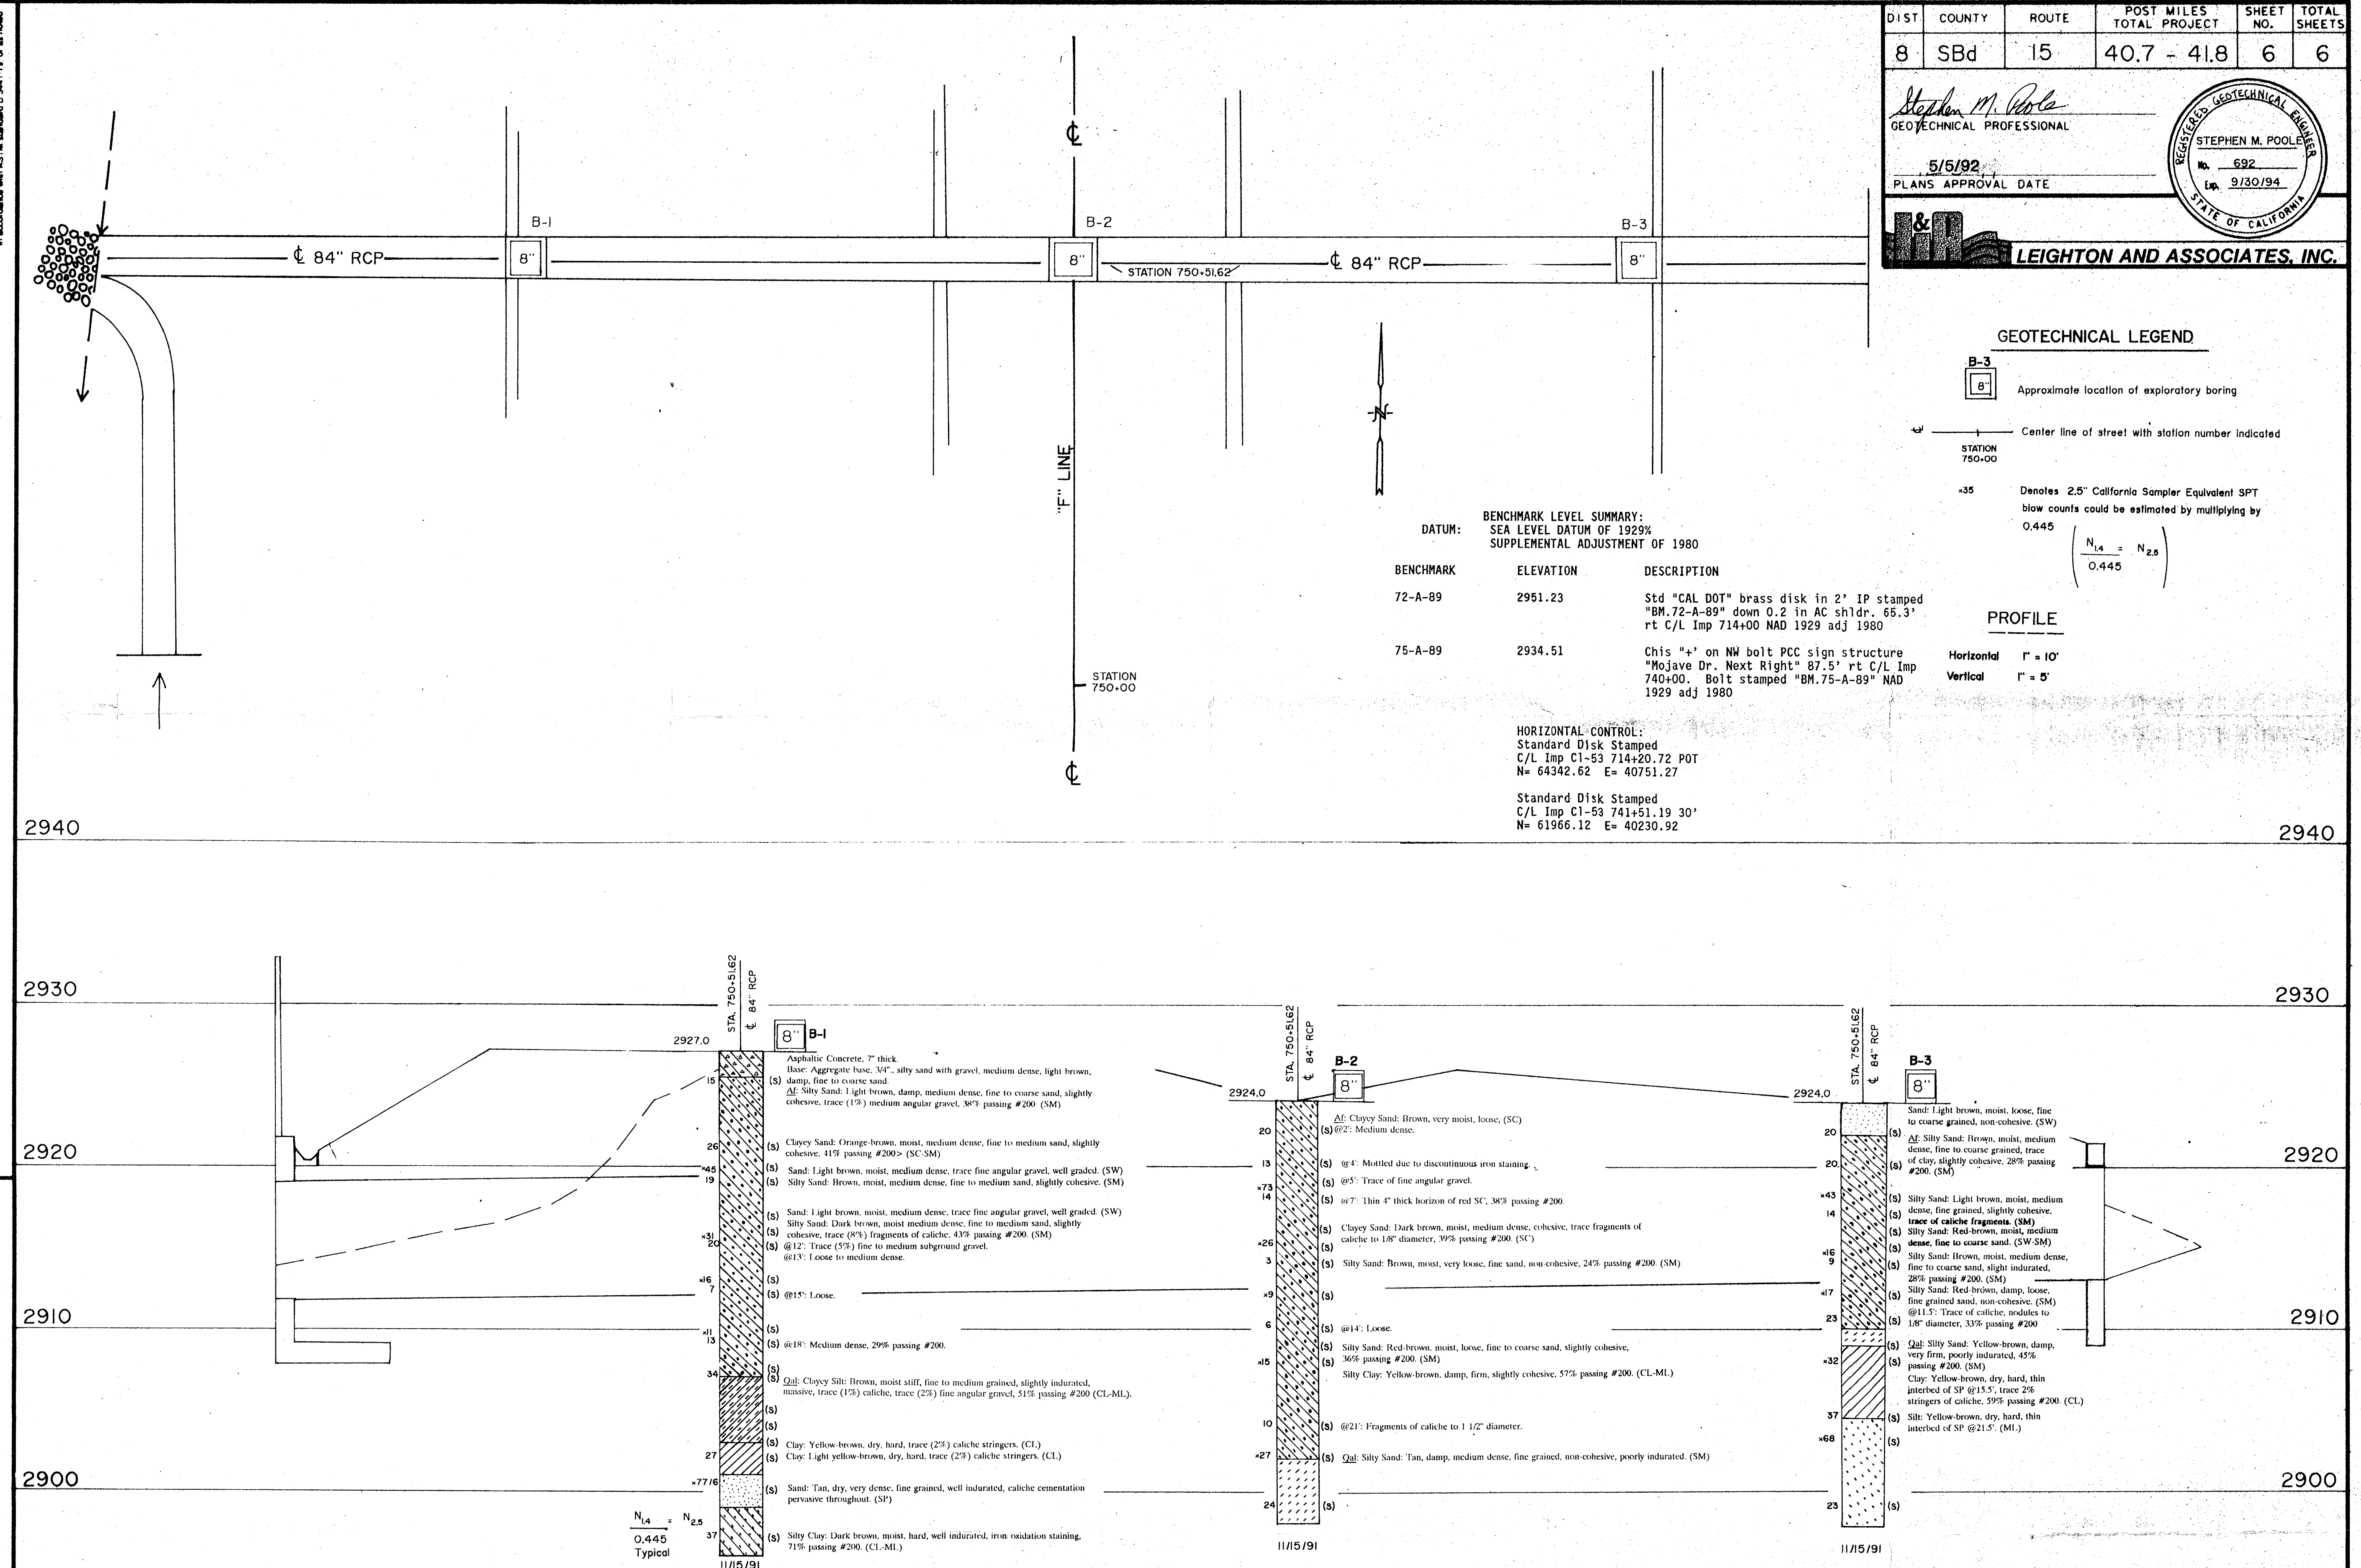

DESIGN OVERSIGHT	DRAWN BY	WENDY S. WEESSIES 12/5/91	GREG UECKER/FRED WINKLER FIELD INVESTIGATOR	LEIGHTON & ASSOCIATES, INC.	PREPARED FOR THE STATE OF CALIFORNIA DEPARTMENT OF TRANSPORTATION	BRIDGE NO.	54-1118	84" RCP			
	SIGN OFF DATE	CHECKED BY				STEPHEN M. POOLE 12/5/91	DATE		11/5/91	PROJECT ENGINEER	
ORIGINAL SCALE IN INCHES FOR REDUCED PLANS						CU 08103 EA 251904	DISREGARD PRINTS BEARING EARLIER REVISION DATES		REVISION DATES (PRELIMINARY STAGE ONLY)		SHEET OF


Mojave Drive WB

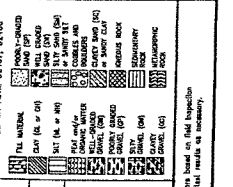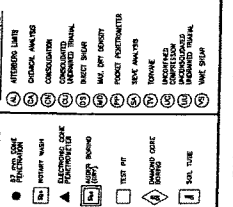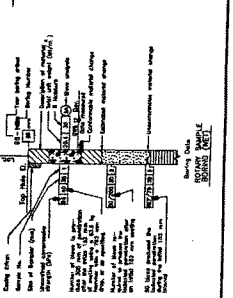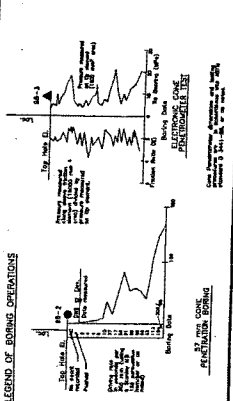


CONSISTENCY CLASSIFICATION FOR SOILS

Soil Type	Liquid Limit (LL)	Plasticity Index (PI)	Consistency
CL	25-50	4-7	Stiff Clay
ML	15-25	4-7	Stiff Silty Clay
CH	>50	>7	Very Stiff Clay
MH	25-50	>7	Very Stiff Silty Clay
CL-ML	25-50	4-7	Stiff Clayey Silty Clay
ML-CL	25-50	4-7	Stiff Silty Clayey Clay
CH-MH	>50	>7	Very Stiff Clayey Silty Clay
MH-CH	>50	>7	Very Stiff Silty Clayey Clay

- Note:**
- The boring logs and related information represent the opinion of the geotechnical engineer as to the character of the materials at the locations shown. Soil conditions between adjacent test holes and at other locations may differ from those shown. Borings will be advanced using a truck-mounted drill rig, utilizing 200mm diameter hollow-stem augers.
 - Samples were taken using a Modified California split-barrel sampler with an inside diameter (I.D.) of 50 mm and an outside diameter (O.D.) of 75 mm, a standard penetration split-barrel sampler with an (I.D.) of 35 mm and an O.D. of 50 mm. Samplers will be driven using a 63.4 kg hammer falling 750 mm.
 - Test boring elevations and locations are based on a borehole survey performed by Associated Engineers Inc.
 - Visual classification of earth materials was based on field inspection and was confirmed or revised with laboratory test results.
 - Benchmark:
ELEVATION = 881.041m N 615445.090 E 2063195.844
Caltrans Point No. 15-1-94, Centerline Imp. I-15
STA/OUT 38+83.616/75.914 m

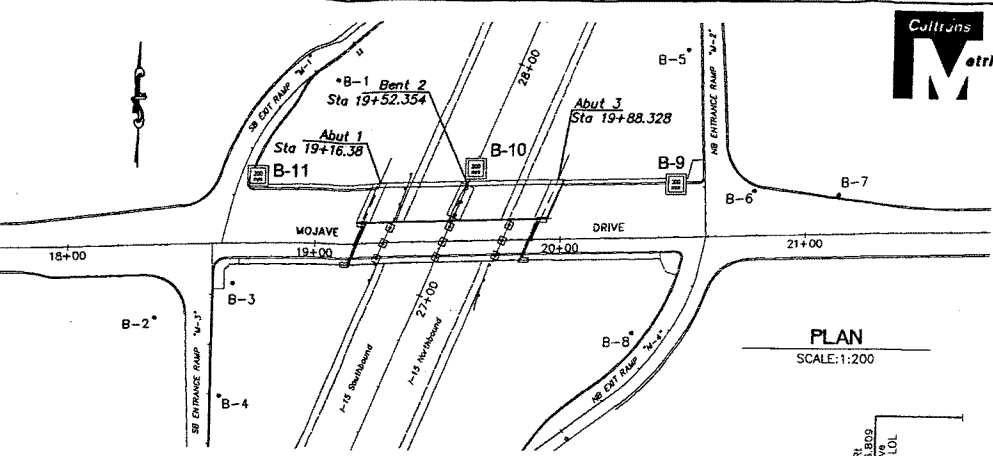

PLAN
SCALE: 1:200

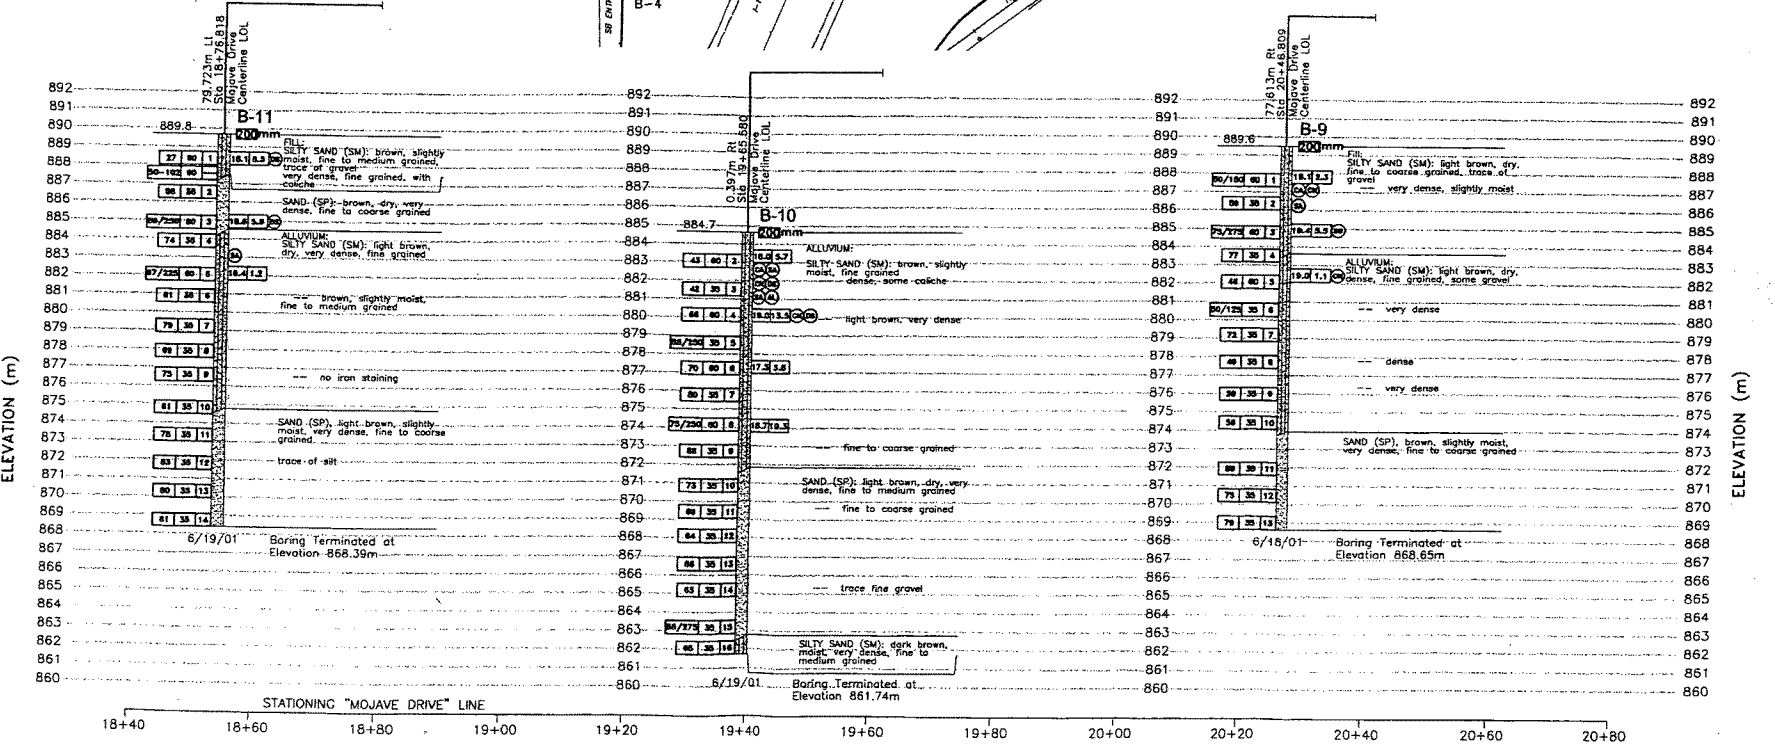

PROFILE
HORIZONTAL SCALE: 1:100
VERTICAL SCALE: 1:600

Caltrans
Metric

DIST	COUNTY	ROUTE	KILOMETERS TOTAL PROJECT	SHEET NO.	TOTAL SHEETS
08	Sbd	15	67.1/68.2		

REGISTERED GEOTECHNICAL ENGINEER
ALEXANDER S. EVANS
Exp. 3/29/03
STATE OF CALIFORNIA

PLANS APPROVAL DATE: _____
The State of California or its officers or agents shall not be responsible for the accuracy or completeness of electronic copies of this plan sheet.


KLEINFELDER INC.
1840 ORANGE TREE LANE
REDLANDS, CA 92374

PLATE 3A
MOJAVE DRIVE WIDENING AT I-15
LOG OF TEST BORINGS (1 OF 1)


DESIGN OVERSIGHT	DRAWN BY: D. FAHREY	FIELD INVESTIGATION BY: SCOTT LAWSON, STAFF ENGINEER	PREPARED FOR THE STATE OF CALIFORNIA DEPARTMENT OF TRANSPORTATION	PROJECT ENGINEER	BRIDGE NO. 54-1214K	MOJAVE DRIVE WIDENING AT I-15	
SIGN OFF DATE	CHECKED BY: M. SIERADZKI				KILOMETER POST: 19.4	LOG OF TEST BORINGS (1 OF 1)	
ORIGINAL SCALE IN MILLIMETERS FOR REDUCED PLANS			CU 221 EA 354500		DESIGNER PRINTS LEAVING UNLESS OTHERWISE NOTED		REVISION DATES (PRELIMINARY STAGE ONLY)

DIST.	COUNTY	ROUTE	SECTION	SHEET NO.	TOTAL SHEETS
VIII	SBd	31	C	13	13

W. Beeson
 CIVIL ENGINEER
 DATE APPROVED: July 25, 1961

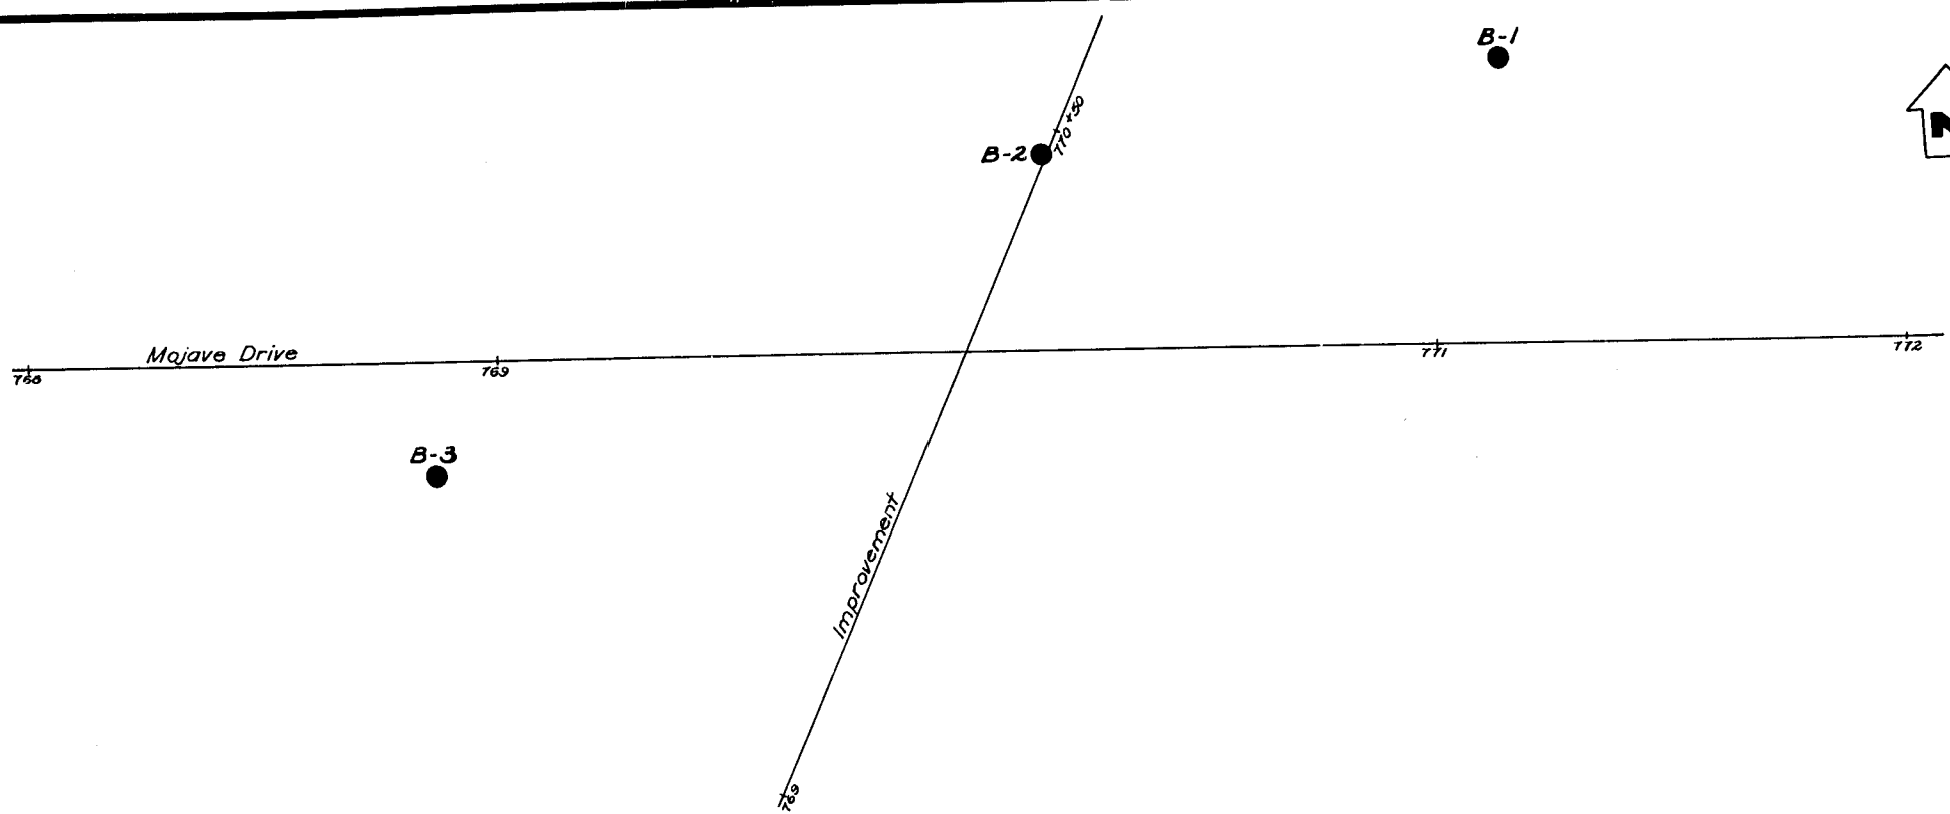

B.M. 77-A-53 Elev. 2914.26
 2"x2" Hub & Nail buried 1.2' 226'
 Lt. Sta. 766 +94 & Improvement.

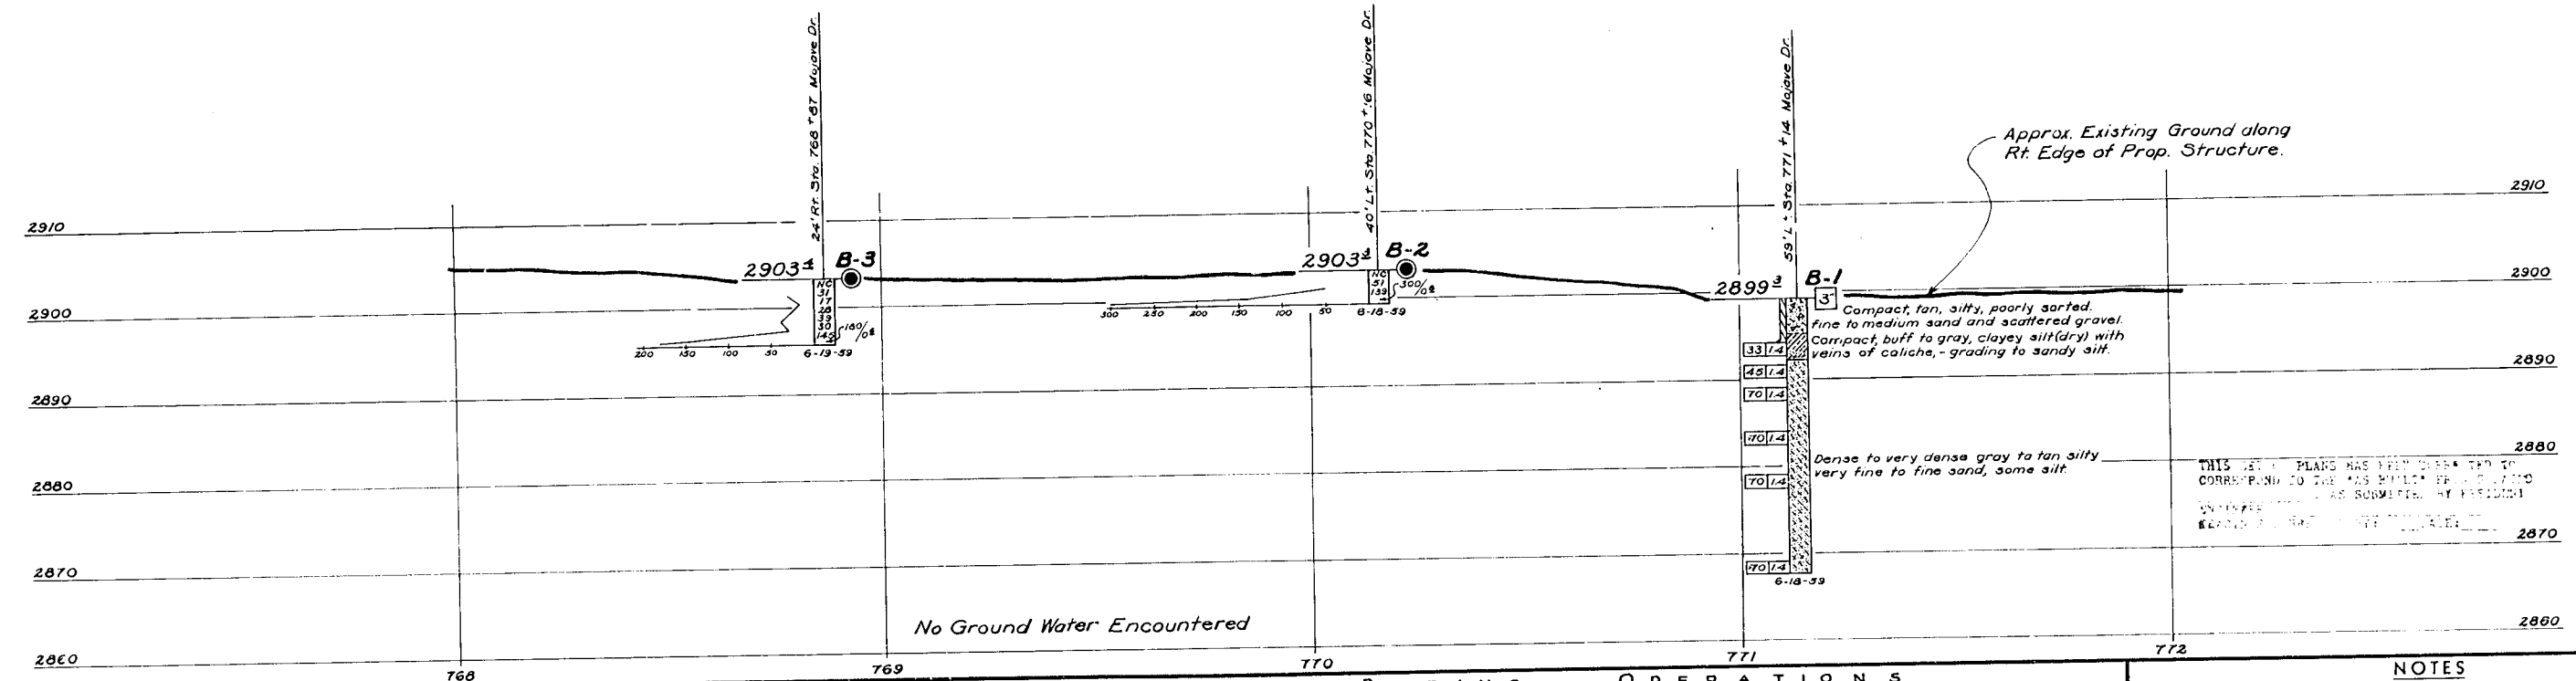


Approx. Existing Ground along
 Rt. Edge of Prop. Structure.

No Ground Water Encountered

THIS SET OF PLANS HAS BEEN CHECKED TO
 CORRESPOND TO THE TEST BORING LOGS AND
 FOUND TO BE CORRECT AS SUBMITTED BY THE
 CONTRACTOR.

FIELD STUDY - Remains/Comp 6-19-60
 DRAWN - [Signature] 5-29-60
 CHECKED - [Signature] 5-29-60
 APPROVED - [Signature] 5-29-60

BRIDGE DEPARTMENT

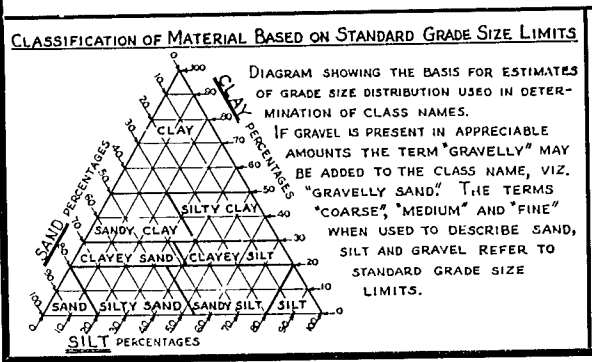

LEGEND OF EARTH MATERIALS

GRAVEL	SILTY CLAY OR CLAYEY SILT
SAND	PEAT AND/OR ORGANIC MATTER
SILT	FILL MATERIAL
CLAY	IGNEOUS ROCK
SANDY CLAY OR CLAYEY SAND	SEDIMENTARY ROCK
SANDY SILT OR SILTY SAND	METAMORPHIC ROCK

LEGEND OF BORING OPERATIONS

- PLAN OF ANY BORING
- ⊙ PENETROMETER
- ⊙ 2 1/2" CONE PENETROMETER
- ⊞ SAMPLER BORING (DRY)
- ⊞ ROTARY BORING (WET)
- ⊞ AUGER BORING (DRY)
- ⊞ JET BORING
- ⊞ CORE BORING
- ⊞ TEST PIT

1" SOIL TUBE

ROTARY BORING

PENETRATION BORING

NOTES

The contractor's attention is directed to Section 2, Article (c) of the Standard Specifications and to the Special Provisions accompanying this set of plans. Classification of earth material as shown on this sheet is based upon field inspection and is not to be construed to imply mechanical analysis.

STATE OF CALIFORNIA
 DEPARTMENT OF PUBLIC WORKS
 DIVISION OF HIGHWAYS

MOJAVE DRIVE O.C.

LOG OF TEST BORINGS

Hor. 1" = 20'
 SCALE Ver. 1" = 10'

BRIDGE 54-626 FILE DRAWING




Victorville Separation OH

FED. ROAD DIV. NO.	STATE	PROJ. NO.	FISCAL YEAR	SHEET NO.	TOTAL SHEETS
7	CAL.				

DIST.	COUNTY	ROUTE	SECTION	POST MILE NO.	TOTAL MILES
Will	SBd	31	D		


BRIDGE ENGINEER CIVIL AND STRUCTURAL ENGINEER - LICENSE 5563

DATE APPROVED:

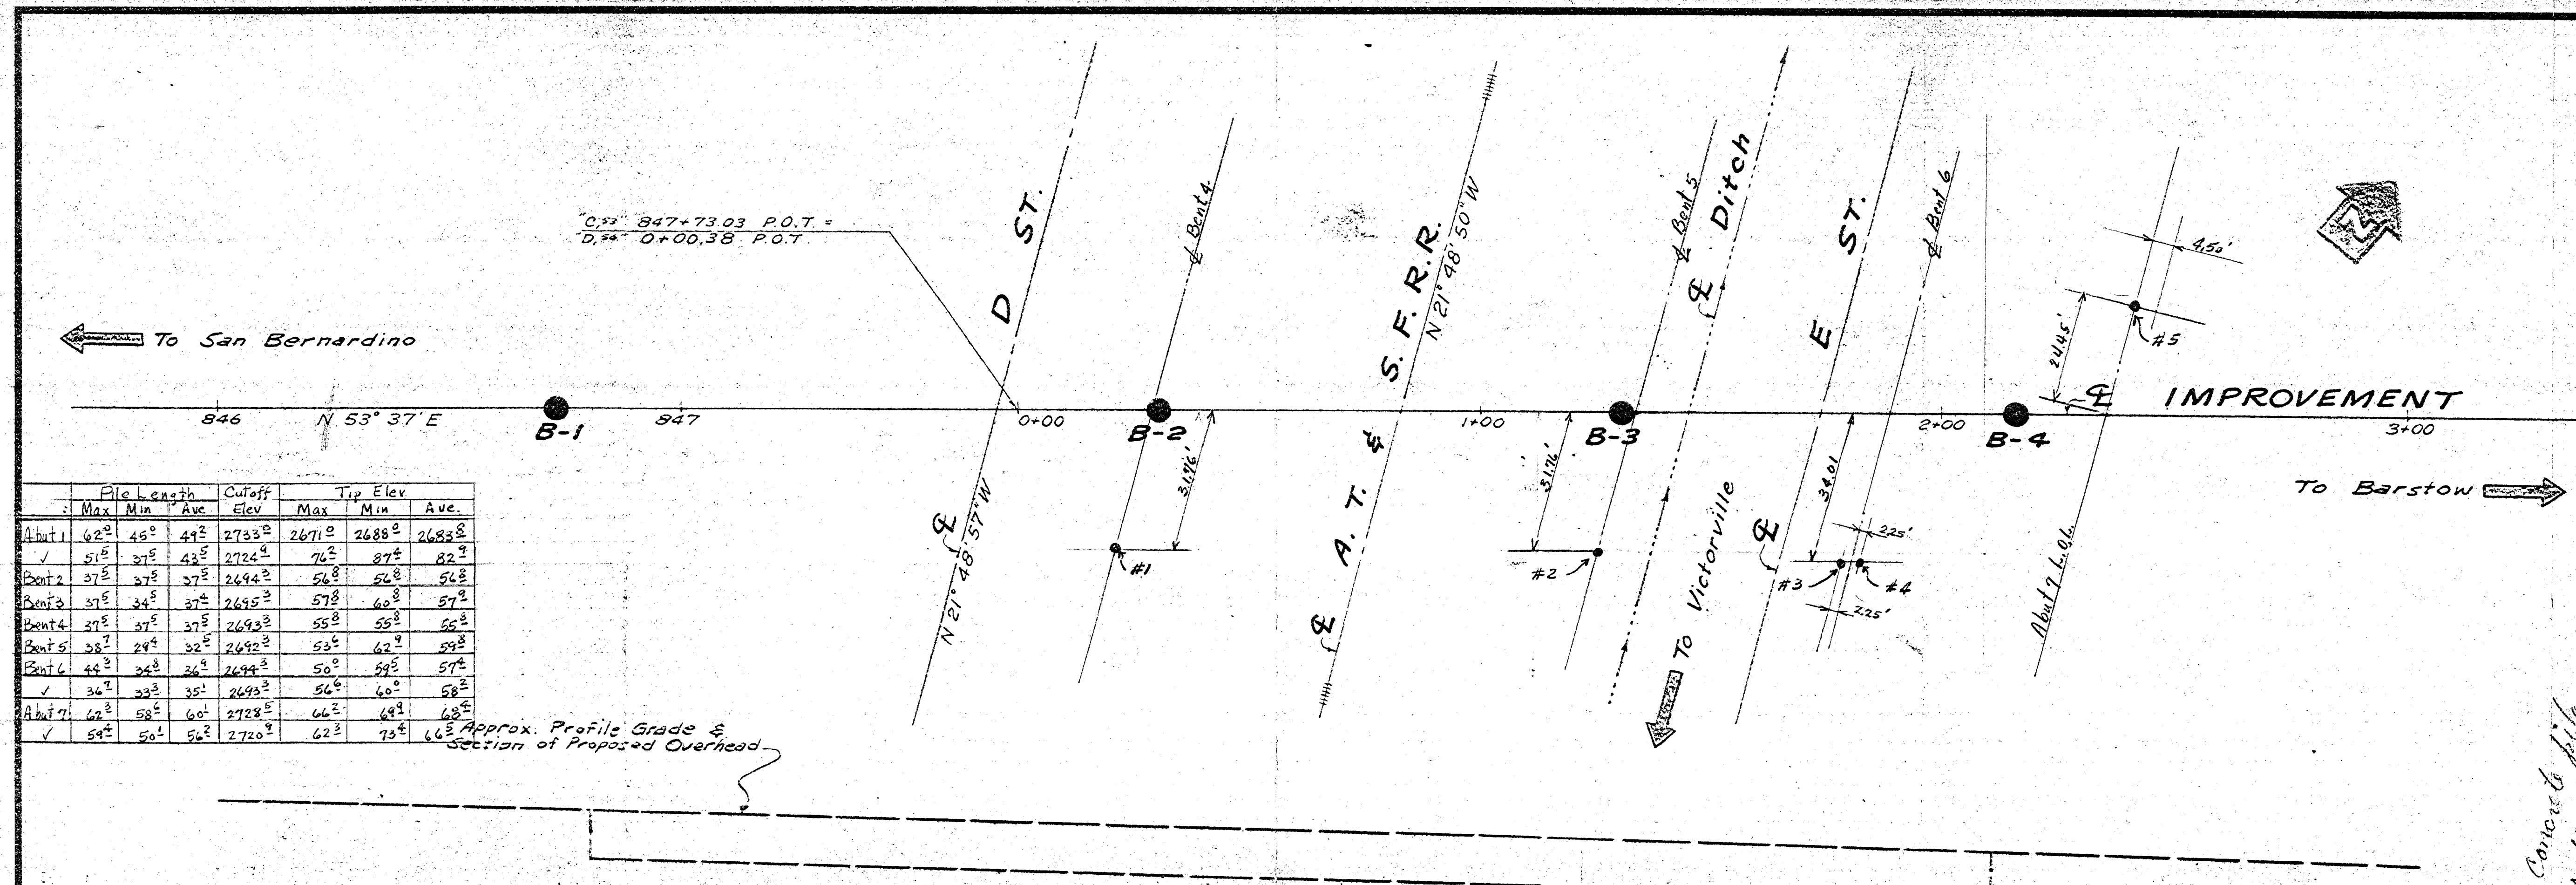


	Pile Length			Cutoff Elev.	Tip Elev.		
	Max	Min	Ave		Max	Min	Ave
Abut 1	42'	45'	44'	2783'	2671'	2688'	2683'
Bent 2	37'	37'	37'	2694'	56'	56'	54'
Bent 3	37'	34'	37'	2695'	57'	60'	57'
Bent 4	37'	37'	37'	2693'	55'	55'	55'
Bent 5	38'	29'	32'	2692'	53'	62'	59'
Bent 6	44'	34'	36'	2694'	50'	59'	57'
Abut 7	34'	33'	35'	2693'	56'	60'	58'
	47'	58'	60'	2728'	66'	69'	68'
	54'	56'	56'	2720'	62'	73'	66'

Approx. Profile Grade & Section of Proposed Overhead

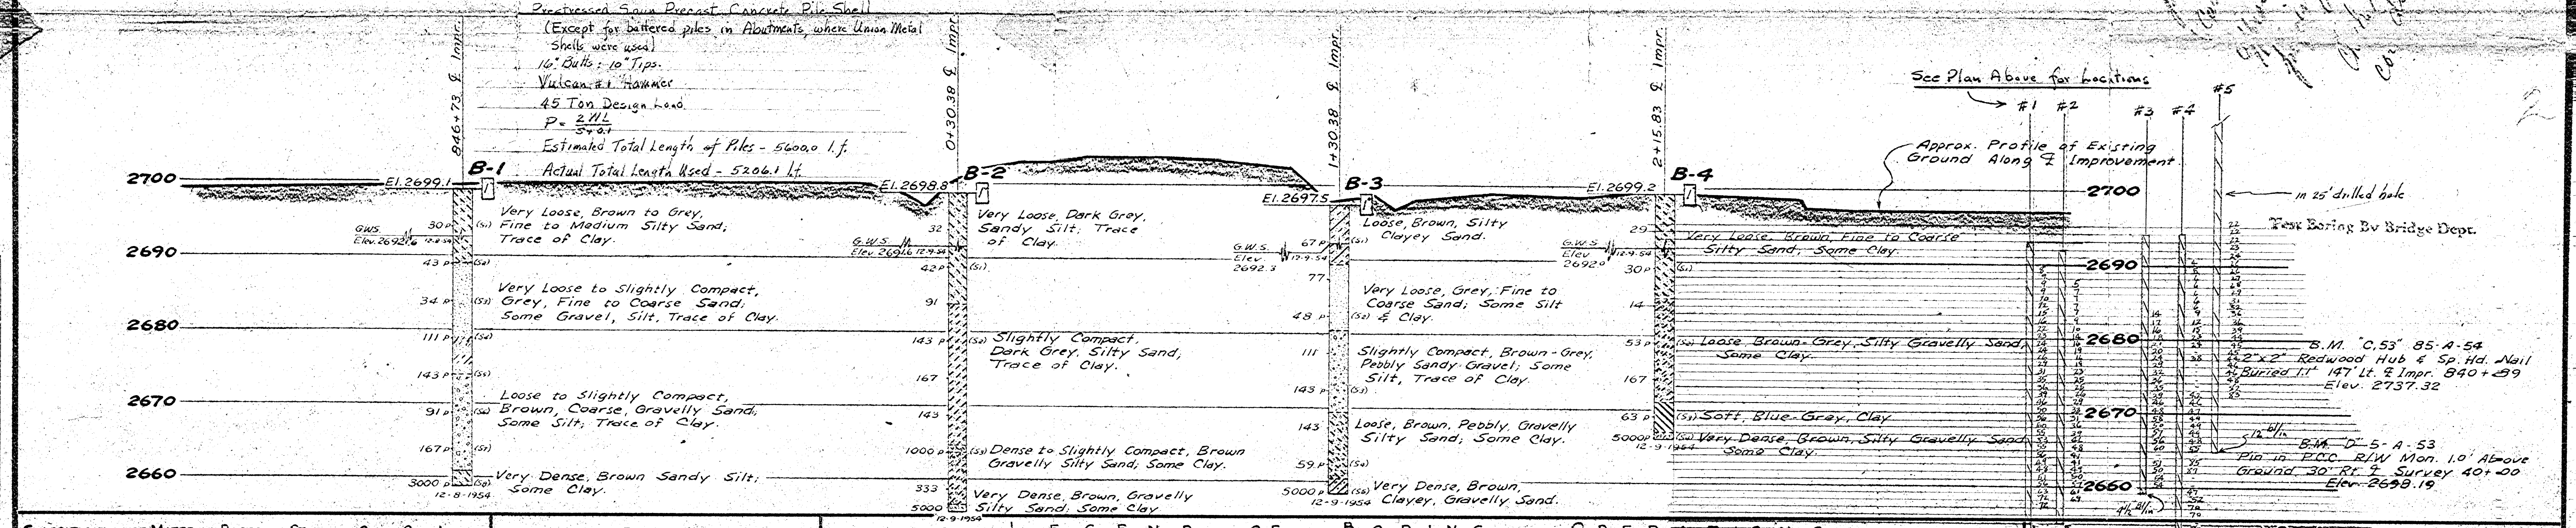


Concrete piles are recommended for foundation support. Estimated pile length for 45' pile is 51' to 55'. Piles should be in place 30 days before construction. Soil conditions should be noted in field log.

BRIDGE DEPARTMENT
 FIELD STUDY
 DRAWN BY J. Mansky
 CHECKED BY F. A. Kesting
 APPROVED BY [Signature]

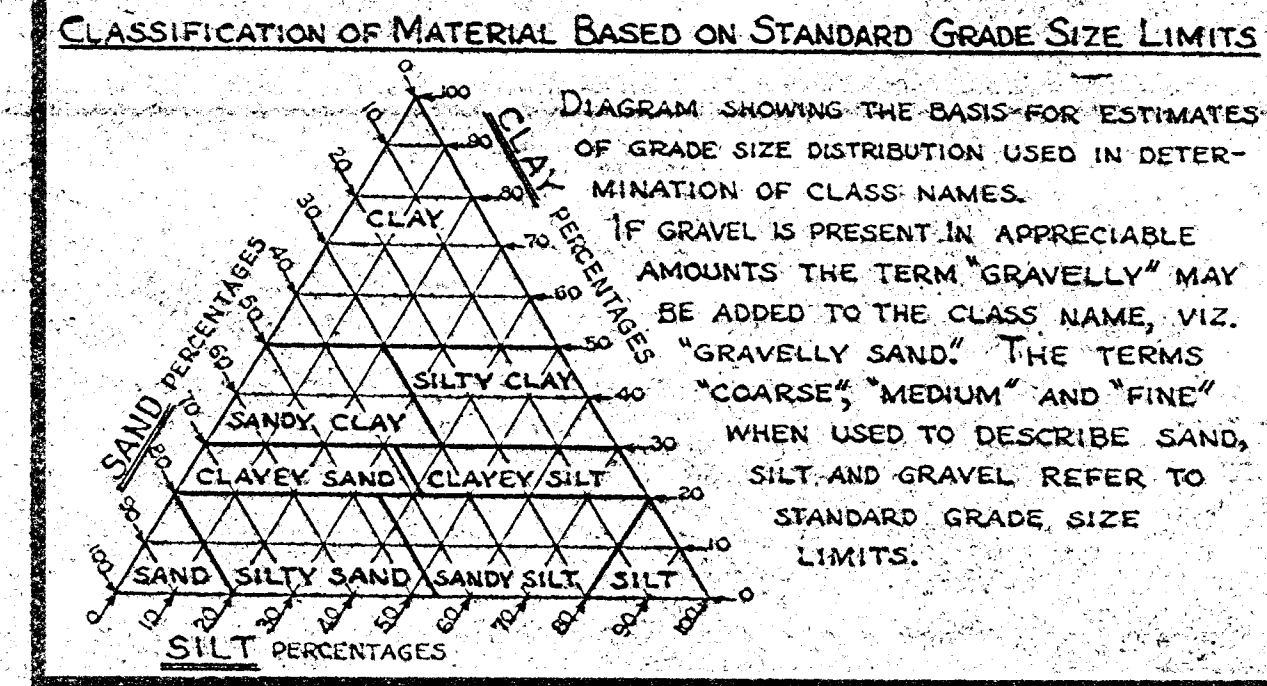

LEGEND OF EARTH MATERIALS

GRAVEL	SILTY CLAY OR CLAYEY SILT
SAND	PEAT AND/OR ORGANIC MATTER
SILT	FILL MATERIAL
CLAY	IGNEOUS ROCK
SANDY CLAY OR CLAYEY SAND	SEDIMENTARY ROCK
SANDY SILT OR SILTY SAND	METAMORPHIC ROCK

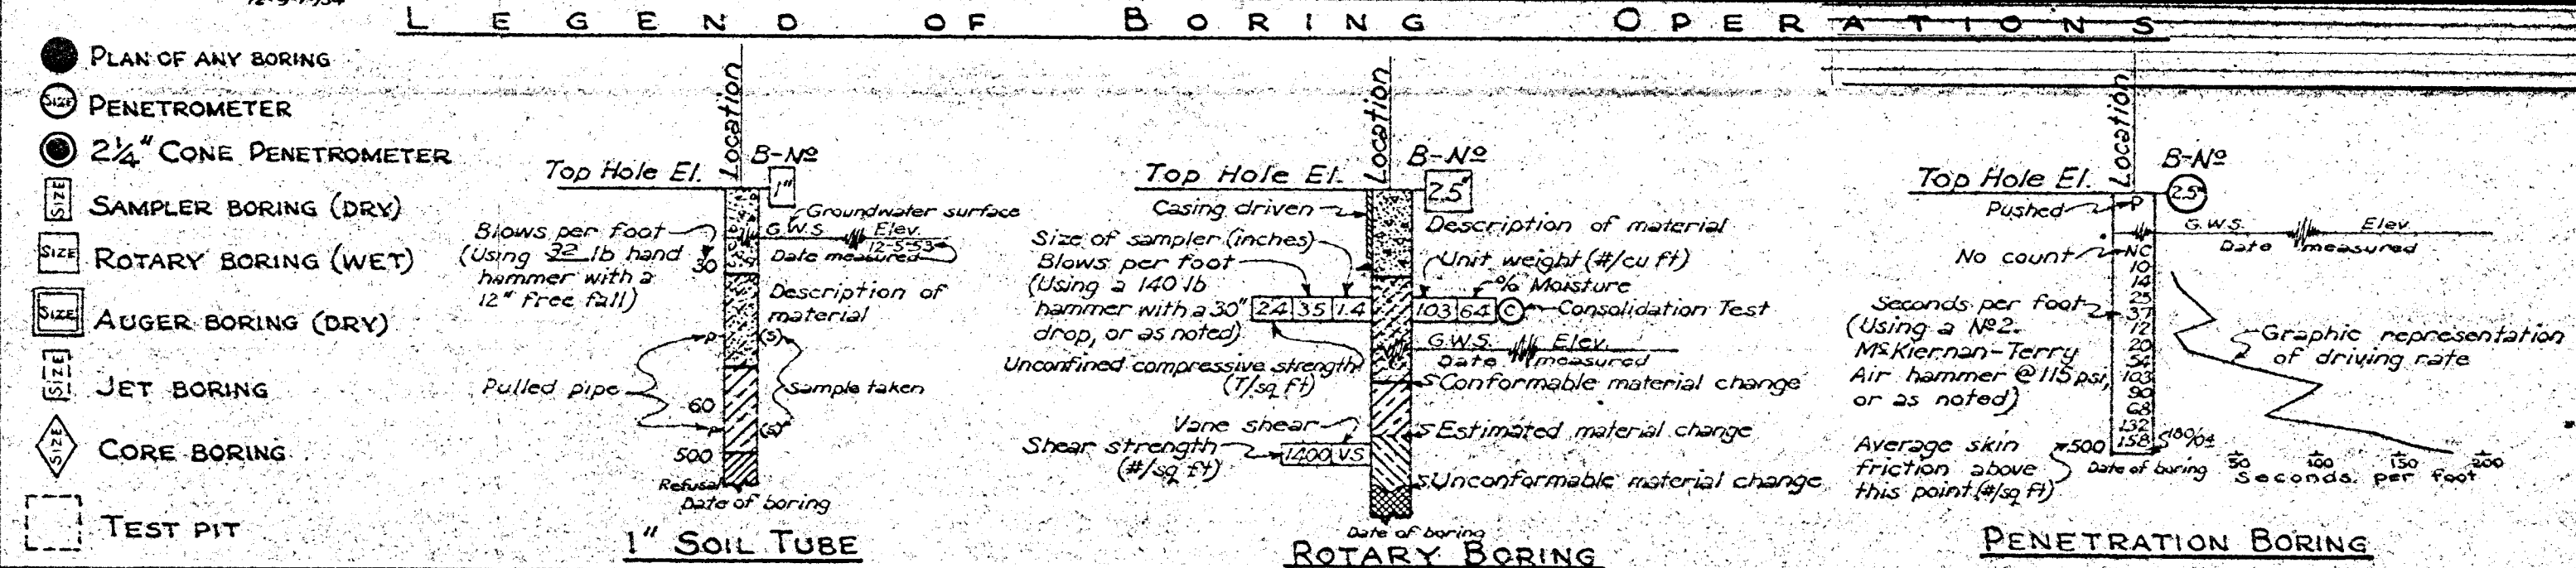

NOTES

The contractor's attention is directed to Section 2, Article (c) of the Standard Specifications and to the special provisions accompanying this set of plans. Classification of earth material as shown on this sheet is based upon field inspections and is not to be construed to imply mechanical analysis.

STATE OF CALIFORNIA
 DEPARTMENT OF PUBLIC WORKS
 DIVISION OF HIGHWAYS


VICTORVILLE OVERHEAD

LOG OF TEST BORINGS

Scale: Horiz. 1" = 20', Vert. 1" = 10'

BRIDGE 54-484 FILE DRAWING

39

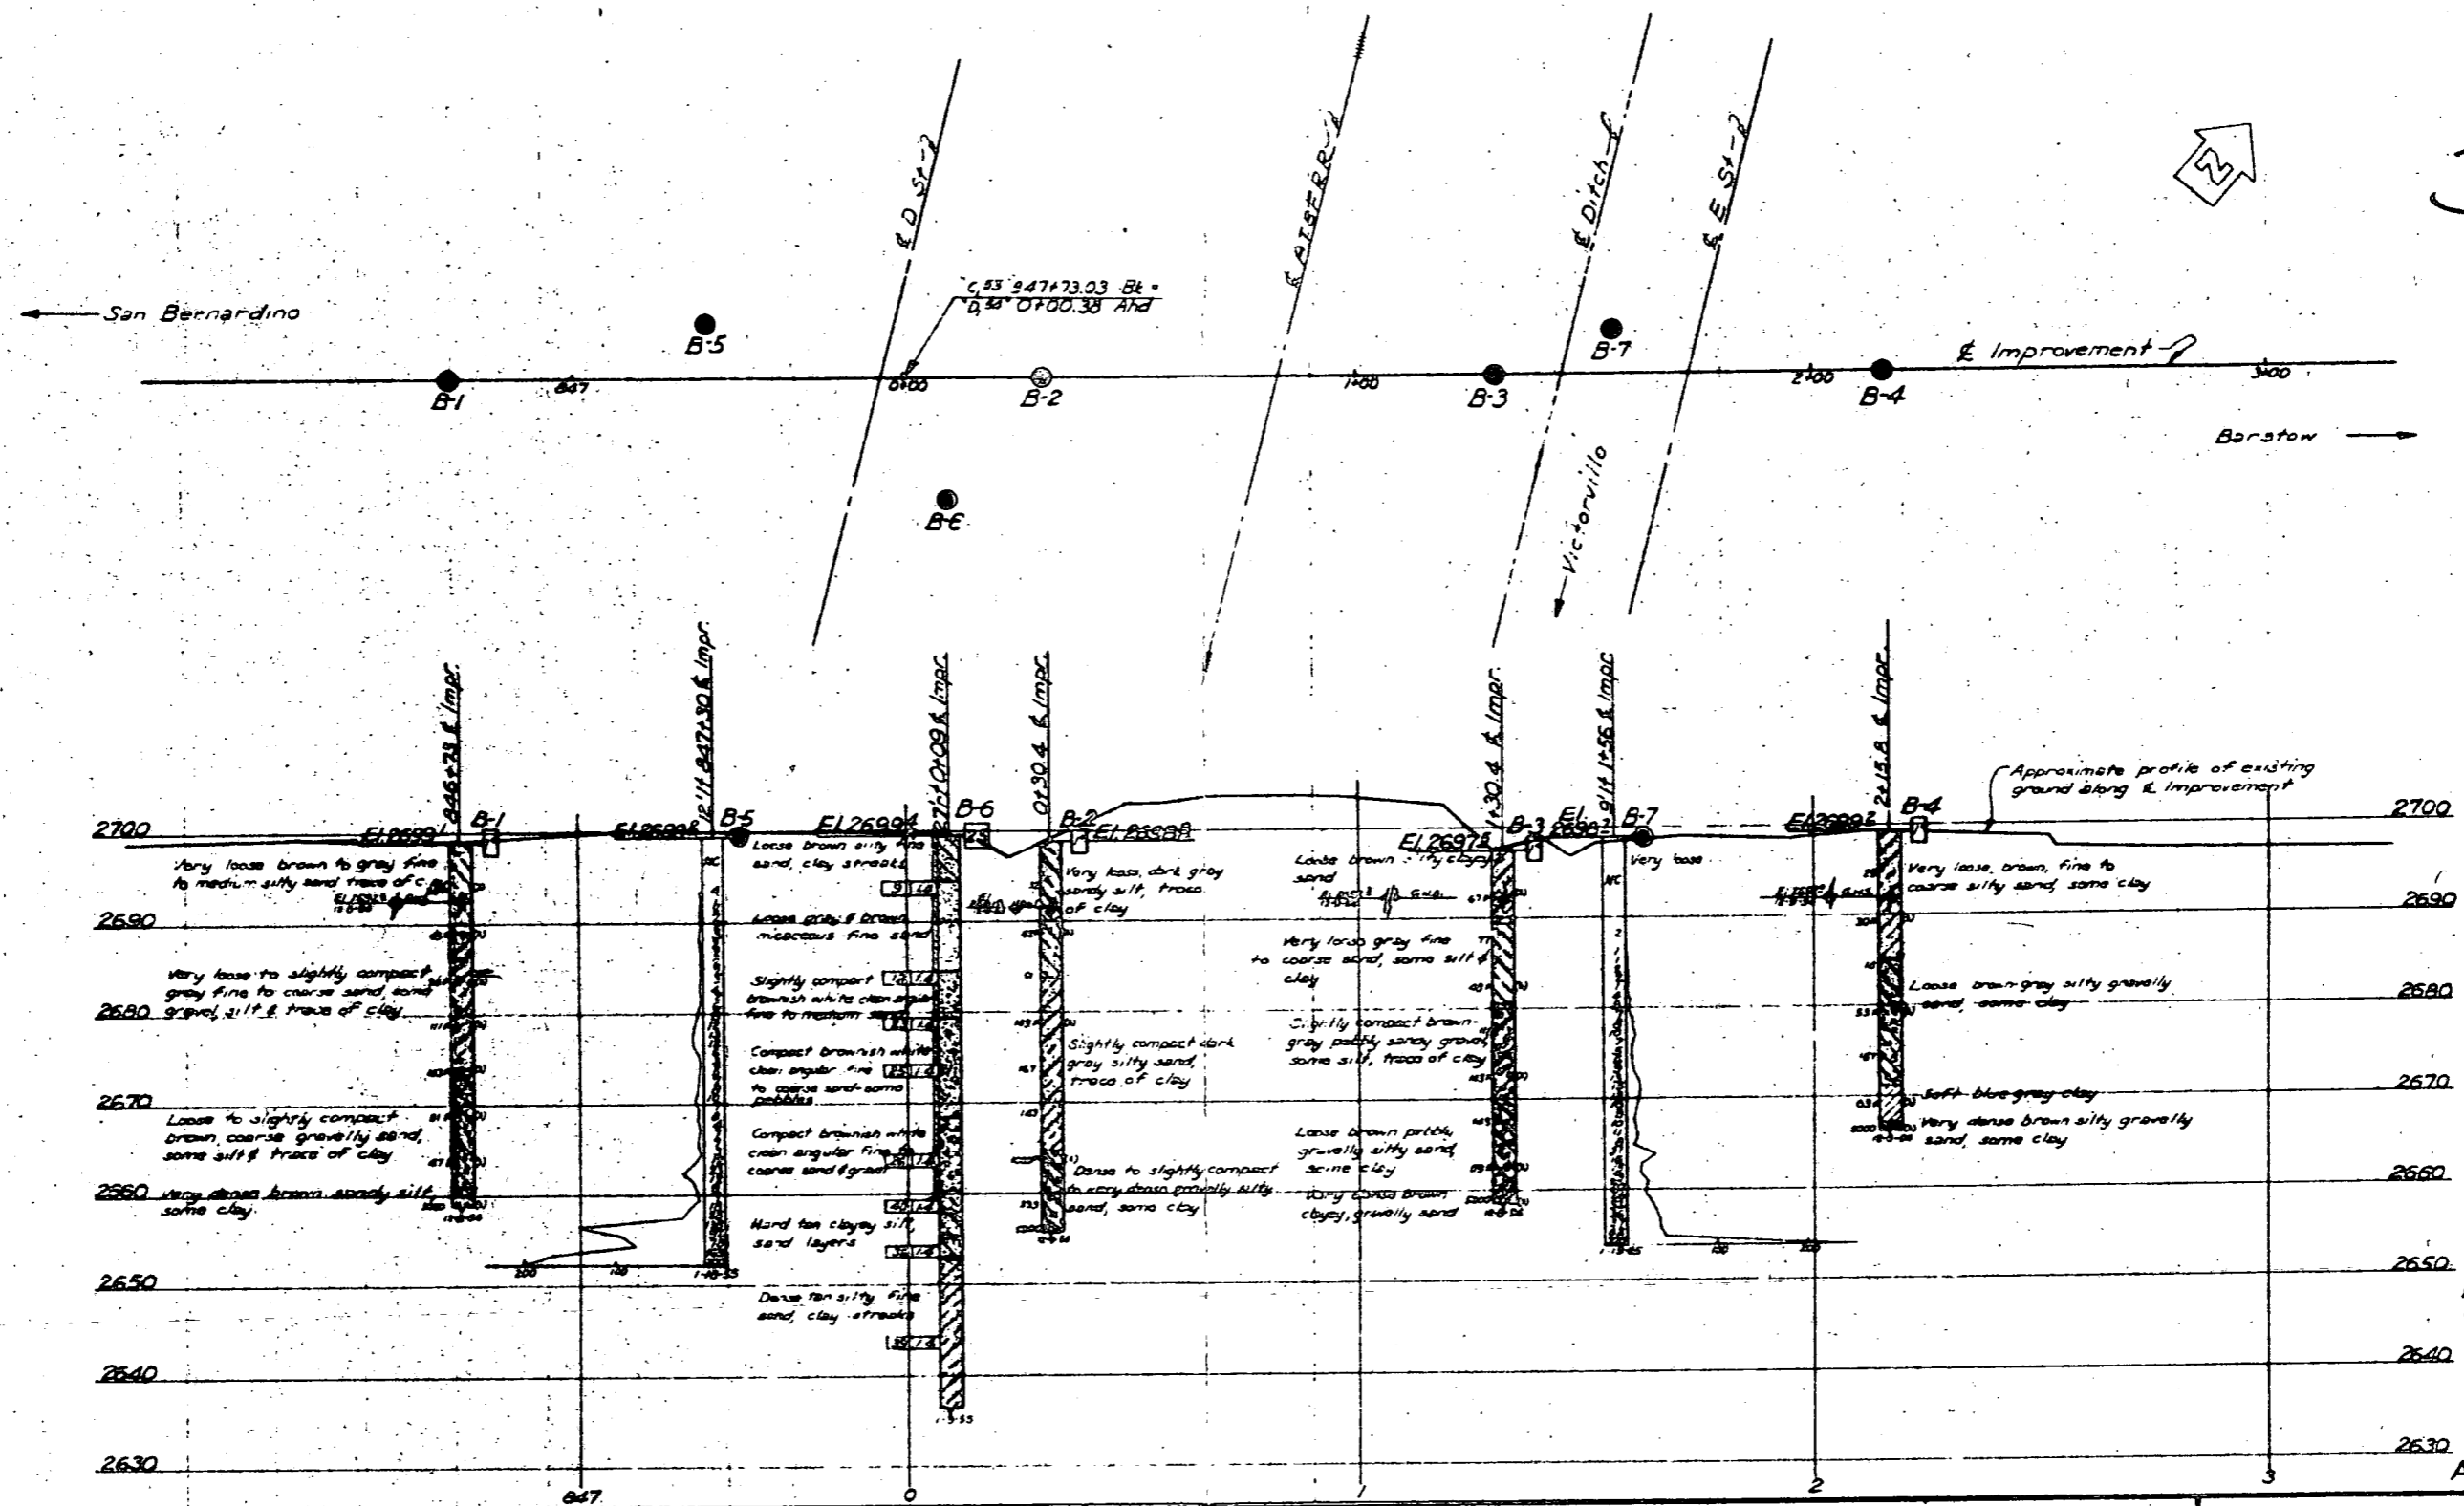


Test Borings by Bridge Dept.

B.M. 'C-53' 85-A-54
2" x 2" Redwood Hub & Sp. No. 1611
Bored 11' 147' H & Invar. Sta 840+09
Elev. 2737.32

B.M. 'D' 5-A-53
Dr. in PCC R/W Monument 2' above
ground 30' H & Invar. Sta 840+00
Elev. 2638.19

AS BUILT 6,750 OR REP


FIELD CHECKED BY: [Signature]
DATE: 1/31/54

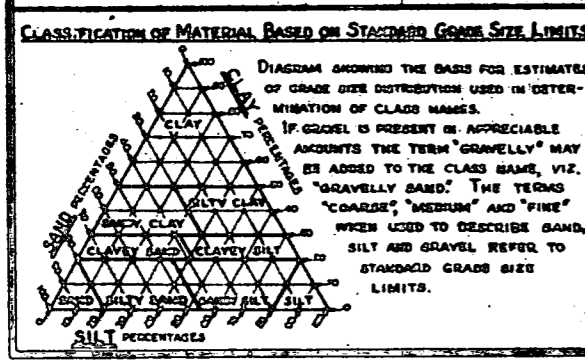

LEGEND OF EARTH MATERIALS

GRAVEL	SILTY CLAY OR CLAYEY SILT
SAND	PEAT OR ORGANIC MATTER
SILT	FILL MATERIAL
CLAY	IGNEOUS ROCK
SANDY CLAY OR CLAYEY SAND	SEDIMENTARY ROCK
SANDY SILT OR SILTY SAND	METAMORPHIC ROCK

- PLANS OF ANY BORING**
- PENETROMETER
 - 2 1/2" CONE PENETROMETER
 - ⊞ SAMPLER BORING (DRY)
 - ⊞ ROTARY BORING (WET)
 - ⊞ AUGER BORING (DRY)
 - ⊞ JET BORING
 - ⊞ CORE BORING
 - TEST PIT

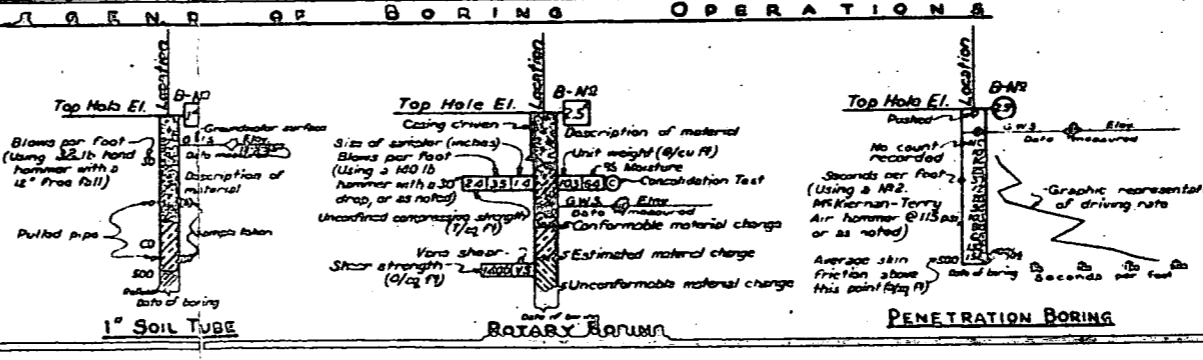

NOTES
The contractor's attention is directed to Section 2, Article (4) of the Standard Specifications and to the Special Provisions accompanying this set of plans.
Classification of earth recorded as shown on this sheet is based upon field inspection and is not to be construed to imply mechanical analysis.

STATE OF CALIFORNIA
DEPARTMENT OF PUBLIC WORKS
DIVISION OF HIGHWAYS

VICTORVILLE OVERHEAD
Rt. 31/43 Sep & OH.

LOG OF TEST BORINGS


SCALE: 1" = 20' HORIZ. 1" = 5' VERT.
BRIDGE 54-484 FILE DRAWING C-4269-13

FUEL DRAWING NO. P. 4269 3

35

Mojave River Bridge

DIST	COUNTY	ROUTE	POST MILES TOTAL PROJECT	SHEET No.	TOTAL SHEETS
08	SBd	15			


 REGISTERED CIVIL ENGINEER 8-14-13 DATE
 HASSAN IBRAHIM
 No. C59016
 Exp. 6-30-15
 CIVIL
 STATE OF CALIFORNIA

PLANS APPROVAL DATE _____

The State of California or its officers or agents shall not be responsible for the accuracy or completeness of electronic copies of this plan sheet.

This LOTB sheet was prepared in accordance with the Caltrans Soil & Rock Logging, Classification, & Presentation Manual (2010 Edition).
 See 2010 Standard Plans A10F and A10G for Soil Legend, and A10H for Rock Legend.
NOTE: LOTB sheets from 3 of 11 to 10 of 11, are based on the Soil & Rock Logging Classification Manual (Field Guide) August 1996.


BENCH MARK

These well monument elevations are based off of BM 43.7-92, Elevation= 2697.606 ft. 2 inches brass disk stamped "State of California Division of Highways BM 43.70-92". 45.9 Ft. right of Station 178.5 @ Interstate I-5 NGVD 1929.

To San Bernardino

R-10-001

R-10-002

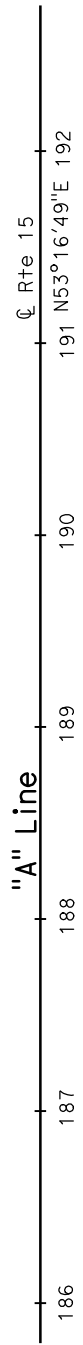

PLAN
1" = 50'

Station	Remarks	Elevation
2720	R-10-001	2717.3'
2710	3" 6" Asphalt concrete pavement of road surface over well-graded SAND (SW); brown; dry. Well-graded SAND with SILT (SW-SM); dense; light brown; moist; few fines; (FILL). Well-graded SAND (SW); very dense; brown; moist; few fine GRAVEL.	31.1, 4 52.1, 4 47.1, 4 55.1, 4
2700		
2690	Poorly-graded SAND with CLAY (SP-SC); dense; greenish brown; moist; mostly fine and medium; few coarse; trace fine GRAVEL; (NATIVE). Well-graded SAND with CLAY and GRAVEL (SW-SC); dense; grayish brown; wet; little well-graded GRAVEL; few fines.	38.1, 4 14.1, 4
2680	GWS Elev. 2681.1' Well-graded SAND (SW); medium dense; grayish brown; wet; little fines; trace fine GRAVEL. 5-18-10	9.1, 4 24.1, 4
2670	Poorly-graded SAND with CLAY (SP-SC); medium dense; grayish brown; wet; mostly fine and medium; few coarse; trace fine GRAVEL. Well-graded SAND with CLAY and GRAVEL (SW-SC); dense; grayish brown; wet; little well-graded GRAVEL; few fines.	37.1, 4 38.1, 4
2660	Well-graded SAND with SILT and GRAVEL (SW-SM); dense; grayish brown; wet; some well-graded SAND; few fines. Well-graded SAND with SILT and GRAVEL (SW-SM); dense; grayish brown; wet; little well-graded GRAVEL; few fines.	34.1, 4 36.1, 4
2650	SILTY SAND (SM); dense; grayish brown; wet; well-graded SAND; little fines; few fine GRAVEL. -very dense; mostly fine; trace GRAVEL. -mostly fine and medium.	52.1, 4 59.1, 4
2640	Well-graded SAND with CLAY and GRAVEL (SW-SC); dense; grayish brown; wet; few fines; trace fine GRAVEL. -very dense; little fines; few GRAVEL.	39.1, 4 55.1, 4
2630		56.1, 4
2620	SILTY SAND (SM); dense; grayish brown; wet; medium to fine SAND; little fines; trace GRAVEL. -very dense; well-graded SAND; few fine GRAVEL. -dense; brown; trace fine GRAVEL.	43.1, 4 49.1, 4 39.1, 4
2610		46.1, 4
2600		74.1, 4 46.1, 4
2590		52.1, 4 63.1, 4
2580		85.1, 4 75.1, 4
2570		82.1, 4 68.1, 4
2560		70.1, 4 82.1, 4
2550		100.1, 4 83.1, 4 80.1, 4
2540	4-28-10 Terminated at Elev 2545.8' ERI = 68%	

PROFILE
Horiz: 1" = 10'
Vert: 1" = 10'

187+00

186+00

ENGINEERING SERVICES		MATERIALS AND GEOTECHNICAL SERVICES		STATE OF CALIFORNIA DEPARTMENT OF TRANSPORTATION		DIVISION OF ENGINEERING SERVICES STRUCTURE DESIGN DESIGN BRANCH X		MOJAVE RIVER BRIDGE (WIDEN) LOG OF TEST BORINGS 1 OF 11	
FUNCTIONAL SUPERVISOR NAME: A. Perez-Cobo	DRAWN BY: F. Nguyen CHECKED BY: S. Logeswaran	FIELD INVESTIGATION BY: H. Ibrahim		BRIDGE NO. 54-0483 POST MILE 43.93		BRIDGE NO. 54-0483 POST MILE 43.93		REVISION DATES 01-26-13 02-12-13 03-01-13	
065 CIVIL LOG OF TEST BORINGS SHEET				ORIGINAL SCALE IN INCHES FOR REDUCED PLANS		UNIT: 3643 PROJECT NUMBER & PHASE: 08000006211		DISREGARD PRINTS BEARING EARLIER REVISION DATES	
				CONTRACT NO.: 08-355561		SHEET OF X X		FILE => mojave-v01.dgn	

DIST	COUNTY	ROUTE	POST MILES TOTAL PROJECT	SHEET No.	TOTAL SHEETS
08	SBD	15			


8-14-13
 REGISTERED CIVIL ENGINEER DATE
 Asef Wardak
 No. C61960
 Exp. 9-30-13
 CIVIL
 STATE OF CALIFORNIA

PLANS APPROVAL DATE

The State of California or its officers or agents shall not be responsible for the accuracy or completeness of electronic copies of this plan sheet.

This LOTB sheet was prepared in accordance with the Caltrans Soil & Rock Logging, Classification, & Presentation Manual (2010 Edition).
 See 2010 Standard Plans A10F and A10G for Soil Legend, and A10H for Rock Legend.

FOR PLAN VIEW, SEE
 "LOG OF TEST BORINGS 1 OF 11"

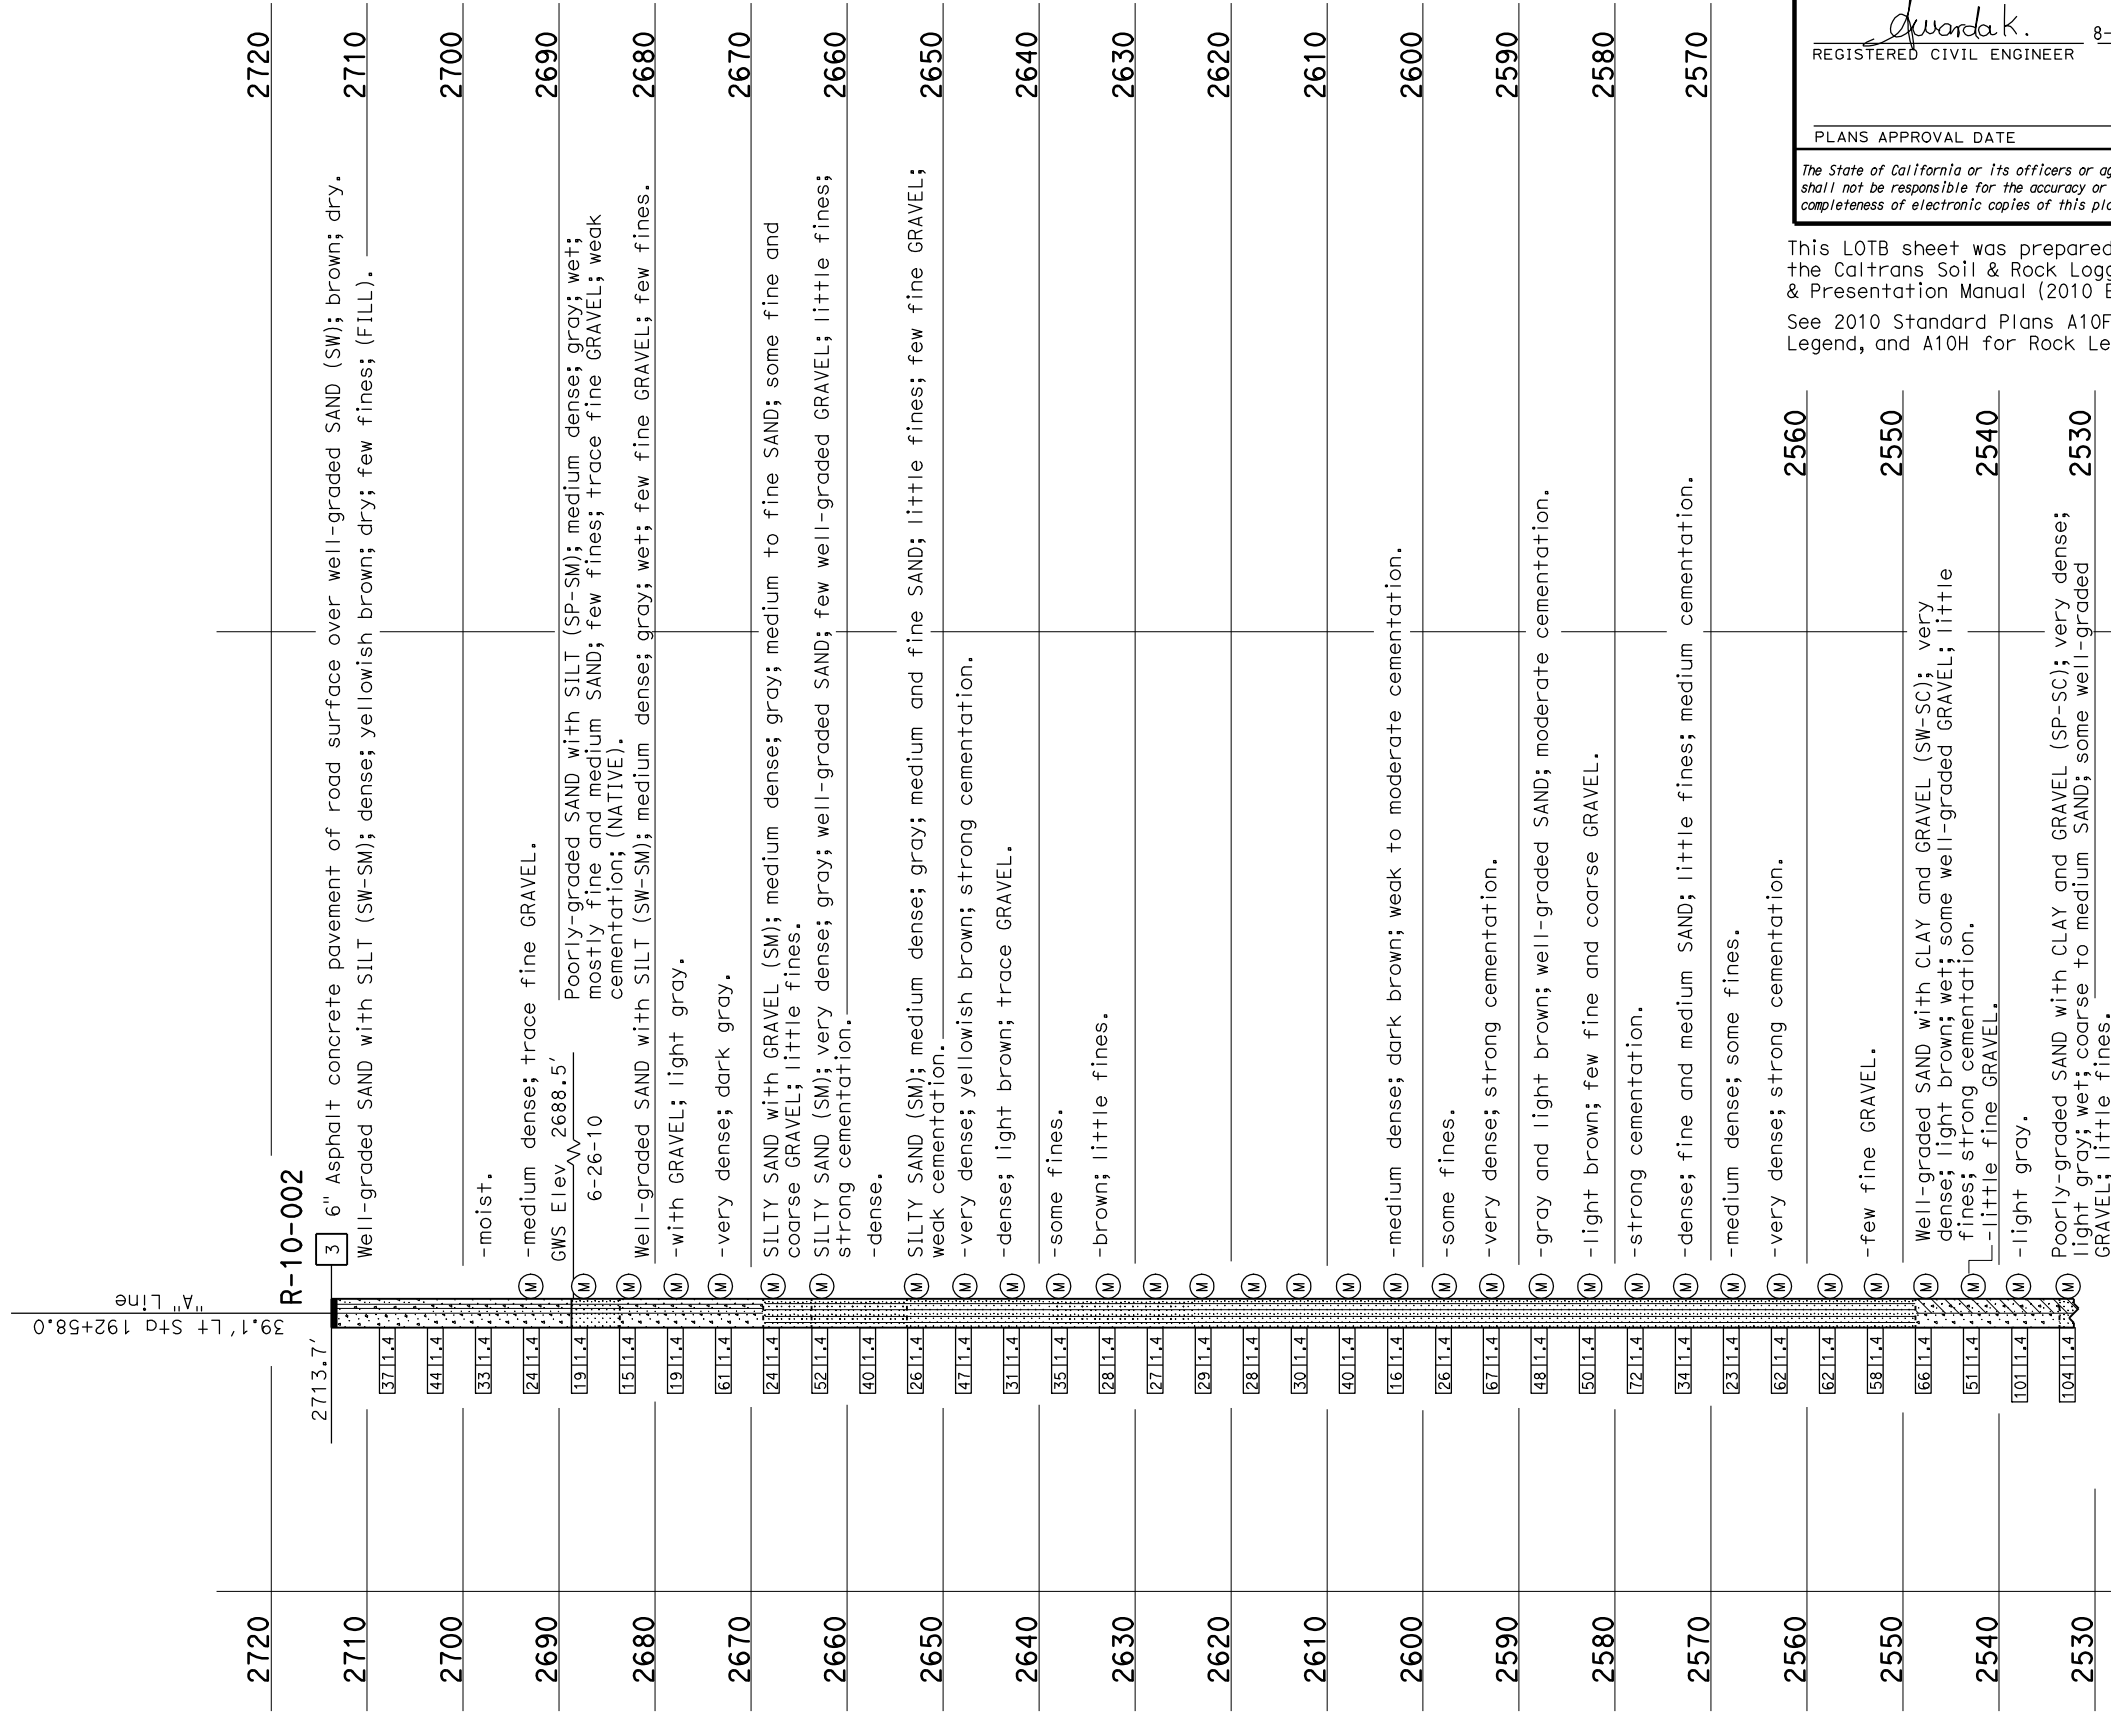

192+00

194+00

PROFILE
 Horiz: 1" = 20'
 Vert: 1" = 10'

ENGINEERING SERVICES FUNCTIONAL SUPERVISOR NAME: A. Perez-Cobo		MATERIALS AND GEOTECHNICAL SERVICES DRAWN BY: F. Nguyen CHECKED BY: S. Logeswaran		FIELD INVESTIGATION BY: A. Wardak		STATE OF CALIFORNIA DEPARTMENT OF TRANSPORTATION		DIVISION OF ENGINEERING SERVICES STRUCTURE DESIGN DESIGN BRANCH X		BRIDGE NO. 54-0483 POST MILE 43.93		MOJAVE RIVER BRIDGE (WIDEN) LOG OF TEST BORINGS 2 OF 11			
ORIGINAL SCALE IN INCHES FOR REDUCED PLANS				UNIT: 3643 PROJECT NUMBER & PHASE: 08000006211		CONTRACT NO.: 08-355561		DISREGARD PRINTS BEARING EARLIER REVISION DATES				REVISION DATES 01-26-13 02-12-13 03-01-13		SHEET OF X X	

FILE => mojave-v02.dgn

DIST	COUNTY	ROUTE	POST MILES TOTAL PROJECT	SHEET No.	TOTAL SHEETS
08	SBd	15			

REGISTERED CIVIL ENGINEER: Hassan Ibrahim
 No. C59016
 Exp. 6-30-15
 STATE OF CALIFORNIA
 REGISTERED PROFESSIONAL ENGINEER
 DATE: 8-14-13
 PLANS APPROVAL DATE: _____
 The State of California or its officers or agents shall not be responsible for the accuracy or completeness of electronic copies of this plan sheet.



BENCH MARK

BM Elev 2718.889'
 N 616469.644 E 2064601.085
 Caltrans aerial target #1-8, nail in asphalt on right shoulder of northbound I-15

TO SAN BERNARDINO ←

☉ RTE 15

"A" Line
 N53°16'49"E
 → TO BARSTOW

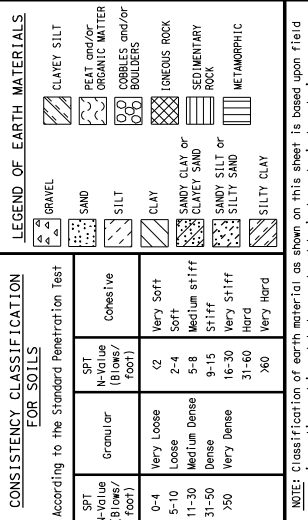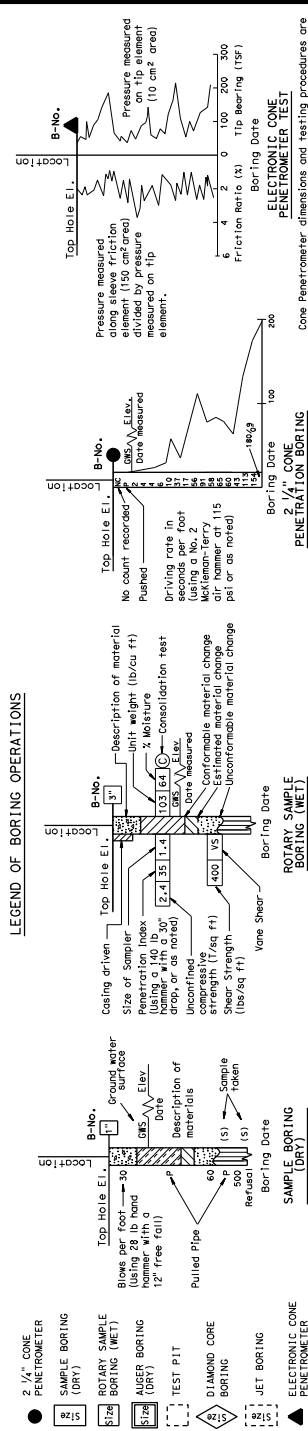

GPS SURVEY NOTES

Test Boring collar position and elevation data has acquired by Differential Global Positioning System methods utilizing a Trimble 12-Channel Pro XRGPS with Minimum Shift Key (MSK) beacon receiver with applied real time differential correction. Horizontal datum : U.S. State Plane 1983 High Precision Geodetic Network (HPGN)

Projection	Zone	
California State Plane Coordinate System	5	
Boring Number	(N) Coordinate	(E) Coordinate
B-1-01	616692.685	2064795.885
B-2-01	616532.026	2064706.510
B-3-01	616496.053	2064671.152
B-4-01	616560.871	2064743.180
B-5-01	616605.484	2064729.150
B-6-01	616617.208	2064727.563
B-7-01	616574.136	2064688.918
B-8-01	616604.509	2064687.583
B-9-01	616595.539	2064665.938
B-10-01	616645.364	2064755.149
B-11-01	616643.181	2064783.874
B-12-01	616606.170	2064800.878
B-13-01	616585.486	2064774.194
B-14-01	616564.448	2064749.462
B-15-01	616613.711	2064740.071
B-16-01	616553.001	2064732.427
B-17-01	616539.325	2064713.315
B-18-01	616526.572	2064696.005
B-19-01	616567.237	2064674.049
B-20-01	616595.558	2064678.743

PLAN 1" = 50'

NOTES:

- The descriptions and classifications of rock and/or soil, including consistency and relative density descriptors, used by the field and/or office personnel for the exploration boreholes shown on this sheet are based on the "Soil and Rock Logging Classification Manual (Field Guide)," Engineering Service Center, Office of Structural Foundations, August 1996.
- Soil colors were determined by using Munsel Soil Color Charts (1994, Revised Edition). Rock colors were determined using Geological Society of America rock color charts (1995, 8th Printing).
- Ground water was measured in borings B-4-01, B-5-01, and B-6-01. Please refer to those borings for ground water measurements. No attempt was made to measure ground water in borings B-7-01 through B-20-01. Those borings were backfilled immediately after completion of drilling.
- The ground water levels indicated in the Log of Test Borings (LOBT) sheets reflect the measured ground water levels measurement in the boreholes on the specified dates. Ground water surface elevations are subject to seasonal fluctuations and will be encountered at higher or lower elevations depending on conditions at time of constructions.
- Test boring B-1-01 utilized a safety hammer to advance the sampler using a 140 lb hammer with a 30" drop. Penetration index values shown are the actual blow counts recorded in the field. Soil descriptions shown on the LOBT sheets for those borings are based on these index values.
- Test boring B-2-01 and B-4-01 through B-13-01 utilized a Dietrich auto hammer to advance the sampler using a 140 lb hammer with a 30" drop. Penetration index values shown are the actual blow counts recorded in the field. Soil consistency classifications for those borings are based on a conversion factor of 1.5 times the blow count.
- The boring B-3-01 utilized a safety hammer from the top of the down to Elev 2666.3' and a Dietrich auto hammer from Elev 2666.3' to the bottom of the boring, to advance the sampler using a 140 lb hammer with a 30" drop. Penetration index values shown are the actual blow counts recorded in the field. Soil consistency classifications shown on the LOBT sheet for boring B-3-01, from the top of the boring down to Elev 2666.3', are based on the actual blow counts recorded on the field, and from Elev 2666.3' to bottom of the boring are based on a conversion factors of 1.5 times the field blow count.
- E = Blow count for 1' penetration extrapolated from blow count for less than 1' (due to change in material or hard driving).
- Borings B-14-01 through B-20-01 were 2.24" diameter cone penetration borings, advanced using a Mobile 3000 hydraulic operated hoe ram. Due to the variability of the energy output of the Mobile 3000 rig, the rig was only used to estimate the depth to very dense earth material.

ENGINEERING SERVICES	MATERIALS & GEOTECHNICAL SVCS	FIELD INVESTIGATION BY:
DRAWN BY: I.G-Remmen	CHECKED BY: A. Wardak	E. Neupert, F. Gerami

STATE OF CALIFORNIA
DEPARTMENT OF TRANSPORTATION

DIVISION OF ENGINEERING SERVICES
STRUCTURE DESIGN
DESIGN BRANCH X

BRIDGE NO.: 54-0483
 POST MILE: 43.8

MOJAVE RIVER BRIDGE (WIDEN)
LOG OF TEST BORINGS 3 OF 11

CONTRACT NO.: 08-355561

DIST	COUNTY	ROUTE	POST MILES TOTAL PROJECT	SHEET No.	TOTAL SHEETS
08	SBd	15			

REGISTERED CIVIL ENGINEER *Hassan Ibrahim* DATE 8-14-13
 PLANS APPROVAL DATE _____
 No. C59016
 Exp. 6-30-15
 CIVIL ENGINEER
 STATE OF CALIFORNIA

The State of California or its officers or agents shall not be responsible for the accuracy or completeness of electronic copies of this plan sheet.

FOR PLAN VIEW, SEE
"LOG OF TEST BORINGS 3 OF 11"

LEGEND OF BORING OPERATIONS


2 1/4" CONE PENETROMETER
 SAMPLE BORING (DRY)
 ROTARY SAMPLE BORING (WET)
 AUGER BORING (DRY)
 TEST PIT
 DIAMOND CORE BORING
 JET BORING
 ELECTRONIC CONE PENETROMETER

LEGEND OF EARTH MATERIALS
 GRAVEL
 SAND
 SILT
 CLAY
 SANDY CLAY or CLAYEY SAND
 SILTY SAND or SANDY SILT
 SILTY CLAY
 CLAYEY SILT
 REAL and/or GRANULIC MAYER
 COBBLES and/or BOULDERS
 LENTICULAR ROCK
 SEDIMENTARY ROCK
 METAMORPHIC ROCK

CONSISTENCY CLASSIFICATION FOR SOILS
 According to the Standard Penetration Test

SPt No./Blow (ft)	Consistency
0-4	Very Loose
5-10	Loose
11-30	Medium Dense
31-50	Dense
750	Very Dense

NOTE: Classification of earth material as shown on this sheet is based upon field inspection and is not to be construed to imply mechanical analysis.

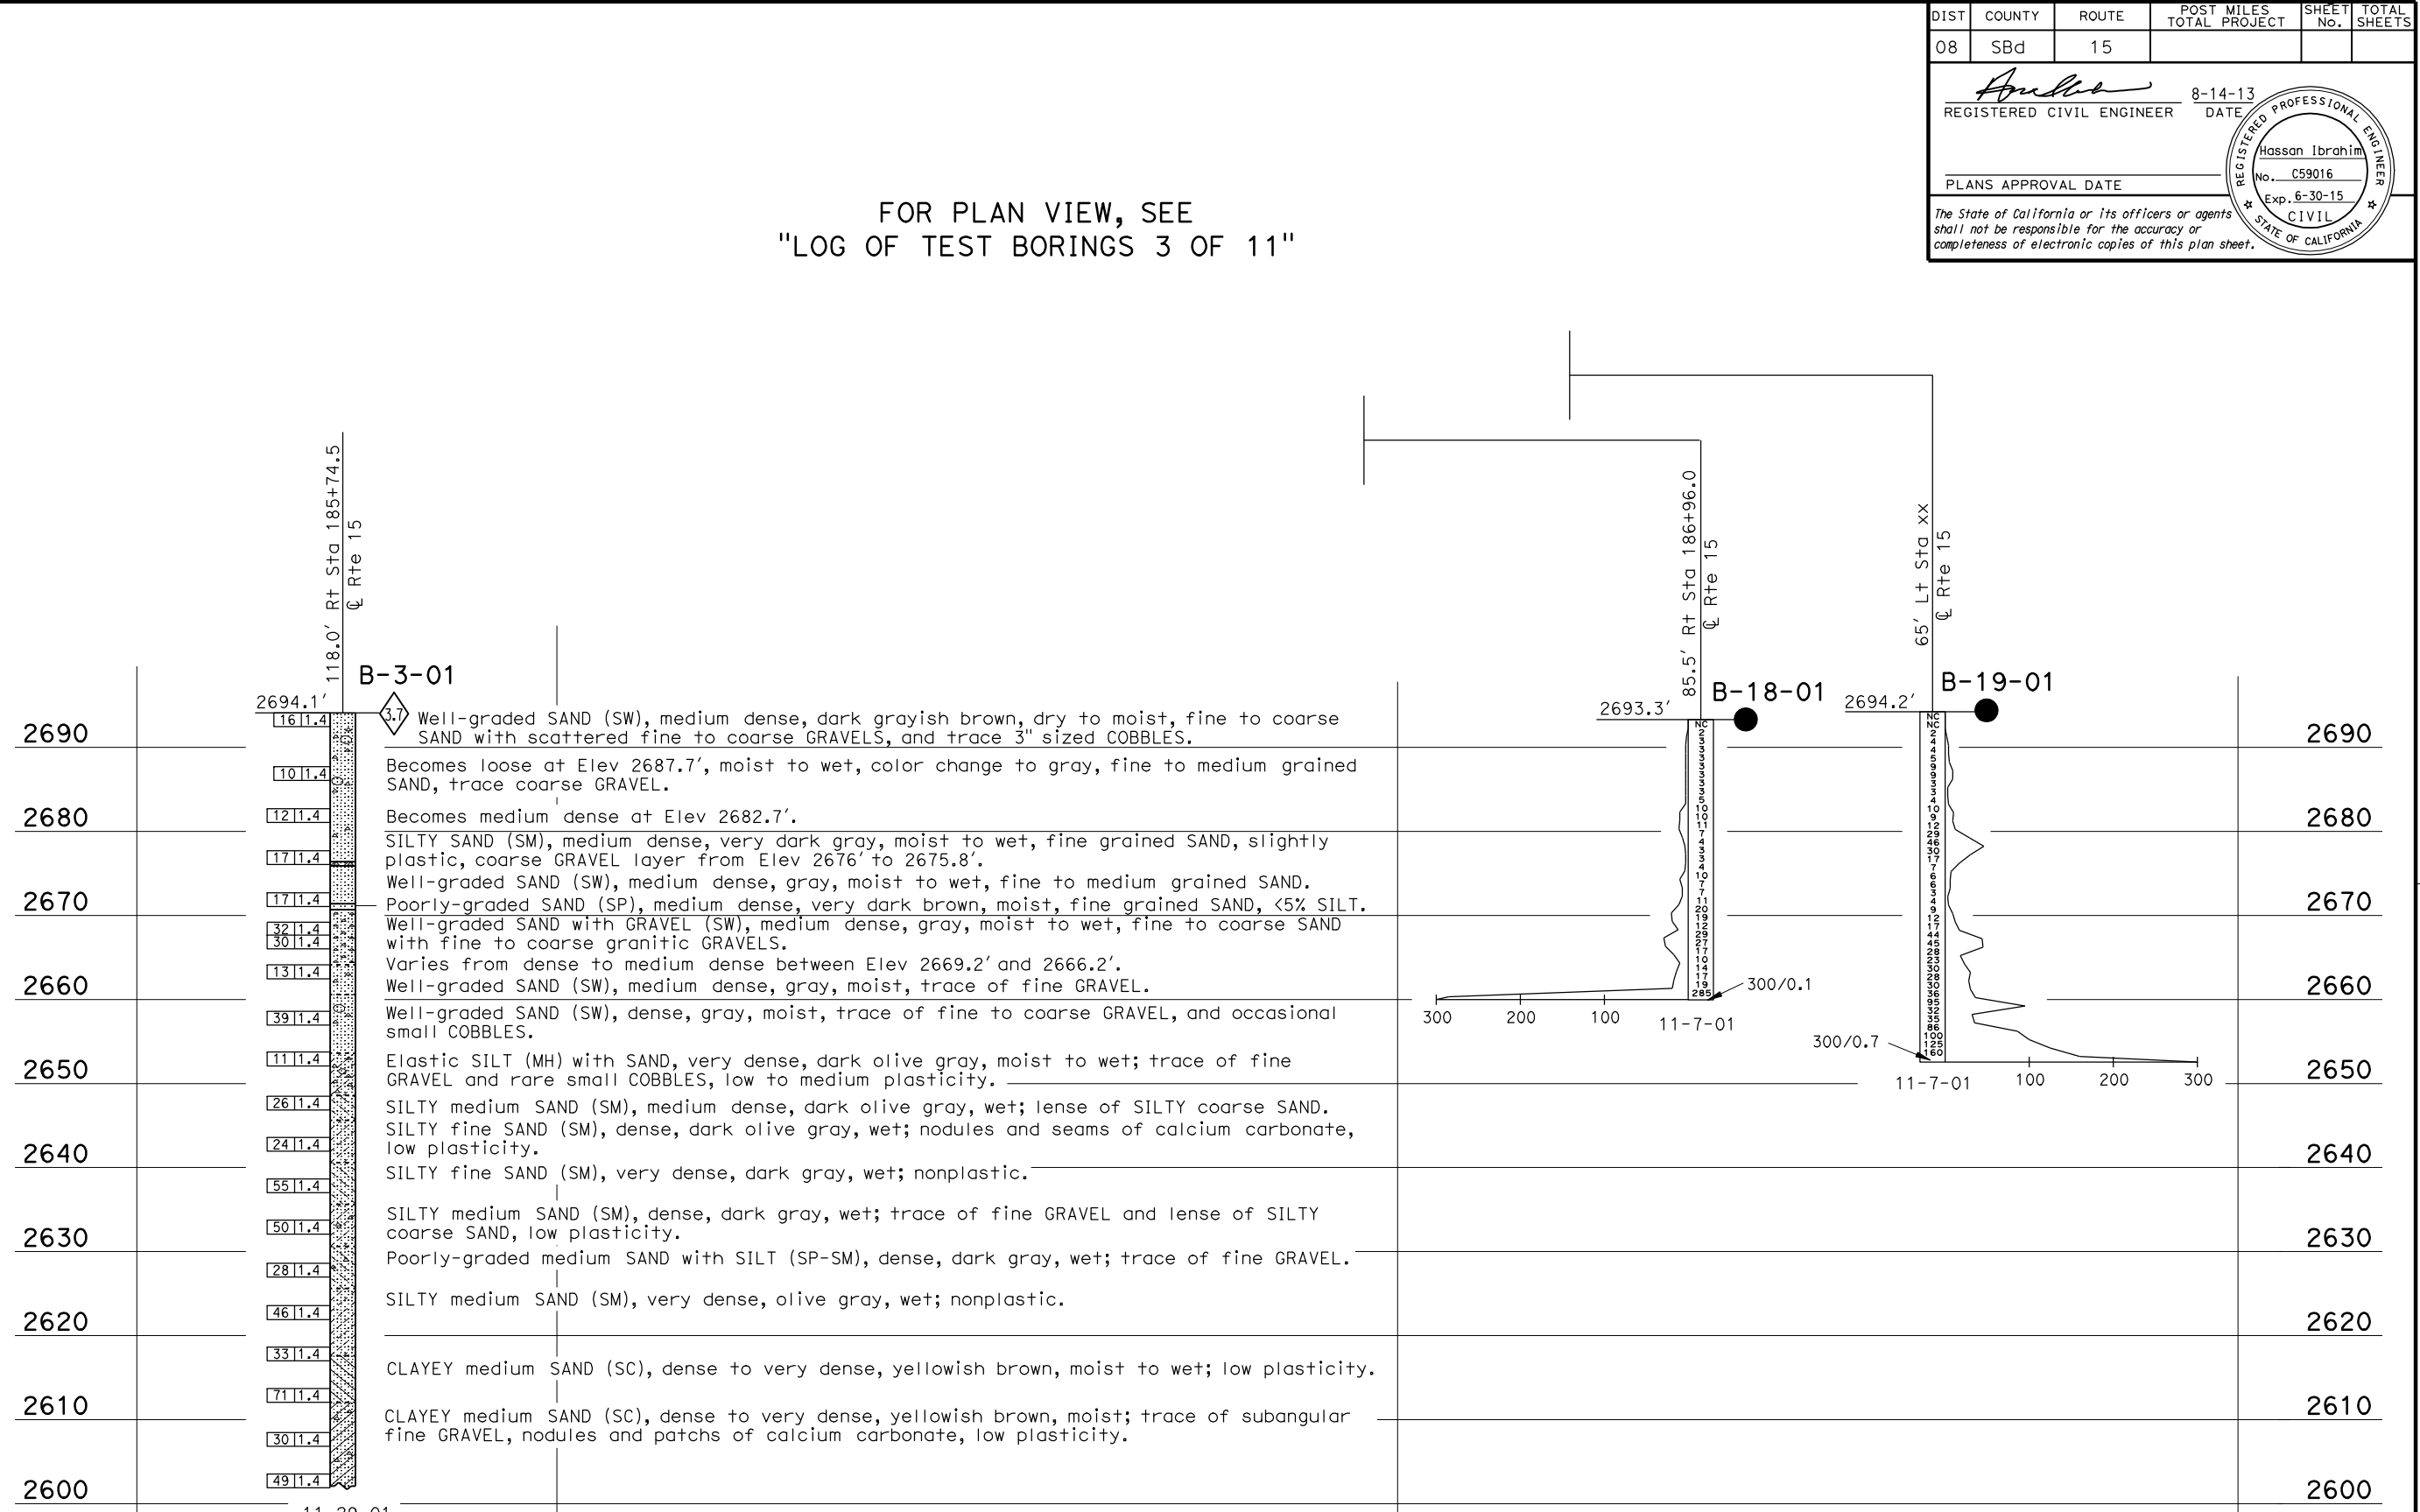

ENGINEERING SERVICES	MATERIALS & GEOTECHNICAL SVCS	FIELD INVESTIGATION BY: E. Neupert	STATE OF CALIFORNIA DEPARTMENT OF TRANSPORTATION	DIVISION OF ENGINEERING SERVICES STRUCTURE DESIGN DESIGN BRANCH X	BRIDGE NO. 57-1226 POST MILE 0.90	MOJAVE RIVER BRIDGE (WIDEN) LOG OF TEST BORINGS 4 OF 11
DRAWN BY I. G. Remmen	CHECKED BY A. Wardak					REVISION DATES 08-07-13

DIST	COUNTY	ROUTE	POST MILES TOTAL PROJECT	SHEET No.	TOTAL SHEETS
08	SBd	15			

REGISTERED CIVIL ENGINEER DATE 8-14-13

PLANS APPROVAL DATE _____

The State of California or its officers or agents shall not be responsible for the accuracy or completeness of electronic copies of this plan sheet.

FOR PLAN VIEW, SEE
"LOG OF TEST BORINGS 3 OF 11"

LEGEND OF BORING OPERATIONS


2 1/4" CONE PENETROMETER
 SAMPLE BORING (DRY)
 ROTARY BORING (WET)
 AUGER BORING (WET)
 TEST PIT
 STANDARD BORING
 JET BORING
 ELECTRONIC CONE PENETROMETER

LEGEND OF EARTH MATERIALS
 GRAVEL
 SAND
 SILT
 CLAY
 SANDY CLAY or CLAYEY SAND
 SILTY SAND
 SILTY CLAY
 CLAYEY SILT
 REAL and/or GRANULIC MATTER
 COBBLES and/or BOLLERS
 LENTICULAR ROCK
 SEDIMENTARY ROCK
 METAMORPHIC ROCK

CONSISTENCY CLASSIFICATION FOR SOILS
 According to the Standard Penetration Test

SPT N-Value (Blows/foot)	Consistency
0-4	Very Loose
5-10	Loose
11-30	Medium Dense
31-50	Dense
51-100	Very Dense
101-150	Very Stiff
151-200	Stiff
201-300	Very Stiff
301-400	Hard
401-500	Very Hard
>500	Very Hard

NOTE: Classification of earth material as shown on this sheet is based upon field inspection and is not to be construed to imply mechanical analysis.

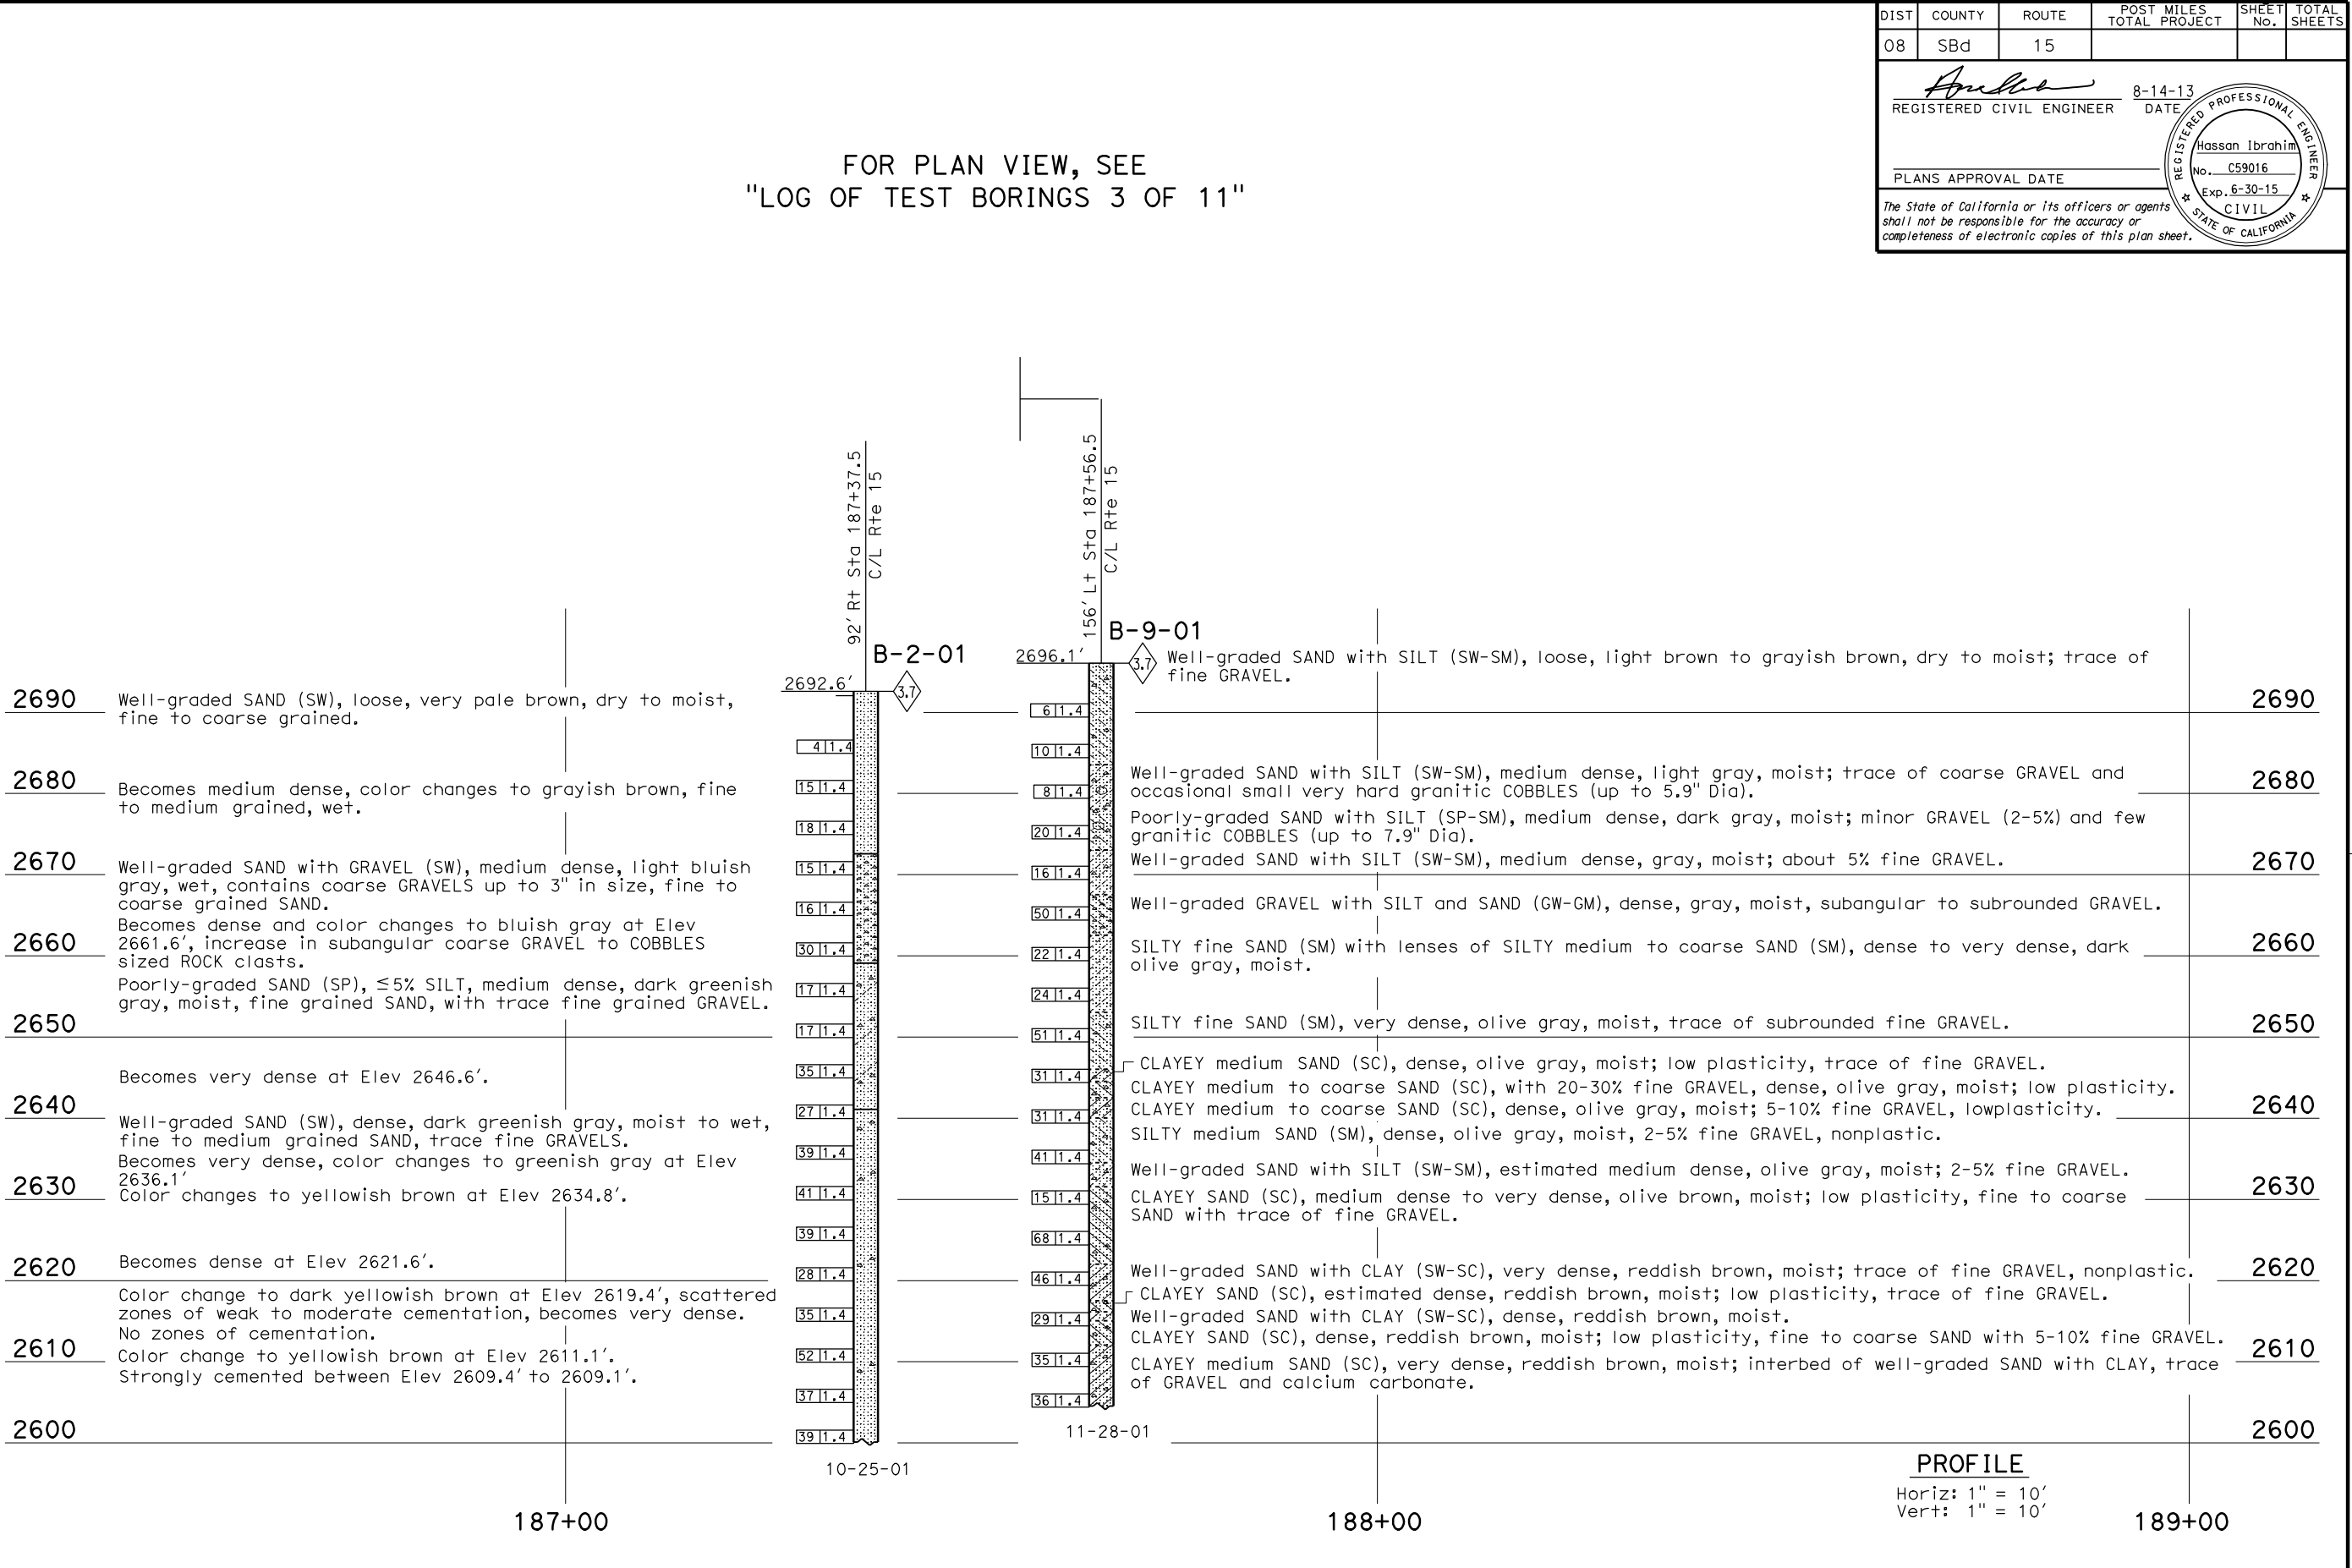

PROFILE
 Horiz: 1" = 10'
 Vert: 1" = 10'

ENGINEERING SERVICES	MATERIALS & GEOTECHNICAL SVCS	FIELD INVESTIGATION BY: E. Neupert, F. Gerami	STATE OF CALIFORNIA DEPARTMENT OF TRANSPORTATION	DIVISION OF ENGINEERING SERVICES STRUCTURE DESIGN DESIGN BRANCH X	BRIDGE NO. 54-0483 POST MILE 43.8	MOJAVE RIVER BRIDGE (WIDEN) LOG OF TEST BORINGS 5 OF 11
DRAWN BY I. G. Remmen	CHECKED BY A. Wardak					

DIST	COUNTY	ROUTE	POST MILES TOTAL PROJECT	SHEET No.	TOTAL SHEETS
08	SBd	15			

REGISTERED CIVIL ENGINEER *Hassan Ibrahim* DATE 8-14-13
 PLANS APPROVAL DATE _____
 No. C59016 Exp. 6-30-15
 CIVIL ENGINEER STATE OF CALIFORNIA
 The State of California or its officers or agents shall not be responsible for the accuracy or completeness of electronic copies of this plan sheet.

FOR PLAN VIEW, SEE
"LOG OF TEST BORINGS 3 OF 11"

LEGEND OF BORING OPERATIONS


2 1/4" CONE PENETROMETER
 SAMPLE BORING (DRY)
 ROTARY SAMPLE BORING (WET)
 AUGER BORING (DRY)
 TEST PIT
 DIAMOND CORE BORING
 JET BORING
 ELECTRONIC CONE PENETROMETER

LEGEND OF EARTH MATERIALS
 GRAVEL
 SAND
 SILT
 CLAY
 SANDY CLAY or CLAYEY SAND
 SILTY SAND
 SILTY CLAY
 CLAYEY SILT
 GRANITIC MAFIC
 COBBLES and/or BOULDERS
 LENTICULAR ROCK
 SEDIMENTARY ROCK
 METAMORPHIC

CONSISTENCY CLASSIFICATION FOR SOILS
 According to the Standard Penetration Test

SPT N ₆₀ (Blows/foot)	Consistency
0-4	Very Loose
5-10	Loose
11-30	Medium Dense
31-50	Dense
51-70	Very Dense
71-90	Very Dense
91-110	Very Dense
2571-2590	Very Dense

NOTE: Classification of earth material as shown on this sheet is based upon field inspection and is not to be construed to imply mechanical analysis.

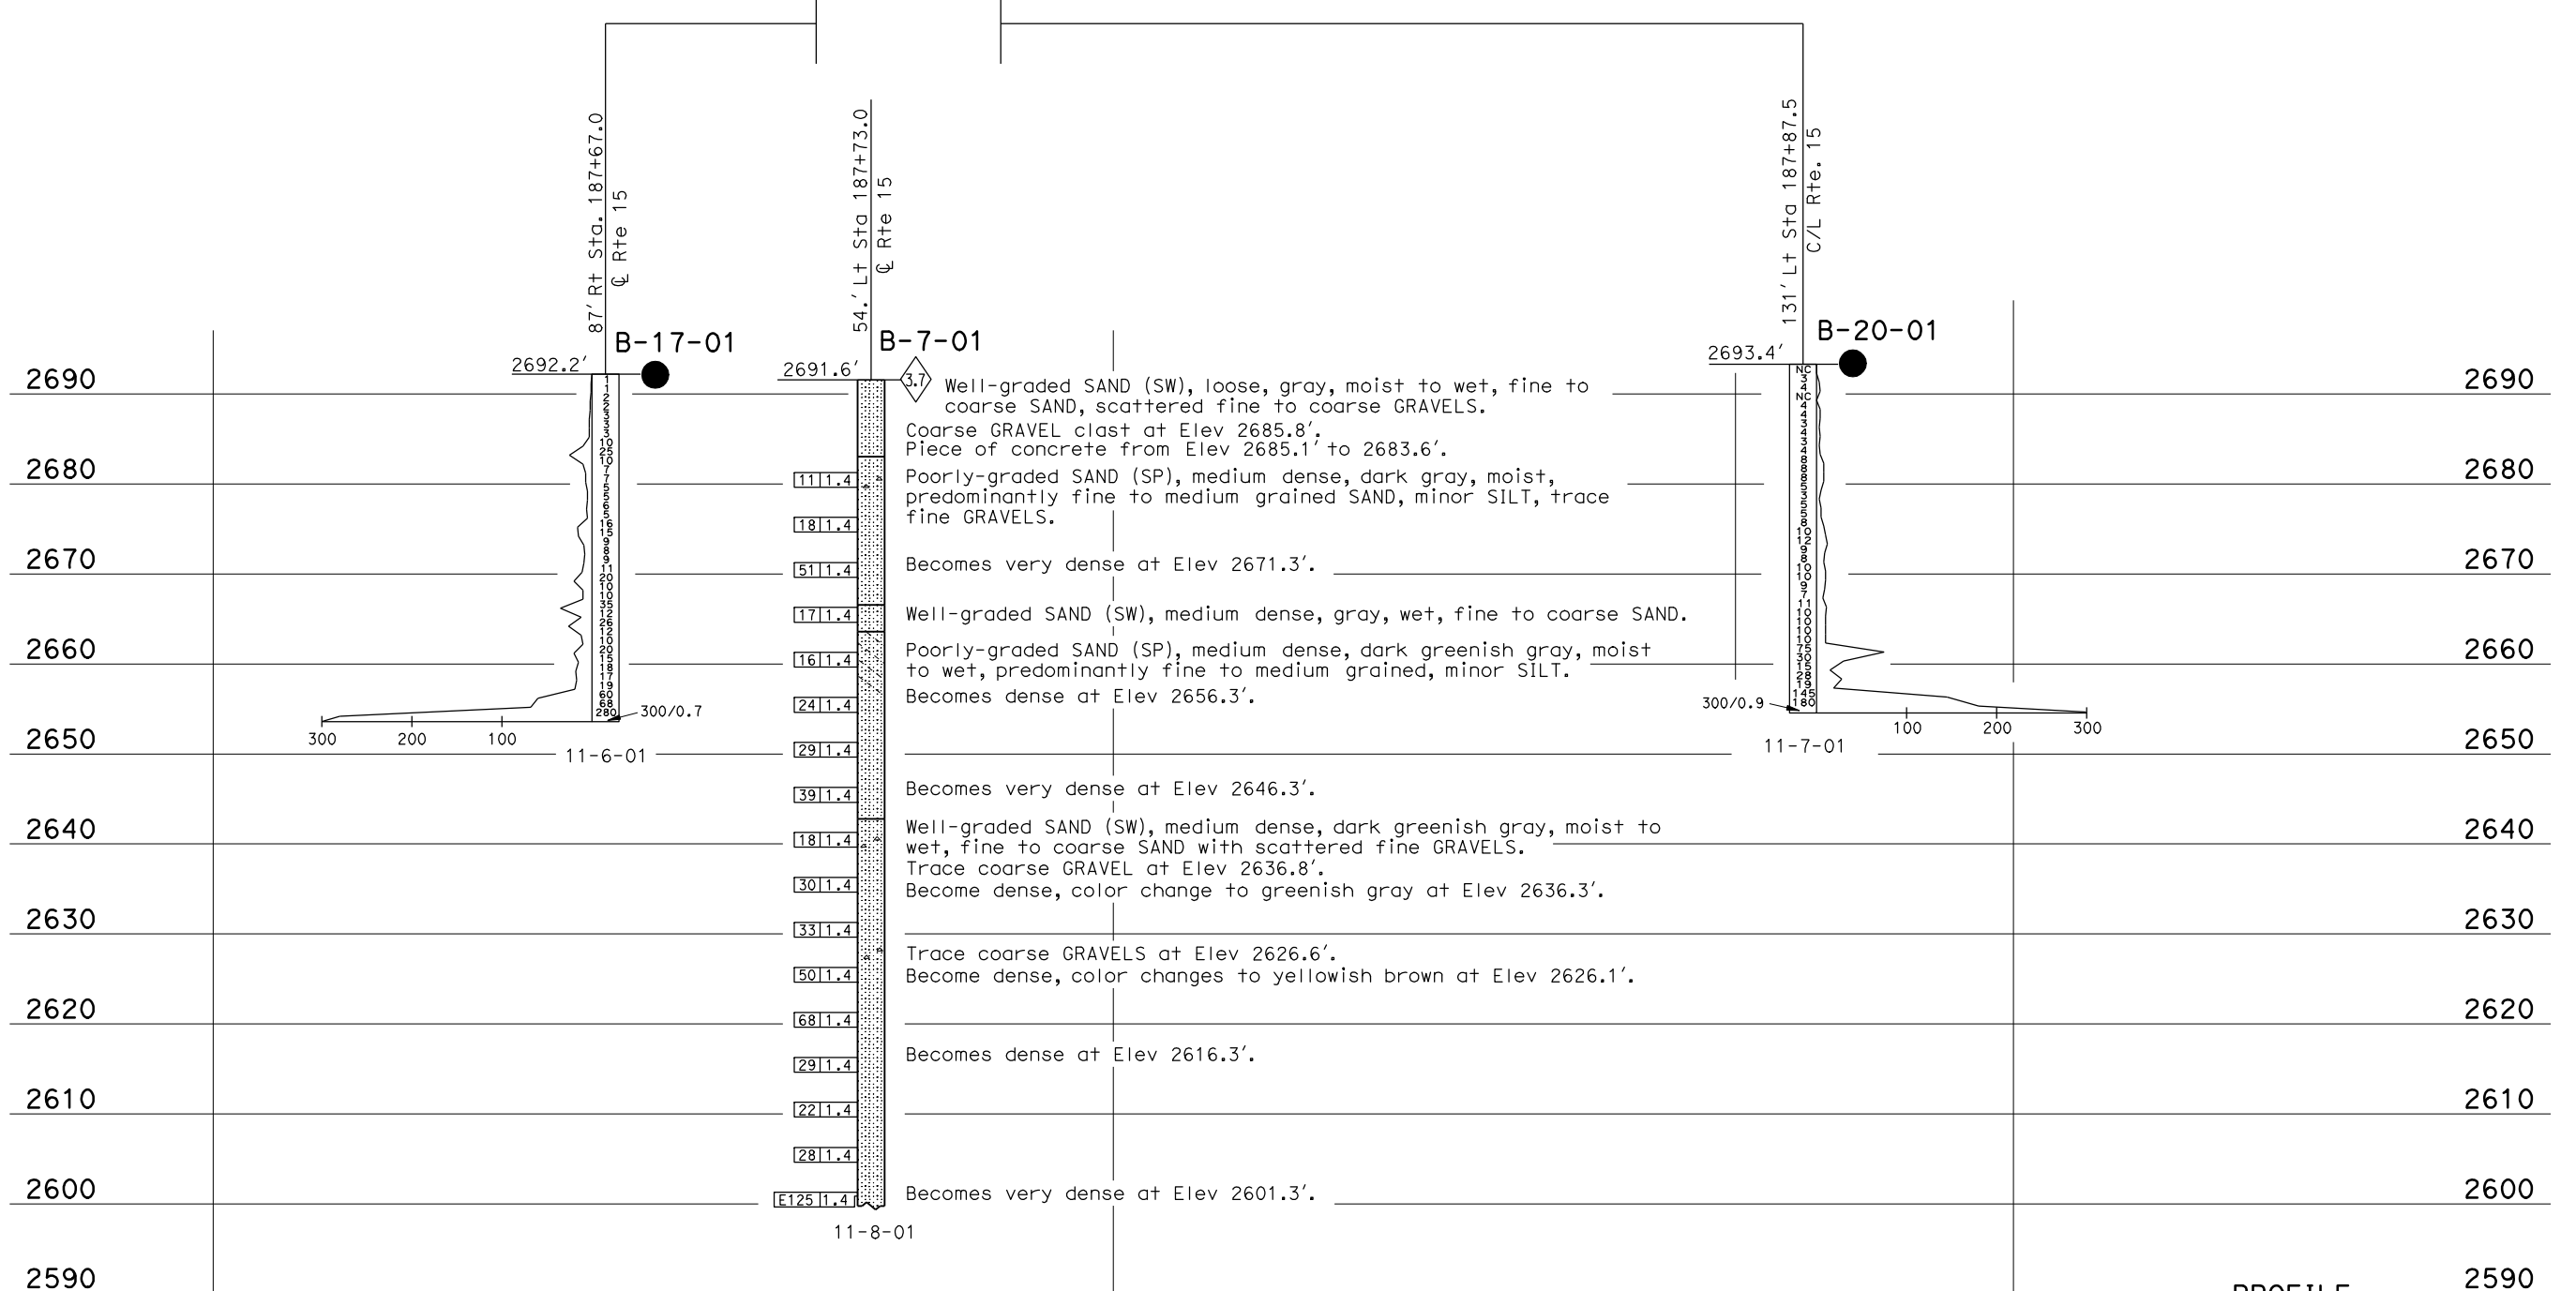

ENGINEERING SERVICES	MATERIALS & GEOTECHNICAL SVCS	FIELD INVESTIGATION BY: E. Neupert, F. Gerami	STATE OF CALIFORNIA DEPARTMENT OF TRANSPORTATION	DIVISION OF ENGINEERING SERVICES STRUCTURE DESIGN DESIGN BRANCH X	BRIDGE NO. 54-0483 POST MILE 43.8	MOJAVE RIVER BRIDGE (WIDEN) LOG OF TEST BORINGS 6 OF 11
DRAWN BY I. G. Remmen	CHECKED BY A. Wardak				CONTRACT NO.: 08-355561	REVISION DATES 08-07-13

USERNAME => s116982 DATE PLOTTED => 14-AUG-2013 TIME PLOTTED => 11:40



DIST	COUNTY	ROUTE	POST MILES TOTAL PROJECT	SHEET No.	TOTAL SHEETS
08	SBd	15			

REGISTERED CIVIL ENGINEER *Hassan Ibrahim* DATE 8-14-13
 No. C59016 Exp. 6-30-15
 CIVIL ENGINEER STATE OF CALIFORNIA

PLANS APPROVAL DATE _____

The State of California or its officers or agents shall not be responsible for the accuracy or completeness of electronic copies of this plan sheet.

FOR PLAN VIEW, SEE
"LOG OF TEST BORINGS 3 OF 11"

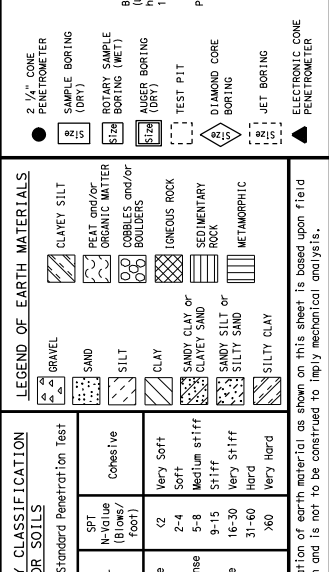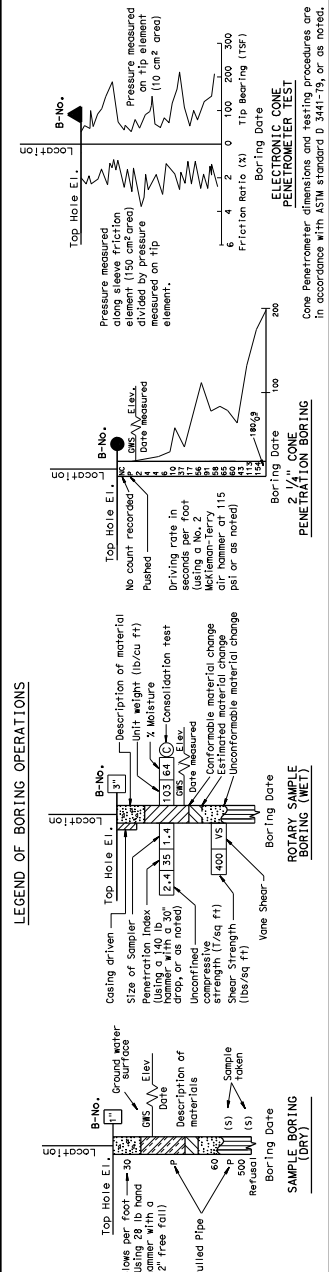


CONSISTENCY CLASSIFICATION FOR SOILS

According to the Standard Penetration Test

SPT N ₆₀ (Blows/foot)	Cohesive	
	Granular	Coarse
0-4	Very Loose	Very Soft
5-10	Loose	Soft
11-30	Medium Dense	Medium Stiff
31-50	Dense	Stiff
51-70	Very Dense	Very Stiff
71-90		Hard
91-110		Very Hard
111-130		>60

NOTE: Classification of earth material as shown on this sheet is based upon field inspection and is not to be construed to imply mechanical analysis.

2690	Well-graded SAND (SW), loose, gray, moist to wet, fine to coarse SAND.
2680	Poorly-graded SAND (SP), loose, dark gray, moist to wet, predominantly fine grained with some medium grained SAND. Well-graded SAND (SW), medium dense, gray, moist to wet, fine to coarse SAND with trace fine to coarse GRAVELS.
2670	Becomes dense at Elev 2665.6'.
2660	Poorly-graded SAND (SP), medium dense, dark greenish gray, wet, predominantly fine to medium grained with trace coarse SAND.
2650	Minor amount of SILT content at Elev 2655.6'.
2640	Becomes very dense at Elev 2645.6', trace coarse GRAVEL.
2630	Becomes dense at Elev 2640.6'.
2620	Color changes to dark yellowish brown at Elev 2629.6'. Becomes very dense at Elev 2625.6'.
2610	Well-graded SAND (SW), dense, yellowish brown, moist to wet, fine to coarse SAND, trace fine GRAVELS.
2600	Poorly-graded SAND (SP), medium dense, yellowish brown, moist to wet, predominantly fine to medium grained. Becomes dense at Elev 2610.6'.
2590	Trace fine GRAVELS at Elev 2604.1'.

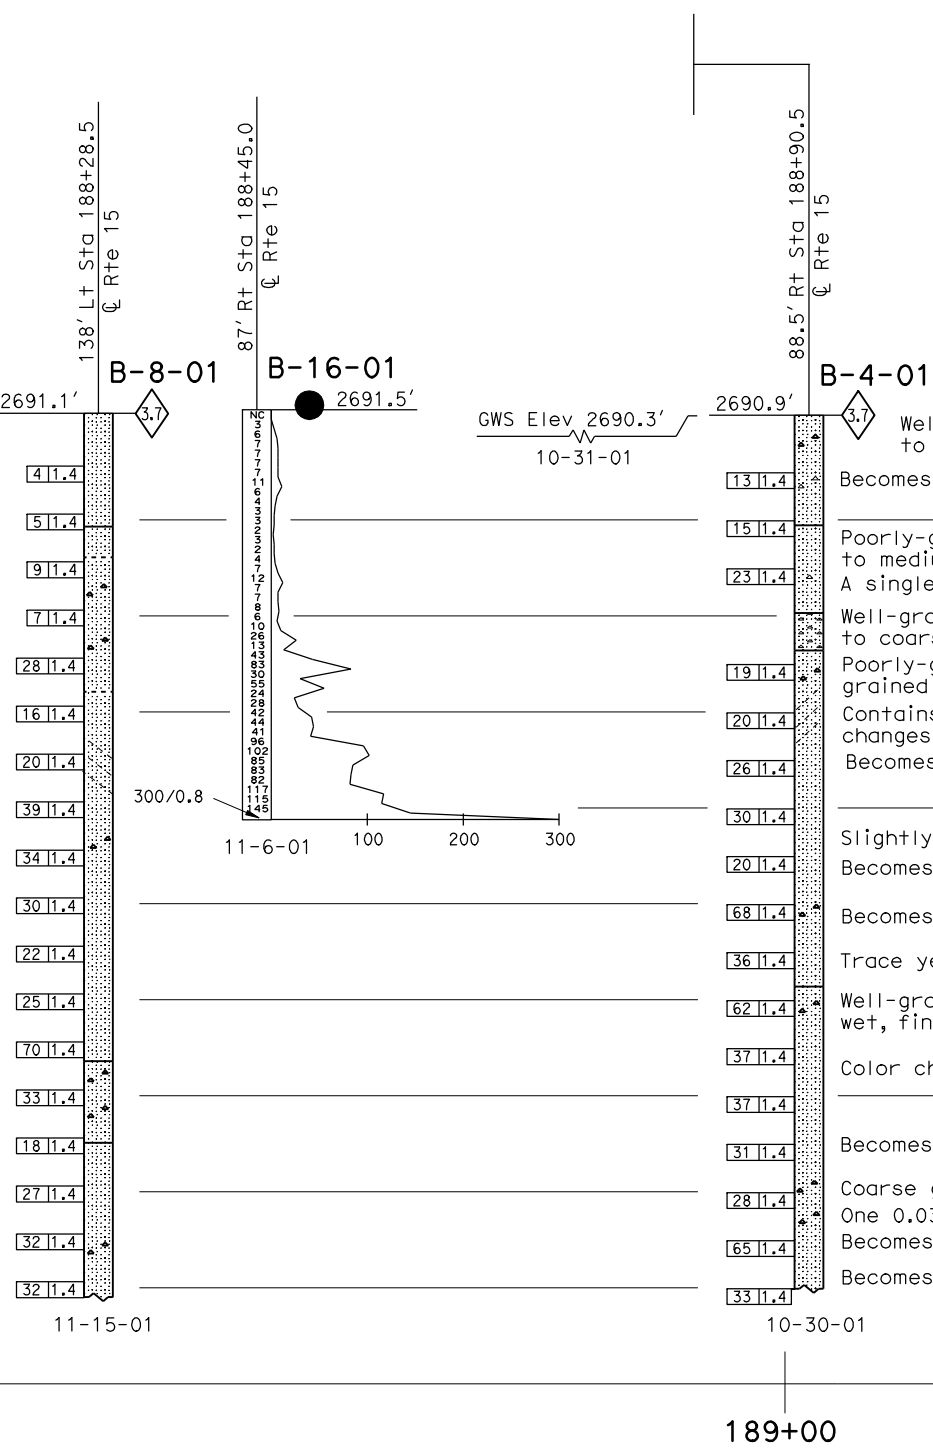

ENGINEERING SERVICES	MATERIALS & GEOTECHNICAL SVCS
DRAWN BY: I. G. Remmen	CHECKED BY: A. Wardak

FIELD INVESTIGATION BY:
E. Neupert, F. Gerami

STATE OF CALIFORNIA
DEPARTMENT OF TRANSPORTATION

DIVISION OF ENGINEERING SERVICES
STRUCTURE DESIGN
DESIGN BRANCH X

BRIDGE NO. 54-0483
POST MILE 43.8

MOJAVE RIVER BRIDGE (WIDEN)
LOG OF TEST BORINGS 7 OF 11

USERNAME => s116982 DATE PLOTTED => 14-AUG-2013 TIME PLOTTED => 11:40

DIST	COUNTY	ROUTE	POST MILES TOTAL PROJECT	SHEET No.	TOTAL SHEETS
08	SBD	15			

REGISTERED CIVIL ENGINEER *Hassan Ibrahim* DATE 8-14-13
 PLANS APPROVAL DATE _____
 No. C59016 Exp. 6-30-15
 CIVIL STATE OF CALIFORNIA
 The State of California or its officers or agents shall not be responsible for the accuracy or completeness of electronic copies of this plan sheet.

FOR PLAN VIEW, SEE "LOG OF TEST BORINGS 3 OF 11"

LEGEND OF BORING OPERATIONS

2 1/4" CONE PENETROMETER


LEGEND OF EARTH MATERIALS

CONSISTENCY CLASSIFICATION FOR SOILS

According to the Standard Penetration Test

SPN No. (Blows/foot)	Consistency
0-4	Very Loose
5-10	Loose
11-30	Medium Dense
31-50	Dense
51-70	Very Dense
71-90	Very Dense
91-110	Very Dense
2571-2590	Very Dense

NOTE: Classification of earth material as shown on this sheet is based upon field inspection and is not to be construed to imply mechanical analysis.

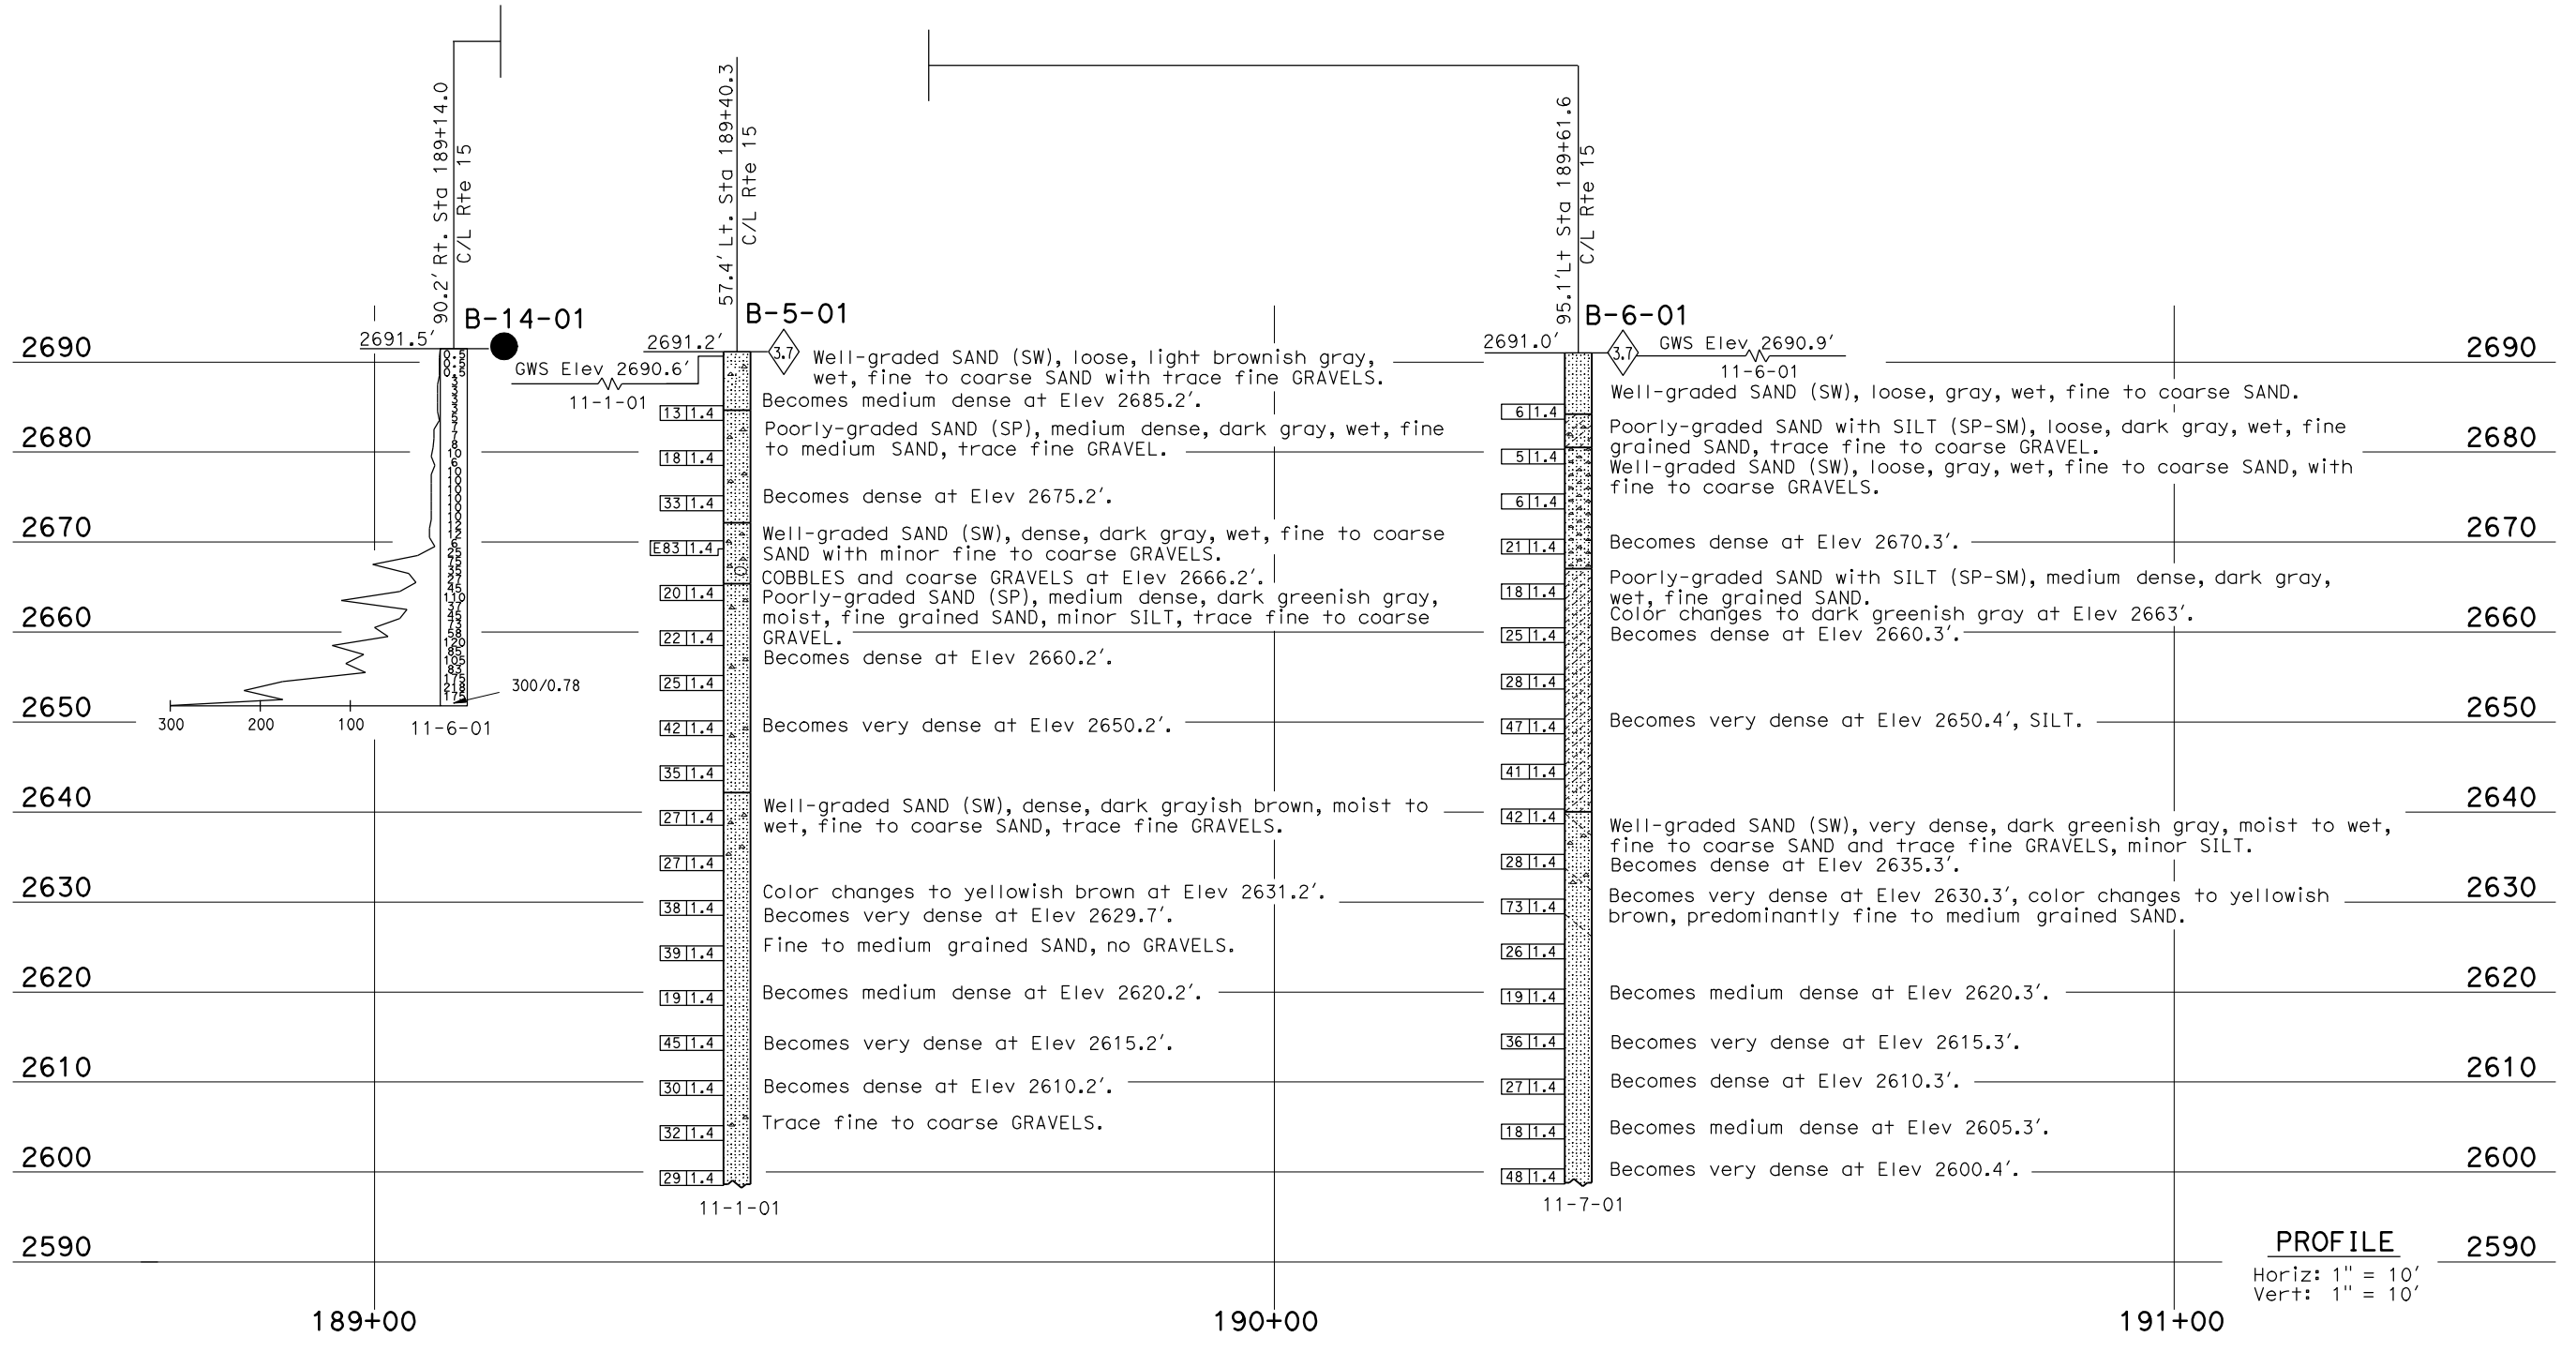

ENGINEERING SERVICES	MATERIALS & GEOTECHNICAL SVCS	FIELD INVESTIGATION BY: E. Neupert, F. Gerami	STATE OF CALIFORNIA DEPARTMENT OF TRANSPORTATION	DIVISION OF ENGINEERING SERVICES STRUCTURE DESIGN DESIGN BRANCH X	BRIDGE NO. 54-0483 POST MILE 43.8	MOJAVE RIVER BRIDGE (WIDEN) LOG OF TEST BORINGS 8 OF 11
DRAWN BY I. G. Remmen	CHECKED BY A. Wardak					

DIST	COUNTY	ROUTE	POST MILES TOTAL PROJECT	SHEET No.	TOTAL SHEETS
08	SBd	15			

REGISTERED CIVIL ENGINEER *Hassan Ibrahim* 8-14-13 DATE
 PLANS APPROVAL DATE
 No. C59016
 Exp. 6-30-15
 CIVIL
 STATE OF CALIFORNIA
 The State of California or its officers or agents shall not be responsible for the accuracy or completeness of electronic copies of this plan sheet.

FOR PLAN VIEW, SEE
"LOG OF TEST BORINGS 3 OF 11"

LEGEND OF BORING OPERATIONS

2 1/4" CONE PENETROMETER

3/8" SAMPLE BORING (DRY)

1 1/2" AUGER BORING (WET)

TEST PIT

DIAMOND CORE BORING

JET BORING

ELECTRONIC CONE PENETROMETER


LEGEND OF EARTH MATERIALS

CONSISTENCY CLASSIFICATION FOR SOILS

According to the Standard Penetration Test

SPN No. (Blows/foot)	Consistency
0-4	Very Loose
5-10	Loose
11-30	Medium Dense
31-50	Dense
51-70	Very Dense
71-90	Very Hard
91-110	Extremely Hard

NOTE: Classification of earth material as shown on this sheet is based upon field inspection and is not to be construed to imply mechanical analysis.

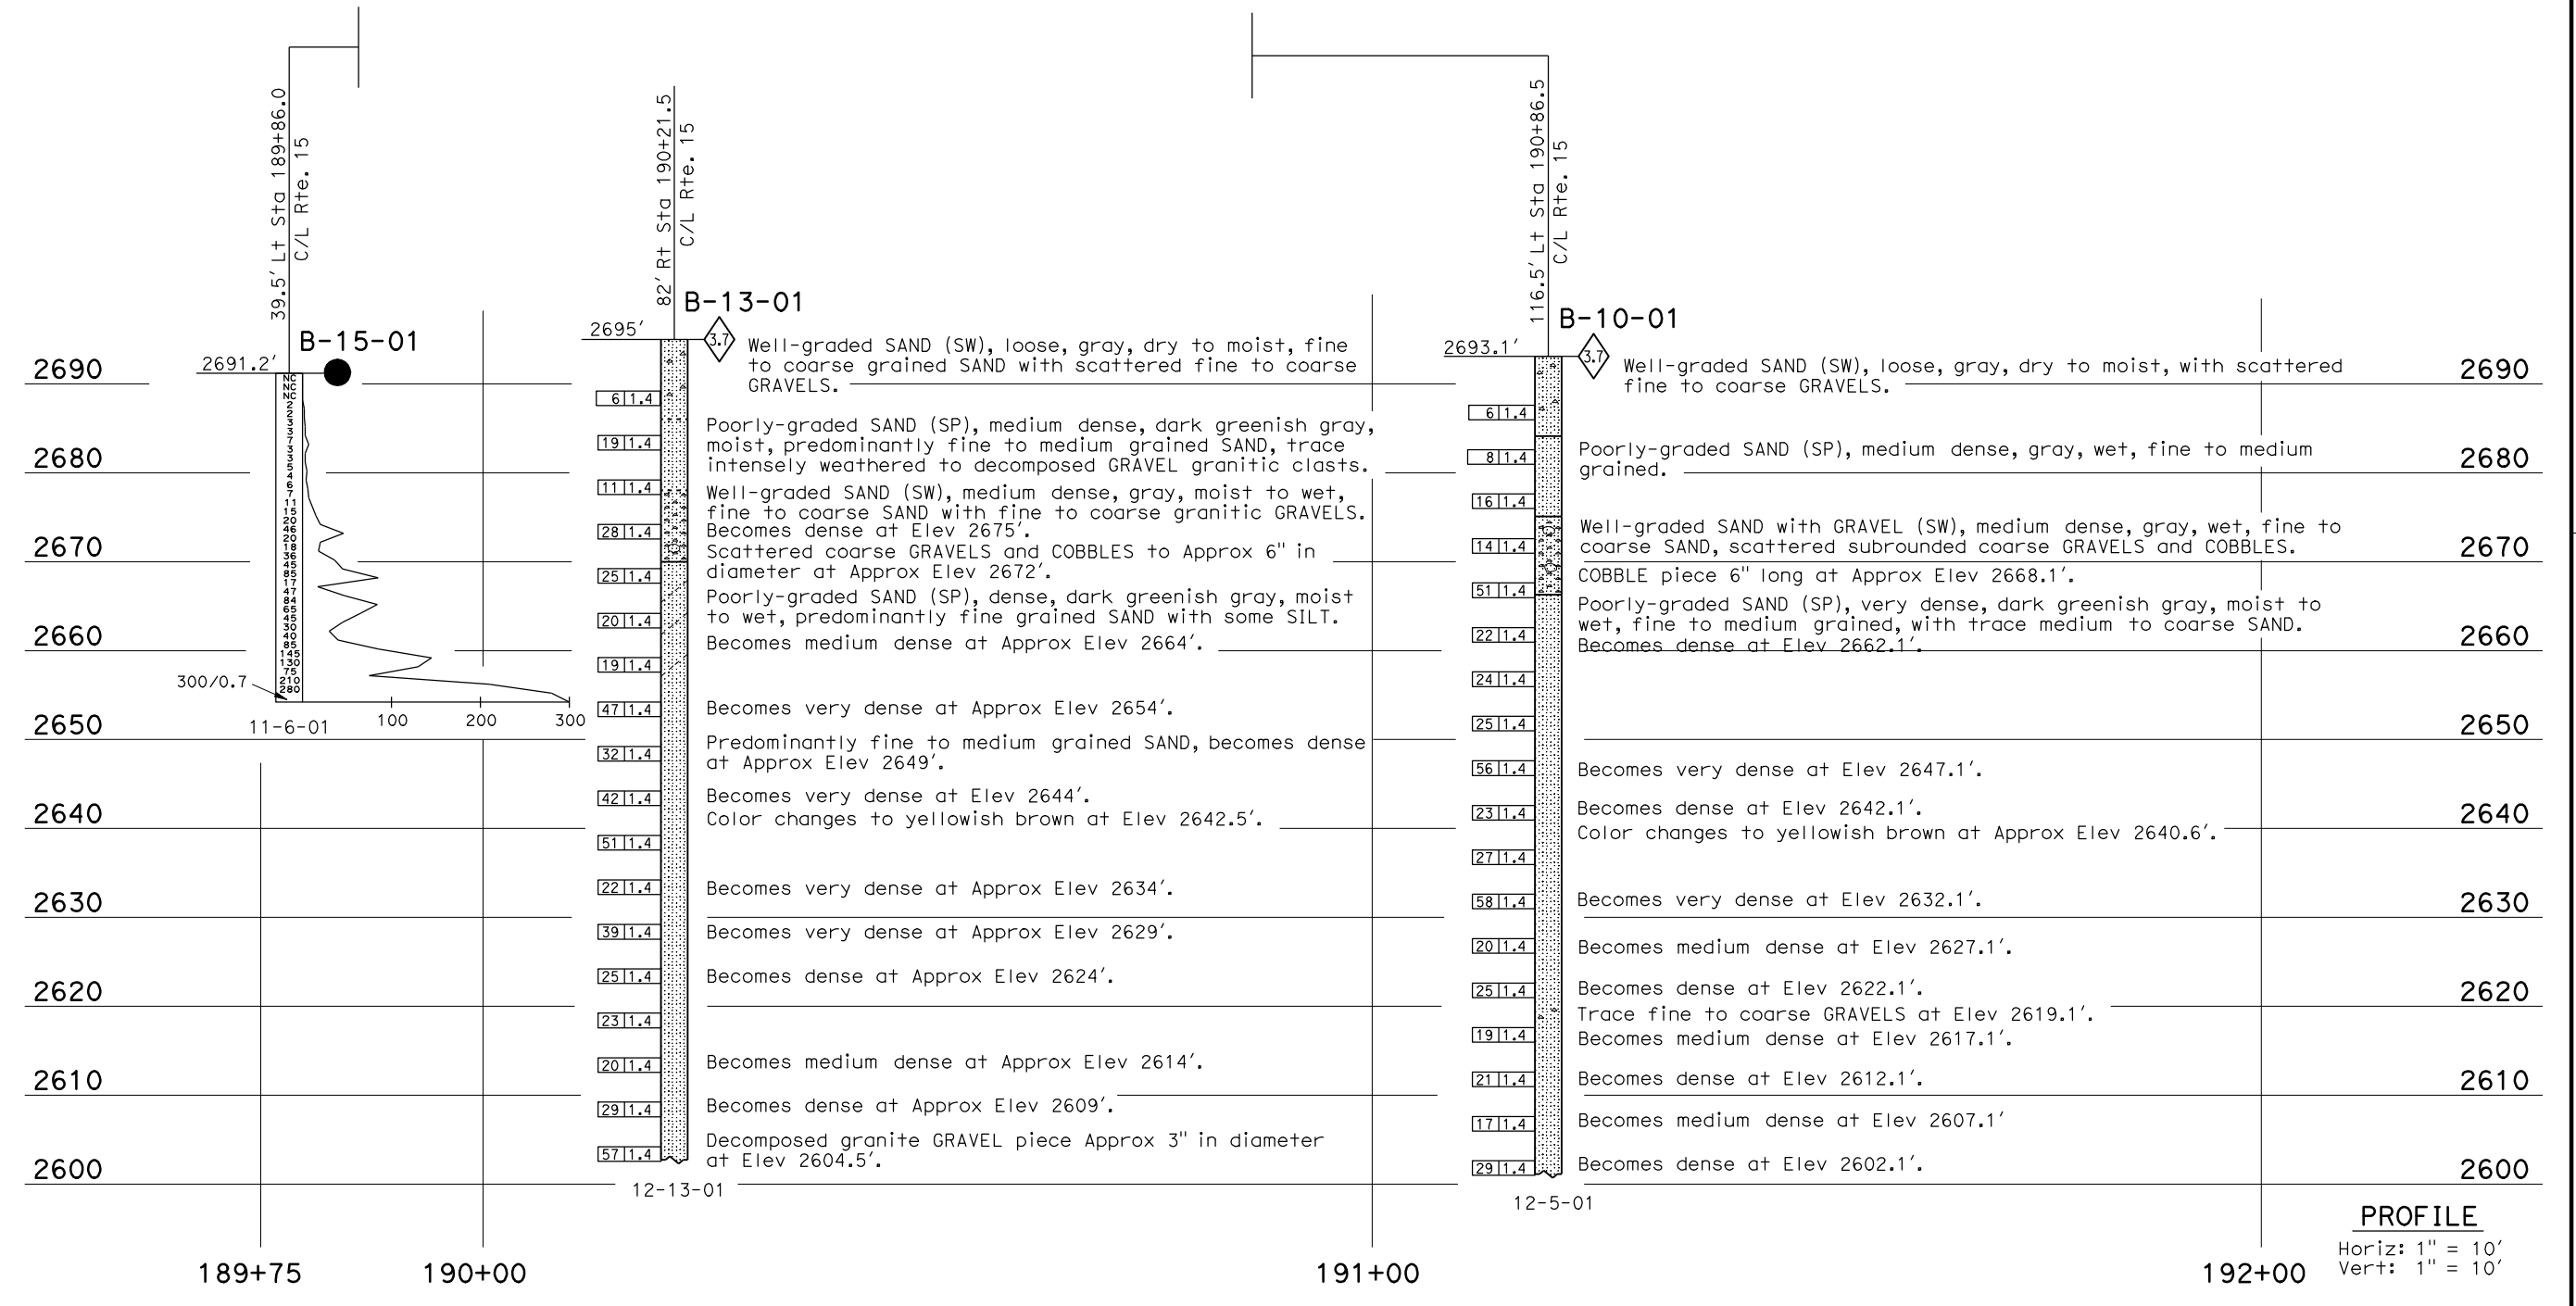

ENGINEERING SERVICES	MATERIALS & GEOTECHNICAL SVCS	FIELD INVESTIGATION BY: E. Neupert, F. Gerami	STATE OF CALIFORNIA DEPARTMENT OF TRANSPORTATION	DIVISION OF ENGINEERING SERVICES STRUCTURE DESIGN DESIGN BRANCH X	BRIDGE NO. 54-0483 POST MILE 43.8	MOJAVE RIVER BRIDGE (WIDEN) LOG OF TEST BORINGS 9 OF 11
DRAWN BY I. G. Remmen	CHECKED BY A. Wardak					

DIST	COUNTY	ROUTE	POST MILES TOTAL PROJECT	SHEET No.	TOTAL SHEETS
08	SBd	15			

REGISTERED CIVIL ENGINEER *Hassan Ibrahim* DATE 8-14-13
 PLANS APPROVAL DATE _____
 No. C59016
 Exp. 6-30-15
 CIVIL
 STATE OF CALIFORNIA

The State of California or its officers or agents shall not be responsible for the accuracy or completeness of electronic copies of this plan sheet.

FOR PLAN VIEW, SEE "LOG OF TEST BORINGS 3 OF 11"

LEGEND OF BORING OPERATIONS

2 1/4" CONE PENETROMETER


LEGEND OF EARTH MATERIALS

CONSISTENCY CLASSIFICATION FOR SOILS

According to the Standard Penetration Test

SPN No. (Blows/foot)	Consistency
0-4	Very Loose
5-10	Loose
11-30	Medium Dense
31-50	Dense
51-70	Very Dense
71-90	Very Stiff
91-110	Stiff
111-130	Very Stiff
131-150	Hard
151-200	Very Hard
>200	>60

NOTE: Classification of earth material as shown on this sheet is based upon field inspection and is not to be construed to imply mechanical analysis.

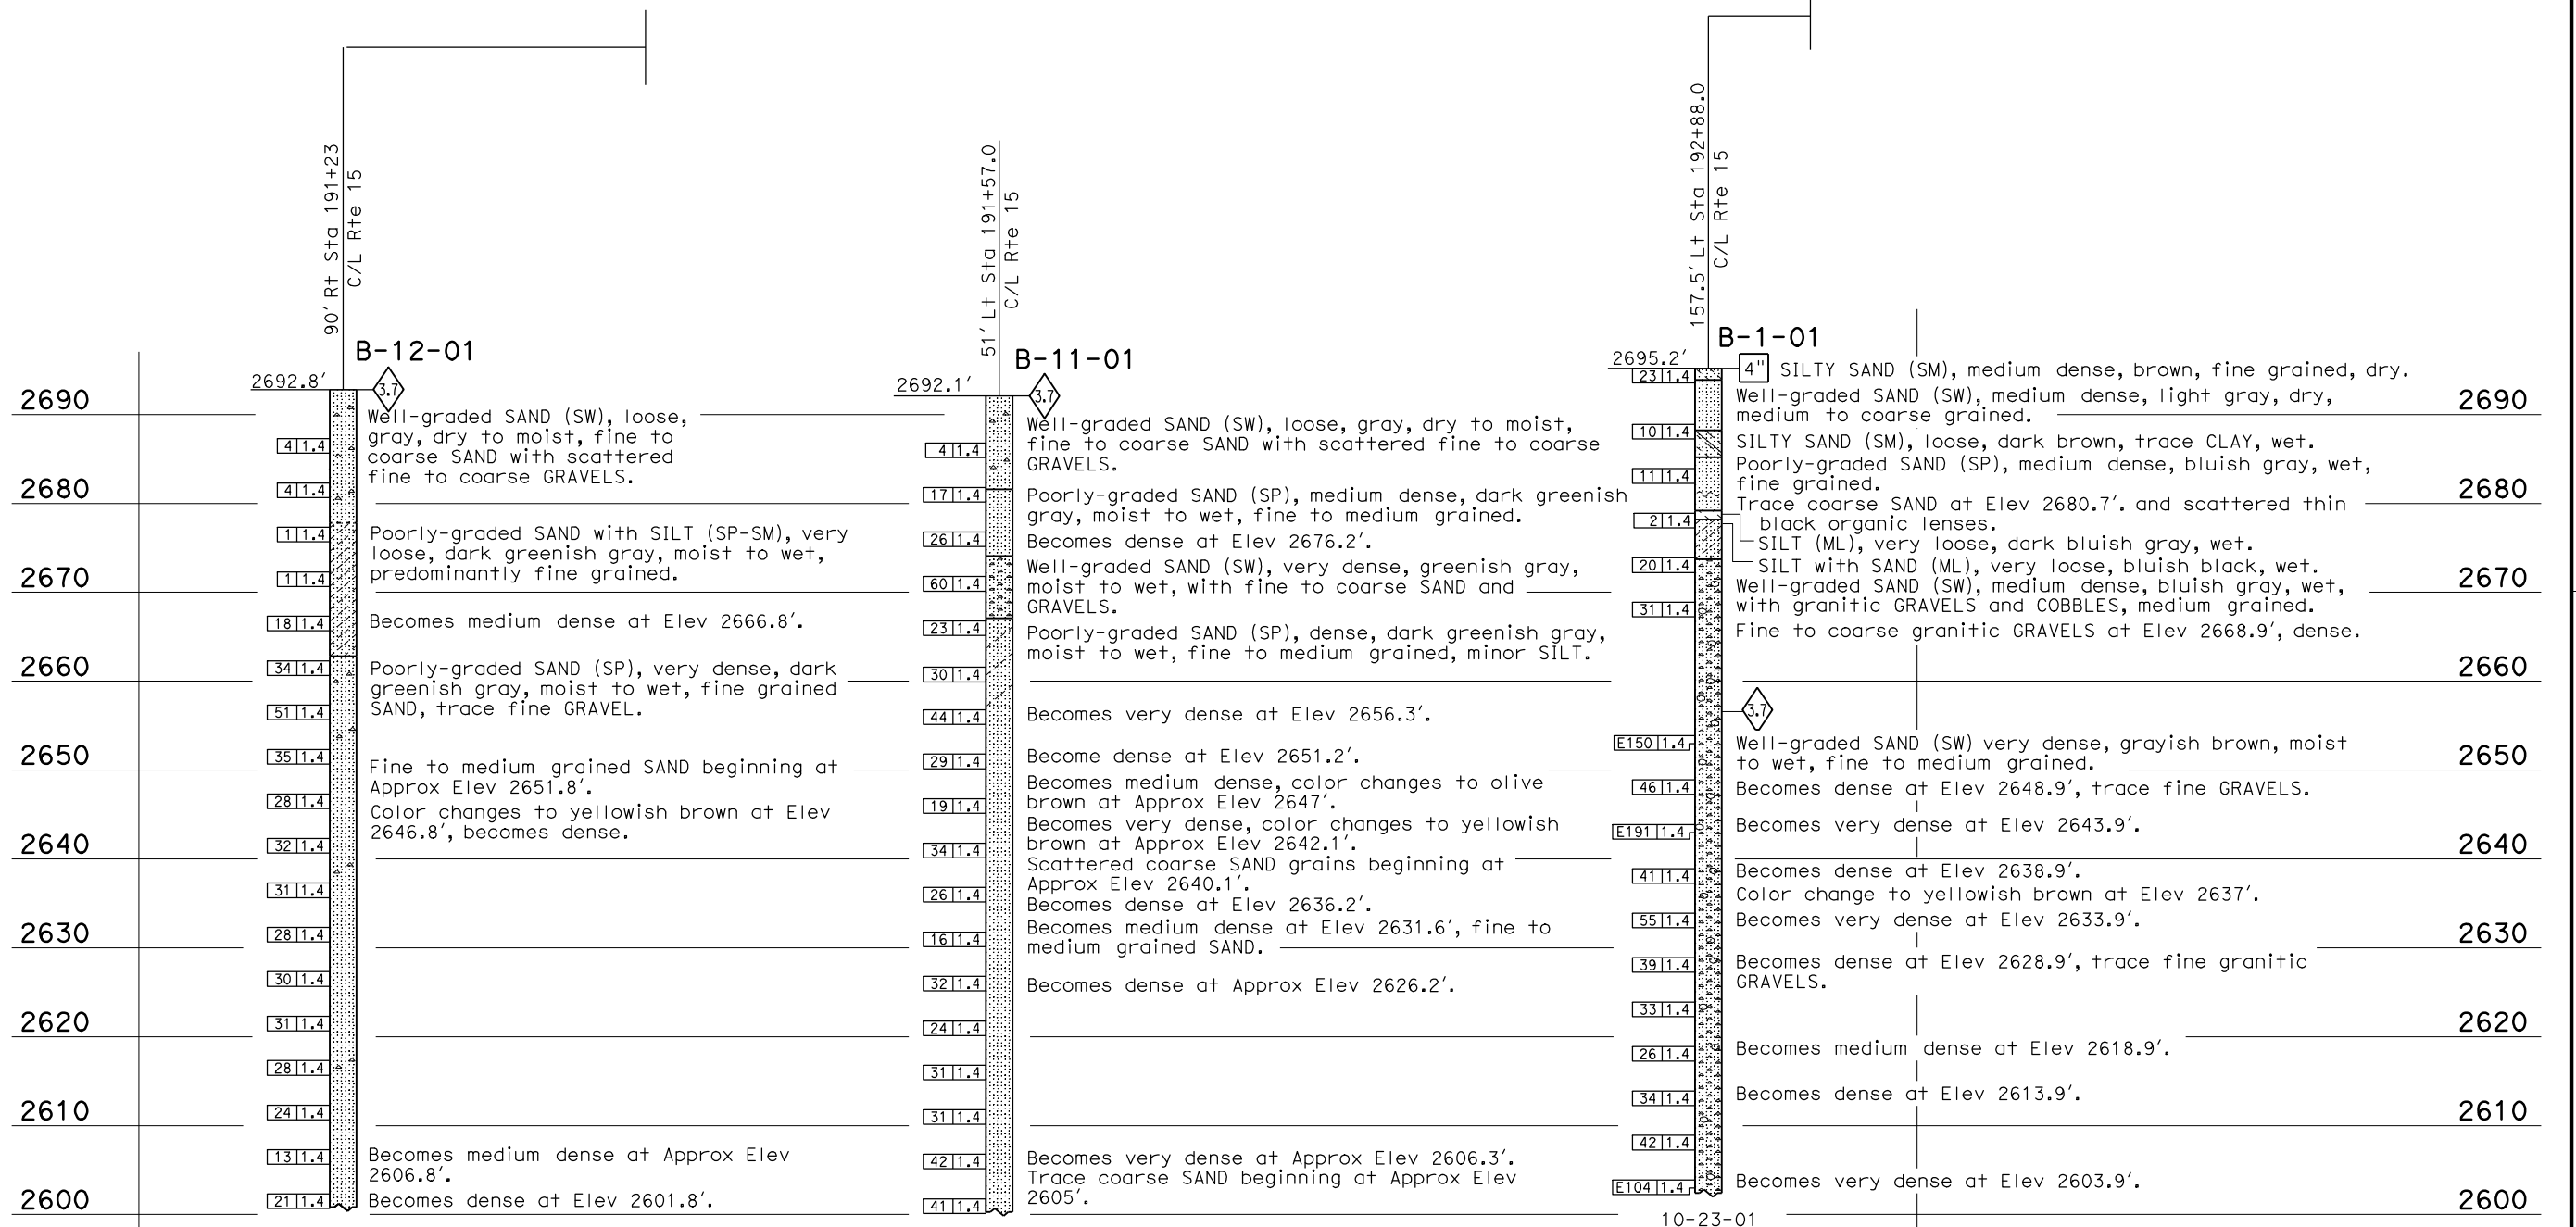


191+00	12-12-01	192+00	12-6-01	193+00	10-23-01
--------	----------	--------	---------	--------	----------

PROFILE
 Horiz: 1" = 10'
 Vert: 1" = 10'


ENGINEERING SERVICES	MATERIALS & GEOTECHNICAL SVCS	FIELD INVESTIGATION BY: E. Neupert, F. Gerami	STATE OF CALIFORNIA DEPARTMENT OF TRANSPORTATION	DIVISION OF ENGINEERING SERVICES STRUCTURE DESIGN DESIGN BRANCH X	BRIDGE NO. 54-0483 POST MILE 43.8	MOJAVE RIVER BRIDGE (WIDEN) LOG OF TEST BORINGS 10 OF 11
DRAWN BY I. G. Remmen	CHECKED BY A. Wardak					

FED. ROAD DIST. NO.	STATE	PROJ. NO.	SHEET NO.	TOTAL SHEETS
7	CAL.	54-483	44	44

15
 AS BUILT
 FEBRUARY 27, 1956

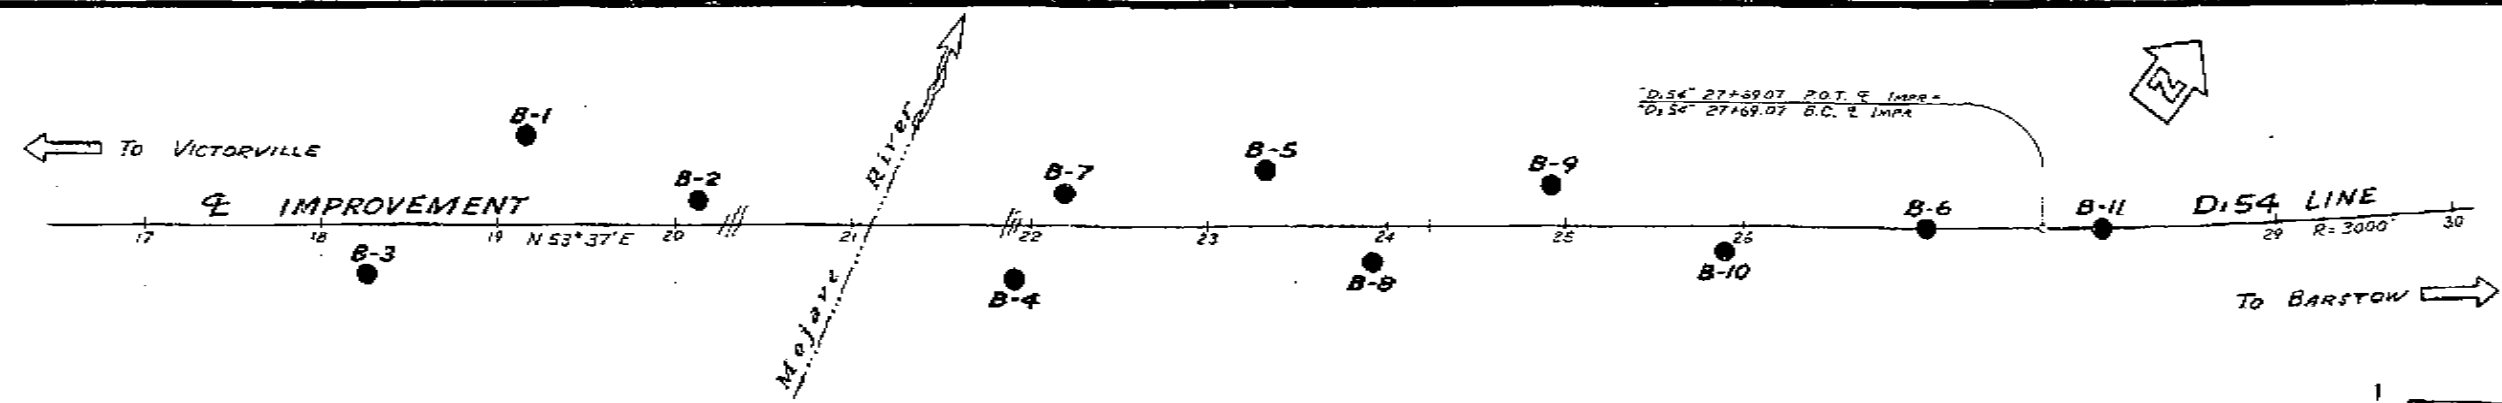

AS BUILT PLANS
 Contract No. 57-8VC12
 Date Completed
 Document No. 80000 790

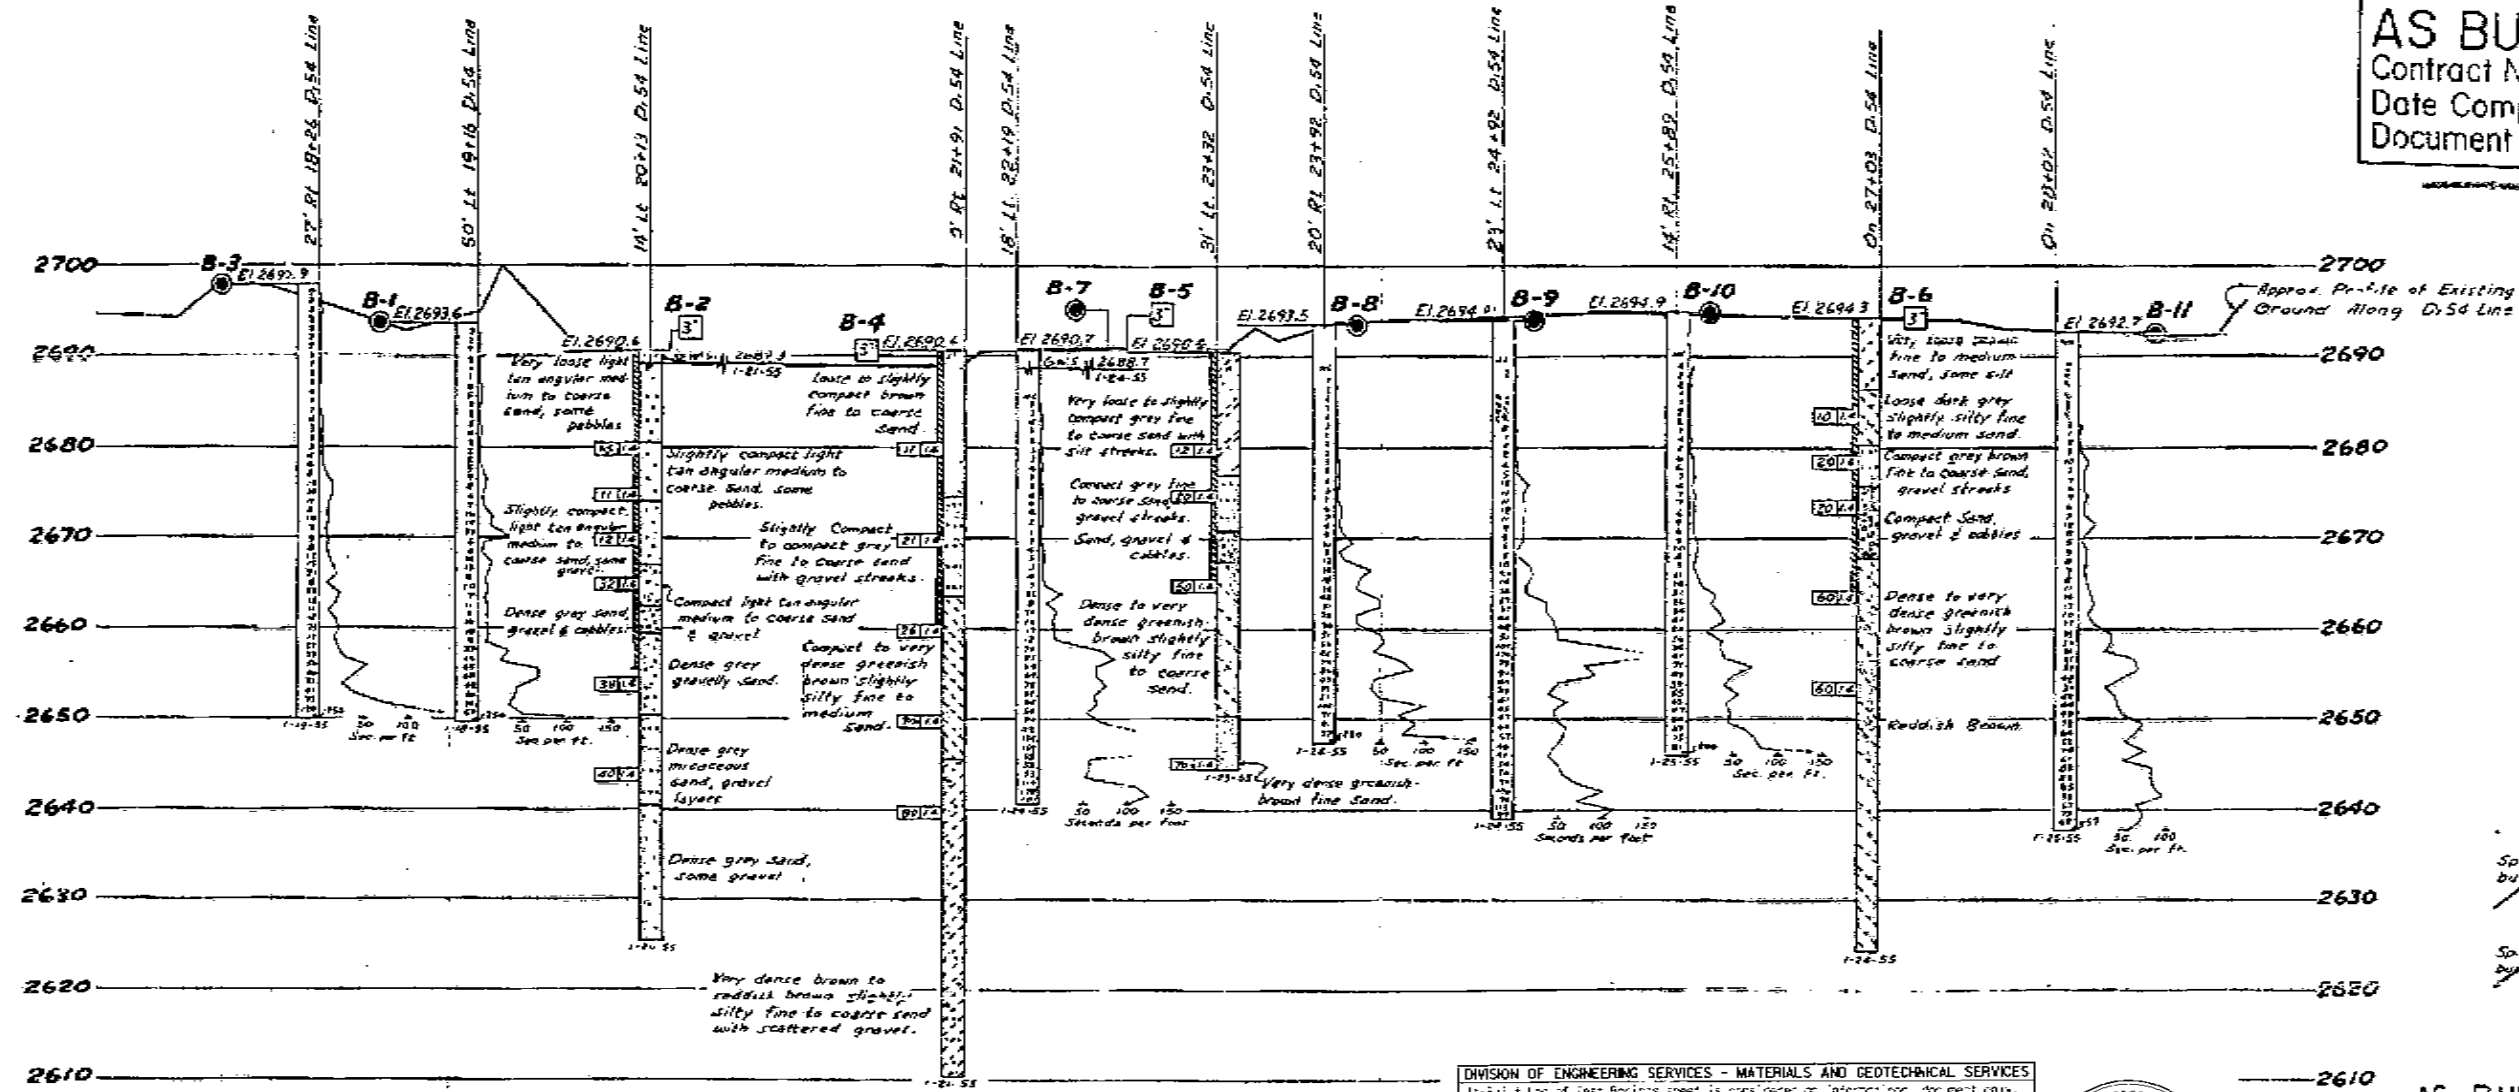


Test Boring By Bridge Dept.

BM D-54 2654
 Sp. Hd. Nail in 2x2 Rwd Hub
 buried 14" 70' D. 181718
 Elev. 2693.93


BM D-54 3044
 Sp. Hd. Nail in 2x2 Rwd Hub
 buried 18" 79' D. 24-54
 Elev. 2674.67

BRIDGE DEPARTMENT
 FIELD CHECKED BY: [Signature]
 CHECKED BY: [Signature]
 APPROVED BY: [Signature]

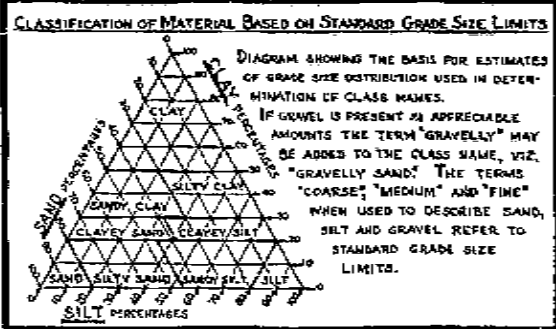

LEGEND OF EARTH MATERIALS

[Symbol] GRAVEL	[Symbol] SILTY CLAY OR CLAYEY SILT
[Symbol] SAND	[Symbol] PEAT AND/OR ORGANIC MATTER
[Symbol] SILT	[Symbol] FILL MATERIAL
[Symbol] CLAY	[Symbol] IGNEOUS ROCK
[Symbol] SANDY CLAY OR CLAYEY SAND	[Symbol] SEDIMENTARY ROCK
[Symbol] SANDY SILT OR SILTY SAND	[Symbol] METAMORPHIC ROCK

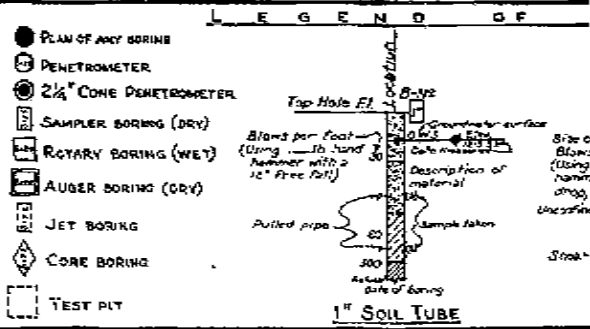

DIVISION OF ENGINEERING SERVICES - MATERIALS AND GEOTECHNICAL SERVICES

As-Built Log of Test Borings sheet is considered an informational document only. As such, the State of California registers on sheet with signature, license number and registration certificate and other data. This drawing is a true and accurate copy of the original document. It does not affect the liability of the City of the information contained in the original document. This drawing is available and presented only for the convenience of the contractor, contractor or other interested party.

DIST.	COUNTY	ROUTE	POST MILE-TOTAL PROJECT	Sheet of
DE	SEA	15		11

August 14, 2015
 DATE

MOJAVE RIVER BRIDGE (WIDEN)
LOG OF TEST BORINGS 11 OF 11

LN#1: 3643 CONTRACT NO. BRIDGE NO. 54-483
 PROJ. NO. & PHASE: 080200621 08-355561

AS-BUILT PERT DATUM: NGVD29 CONVERSION: NGVD29 + 2.7 FT Sheet of

NOTE: A COPY OF THIS LOG OF TEST BORINGS IS AVAILABLE AT OFFICE OF STRUCTURE MAINTENANCE AND INVESTIGATIONS, SACRAMENTO, CALIFORNIA



AS BUILT J.R.N.H. 1-7-58 BR REP

NOTES

The contractor's attention is directed to Section 2, Article (c) of the Standard Specifications and to the Special Provisions accompanying this set of plans. Classification of earth material as shown on this sheet is based upon field inspection and is not to be construed to imply mechanical analysis.

STATE OF CALIFORNIA
 DEPARTMENT OF PUBLIC WORKS
 DIVISION OF HIGHWAYS

MOJAVE RIVER BRIDGE

LOG OF TEST BORINGS

Notes 1"=50'
 SCALE 6x6 1"=10'

BRIDGE 54-483 FILE DRAWING C-4370-9

PREL. DRAWING NO. P. 4170 28/37 487

Stoddard Wells Road


NO TEST PILE SPECIFIED
 LOCATION - BENT #3 - RIGHT FOOTING - PILE NO. 21 - SEE FIELD BOOK NO. 2
 TYPE - CAST-IN-PLACE CONCRETE PILE ALTERNATIVE "W"
 HAMMER - VULCAN NO. 1
 DIAM. - 10" TIP & 16" BUTT
 ELEV. - CUT-OFF 2703.25 TIP 2690.2
 LOADS - DESIGN 45 TONS E.N.R. LOAD 82+ TONS

LENGTH -	MAX.	MIN.	AVE.
ABUT #1	28.2	26.8	27.5
BENT #2L	14.7	12.4	13.1
2R	13.3	12.8	13.0
BENT #3L	12.8	12.7	12.7
3R	13.4	11.5	12.9
BENT #4L	13.6	12.9	13.1
4R	12.6	11.6	12.3
ABUT #5	35.0	31.7	32.7

TOTAL - 691.9 L.F.
 ESTIMATE - 1350 L.F.

ATTEMPT WAS MADE TO DRIVE PILES THROUGH SOFTER AREA (B-2 & B-4) AT ELEV. 2690 ±, BUT PILES REACHED E.N.R. BEARING WELL BEFORE MIN. PENETRATION.


PENETR	BLOWS/FT
1	3
2	9
3	16
4	23
5	28
6	30
7	32
8	38
9	47
10	54
11	85
12	109
13	111

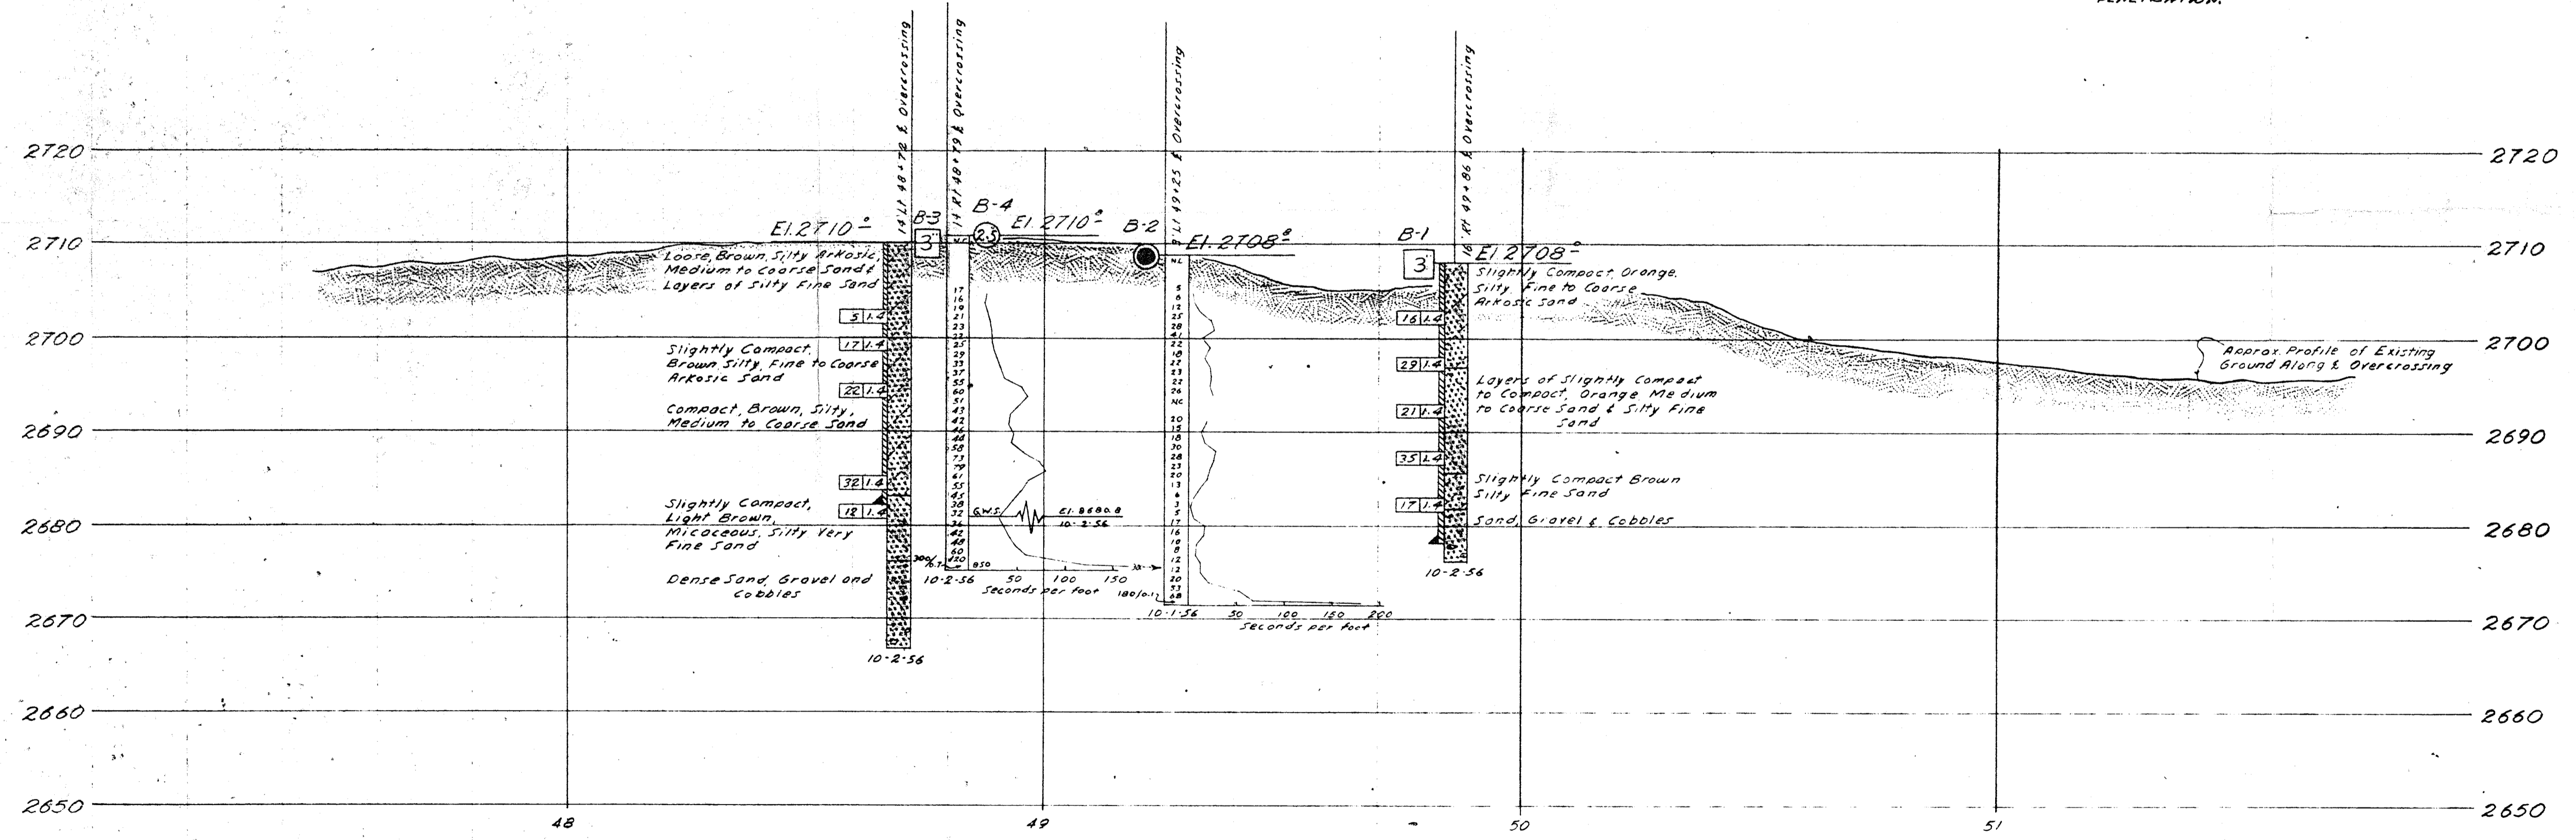

B.M. #5A-54
 Set 2"x2" Rwd. Hub & Sc. Hd.
 on Bur. 1:27.9 = E.P. Imp. 44+00
 Elev. 2691.66

BRIDGE DEPARTMENT

FIELD STUDY 10-8-56
 DRAWN BY D. J. B. 10-4-56
 CHECKED BY C. J. B. 10-11-56
 Approved Recommended by *[Signature]*
 Chief Engineer, Highway Division

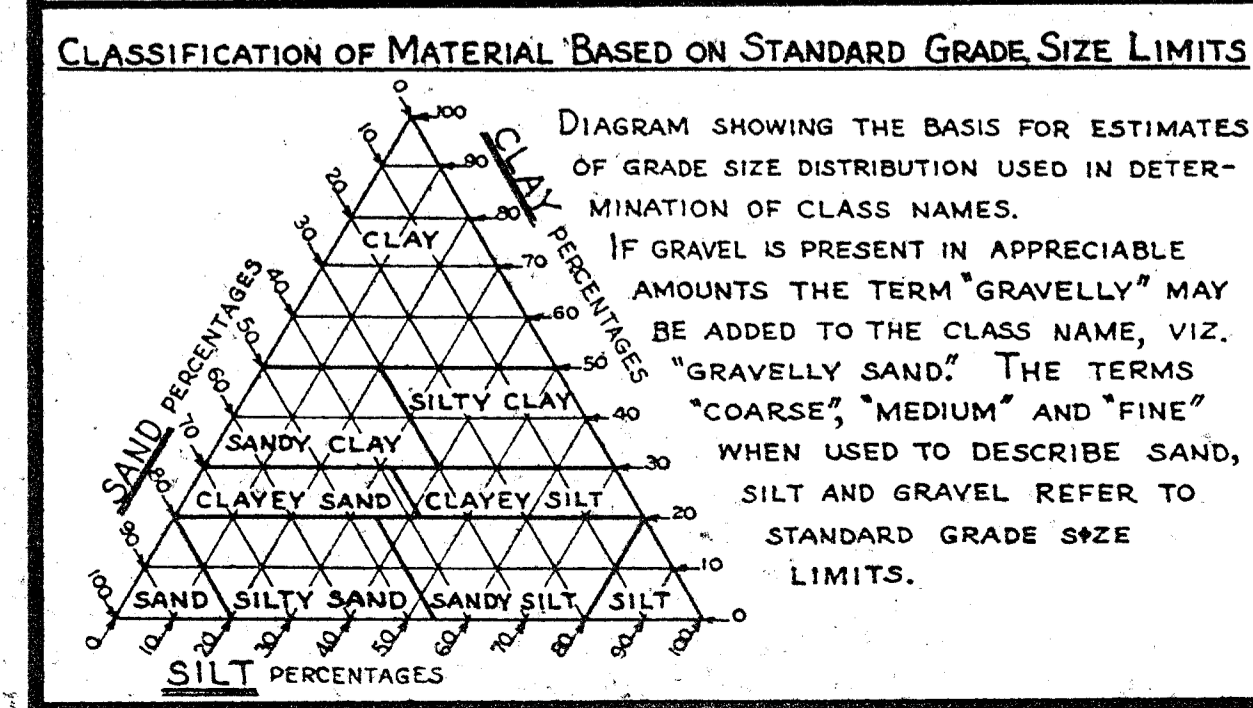

LEGEND OF EARTH MATERIALS

GRAVEL	SILTY CLAY OR CLAYEY SILT
SAND	PEAT AND/OR ORGANIC MATTER
SILT	FILL MATERIAL
CLAY	IGNEOUS ROCK
SANDY CLAY OR CLAYEY SAND	SEDIMENTARY ROCK
SANDY SILT OR SILTY SAND	METAMORPHIC ROCK

LEGEND OF BORING OPERATIONS

- PLAN OF ANY BORING
- PENETROMETER
- 2 1/2" CONE PENETROMETER
- SAMPLER BORING (DRY)
- ROTARY BORING (WET)
- AUGER BORING (DRY)
- JET BORING
- CORE BORING
- TEST PIT

1" SOIL TUBE

ROTARY BORING

PENETRATION BORING

NOTES

The contractor's attention is directed to Section 2, Article (c) of the Standard Specifications and to the Special Provisions accompanying this set of plans. Classification of earth material as shown on this sheet is based upon field inspection and is not to be construed to imply mechanical analysis.

STATE OF CALIFORNIA
 DEPARTMENT OF PUBLIC WORKS
 DIVISION OF HIGHWAYS

STODDARD WELLS RD. OVERCROSSING


LOG OF TEST BORINGS

Horizontal Scale 1" = 20'
 Vertical Scale 1" = 10'

BRIDGE 54-535 FILE 59 DRAWING C-5224-11

121

Cement Company Road UC

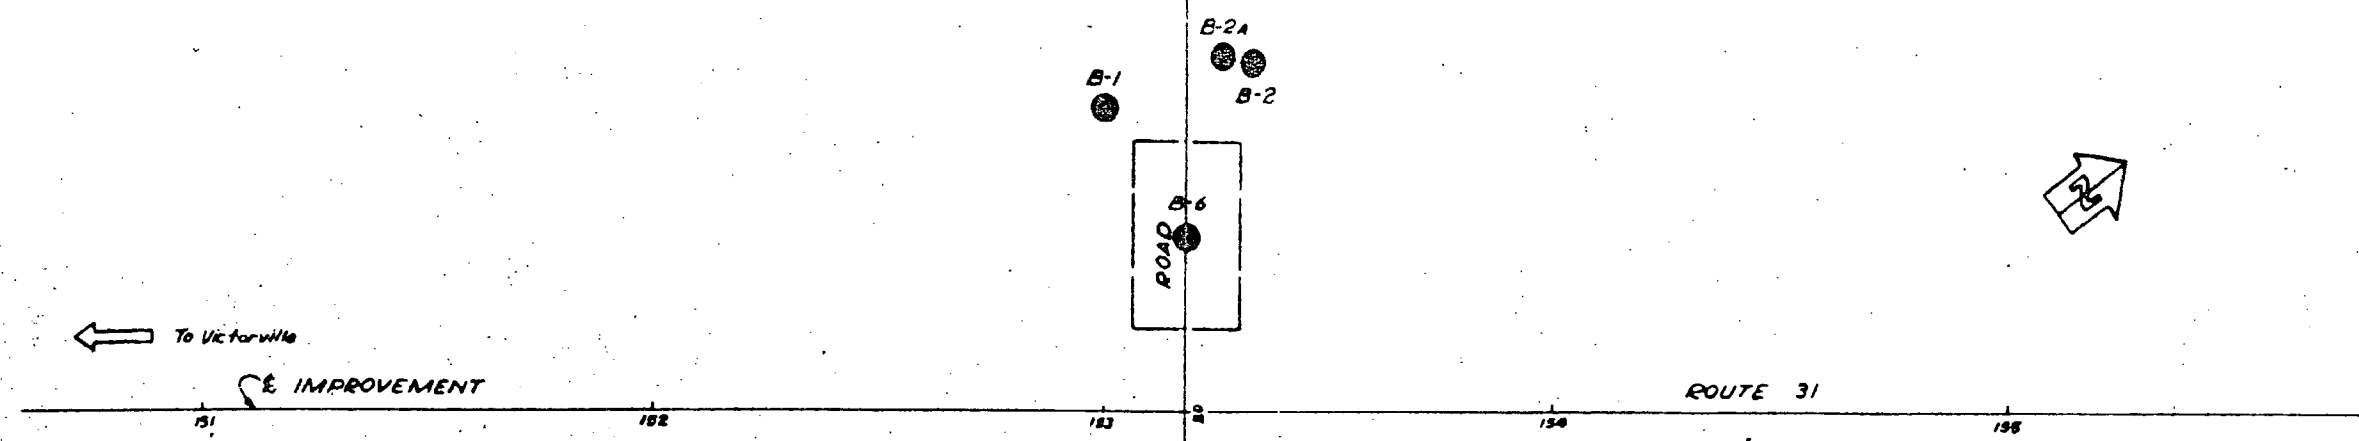

DIVISION OF ENGINEERING SERVICES - GEOTECHNICAL SERVICES

As-Built Log of Test Borings sheet is considered an informational document only. As such, the State of California registration seal with signature, license number and registration certificate expiration date confirm that this is a true and accurate copy of the original document. It does not attest to the accuracy or validity of the information contained in the original document. This drawing is available and presented only for the convenience of any bidder, contractor or other interested party.


DIST.	COUNTY	ROUTE	KILOMETER POST - TOTAL PROJECT	Sheet No.	Total Sheets
08	SBD	31			

REGISTERED ENGINEER - CIVIL

CEMENT CO. UC (WIDEN)
LOG OF TEST BORINGS 2 OF 2

NOTE: A COPY OF THIS LOG OF TEST BORINGS IS AVAILABLE AT OFFICE OF STRUCTURE MAINTENANCE AND INVESTIGATIONS, SACRAMENTO, CALIFORNIA


CU: 08
 EA: 355521
 BRIDGE No. 54 0517

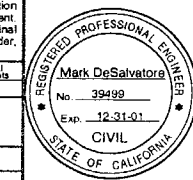


Revisions made to this Log of Test Borings from the original 1956 Log of Test Borings are the addition of the following table and notes:

Boring	Station	Offset from "C/L Route 15"
B-3	97+54.251	18.290 m Right
B-1	97+54.251	19.810 m Left
B-5	97+59.738	11.580 m Right
B-6	97+59.738	11.580 m Left
B-2A	97+62.176	22.860 m Left
B-4	97+62.786	7.320 m Right
B-2	97+64.310	22.560 m Left


- Notes:
- See the General Plan and/or Foundation Plan for Metric Stations.
 - The Division of Structure Design produced the data presented in the table above. The data are the metric locations for the As-Built Test Borings referenced to the proposed new structure location. This table is presented on the As-Built Log of Test Boring sheet for the convenience of any bidder, contractor or other interested party.
 - In the table above, the Metric Boring Locations are based on NAD 83 horizontal datum.

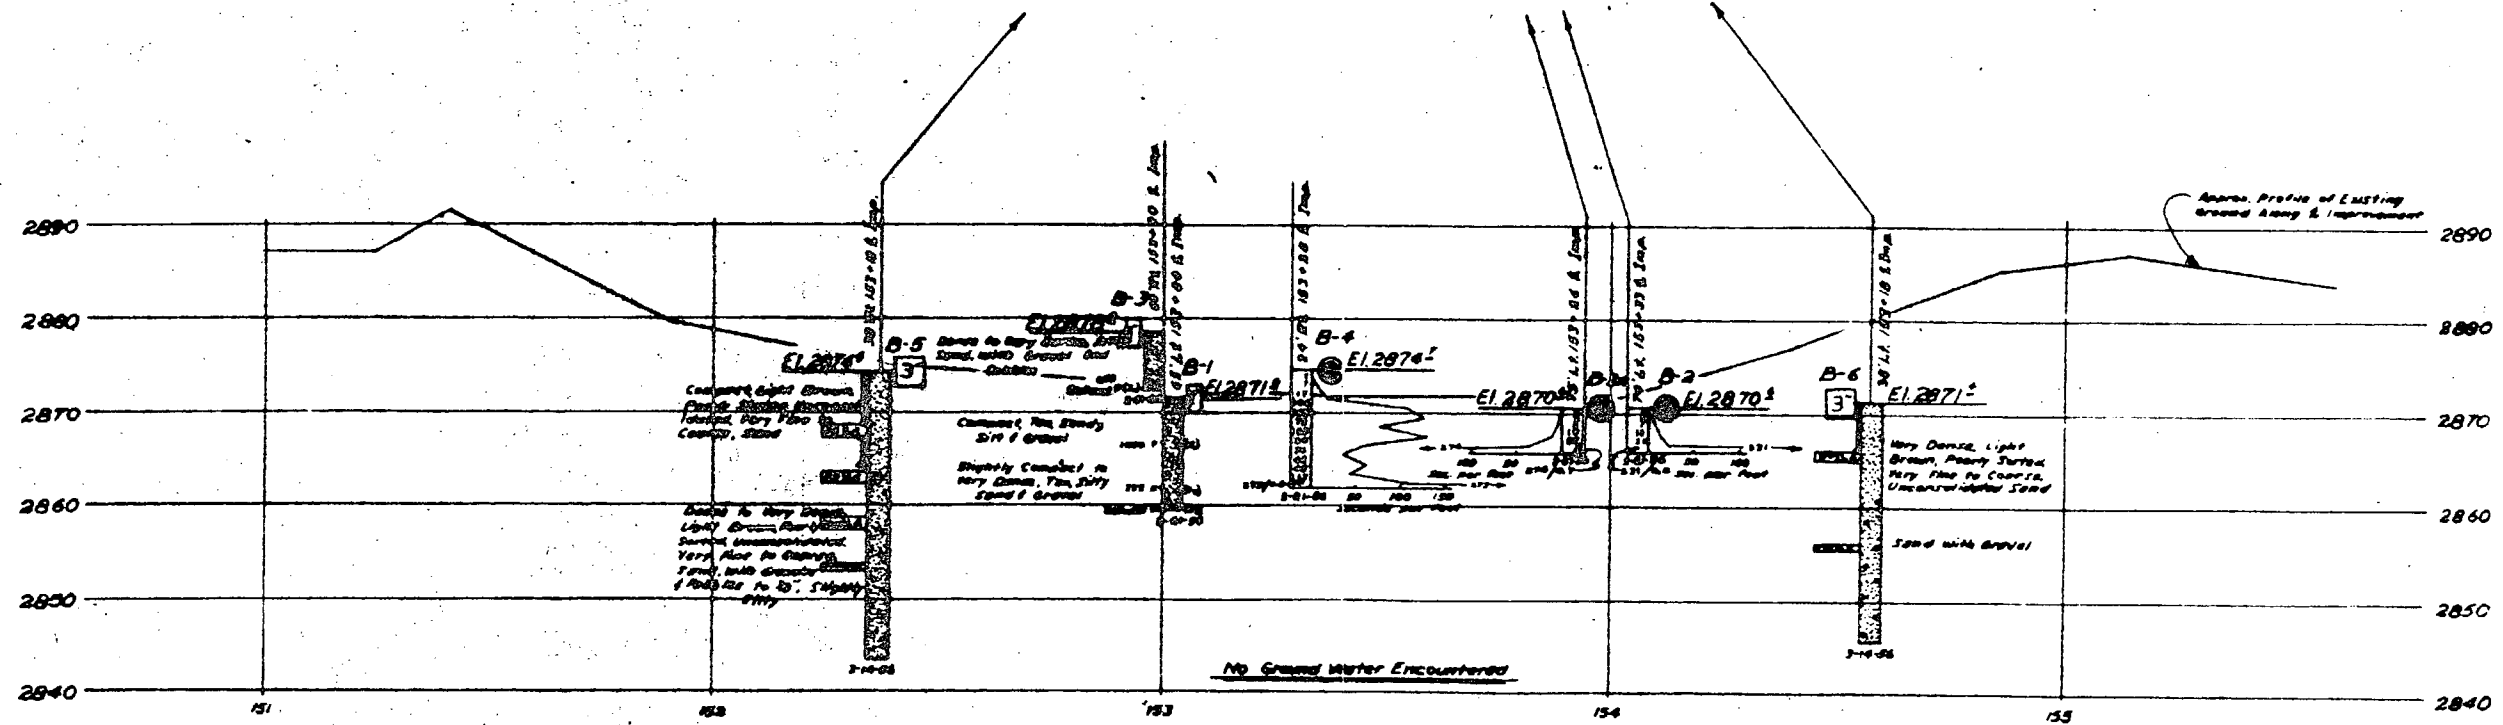

B.M. = 64.54
 2' x 2' Road N of Sd Rd. n. Dur. 15
 2' x 2' Road Small Jct. Dur. 186.9 ft
 Sta. 17+47.6 S. Imp. El. 2891.6

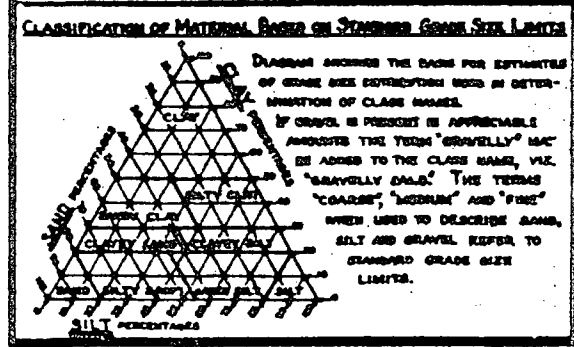

- LEGEND OF EARTH MATERIALS**
- GRAVEL
 - SAND
 - SILT
 - CLAY
 - SANDY CLAY OR CLAYEY SAND
 - SANDY SILT OR SILTY SAND
 - SILTY CLAY OR CLAYEY SILT
 - PEAT AND/OR ORGANIC MATTER
 - FILL MATERIAL
 - IGNEOUS ROCK
 - SEDIMENTARY ROCK
 - METAMORPHIC ROCK

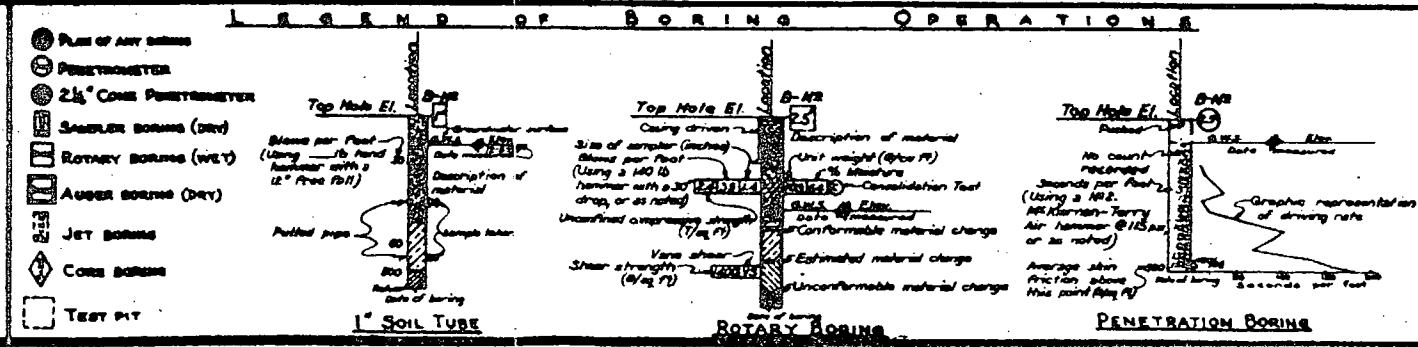

NOTES

The contractor's attention is directed to Section 2, Article (c) of the Standard Specifications and to the Special Provisions accompanying this set of plans.

Classification of earth material as shown on this sheet is based upon field inspection and is not to be construed to imply mechanical analysis.

STATE OF CALIFORNIA
 DEPARTMENT OF PUBLIC WORKS
 DIVISION OF HIGHWAYS

58-BVCA-FI

CEMENT CO. UNDERCROSSING

LOG OF TEST BORINGS


Scale: Horiz. 1" = 20', Vert. 1" = 10'
 BRIDGE 54-517
 FILE 5-14
 DRAWING 1-4353-2




DIST	COUNTY	ROUTE	KILOMETER POST TOTAL PROJECT	SHEET NO	TOTAL SHEETS
08	SBd	15			

10-24-01
 REGISTERED CIVIL ENGINEER
 Mark DeSajvatore
 No. 39499
 Exp. 12-31-01
 CIVIL
 STATE OF CALIFORNIA

PLANS APPROVAL DATE
 The State of California or its officers or agents shall not be responsible for the accuracy or completeness of electronic copies of this plan sheet.

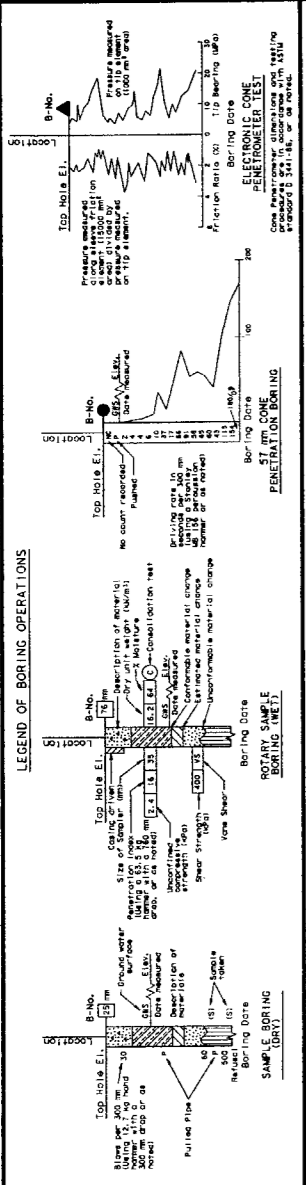


BENCH MARK
 BM #46.52-92 Elev. 879.372
 Fd. 51 mm with std. br. dish in conc. 4.219 m West of NBnd
 R/W fence, down 152mm (NGVD 29)

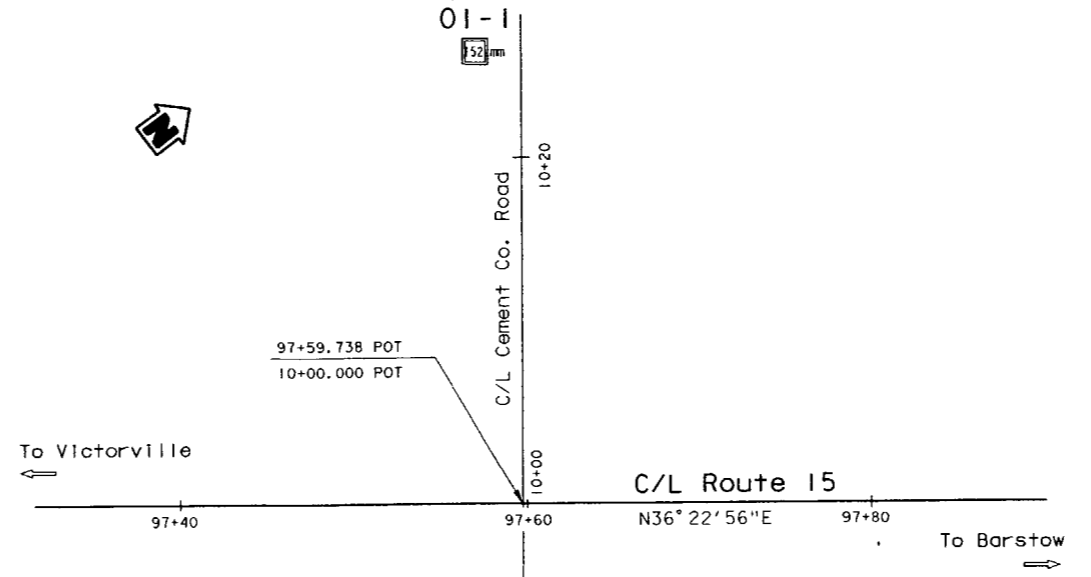

PLAN
1:200

- Notes:**
- Ground Water was not encountered during field investigation.
 - The descriptions and classifications of rock and/or soil, including consistency and relative density descriptors, used by the field and/or office personnel for the exploration boreholes shown on this sheet are based on the "Soil and Rock Logging Classification Manual (Field Guide)", Engineering Service Center, Office of Structural Foundations, August 1996.
 - Soil colors were determined by using Munsell Soil Color Charts (1994, Revised Edition). Rock colors were determined using USGS rock color charts (1995, revised text).
 - Test boring 01-1, 01-2 utilized a safety hammer to advance the sampler using 63.5 kg hammer with a 760 mm drop. Penetration index values shown are the actual blow counts recorded in the field.
 - E= Blow count for 0.3 m penetration extrapolated from blow count for less than 0.3 m penetration (due to change in material or hard driving).

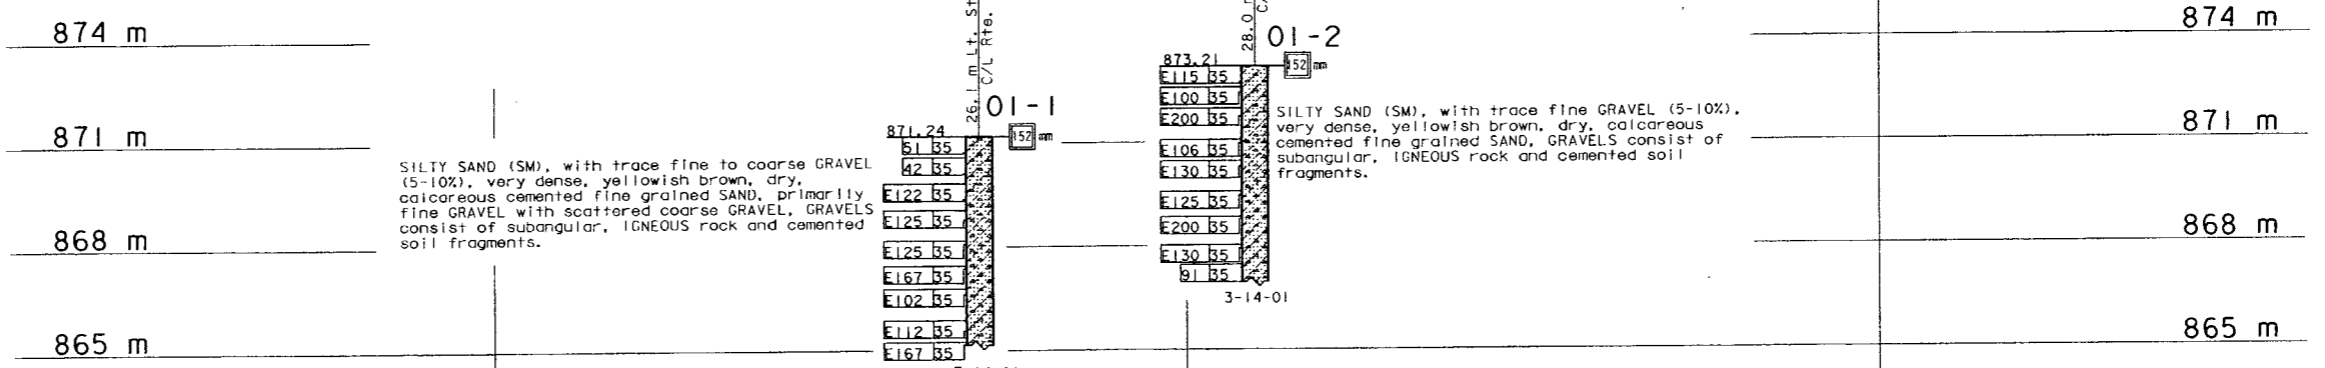

PROFILE
 HOR. 1:50
 VER. 1:100

ALL DIMENSIONS ARE IN METERS UNLESS OTHERWISE SHOWN

LEGEND OF EARTH MATERIALS

GRAVEL	CLAYEY SILT
SAND	CLAYEY SAND
SILT	CLAY
CLAY	CLAYEY CLAY
CLAYEY SAND	CLAYEY SILT
CLAYEY SILT	SANDY SILT
SANDY SILT	SANDY CLAY
SANDY CLAY	SANDY SILTY SAND
SANDY SILTY SAND	SANDY SILTY CLAY
SANDY SILTY CLAY	SANDY SILTY CLAY

CONSISTENCY CLASSIFICATION FOR SOILS

SPT N (blows/30 cm)	Consistency
0-4	Very Loose
5-10	Loose
11-20	Medium Dense
21-30	Dense
31-50	Very Dense
>50	Hard

NOTE: Classification of earth material as shown on this sheet is based upon field inspection and is not to be construed to imply mechanical analysis.

ENGINEERING SERVICES	GEOTECHNICAL SERVICES
DRAWN BY: Lily Wang 09/01	CHECKED BY: M. Spohn

FIELD INVESTIGATION BY:
H. Valencia

STATE OF CALIFORNIA
 DEPARTMENT OF TRANSPORTATION

DIVISION OF STRUCTURES
 STRUCTURE DESIGN

BRIDGE NO. 54-0517
 KILOMETER POST 74.7
CEMENT CO. UC (WIDEN)
LOG OF TEST BORINGS 1 OF 2

Bell Mountain Wash



DIST	COUNTY	ROUTE	KILOMETER TOTAL PROJECT	POST No	SHEET No	TOTAL SHEETS
08	SBd	15				

10-29-01
 REGISTERED CIVIL ENGINEER
 Mark DeSalvatore
 No. 39499
 Exp. 12-31-01
 CIVIL
 STATE OF CALIFORNIA

PLANS APPROVAL DATE
 The State of California or its officers or agents shall not be responsible for the accuracy or completeness of electronic copies of this plan sheet.

LEGEND OF BORING OPERATIONS

75 mm CONE PENETRATION TEST
 Friction ratio (kN/m²)
 Tip resistance (kN/m²)
 Friction ratio (%)


ROTARY SAMPLE BORING (REBT)
 Borehole diameter
 Sample interval
 Sample location

DIAMOND CORE BORING
 Core diameter
 Core length
 Core location

LEGEND OF EARTH MATERIALS


CONSISTENCY CLASSIFICATION FOR SOILS

NOTE: Classification of earth material as shown on this sheet is based upon field inspection and is not to be construed to imply mechanical analysis.

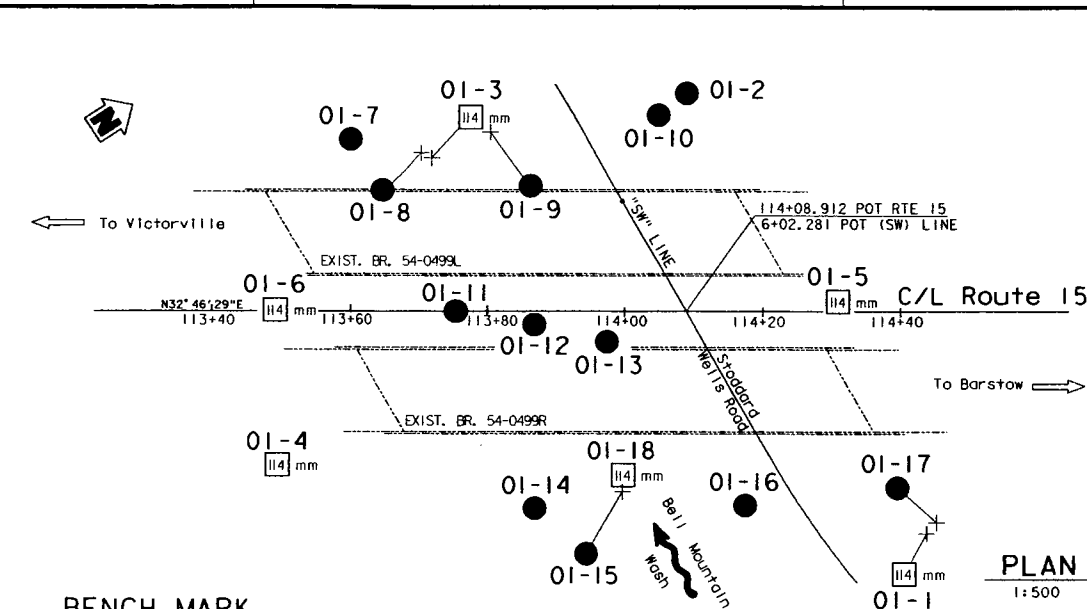

- Notes:**
- No attempt was made to measure ground water in any borings except for boring 01-3 during the 2001 field investigation.
 - Ground water was not encountered in borings 01-3 during the 2001 field investigation.
 - The descriptions and classifications of rock and/or soil, including consistency and relative density descriptors, used by the field and/or office personnel for the exploration boreholes shown on this sheet are based on the "Soil and Rock Logging Classification Manual (Field Guide)", Engineering ServiceCenter, Office of Structural Foundations, August 1996.
 - Soil colors were determined by using Munsell Soil Color Charts (1994, Revised Edition). Rock colors were determined using USGS rock color charts (1995, revised text).
 - Test boring B-1-00 was advanced using a combination of tungsten-carbide drill bits and wireline diamond coring methods.
 - Test borings 01-2, 01-4, 01-5, 01-18 utilized a safety hammer to advance the sampler using a 63.5 kg hammer with a 760 mm drop. Penetration Index values shown are the actual blow counts recorded in the field.
 - Test borings 01-1, 01-3, 01-6 utilized a Deldrich automatic hammer to advance the sampler. Penetration Index values shown on the LOTB sheets were the actual blow counts recorded in the field.
 - Soil consistency classifications for test borings 01-1, 01-3, 01-6 are based on a conversion factor of 1.5 times the uncorrected blow count.
 - E=Blow count for 0.3 m penetration extrapolated from blow count for less than 0.3 m penetration (due to change in material or hard driving).
 - Penetration Index value designated "Ref" means sampler refusal.
 - Refusal in earth material is defined as severely limited or halted penetration (less than 60 mm penetration in 50 blow counts) of the Standard Penetration Test (SPT) sampler due to the presence of GRAVEL, COBBLES, BOULDERS or ROCK formation materials.

BENCH MARK
 BM PT #186 Elev. 878.901 m
 Fd. PK nail & tin in AC gore, approx. 24.94 m NW'y of the SBnd edge of deck bridge N621227.045 E2067844.939

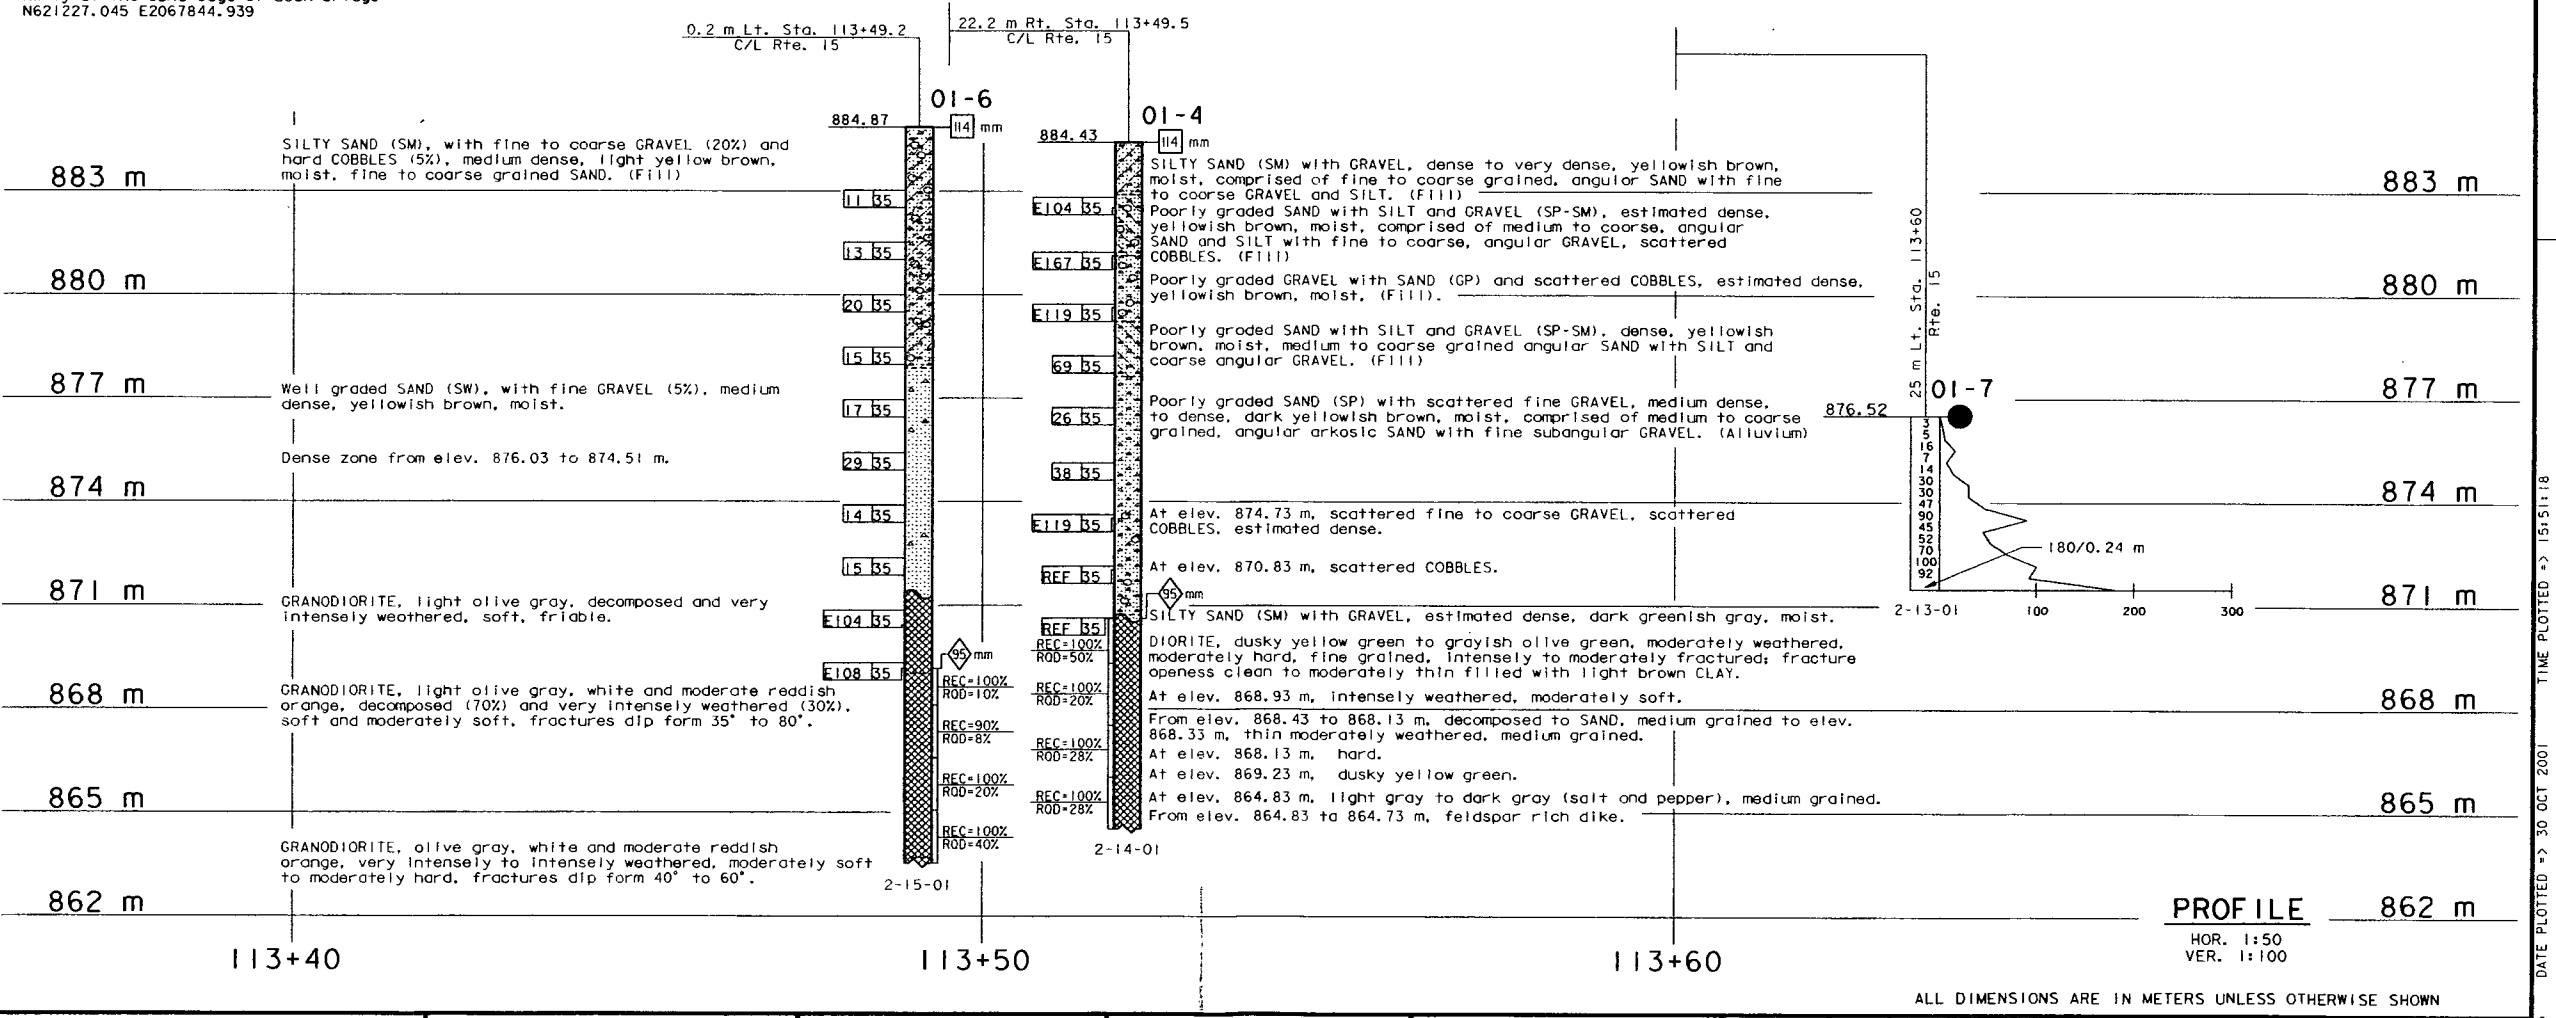

LEGEND OF BORING OPERATIONS

75 mm CONE PENETRATION TEST
 Friction ratio (kN/m²)
 Tip resistance (kN/m²)
 Friction ratio (%)

ROTARY SAMPLE BORING (REBT)
 Borehole diameter
 Sample interval
 Sample location

DIAMOND CORE BORING
 Core diameter
 Core length
 Core location

LEGEND OF EARTH MATERIALS

CONSISTENCY CLASSIFICATION FOR SOILS

NOTE: Classification of earth material as shown on this sheet is based upon field inspection and is not to be construed to imply mechanical analysis.

ENGINEERING SERVICES	GEOTECHNICAL SERVICES	FIELD INVESTIGATION BY: R. Fuentes M. Pagenkopp H. Valencia	STATE OF CALIFORNIA DEPARTMENT OF TRANSPORTATION	DIVISION OF STRUCTURES STRUCTURE DESIGN	BRIDGE NO. 54-0499 KILOMETER POST 76.3	BELL MOUNTAIN WASH BRIDGE (WIDEN)
DRAWN BY Irma G-Remmen 9/01	CHECKED BY H. Valencia 10/01		CU 08 EA 355521		DISREGARD PRINTS BEARING EARLIER REVISION DATES	LOG OF TEST BORINGS 1 OF 7

REVISION DATES (PRELIMINARY STAGE ONLY)

NO.	DATE	DESCRIPTION
1	10-24-01	10-29-01

FILE -> /user/dms/local/trans/lab/08-355520/bellmnt1.dgn

DATE PLOTTED -> 30 OCT 2001 USERNAME -> TSDPP



DIST	COUNTY	ROUTE	KILOMETER POST TOTAL PROJECT	SHEET No	TOTAL SHEETS
08	SBd	15			

10-30-01
 REGISTERED CIVIL ENGINEER
 Mark DeSalvatore
 No. 39499
 Exp. 12-31-01
 CIVIL
 STATE OF CALIFORNIA

PLANS APPROVAL DATE
 The State of California or its officers or agents shall not be responsible for the accuracy or completeness of electronic copies of this plan sheet.

FOR PLAN VIEW, SEE
 "LOG OF TEST BORINGS" 1 OF 7

LEGEND OF BORING OPERATIONS

75 mm CONE PENETRATION
 75 mm CONE PENETRATION TEST
 Friction ratio (kN/m²) vs. Penetration (mm) graph showing test results.

ROTARY SAMPLE BORING (WELL)
 Description of material, Sample No., Depth (m), etc.

DIAMOND CORE BORING
 Description of material, Sample No., Depth (m), etc.

75 mm CONE PENETRATION
 75 mm CONE PENETRATION TEST
 Friction ratio (kN/m²) vs. Penetration (mm) graph showing test results.

ROTARY SAMPLE BORING (WELL)
 Description of material, Sample No., Depth (m), etc.

DIAMOND CORE BORING
 Description of material, Sample No., Depth (m), etc.

LEGEND OF EARTH MATERIALS


GRAVEL, SAND, SILT, CLAY, LOESS, SILTY SAND, SILTY CLAY, CLAYEY SILT, PEAT AND/OR ORGANIC WATER, COBBLES AND/OR Boulders, LIQUEFIED ROCK, SEDIMENTARY ROCK, METAMORPHIC.

CONSISTENCY CLASSIFICATION FOR SOILS

According to the Standard Penetration Test

SPT N-value (blows/30 cm)	Consistency
0-4	Very Loose
5-10	Loose
11-20	Medium Dense
21-30	Dense
31-50	Very Dense
> 50	Hard

NOTE: Classification of earth material as shown on this sheet is based upon field inspection and is not to be construed to imply mechanical analysis.

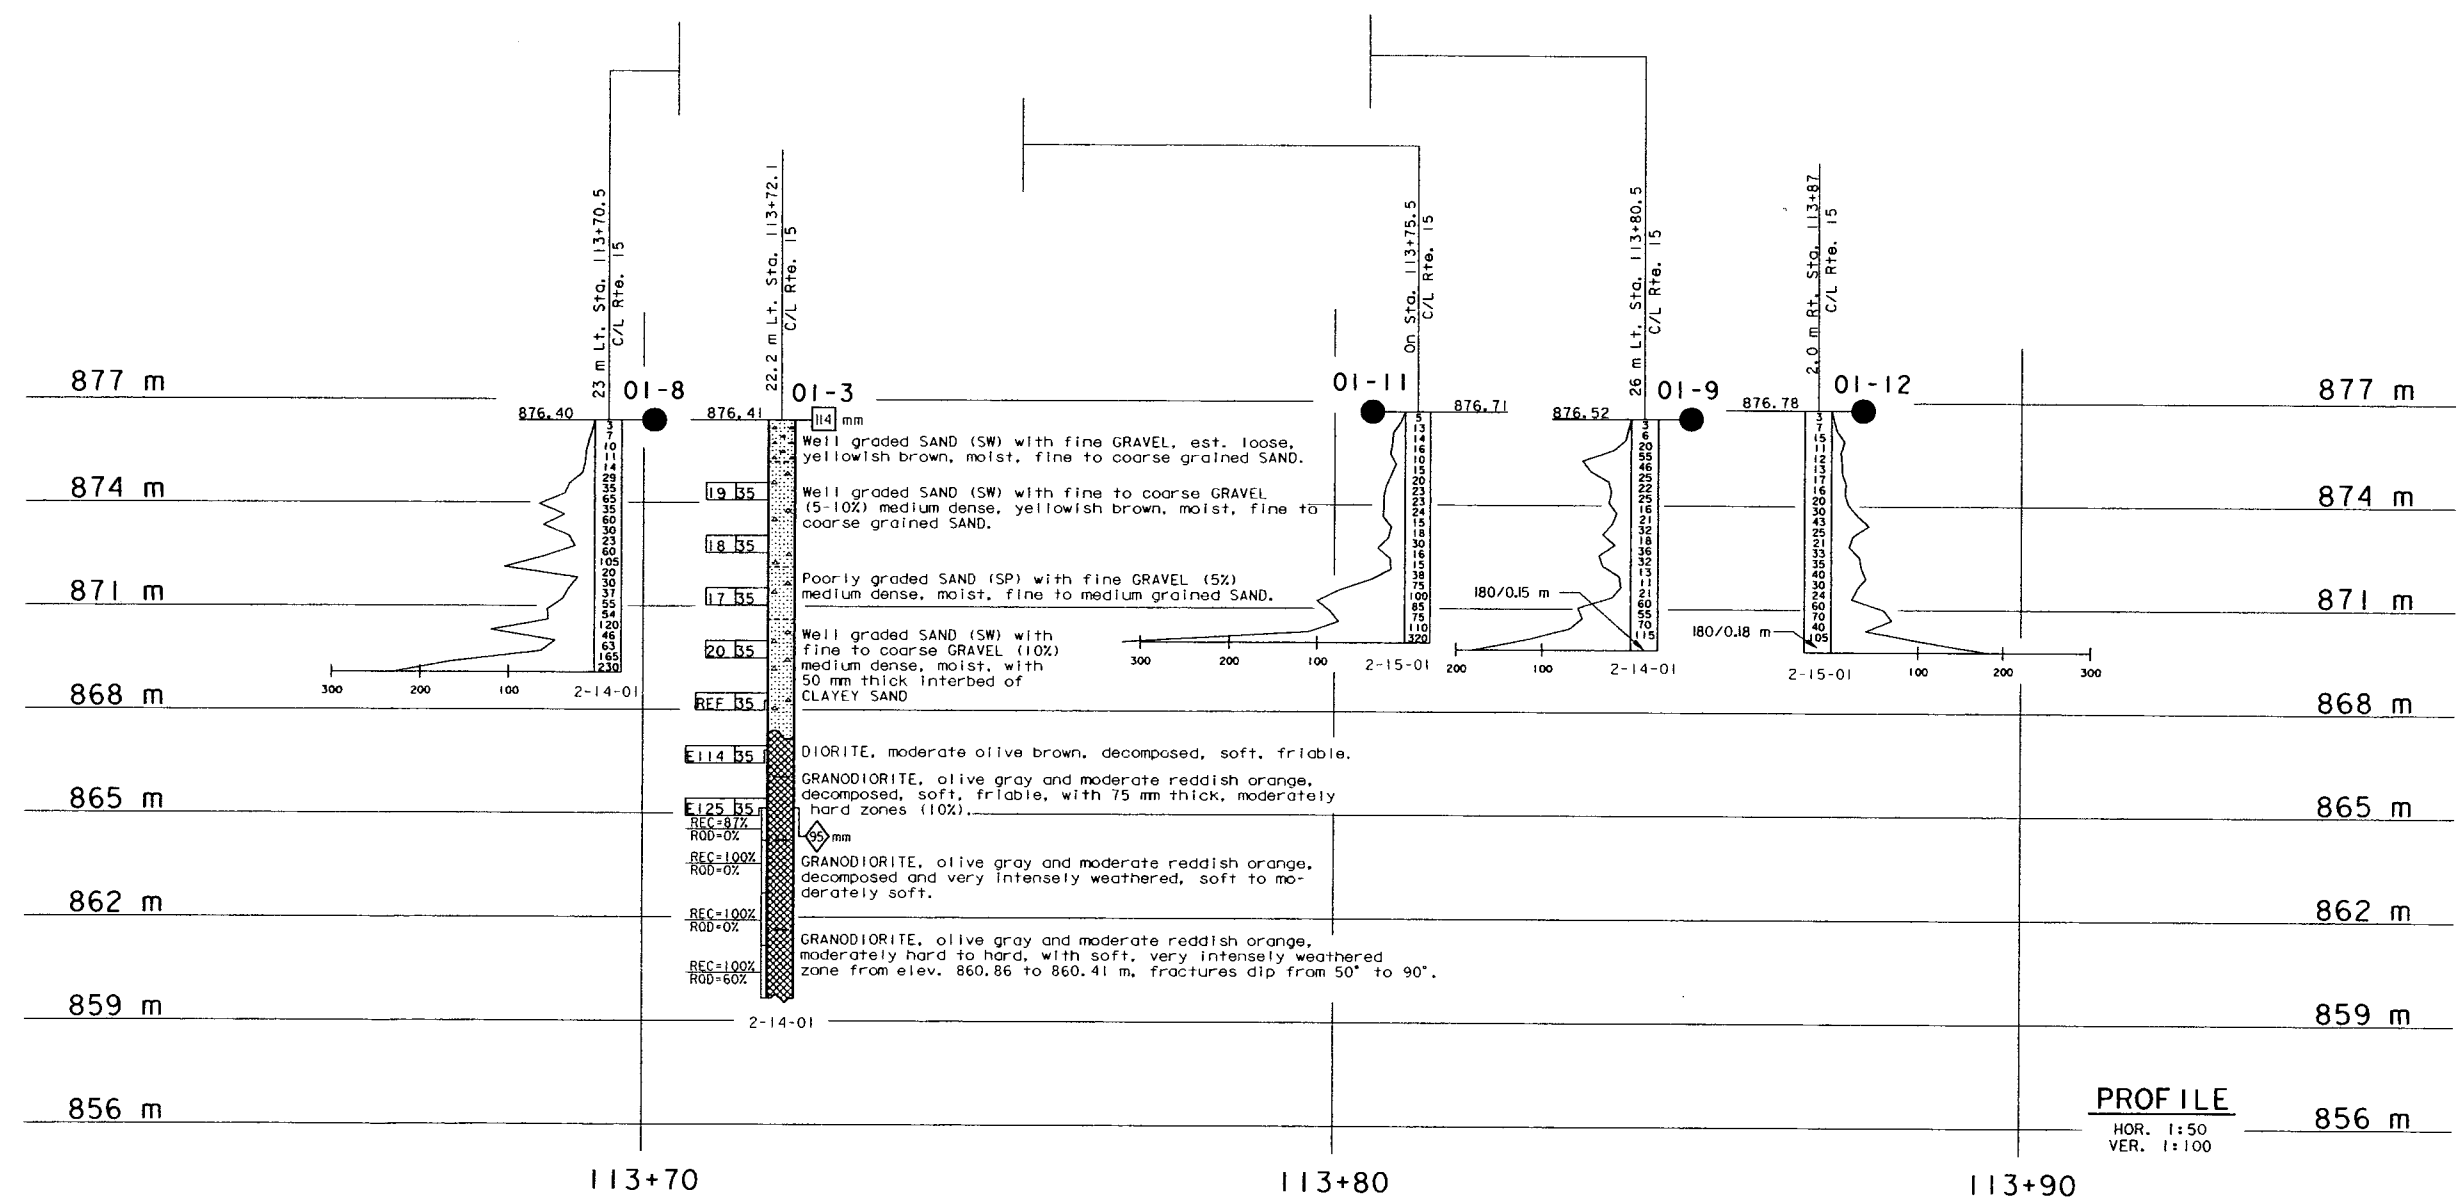

ENGINEERING SERVICES		GEOTECHNICAL SERVICES		FIELD INVESTIGATION BY: R. Fuentes M. Pagenkopp H. Valencia	BRIDGE NO. 54-0499	BELL MOUNTAIN WASH BRIDGE (WIDEN)	
DRAWN BY Irma G-Reitman 9/01	CHECKED BY N. Sandoval 10/01			STATE OF CALIFORNIA DEPARTMENT OF TRANSPORTATION	KILOMETER POST 76.3	LOG OF TEST BORINGS 2 OF 7	
O&G CIVIL LOG OF TEST BORINGS SHEET (METRIC) (REV. 328/01)				CU 08 EA 355521	DISREGARD PRINTS BEARING EARLIER REVISION DATES		



REVISION DATES (PRELIMINARY STAGE ONLY)	SHEET	OF
10-24-01 10-25-01 10-30-01		

FILE => /user/dms/local/translab/08-355520/bellmntn2.dgn

DATE PLOTTED => 30 OCT 2001 TIME PLOTTED => 15:22:03 USERNAME => tsdbd




DIST	COUNTY	ROUTE	KILOMETER POST TOTAL PROJECT	SHEET No	TOTAL SHEETS
08	Sbd	15			

REGISTERED CIVIL ENGINEER
 10-30-01
 Mark Desalvatore
 No. 39499
 Exp. 12-31-01
 CIVIL
 STATE OF CALIFORNIA

PLANS APPROVAL DATE
 The State of California or its officers or agents shall not be responsible for the accuracy or completeness of electronic copies of this plan sheet.

FOR PLAN VIEW, SEE
"LOG OF TEST BORINGS" 1 OF 7

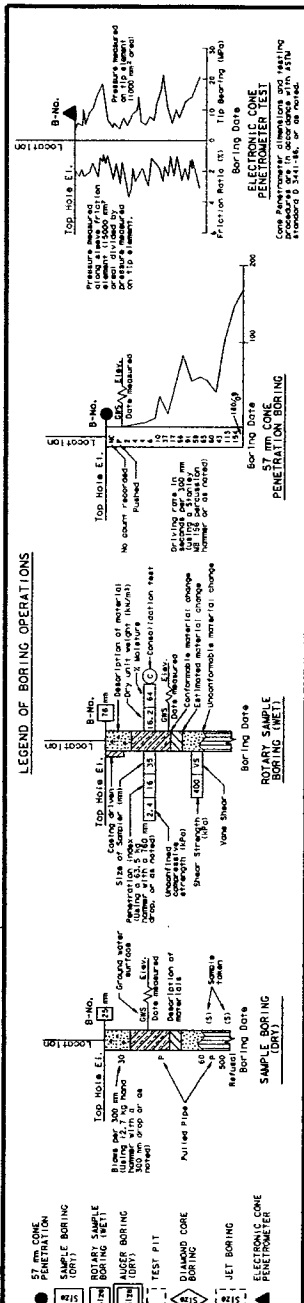


LEGEND OF EARTH MATERIALS

GRAVEL	CLAYEY SILT
SAND	PEAT and/or ORGANIC MATTER
COBBLES and/or Boulders	SILT
LIQUEFIED SAND	CLAY
LONGEVUS ROCK	CLAYEY SAND
SEDIMENTARY ROCK	SANDY SILT or SILTY SAND
IGNEOUS ROCK	SILT CLAY
DIAMOND CORE BORING	METAMORPHIC

CONSISTENCY CLASSIFICATION FOR SOILS

SP	Very Loose	0-2
SM	Loose	2-4
MS	Medium Dense	4-6
ML	Dense	6-8
MH	Very Dense	8-10
SH	Very Stiff	10-15
CH	Hard	15-30

NOTE: Classification of earth material as shown on this sheet is based upon field inspection and is not to be construed to imply mechanical analysis.

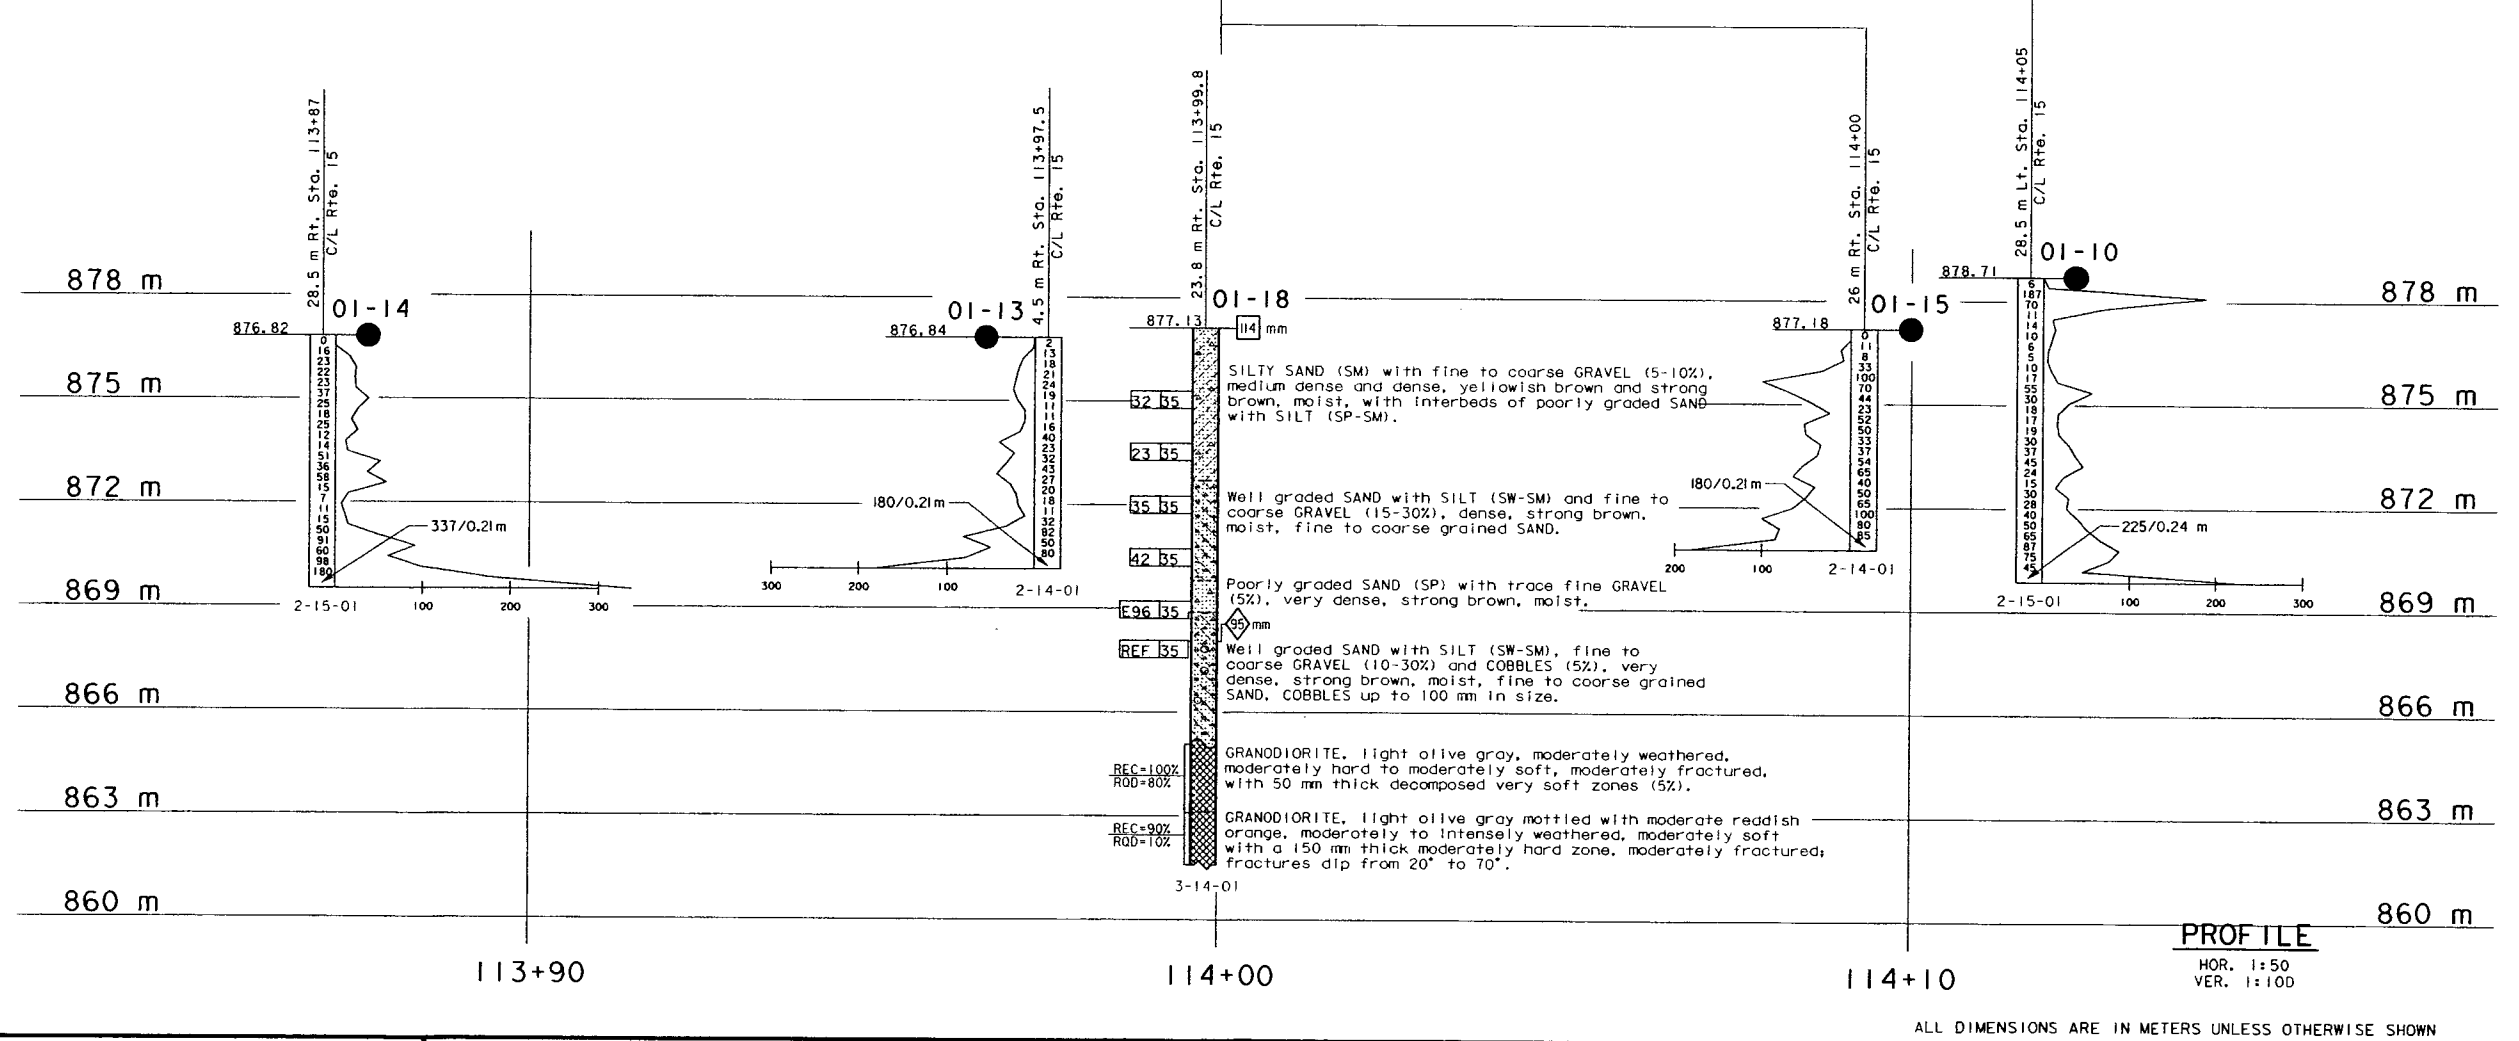

ENGINEERING SERVICES DRAWN BY Irma G-Remmen 9/01 CHECKED BY N. Sandoval 10/01		GEOTECHNICAL SERVICES		FIELD INVESTIGATION BY: R. Fuentes M. Pagenkopp H. Valencia		STATE OF CALIFORNIA DEPARTMENT OF TRANSPORTATION		DIVISION OF STRUCTURES STRUCTURE DESIGN		BRIDGE NO. 54-0499 KILOMETER POST 76.3		BELL MOUNTAIN WASH BRIDGE (WIDEN) LOG OF TEST BORINGS 3 OF 7	
ORIGINAL SCALE IN MILLIMETERS FOR REDUCED PLANS: 0 10 20 30 40 50 60 70 80 90 100						CU 08 EA 355521		DISREGARD PRINTS BEARING EARLIER REVISION DATES		REVISION DATES (PRELIMINARY STAGE ONLY)		SHEET OF	

DATE PLOTTED => 30 OCT 2001
TIME PLOTTED => 15:27:38
USERNAME => TSBDD




DIST	COUNTY	ROUTE	KILOMETER POST TOTAL PROJECT	SHEET No	TOTAL SHEETS
08	Sbd	15			

10-30-01
 REGISTERED CIVIL ENGINEER
 Mark DeSalvatore
 No. 39499
 EXD. 12-31-01
 CIVIL
 STATE OF CALIFORNIA

PLANS APPROVAL DATE
 The State of California or its officers or agents shall not be responsible for the accuracy or completeness of electronic copies of this plan sheet.

FOR PLAN VIEW, SEE
"LOG OF TEST BORINGS" 1 OF 7

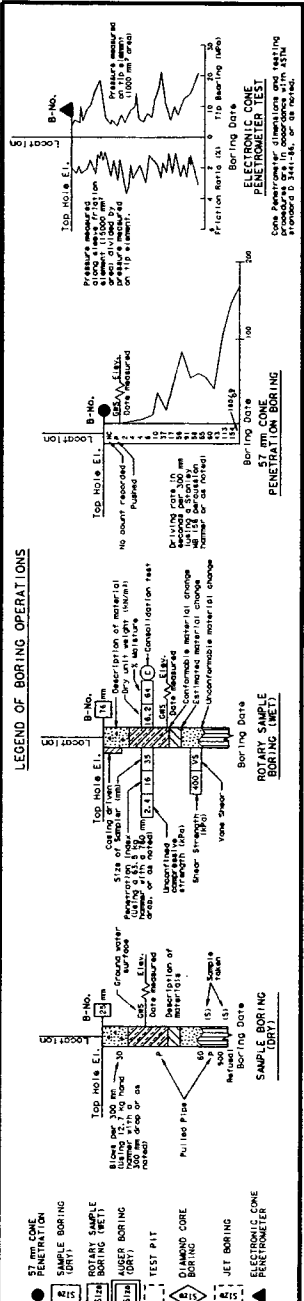


LEGEND OF EARTH MATERIALS

CLAYEY SILT	PEAT AND/OR ORGANIC MATTER
COBBLES AND/OR BOULDER	GRAVEL
GRAVEL	SAND
SILT	CLAY
CLAY	CLAYEY SAND
SANDY CLAY	SANDY SILT
SANDY SILT	SILT CLAY
SILT CLAY	

CONSISTENCY CLASSIFICATION FOR SOILS

SP	Very Soft
ST	Soft
MC	Medium Consistent
HC	Hard Consistent
U	Very Hard

NOTE: Classification of earth material as shown on this sheet is based upon field inspection and is not to be construed to imply mechanical analysis.

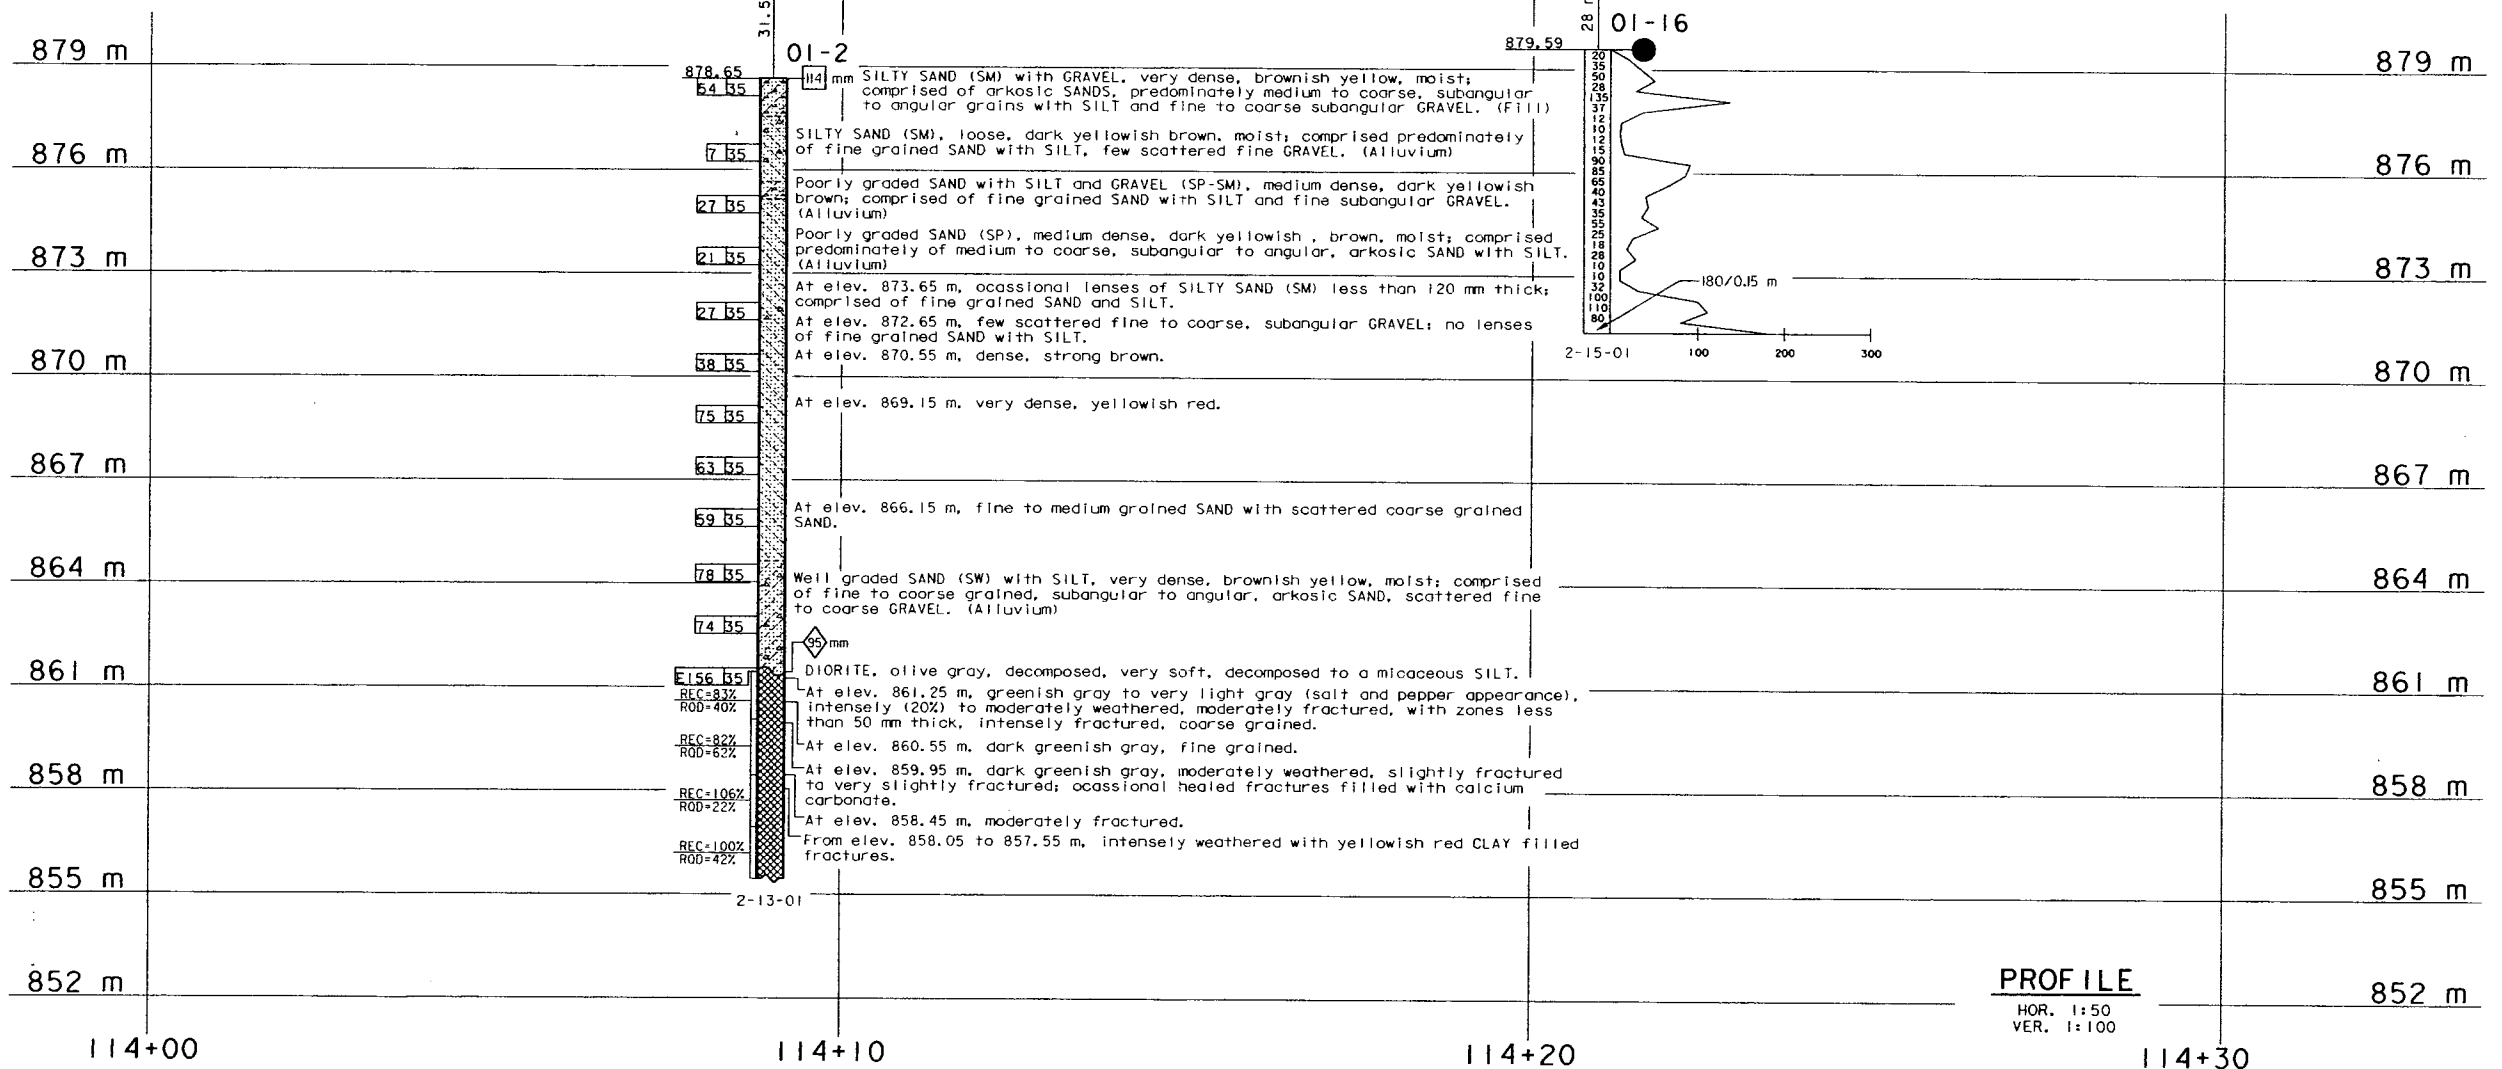

PROFILE
HOR. 1:50
VER. 1:100

ALL DIMENSIONS ARE IN METERS UNLESS OTHERWISE SHOWN

ENGINEERING SERVICES		GEOTECHNICAL SERVICES		FIELD INVESTIGATION BY: R. Fuentes M. Pagenkopp H. Valencia		BRIDGE NO. 54-0499		BELL MOUNTAIN WASH BRIDGE (WIDEN)	
DRAWN BY	Irma G-Remmen 9/01			STATE OF CALIFORNIA DEPARTMENT OF TRANSPORTATION		KILOMETER POST 76.3		LOG OF TEST BORINGS 4 OF 7	
CHECKED BY	H. Valencia 10/01			CU 08 EA 355521		DISREGARD PRINTS BEARING EARLIER REVISION DATES		REVISION DATES (PRELIMINARY STAGE ONLY)	
				ORIGINAL SCALE IN MILLIMETERS FOR REDUCED PLANS		FILE -> /user/dms/local/translab/08-355520/bel1mtr4.dgn		SHEET OF	

DATE PLOTTED => 30 OCT 2001 TIME PLOTTED => 15:46:04 USERNAME => tsddd




DIST	COUNTY	ROUTE	KILOMETER TOTAL PROJECT	POST No	SHEET No	TOTAL SHEETS
08	SBd	15				

10-30-01
 REGISTERED CIVIL ENGINEER
 Mark Desjardins
 No. 39499
 Exp. 12-31-01
 CIVIL ENGINEER
 STATE OF CALIFORNIA

PLANS APPROVAL DATE

The State of California or its officers or agents shall not be responsible for the accuracy or completeness of electronic copies of this plan sheet.



FOR PLAN VIEW, SEE
 "LOG OF TEST BORINGS" 1 OF 7

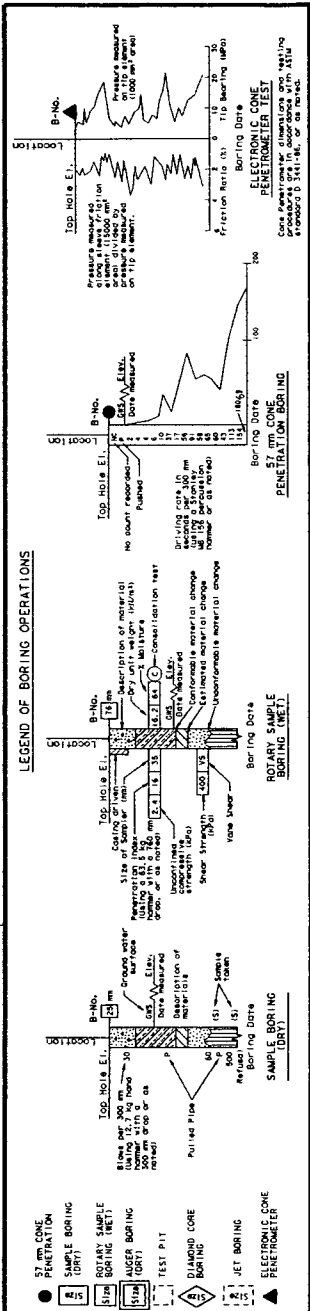

LEGEND OF EARTH MATERIALS

CONSISTENCY CLASSIFICATION FOR SOILS	
SP (Very Loose)	Very Soft
SL (Loose)	Soft
ML (Medium Dense)	Firm
CL (Dense)	Very Stiff
CH (Very Dense)	Hard

NOTE: Classification of earth material as shown on this sheet is based upon field inspection and is not to be construed to imply mechanical analysis.

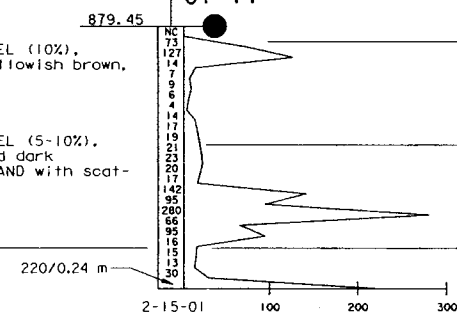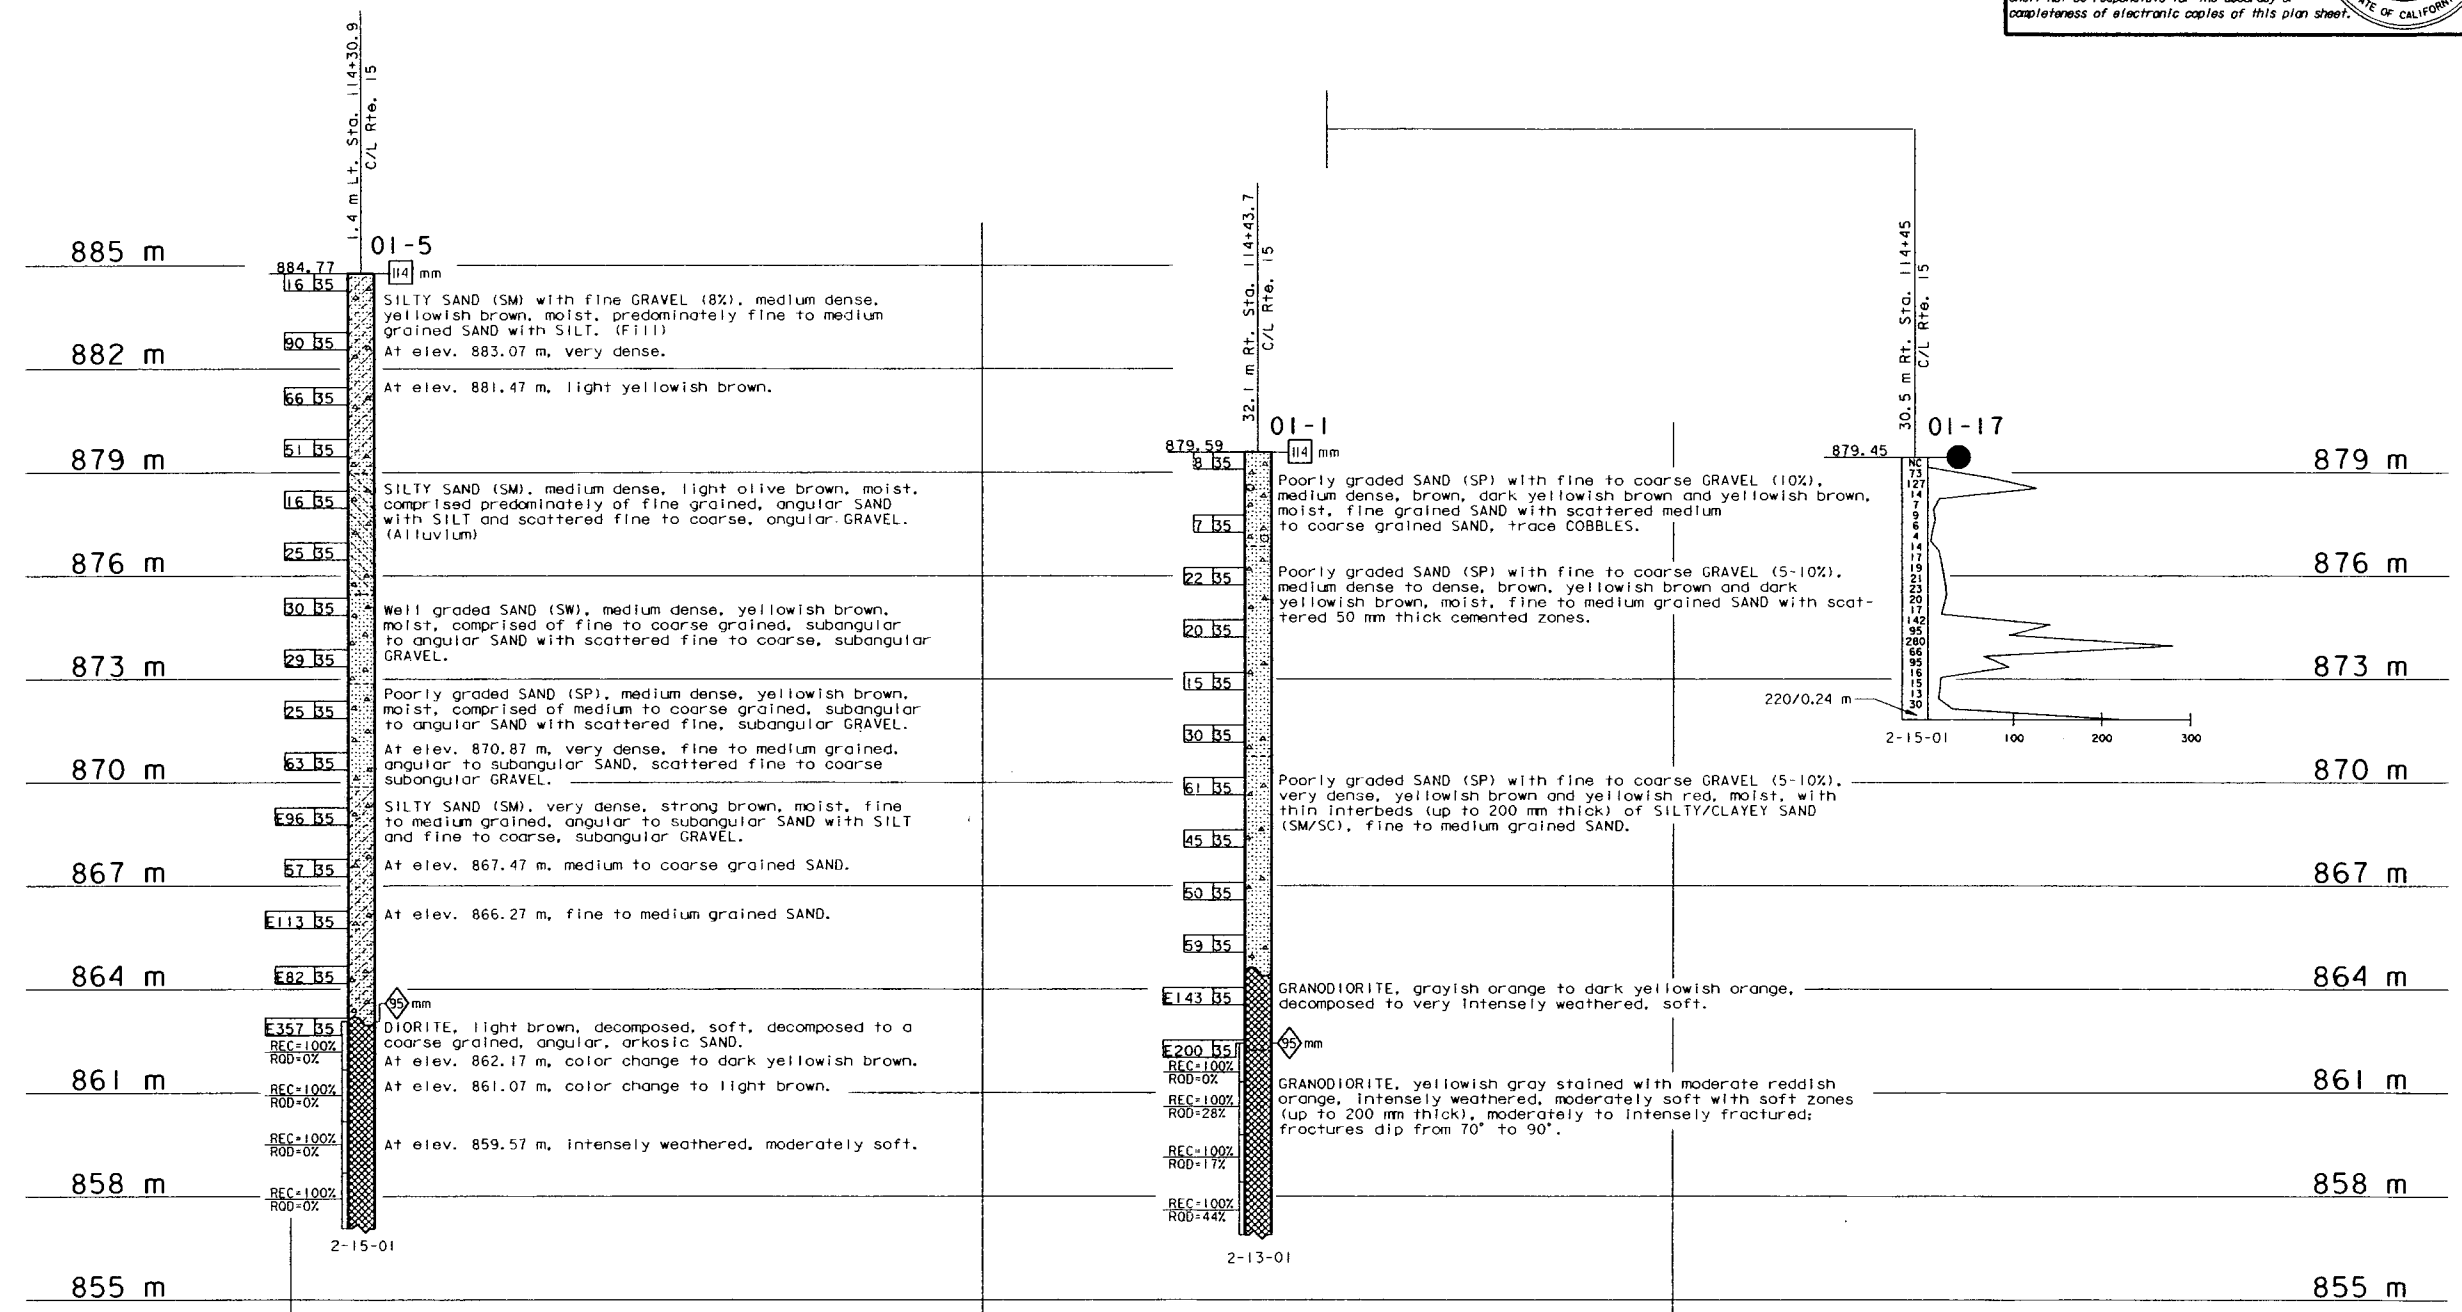

PROFILE
 HOR. 1:50
 VER. 1:100

ALL DIMENSIONS ARE IN METERS UNLESS OTHERWISE SHOWN

ENGINEERING SERVICES		GEOTECHNICAL SERVICES		FIELD INVESTIGATION BY: R. Fuentes M. Pagenkopp H. Valencia		BRIDGE NO. 54-0499		BELL MOUNTAIN WASH BRIDGE (WIDEN)	
DRAWN BY Irma G-Remmen 9/01		CHECKED BY H. Valencia 10/01		STATE OF CALIFORNIA DEPARTMENT OF TRANSPORTATION		DIVISION OF STRUCTURES STRUCTURE DESIGN		LOG OF TEST BORINGS 5 OF 7	

DATE PLOTTED -> 30 OCT 2001 TIME PLOTTED -> 15:37:44 USERNAME -> fssddp



DIST	COUNTY	ROUTE	KILOMETER TOTAL PROJECT	POST	SHEET No	TOTAL SHEETS
08	SBd	15				

10-30-01
 REGISTERED CIVIL ENGINEER
 Mark Desalvatore
 No. 39499
 Exp. 12-31-01
 CIVIL
 STATE OF CALIFORNIA

PLANS APPROVAL DATE

The State of California or its officers or agents shall not be responsible for the accuracy or completeness of electronic copies of this plan sheet.


WEATHERING DESCRIPTORS							Modified from United States Bureau of Reclamation, Engineering Geology Field Manual.
Descriptors		Diagnostic features				General characteristics (strength, excavation, etc.)	
Alphanumeric descriptor	Descriptive term	Chemical weathering-Discoloration and/or oxidation		Mechanical weathering-Grain boundary conditions (disaggregation) primarily for granitics and some coarse-grained sediments	Texture and solutioning		
		Body of rock	Fracture surfaces*		Texture	Solutioning	
W1	Fresh	No discoloration, not oxidized.	No discoloration or oxidation.	No separation, intact (tight).	No change.	No solutioning.	Hammer rings when crystalline rocks are struck. Almost always rock excavation except for naturally weak or weakly cemented rocks such as siltstones or shales.
W2	Slightly weathered to fresh ^o						
W3	Slightly weathered	Discoloration or oxidation is limited to surface of, or short distance from, fractures; some feldspar crystals are dull.	Minor to complete discoloration or oxidation of most surfaces.	No visible separation, intact (tight).	Preserved.	Minor leaching of some soluble minerals may be noted.	Hammer rings when crystalline rocks are struck. Body of rock not weakened. With few exceptions, such as siltstones or shales, classified as rock excavation.
W4	Moderately to slightly weathered ^o						
W5	Moderately weathered	Discoloration or oxidation extends from fractures usually throughout; Fe-Mg minerals are "rusty," feldspar crystals are "cloudy."	All fracture surfaces are discolored or oxidized.	Partial separation of boundaries visible.	Generally preserved.	Soluble minerals may be mostly leached.	Hammer does not ring when rock is struck. Body of rock is slightly weakened. Depending on fracturing, usually is rock excavation except in naturally weak rocks such as siltstones or shales.
W6	Intensely to moderately weathered ^o						
W7	Intensely weathered	Discoloration or oxidation throughout; all feldspars and Fe-Mg minerals are altered to clay to some extent; or chemical alteration produces in-situ disaggregation, see grain boundary conditions.	All fracture surfaces are discolored or oxidized, surfaces friable.	Partial separation, rock is friable; in some conditions granitics are disaggregated.	Texture altered by chemical weathering (hydration, argillation).	Leaching of soluble minerals may be complete.	Dull sound when struck with hammer, usually can be broken with moderate to heavy manual pressure or by light hammer blow without reference to planes of weakness such as incipient or hairline fractures, or veinlets. Rock is significantly weakened. Usually common excavation.
W8	Very intensely weathered						
W9	Decomposed	Discolored or oxidized throughout, but resistant minerals such as quartz may be unaltered; all feldspars and Fe-Mg minerals are completely altered to clay.		Complete separation of grain boundaries (disaggregated).	Resembles a soil, partial or complete remnant rock structure may be preserved; leaching of soluble minerals usually complete.		Can be granulated by hand. Always common excavation. Resistant minerals such as quartz may be present as "stringers" or "dikes."

Note: This chart and its horizontal categories are more readily applied to rocks with feldspars and mafic minerals. Weathering in various sedimentary rocks, particularly limestones and poorly indurated sediments, will not always fit the categories established. This chart and weathering categories may have to be modified for particular site conditions or alteration such as hydrothermal effects; however, the basic framework and similar descriptors are to be used.

^o Combination descriptors are permissible where equal distribution of both weathering characteristics are present over significant intervals or where characteristics present are "in between" the diagnostic feature. However, dual descriptors should not be used where significant, identifiable zones can be delineated. When given as a range only two adjacent terms may be combined. "Decomposed to slightly weathered," or "moderately weathered to fresh" are not acceptable.

[†] Does not include directional weathering along shears or faults and their associated features. For example, a shear zone that carried weathering to great depths into a fresh rock mass would not require the rock mass to be classified as weathered.

[§] These are generalizations and should not be used as diagnostic features for weathering or excavation classification. These characteristics vary to a large extent based on naturally weak materials or cementation and type of excavation.

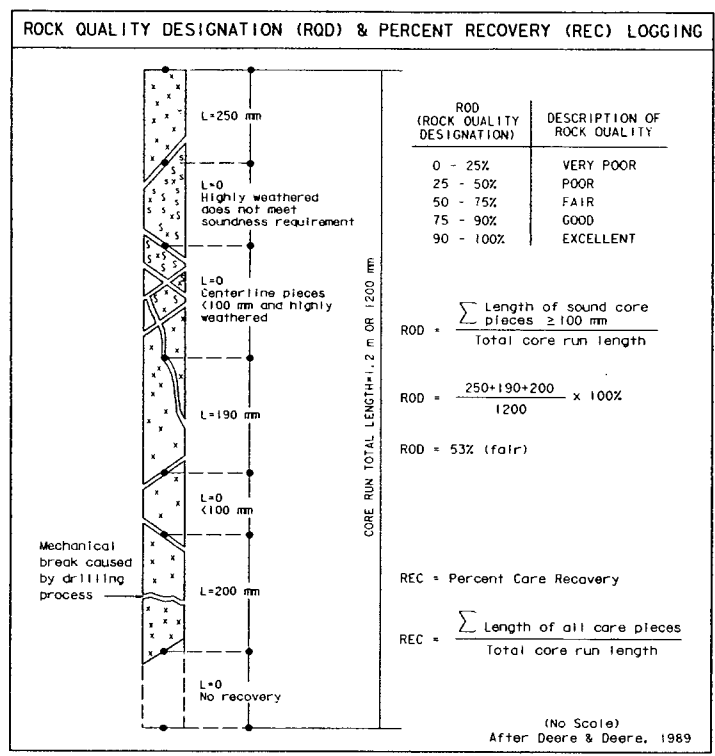

FRACTURE DENSITY		Modified from United States Bureau of Reclamation, Engineering Geology Field Manual.
<p>FRACTURE DENSITY- Based on the spacing of all natural fractures in an exposure or core recovery lengths in boreholes; excludes mechanical breaks, shears, and shear zones; however, shear-disrupted zones (fracturing outside the shear) are included. Descriptors for fracture density apply to all rock exposures such as tunnel walls, dazer trenches, outcrops, or foundation cut slopes and inverts, as well as boreholes. Descriptive criteria presented below are based on borehole cores where lengths are measured along the core axis, for other exposures the criteria is distance measured between fractures (size of blocks).</p> <p>UNFRACTURED (FD0): No fractures.</p> <p>VERY SLIGHTLY FRACTURED (FD1): Core recovered mostly in lengths greater than 1 m.</p> <p>SLIGHTLY TO VERY SLIGHTLY FRACTURED (FD2)*</p> <p>SLIGHTLY FRACTURED (FD3): Core recovered mostly in lengths from 300 to 1000 mm, with few scattered lengths less than 300 mm or greater than 1000 mm.</p> <p>MODERATELY TO SLIGHTLY FRACTURED (FD4)*</p> <p>MODERATELY FRACTURED (FD5): Core recovered mostly in 100 to 300 mm lengths with most lengths about 200 mm.</p> <p>INTENSELY TO MODERATELY FRACTURED (FD6)*</p> <p>INTENSELY FRACTURED (FD7): Lengths average from 30 to 100 mm with scattered fragmented intervals. Core recovered mostly in lengths less than 100 mm.</p> <p>VERY INTENSELY TO INTENSELY FRACTURED (FD8)*</p> <p>VERY INTENSELY FRACTURED (FD9): Core recovered mostly as chips and fragments with a few scattered short core lengths.</p> <p>* Combinations of fracture densities (e.g. very intensely to intensely fractured, or moderately to slightly fractured) are used where equal distribution of both fracture density characteristics are present over a significant interval or exposure, or where characteristics are "in between" the descriptor definitions.</p>		

ROCK HARDNESS DESCRIPTORS			Modified from United States Bureau of Reclamation, Engineering Geology Field Manual.
Alphanumeric Descriptor	Descriptor	Criteria	
H1	Extremely hard	Core, fragment, or exposure cannot be scratched with knife or sharp pick; can only be chipped with repeated heavy hammer blows.	
H2	Very hard	Cannot be scratched with knife or sharp pick. Core or fragment breaks with repeated heavy hammer blows.	
H3	Hard	Can be scratched with knife or sharp pick with difficulty (heavy pressure). Heavy hammer blow required to break specimen.	
H4	Moderately hard	Can be scratched with knife or sharp pick with light or moderate pressure. Core or fragment breaks with moderate hammer blow.	
H5	Moderately soft	Can be grooved 2 mm deep by knife or sharp pick with moderate or heavy pressure. Core or fragment breaks with light hammer blow or heavy manual pressure.	
H6	Soft	Can be grooved or gouged easily by knife or sharp pick with light pressure, can be scratched with fingernail. Breaks with light to moderate manual pressure.	
H7	Very soft	Can be readily indented, grooved or gouged with fingernail, or carved with a knife. Breaks with light manual pressure.	

Any bedrock unit softer than H7, very soft, is to be described using ASTM D-2488 consistency descriptors.

Note: Although "sharp pick" is included in these definitions, descriptions of ability to be scratched, grooved or gouged by a knife is the preferred criteria.

BEDDING, FOLIATION, OR FLOW TEXTURE DESCRIPTORS		Modified from United States Bureau of Reclamation, Engineering Geology Field Manual.
Descriptors	Thickness / Spacing	
Massive	Greater than 3 m	
Very thickly bedded, foliated, or banded	1 to 3 m	
Thickly	300 mm to 1 m	
Moderately	100 to 300 mm	
Thinly	30 to 100 mm	
Very thinly	10 to 30 mm	
Laminated (intensely foliated or banded)	Less than 10 mm	

ENGINEERING SERVICE CENTER		STRUCTURE FOUNDATIONS		FIELD INVESTIGATION BY: R. Fuentes M. Pagenkopp H. Valencia		STATE OF CALIFORNIA DEPARTMENT OF TRANSPORTATION		DIVISION OF STRUCTURES STRUCTURE DESIGN		BRIDGE NO. 54-0499 KILOMETER POST 76.3		BELL MOUNTAIN WASH BRIDGE (WIDEN)	
DRAWN BY Irma G-Rennen 9/01		CHECKED BY H. Valencia 10/01		ORIGINAL SCALE IN MILLIMETERS FOR REDUCED PLANS 0 10 20 30 40 50 60 70 80 90 100		CU 08 EA 355521		DISREGARD PRINTS BEARING EARLIER REVISION DATES		REVISION DATES (PRELIMINARY STAGE ONLY) 10-24-01 10-25-01 10-30-01		SHEET 6 OF 7	

OSF GEOLOGIST LOG OF TEST BORINGS SHEET (METRIC) (REV. 10/5/2000)

FILE -> /user/dms/local/translab/08-355520/bellmtn6.dgn

DATE PLOTTED -> 30 OCT 2001 TIME PLOTTED -> 15:43:39 USERNAME -> T8DDP

YV Sbd 31 D 17 71
 1957 39 171



DIVISION OF ENGINEERING SERVICES - OFFICE OF GEOTECHNICAL SERVICES
 As-Built Log of Test Borings sheet is considered an informational document only. As such, certificate expiration date confirm that this is a true and accurate copy of the original document. It does not attest to the accuracy or validity of the information contained in the any bidder, contractor or other interested party.

DIST.	COUNTY	ROUTE	KILOMETER POST - TOTAL PROJECT	Sheet No.	Total Sheets
08	Sbd	15		7	7

REGISTERED ENGINEER - CIVIL
 Mark DeSalvatore
 No. 38499
 Exp. 12-31-01
 CIVIL
 STATE OF CALIFORNIA

BELL MOUNTAIN WASH BRIDGE (WIDEN)
LOG OF TEST BORINGS 7 OF 7

NOTE: A COPY OF THIS LOG OF TEST BORINGS IS AVAILABLE AT OFFICE OF STRUCTURE MAINTENANCE AND INVESTIGATIONS, SACRAMENTO, CALIFORNIA
 CU: 08
 EA: 355521
 BRIDGE No. 54-0499

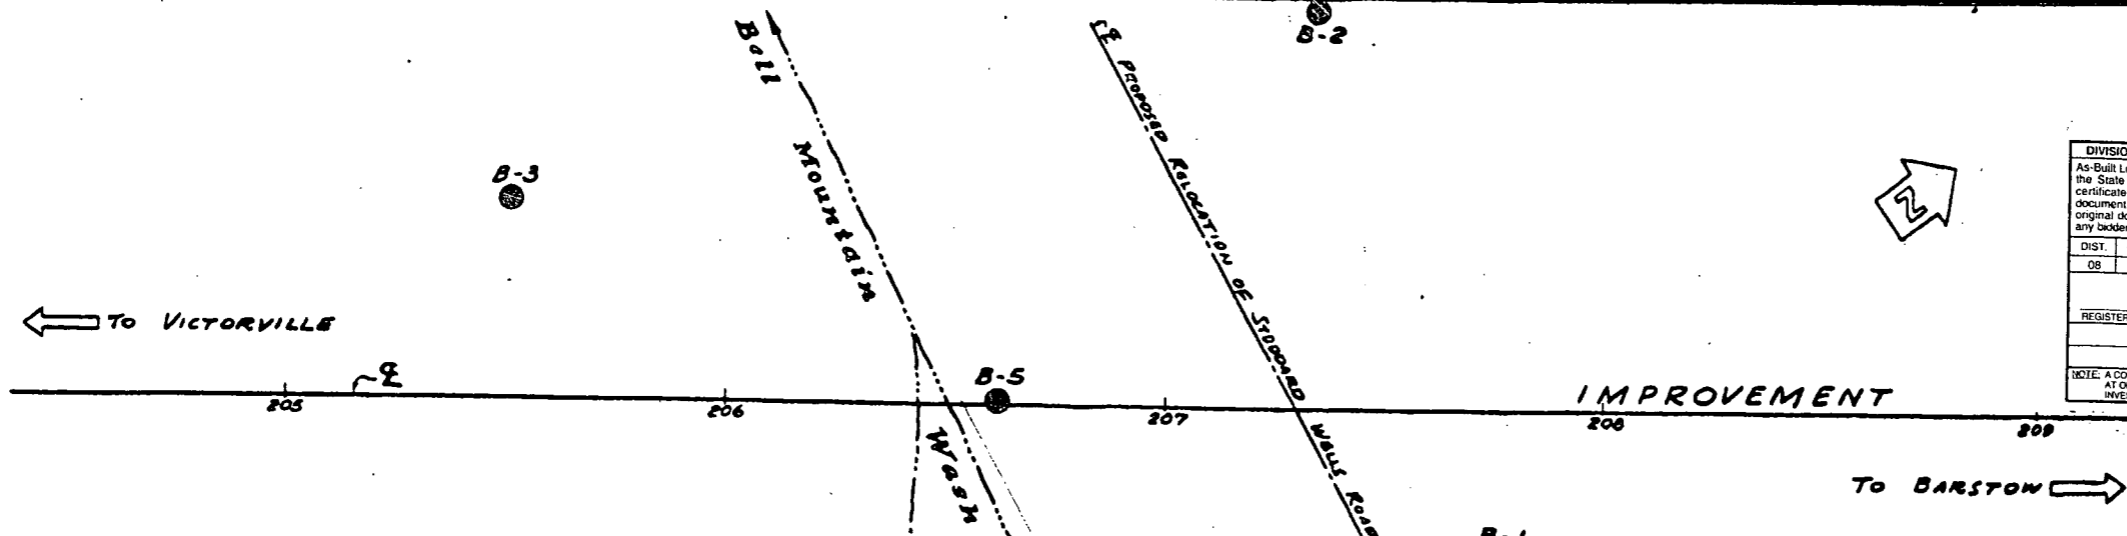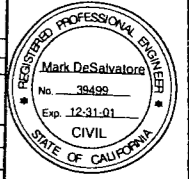

Pile #74
 Pile # Blows/ft.

1	1
2	2
3	3
4	6
5	8
6	7
7	7
8	7
9	8
10	6
11	5
12	5
13	7
14	13
15	11
16	13
17	13
18	25
19	50

DESIGN PILE LOADING: 45T
PILE TYPE: RH-40 STEEL
TOTAL NUMBER PILES: 22
LINEAL FT PILES, PLAN: 600
LINEAL FT PILES, 'AS BUILT' 633.5
HAMMER: VULCAN No. 1



Revisions made to this Log of Test Borings from the original 1955 Log of Test Borings are the addition of the following table and notes:

Boring	Station	Offset from 'CL Route 15'
B-3	113+54.135	13.110 m Left
B-4	113+67.546	12.800 m Right
B-5	113+87.968	0.305 m Left
B-2	114+10.219	26.210 m Left
B-1	114+22.716	9.450 m Right

- Notes:
- See the General Plan and/or Foundation Plan for Metric Stationing.
 - The Division of Structure Design produced the data presented in the table above. The data are the metric locations for the As-Built Test Borings referenced to the centerline of Route 15 as shown on the General Plan (dated 9-7-00). This table is presented on the As-Built Log of Test Boring sheet for the convenience of any bidder, contractor or other interested party.
 - In the table above, the Metric Boring Locations are based on NAD 83 horizontal datum.


AS BUILT
 CORRECTIONS BY A. KECCHIVAL
 CONTRACT NO. 08-119A04
 DATE 7-25-69

B.M. "Q" 21-A-54
 RWD 2x2 16" Deep, 692' Rt. STA
 207+781 & EAST RDBD.
 Elev. 2850.15

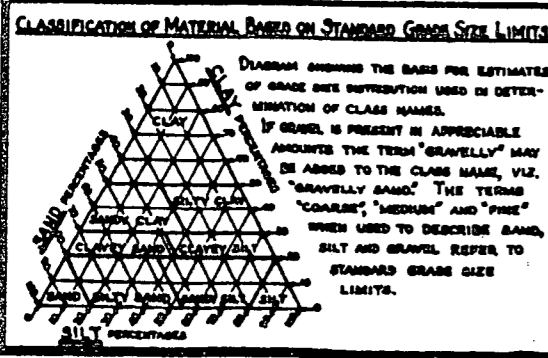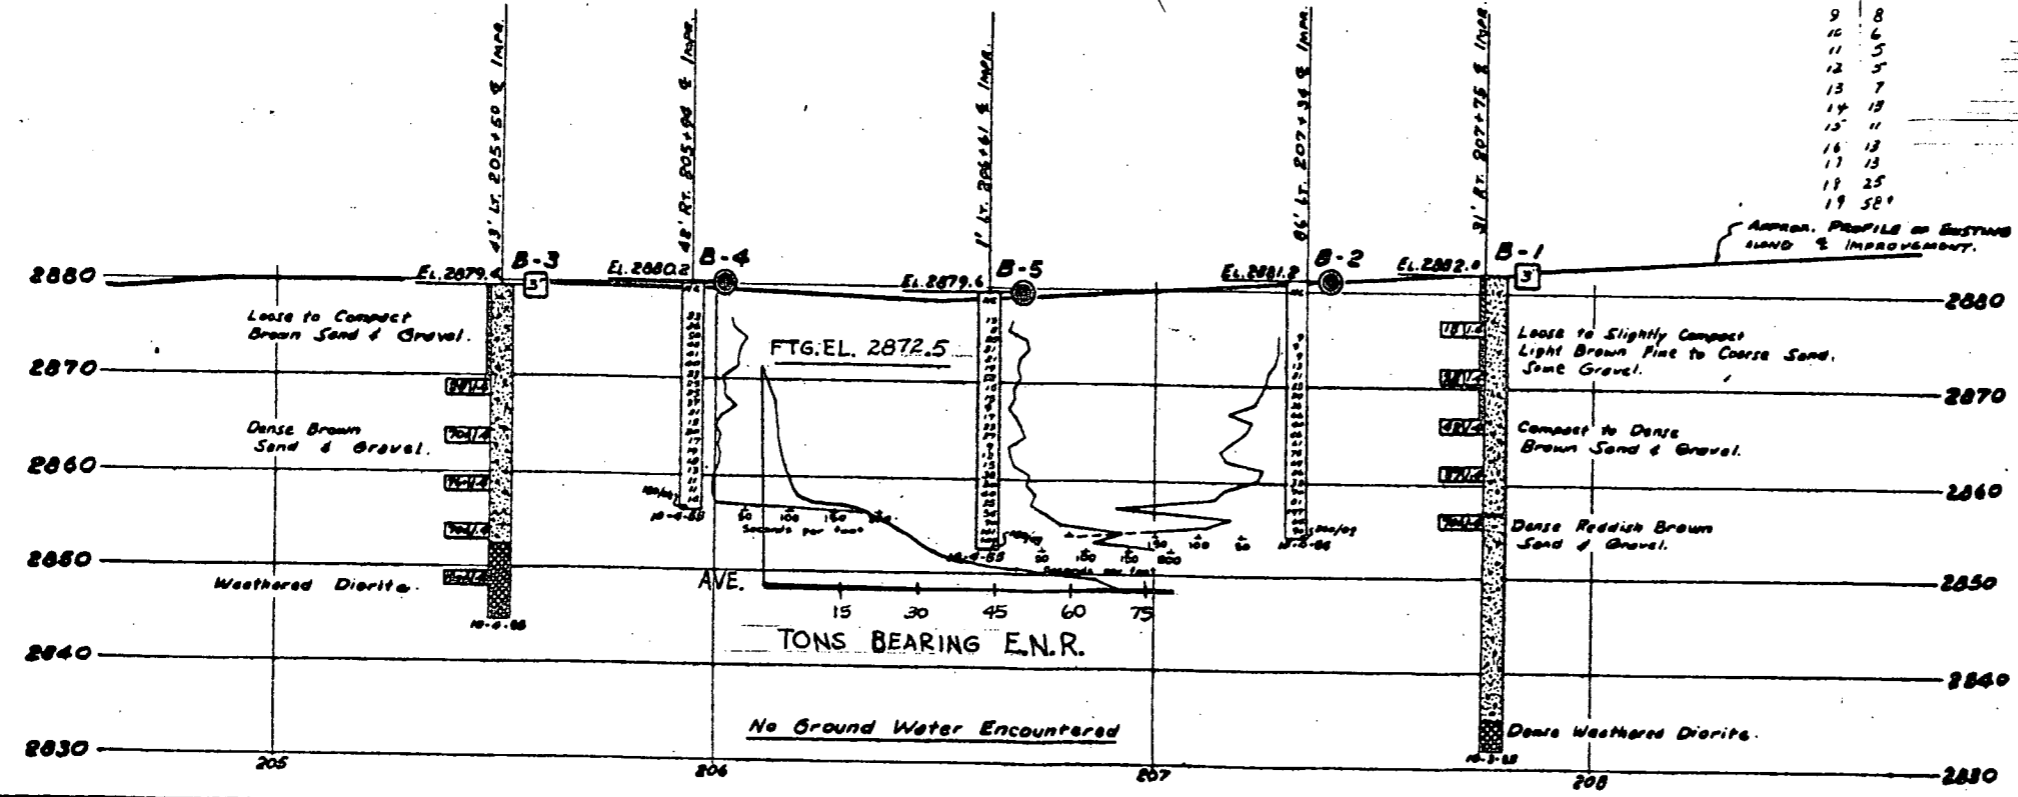

LEGEND OF EARTH MATERIALS

GRAVEL	SILTY CLAY OR CLAYEY SILT
SAND	PEAT AND/OR ORGANIC MATTER
SILT	FILL MATERIAL
CLAY	IGNEOUS ROCK
SANDY CLAY OR CLAYEY SAND	SEDIMENTARY ROCK
SANDY SILT OR SILTY SAND	METAMORPHIC ROCK

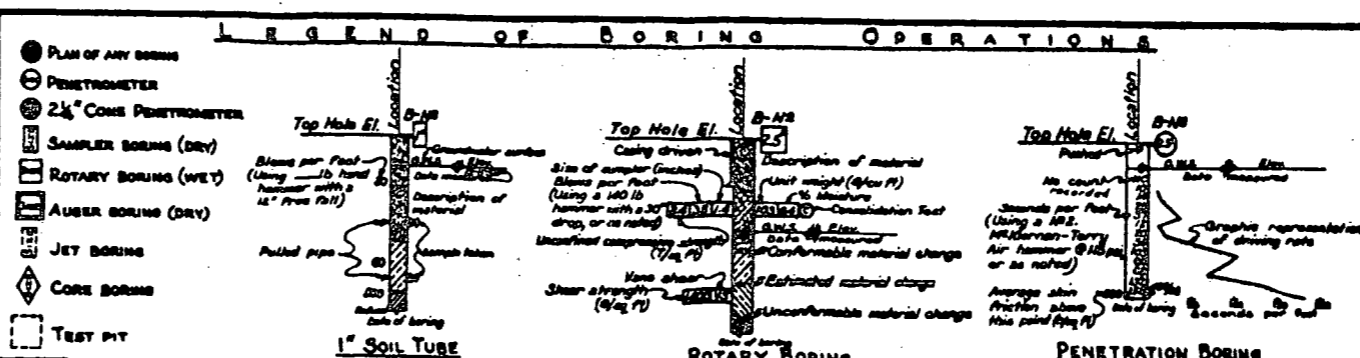

NOTES

The contractor's attention is directed to Section 2, Article (c) of the Standard Specifications and to the Special Provisions accompanying this set of plans.

Classification of earth material as shown on this sheet is based upon field inspection and is not to be construed to imply mechanical analysis.

STATE OF CALIFORNIA
 DEPARTMENT OF PUBLIC WORKS
 DIVISION OF HIGHWAYS

58-8VC4-F1

BELL MOUNTAIN WASH BRIDGE


LOG OF TEST BORINGS

Scale: Horiz. 1" = 80', Vert. 1" = 10', Bridge 54-499, Plan E-54, Drawing C-4691-11

BRIDGE DEPARTMENT

North Victorville UP

BRIDGE DEPARTMENT

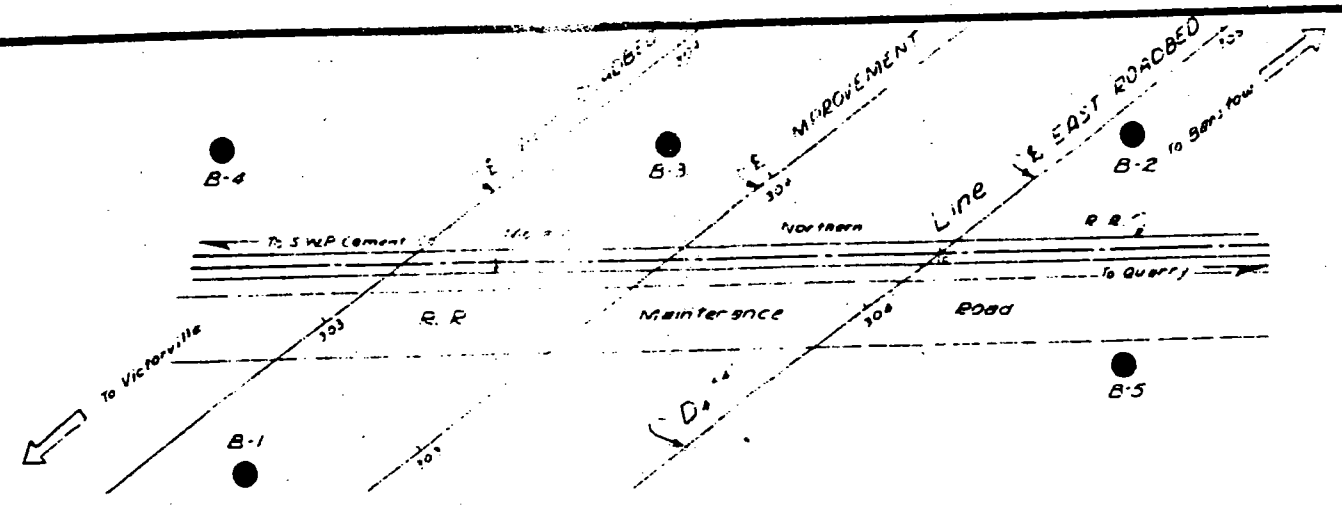

DIVISION OF ENGINEERING SERVICES - OFFICE OF GEOTECHNICAL SERVICES
 As-Built Log of Test Borings sheet is considered an informational document only. As such, the State of California registration seal with signature, license number and registration certificate expiration date confirm that this is a true and accurate copy of the original document. It does not attest to the accuracy or validity of the information contained in the original document. This drawing is available and presented only for the convenience of any bidder, contractor or other interested party.

DIST.	COUNTY	ROUTE	KILOMETER POST - TOTAL PROJECT	Sheet No.	Total Sheets
08	Sbd	15			

REGISTERED ENGINEER: CIVIL
 Mark DeSalvatore
 No. 39499
 Exp. 12-31-01
 CIVIL
 STATE OF CALIFORNIA



NORTH VICTORVILLE UP (REPLACE)
LOG OF TEST BORINGS 2 OF 2

NOTE: A COPY OF THIS LOG OF TEST BORINGS IS AVAILABLE AT OFFICE OF STRUCTURE MAINTENANCE AND INVESTIGATIONS, SACRAMENTO, CALIFORNIA. CU: 08 EA: 358571 BRIDGE No. 54-1211

Revisions made to this Log of Test Borings from the original 1956 Log of Test Borings are the addition of the following table and notes:


Boring	Station	Offset from C/L Route 15
B-1	143+14.629	5.853 m Left
B-4	143+26.159	23.821 m Left
B-3	143+51.687	6.591 m Left
B-5	143+67.727	24.096 m Right
B-2	143+77.251	12.163 m Right

- Notes:
- See the General Plan and/or Foundation Plan for Metric Stationing.
 - The Division of Structure Design produced the data presented in the table above. The data are the metric locations for the As-Built Test Borings referenced to the centerline of Route 15 as shown on the General Plan (dated 9-14-00). This table is presented on the As-Built Log of Test Boring sheet for the convenience of any bidder, contractor or other interested party.
 - In the table above, the Metric Boring Locations are based on NAD 83 horizontal datum.

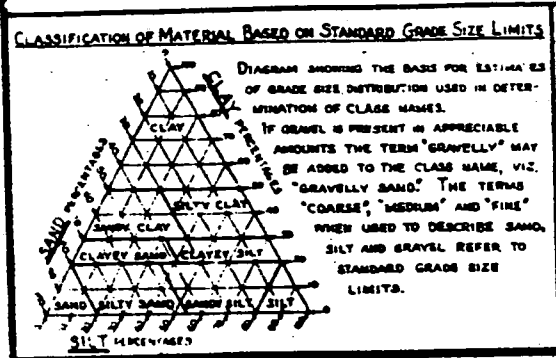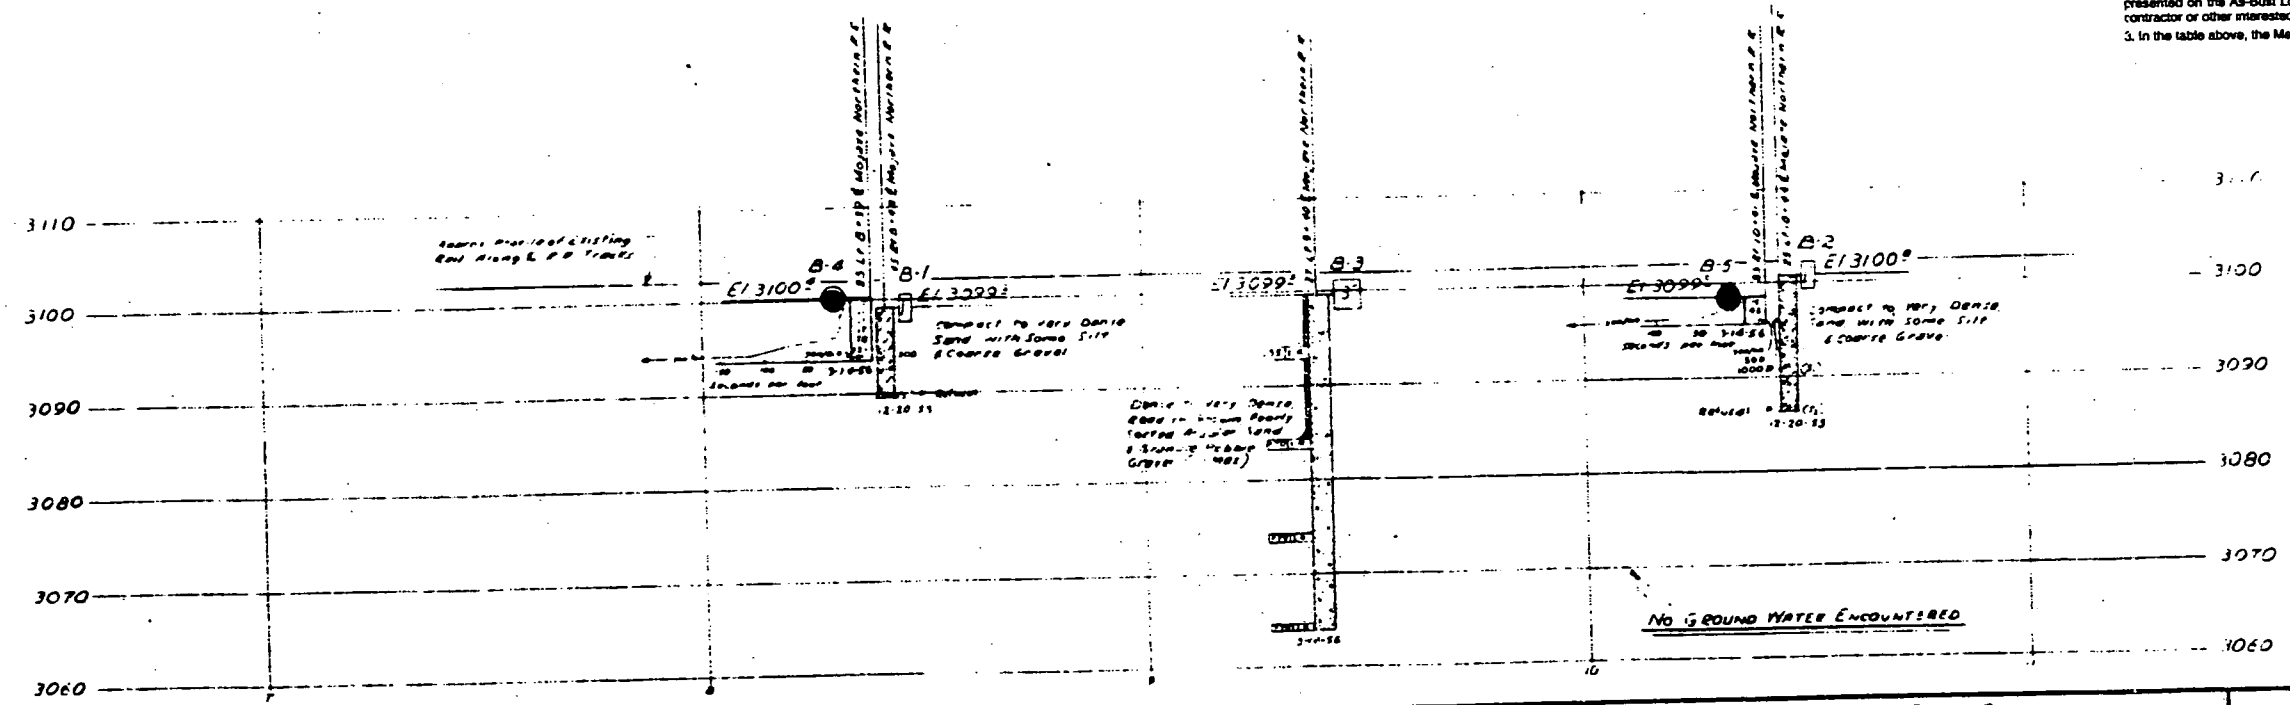

LEGEND OF EARTH MATERIALS

GRAVEL	SILTY CLAY OR CLAYEY SILT
SAND	PEAT AND/OR ORGANIC MATTER
SILT	FILL MATERIAL
CLAY	IGNEOUS ROCK
SANDY CLAY OR CLAYEY SAND	SEDIMENTARY ROCK
SANDY SILT OR SILTY SAND	METAMORPHIC ROCK

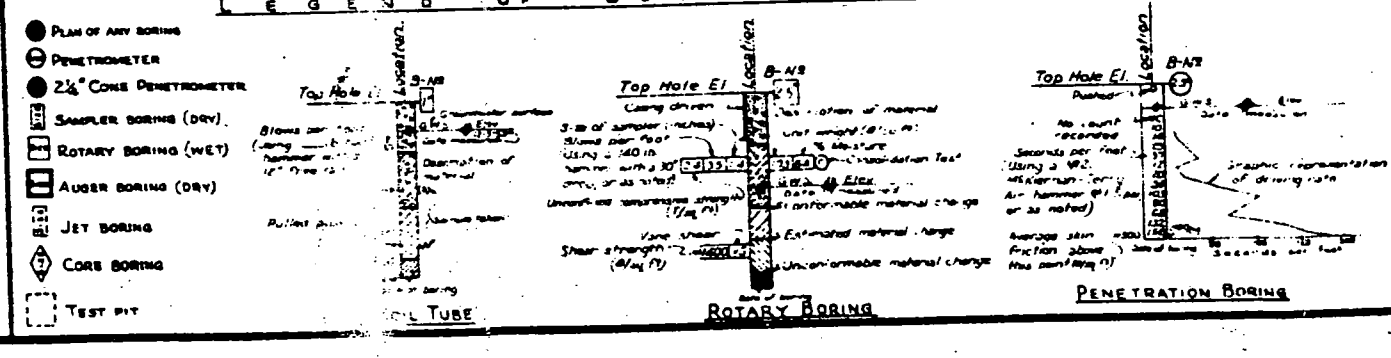

NOTES

The contractor's attention is directed to Section 2, Article 11 of the Standard Specifications and to the Special Provisions accompanying the set of plans. Classification of earth material as shown on this sheet is based upon field inspection and is not to be construed to imply mechanical analysis.

50-BVC-1-E1

NORTH VICTORVILLE U.P.
LOG OF TEST BORINGS

SCALE: HORIZ. 1" = 40' VERT. 1" = 10' BRIDGE 54-514 FILE DRAWING






DIST	COUNTY	ROUTE	KILOMETER POST TOTAL PROJECT	SHEET No	TOTAL SHEETS
08	Sbd	15			

10-30-01
REGISTERED CIVIL ENGINEER

PLANS APPROVAL DATE

The State of California or its officers or agents shall not be responsible for the accuracy or completeness of electronic copies of this plan sheet.

BENCH MARK
 BM #CP-110 Elev. 937.082
 Fd. 2X2 H&T in dirt median
 Rte. 15, approx. Sta. 142.51
 N 623609.920
 E 2069428.081
 NGVD1929

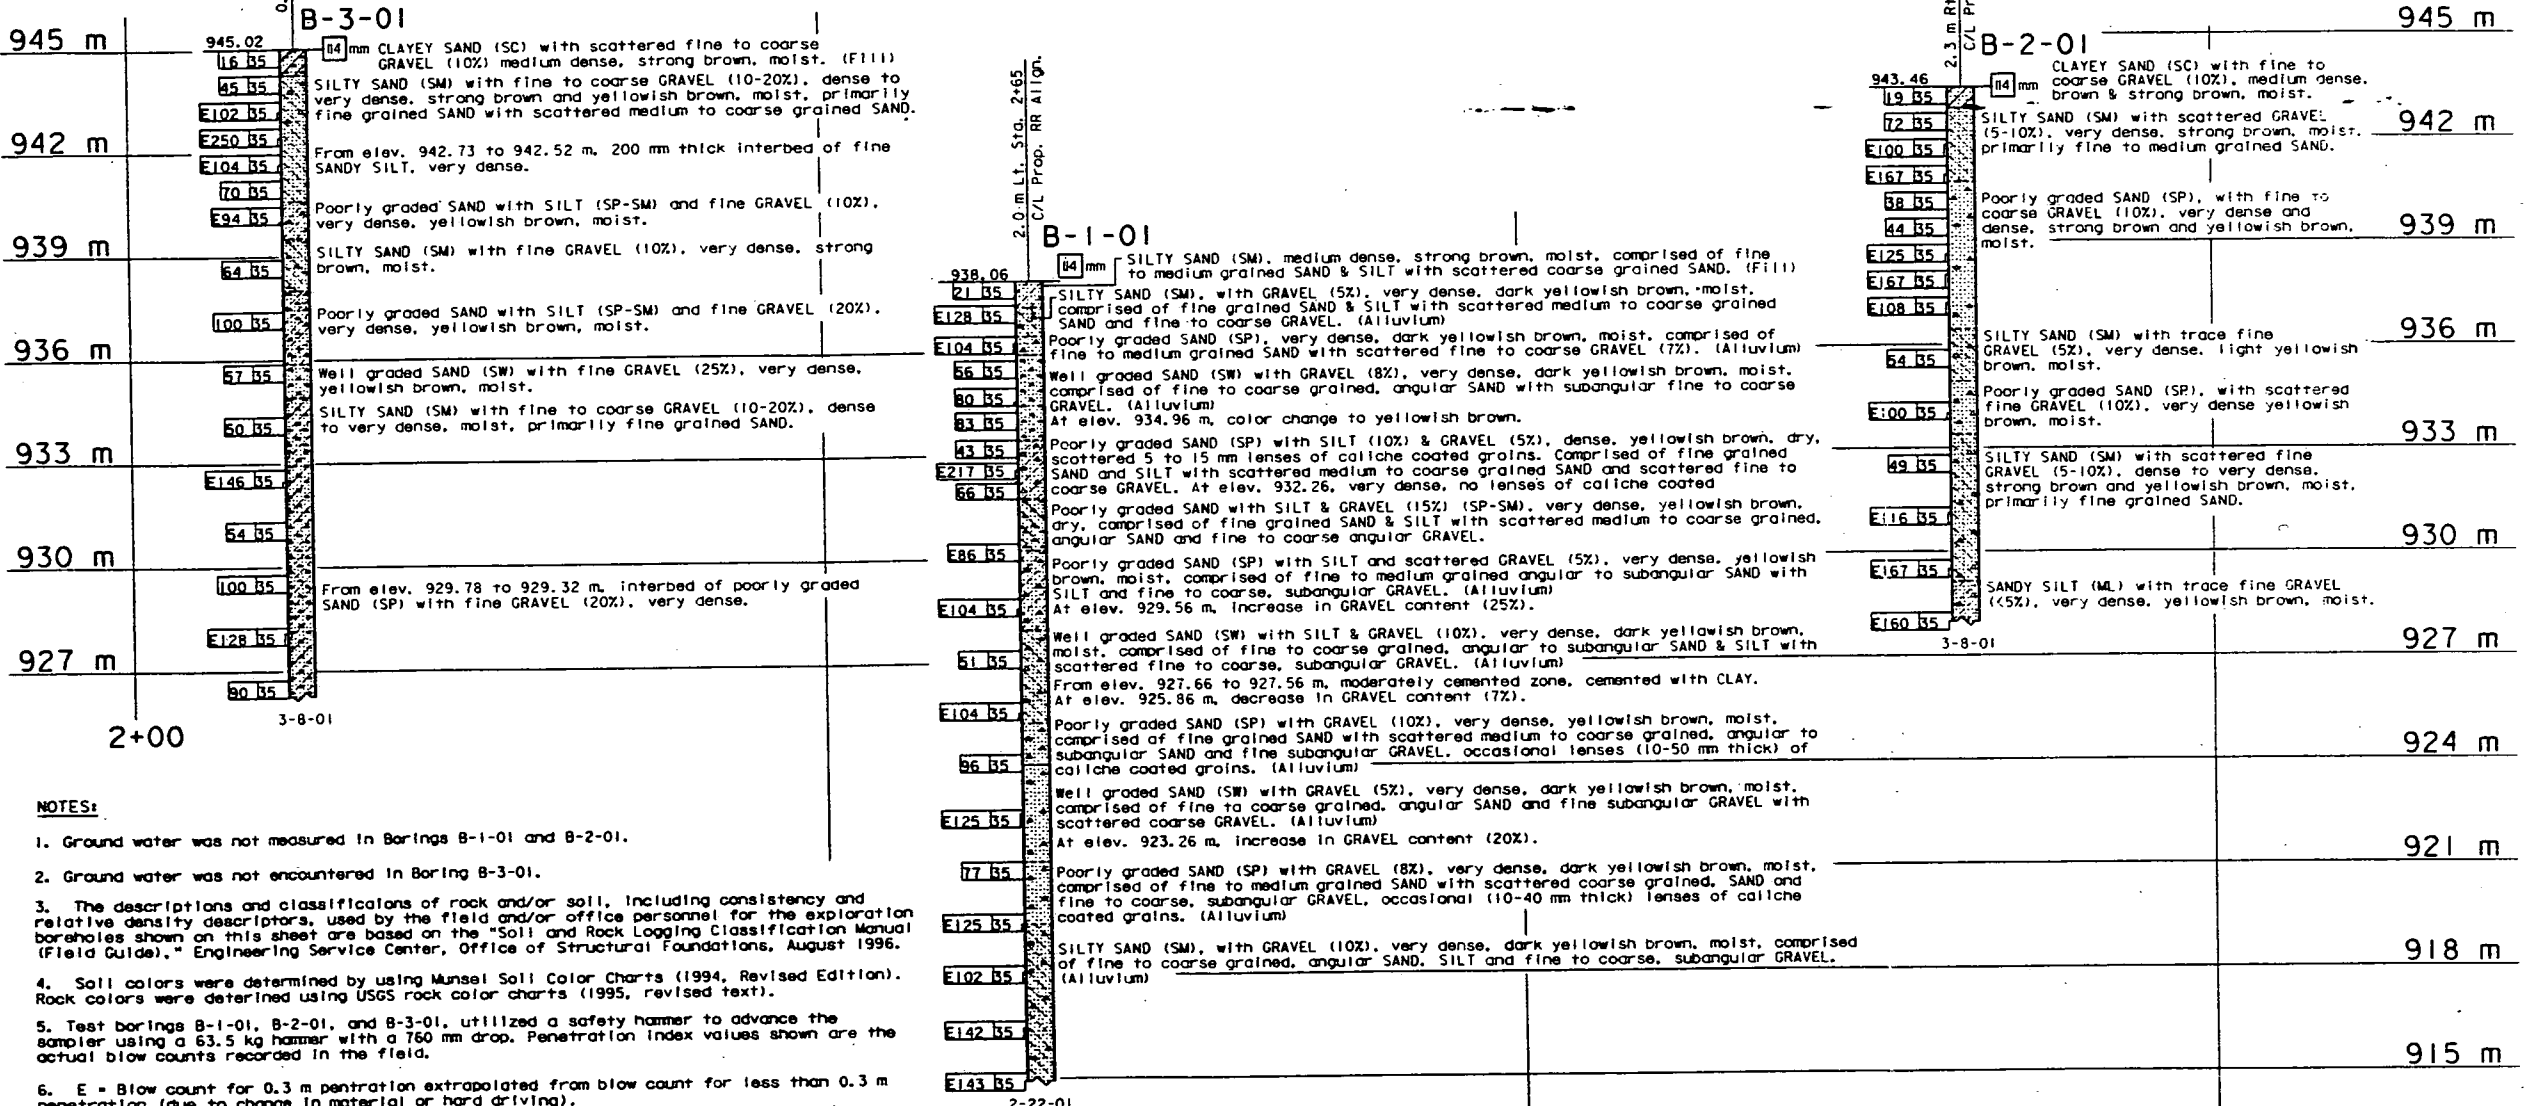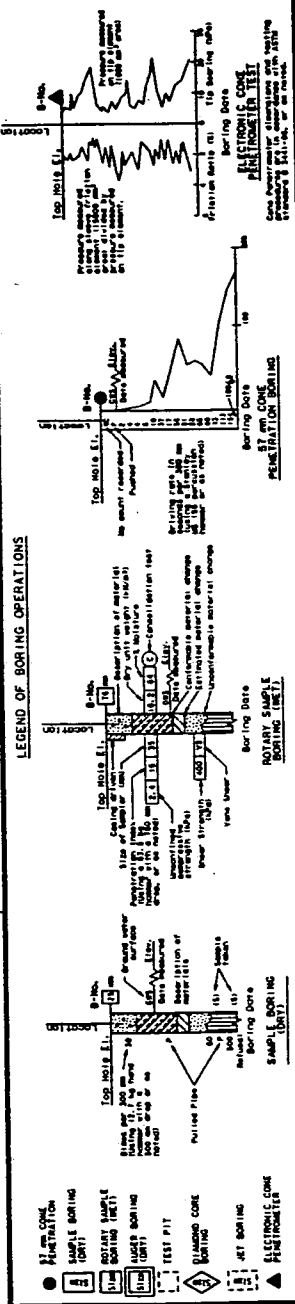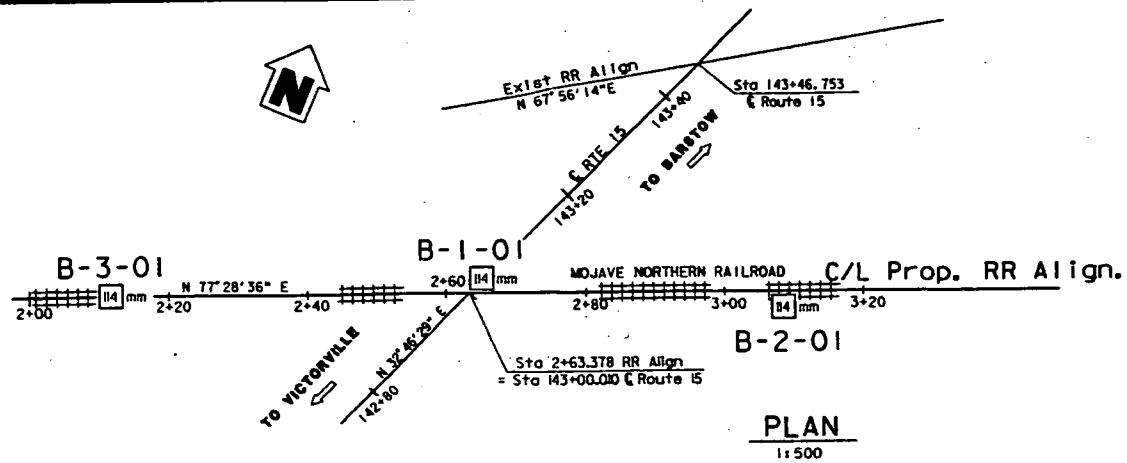

- NOTES:**
- Ground water was not measured in Borings B-1-01 and B-2-01.
 - Ground water was not encountered in Boring B-3-01.
 - The descriptions and classifications of rock and/or soil, including consistency and relative density descriptors, used by the field and/or office personnel for the exploration borings shown on this sheet are based on the "Soil and Rock Logging Classification Manual (Field Guide)," Engineering Service Center, Office of Structural Foundations, August 1996.
 - Soil colors were determined by using Munsell Soil Color Charts (1994, Revised Edition). Rock colors were determined using USGS rock color charts (1995, revised text).
 - Test borings B-1-01, B-2-01, and B-3-01, utilized a safety hammer to advance the sampler using a 63.5 kg hammer with a 760 mm drop. Penetration Index values shown are the actual blow counts recorded in the field.
 - E = Blow count for 0.3 m penetration extrapolated from blow count for less than 0.3 m penetration (due to change in material or hard driving).

LEGEND OF EARTH MATERIALS


CLAYEY SILT	CLAYEY SAND	CLAYEY SILT	CLAYEY SAND
CLAYEY SILT	CLAYEY SAND	CLAYEY SILT	CLAYEY SAND
CLAYEY SILT	CLAYEY SAND	CLAYEY SILT	CLAYEY SAND

CONSISTENCY CLASSIFICATION FOR SOILS

Penetration (mm)	Consistency
0-2	Very Soft
2-4	Soft
4-8	Medium Dense
8-15	Dense
15-30	Very Dense
30	Hard


ENGINEERING SERVICES	GEOTECHNICAL SERVICES	FIELD INVESTIGATION BY:	STATE OF CALIFORNIA	DIVISION OF STRUCTURES	BRIDGE NO.	NORTH VICTORVILLE UP (REPLACE)
DRAWN BY: Irma G-Ramirez 9/01		H. Valencio, M. Pagenkopp	DEPARTMENT OF TRANSPORTATION	STRUCTURE DESIGN	54-1211	LOG OF TEST BORINGS 1 OF 2
CHECKED BY: M. Spahn 10/01					KILOMETER POST: 79.2	

APPENDIX B
LOCATIONS OF PROPOSED STRUCTURES

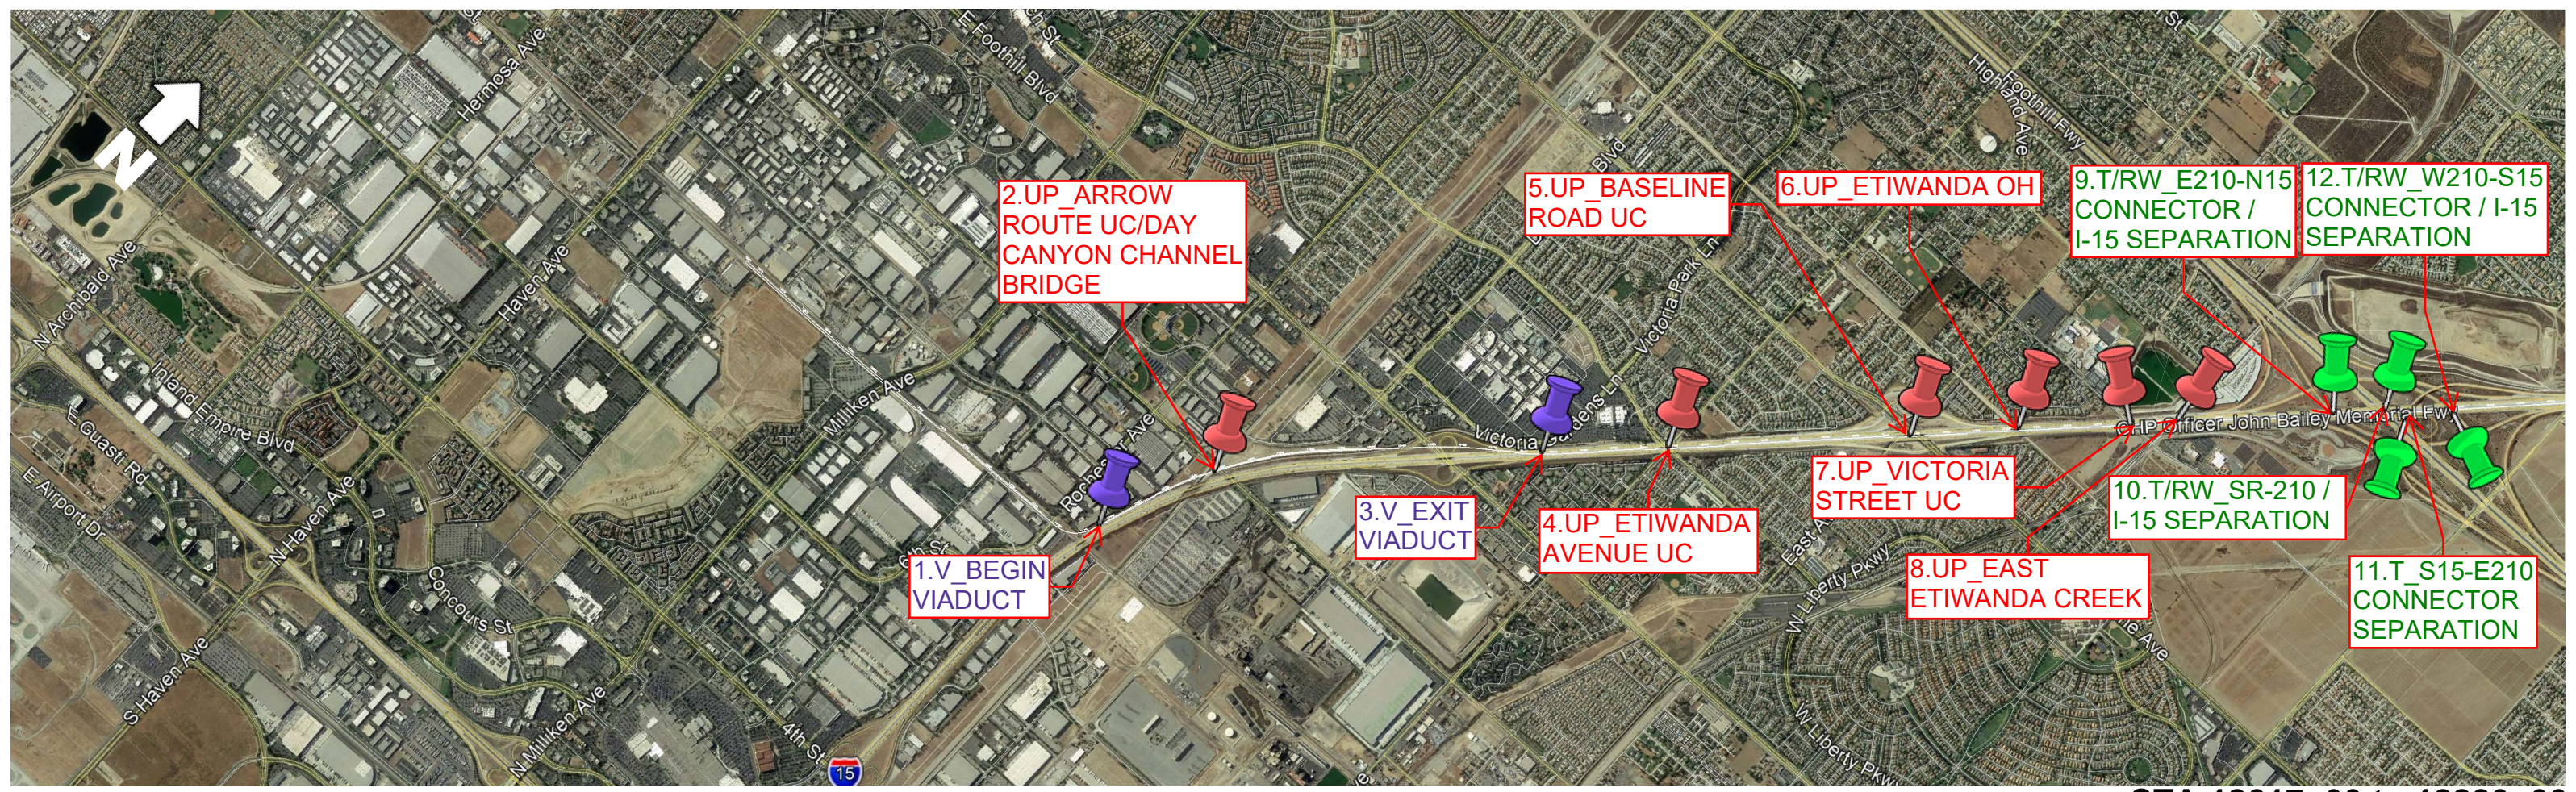

📌 --- Viaduct (V)
 📌 --- Underpass (UP)
 📌 --- Trench (T)
 📌 --- Siderunning Trench (T/SR)

STA 12617+00 to 12280+00

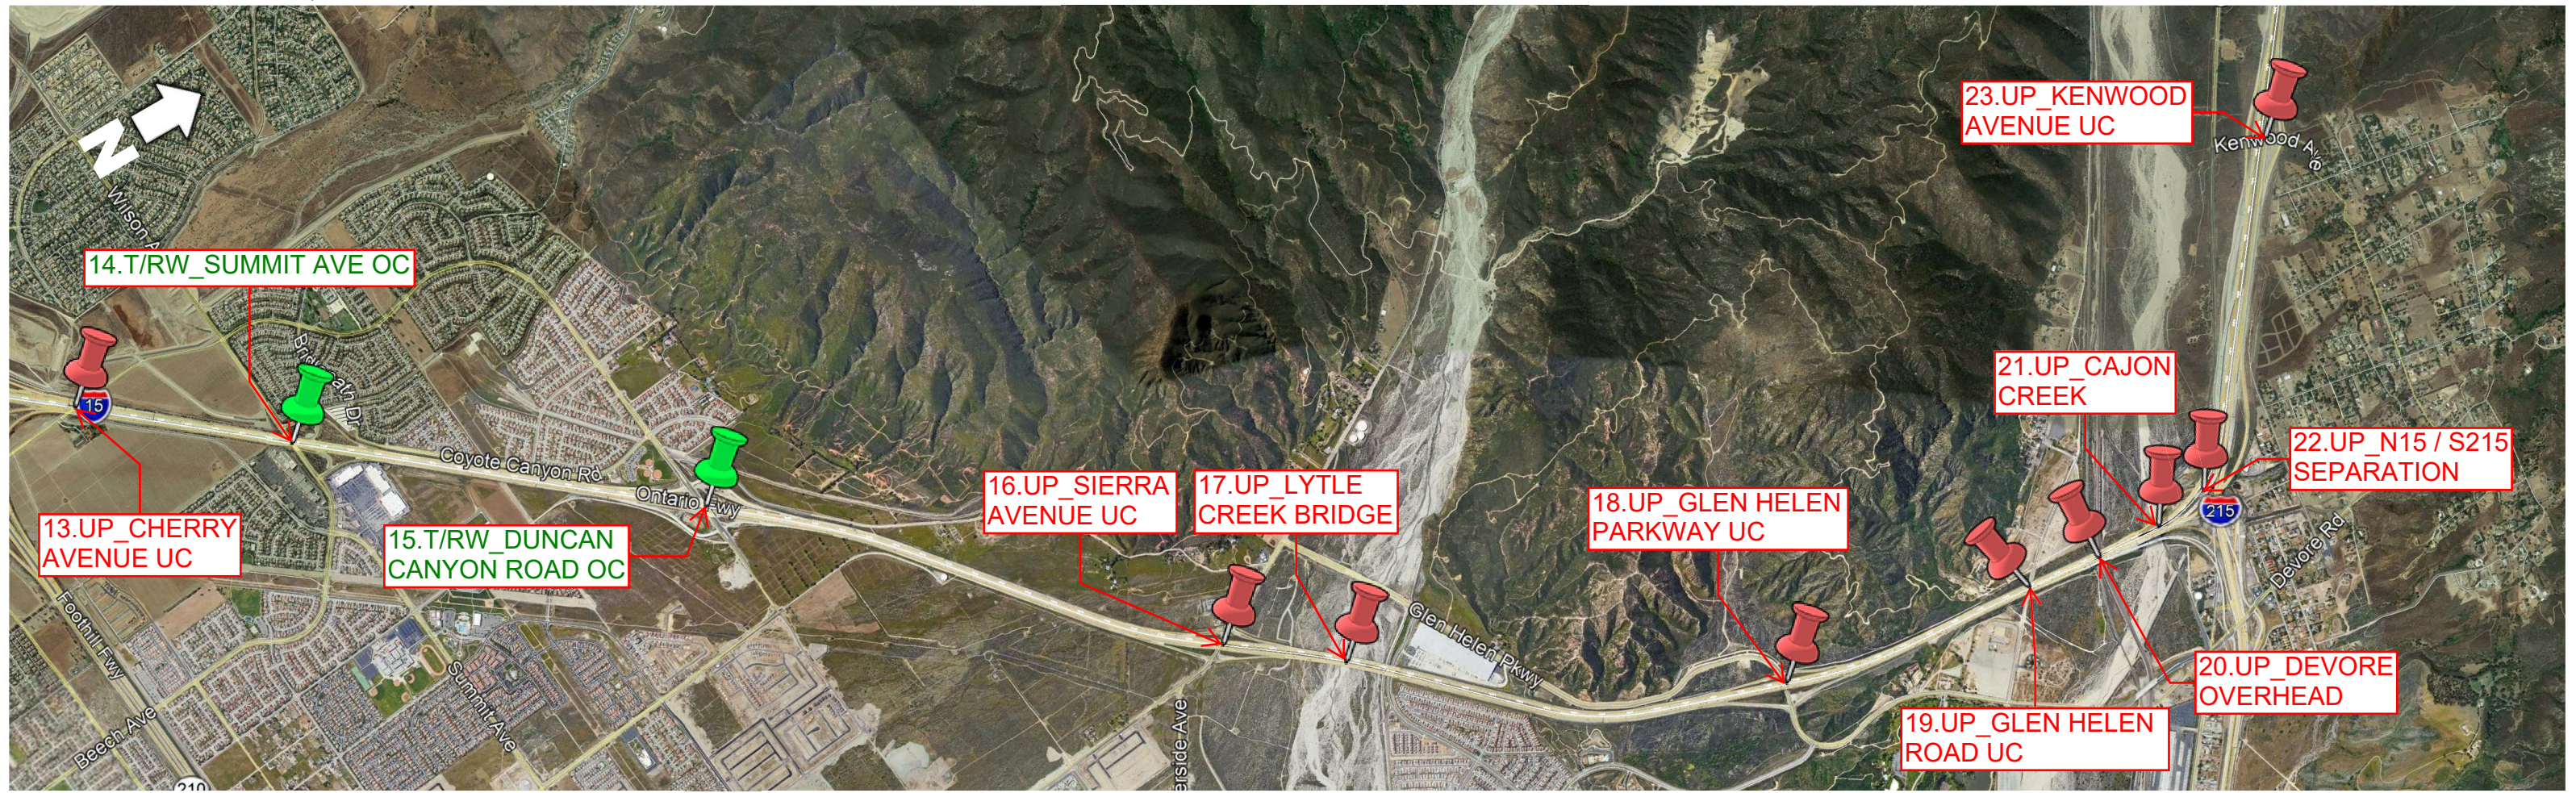


STA 12280+00 to 11800+00



STA 11800+00 to 11310+00

--- Viaduct (V)
 --- Underpass (UP)
 --- Trench (T)
 --- Siderunning Trench (T/SR)

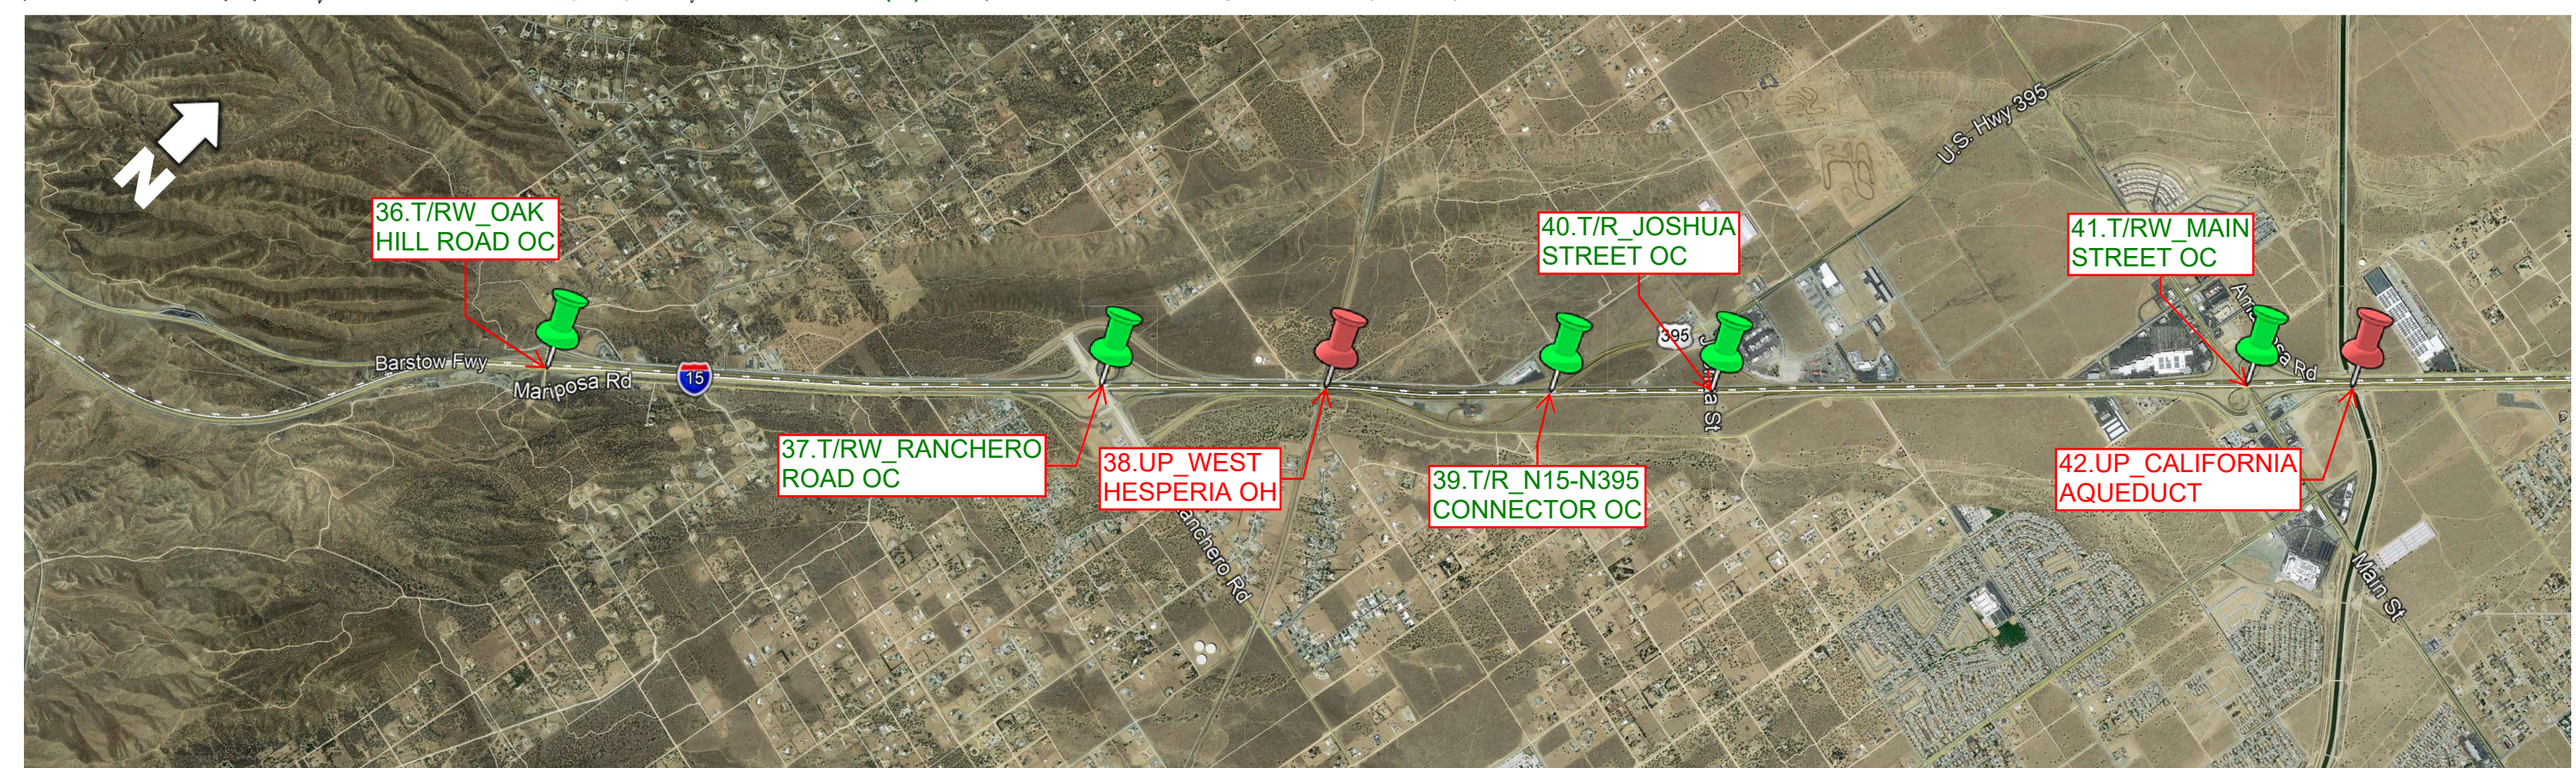


STA 11310+00 to 10870+00



📌 --- Viaduct (V)
 📌 --- Underpass (UP)
 📌 --- Trench (T)
 📌 --- Siderunning Trench (T/SR)

STA 10870+00 to 10430+00

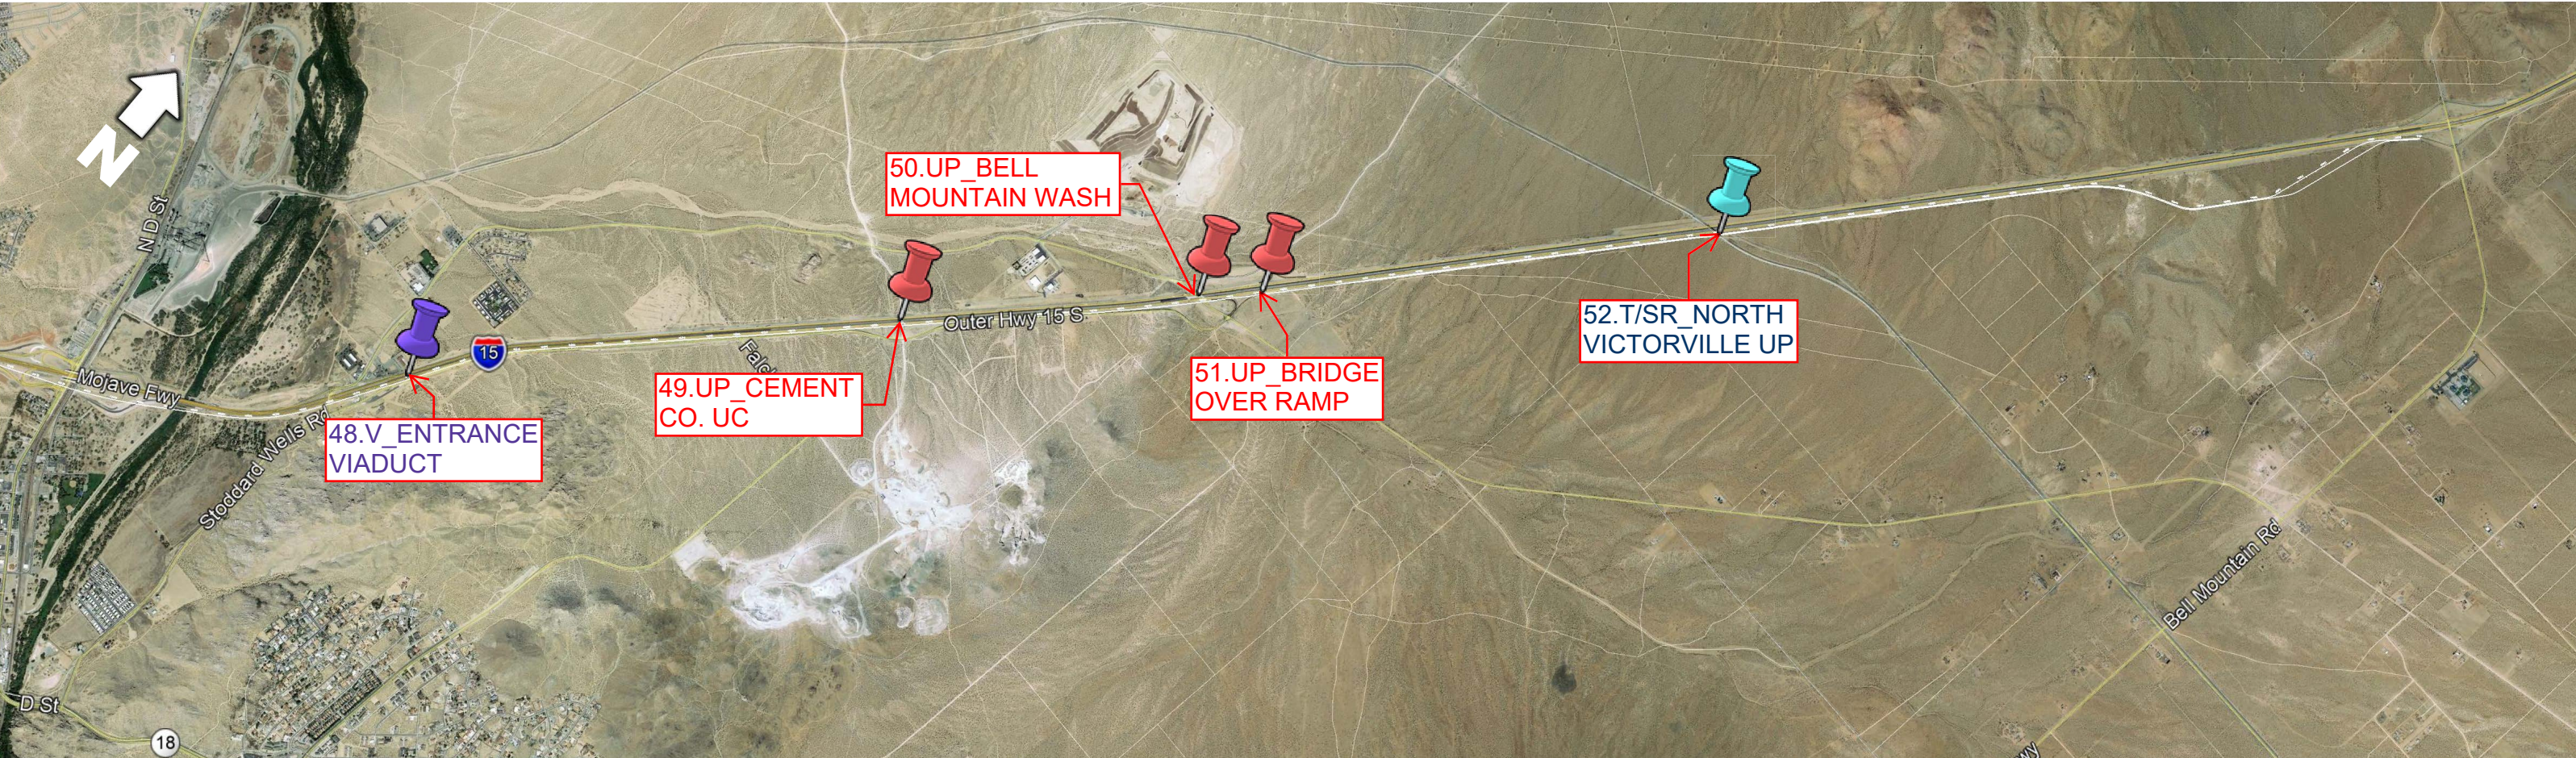

STA 10430+00 to 10017+00